
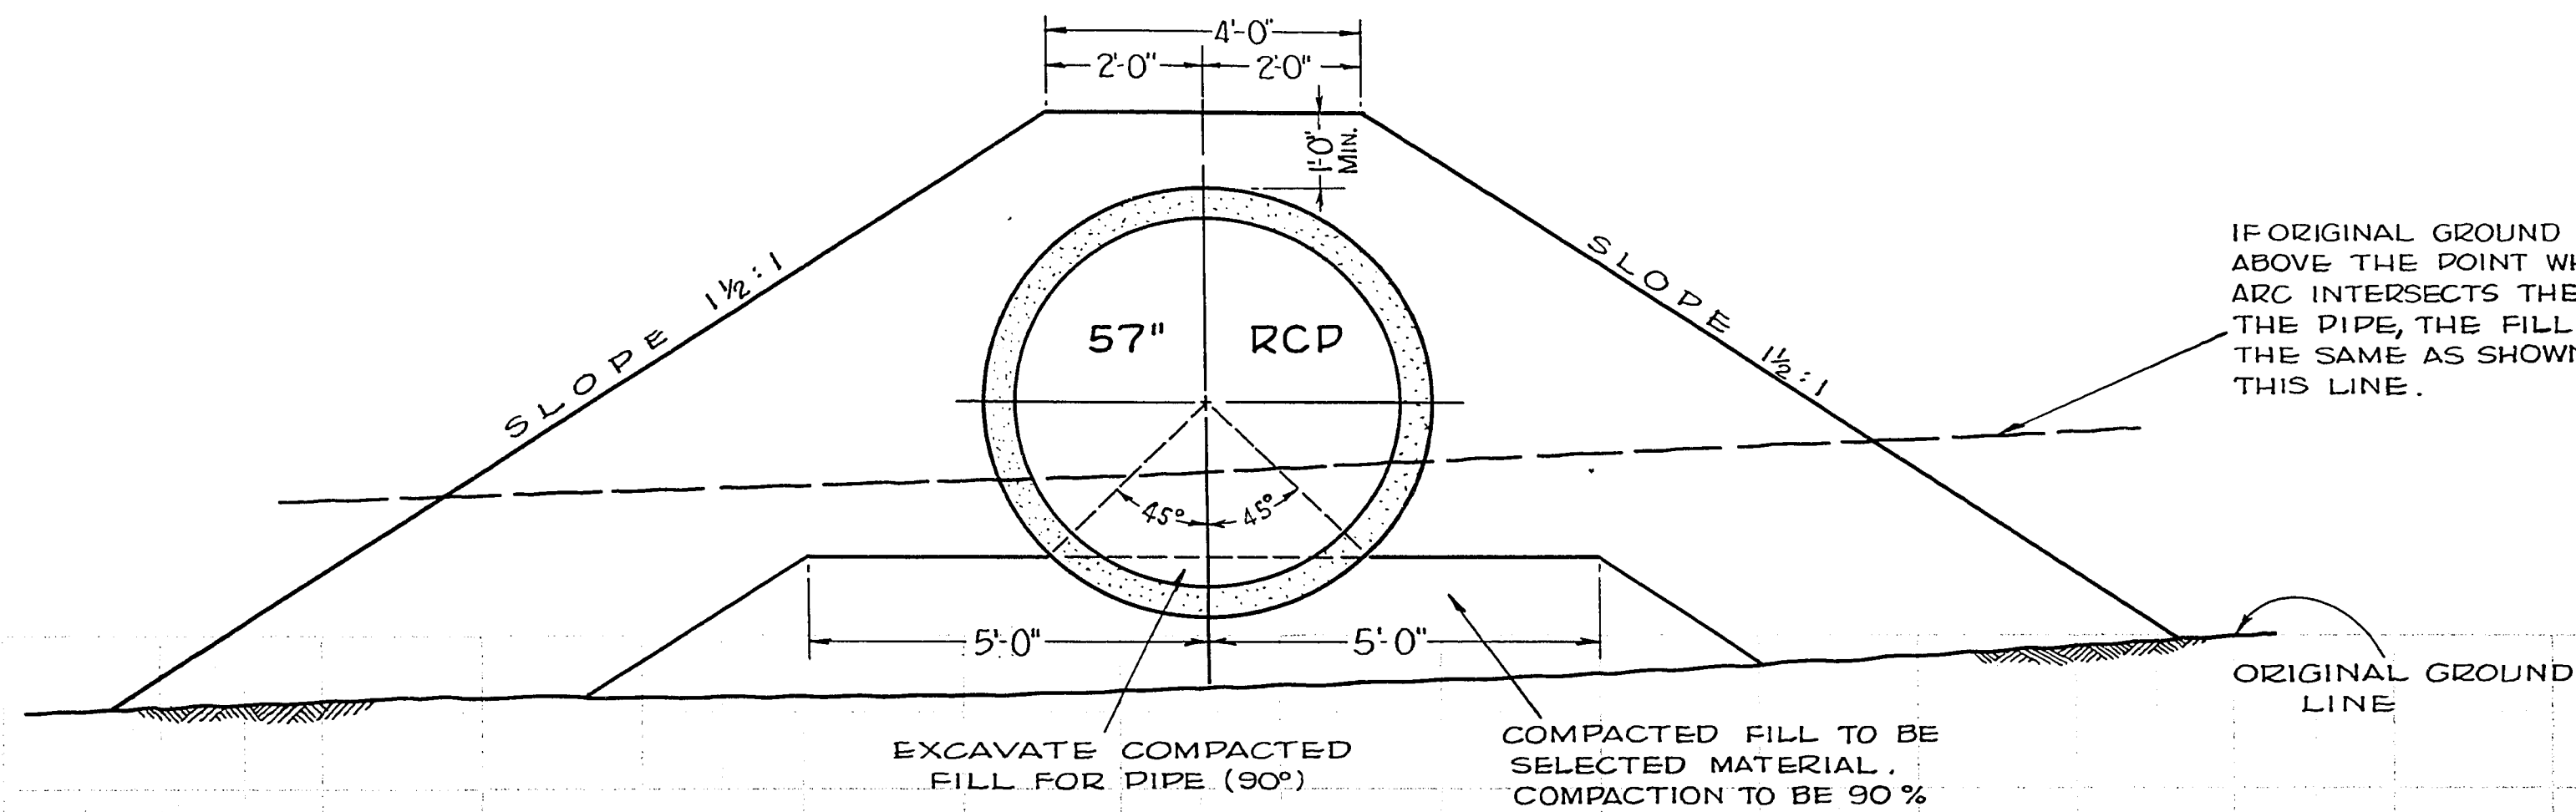
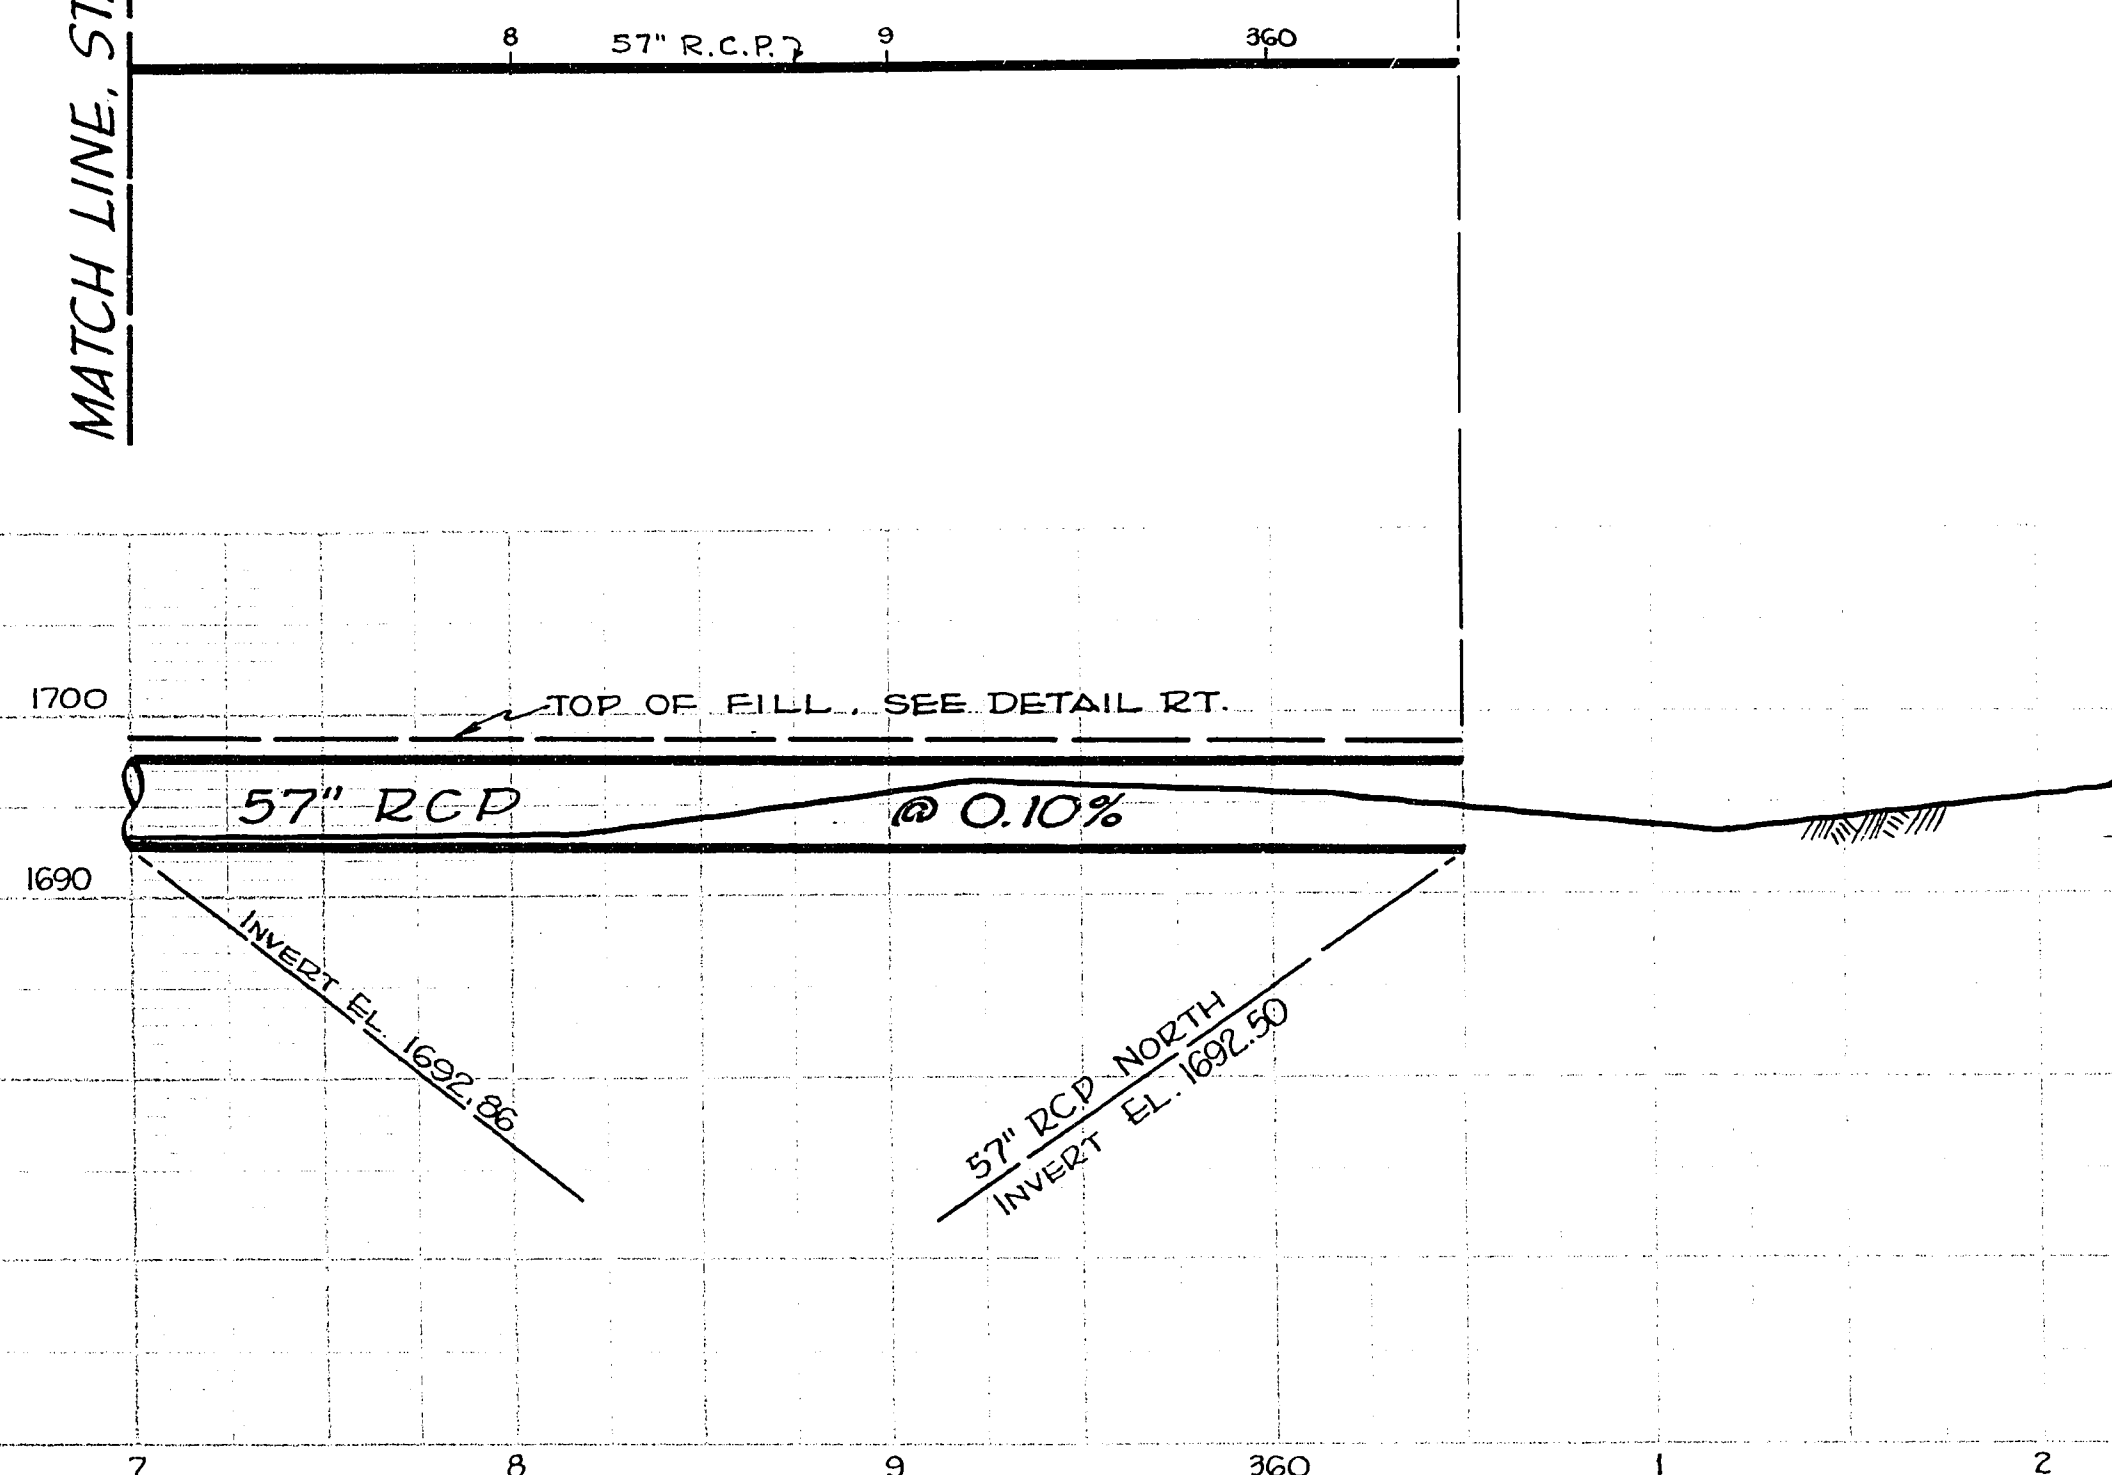


SCHEDULE C

MATCH LINE STA. 357+00

START OF PROJECT

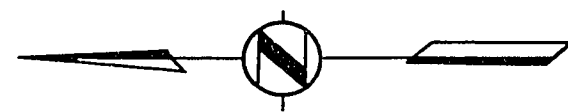


DETAIL OF FILL OVER 57" RCP


SCALE, 1 IN. = 20 FT.

SCHEDULE A


SCALE, 1 IN. = 50 FT.

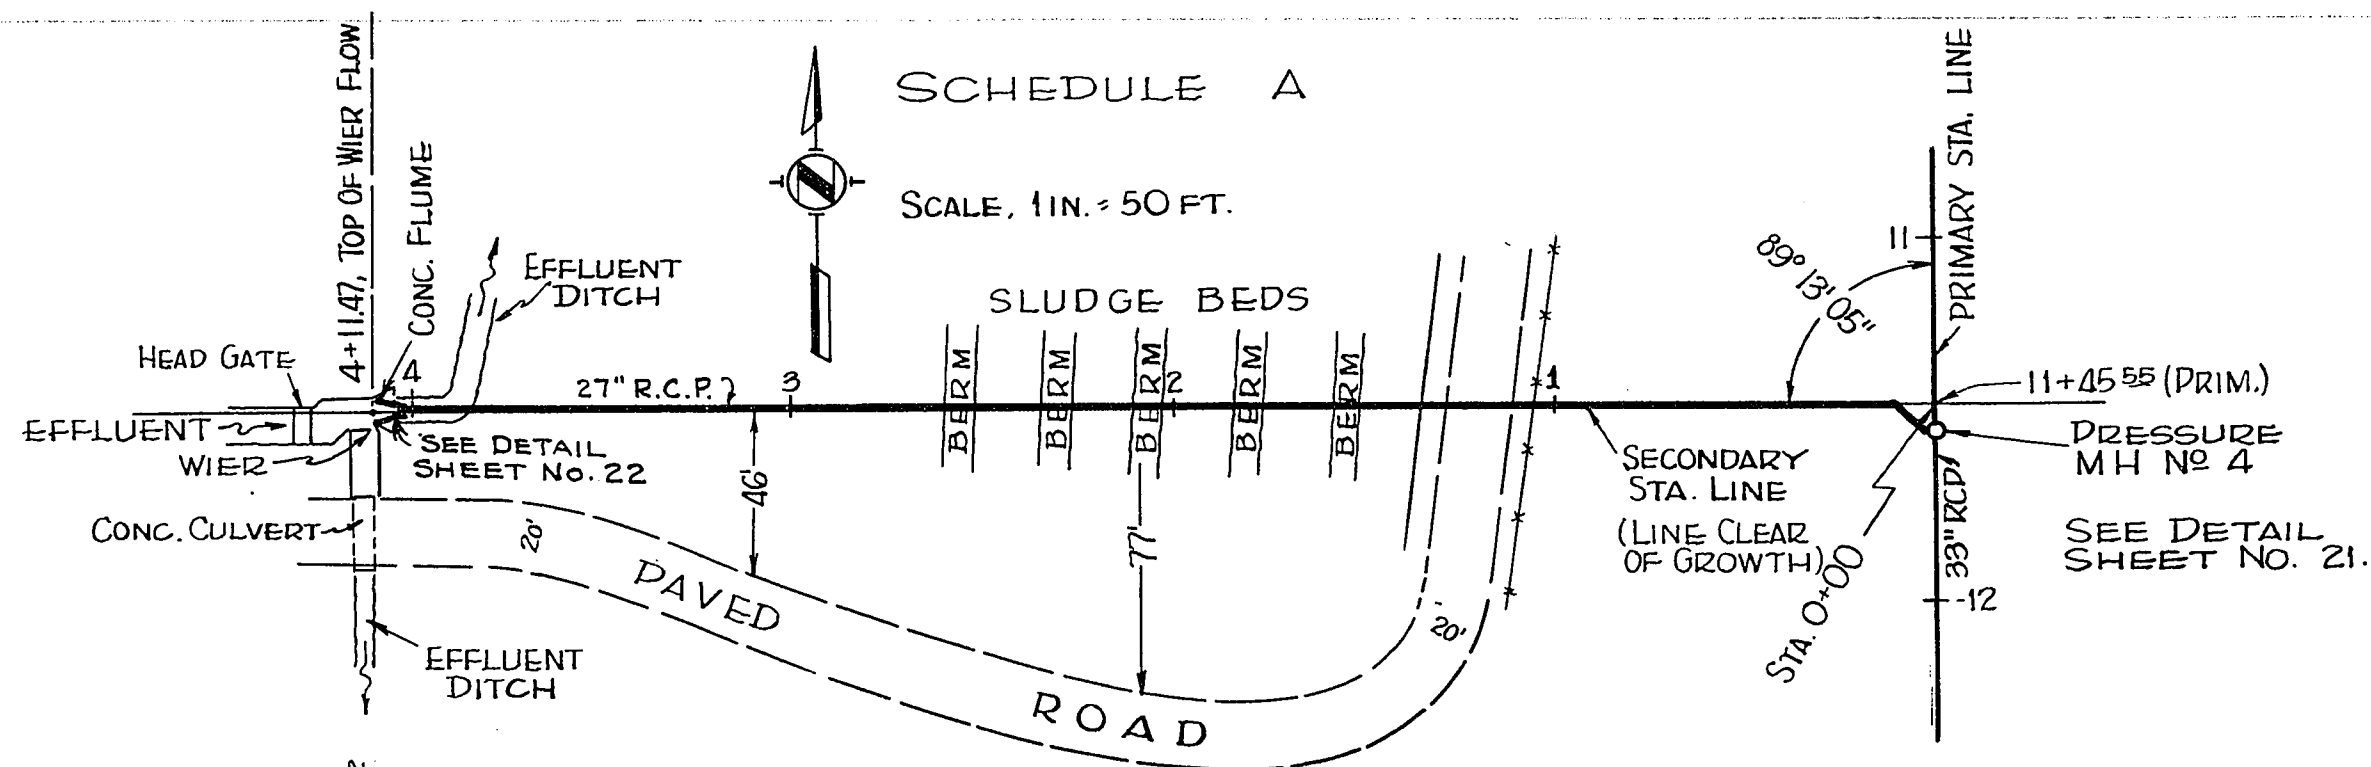

OUTFALL SEWER, LINE "C"

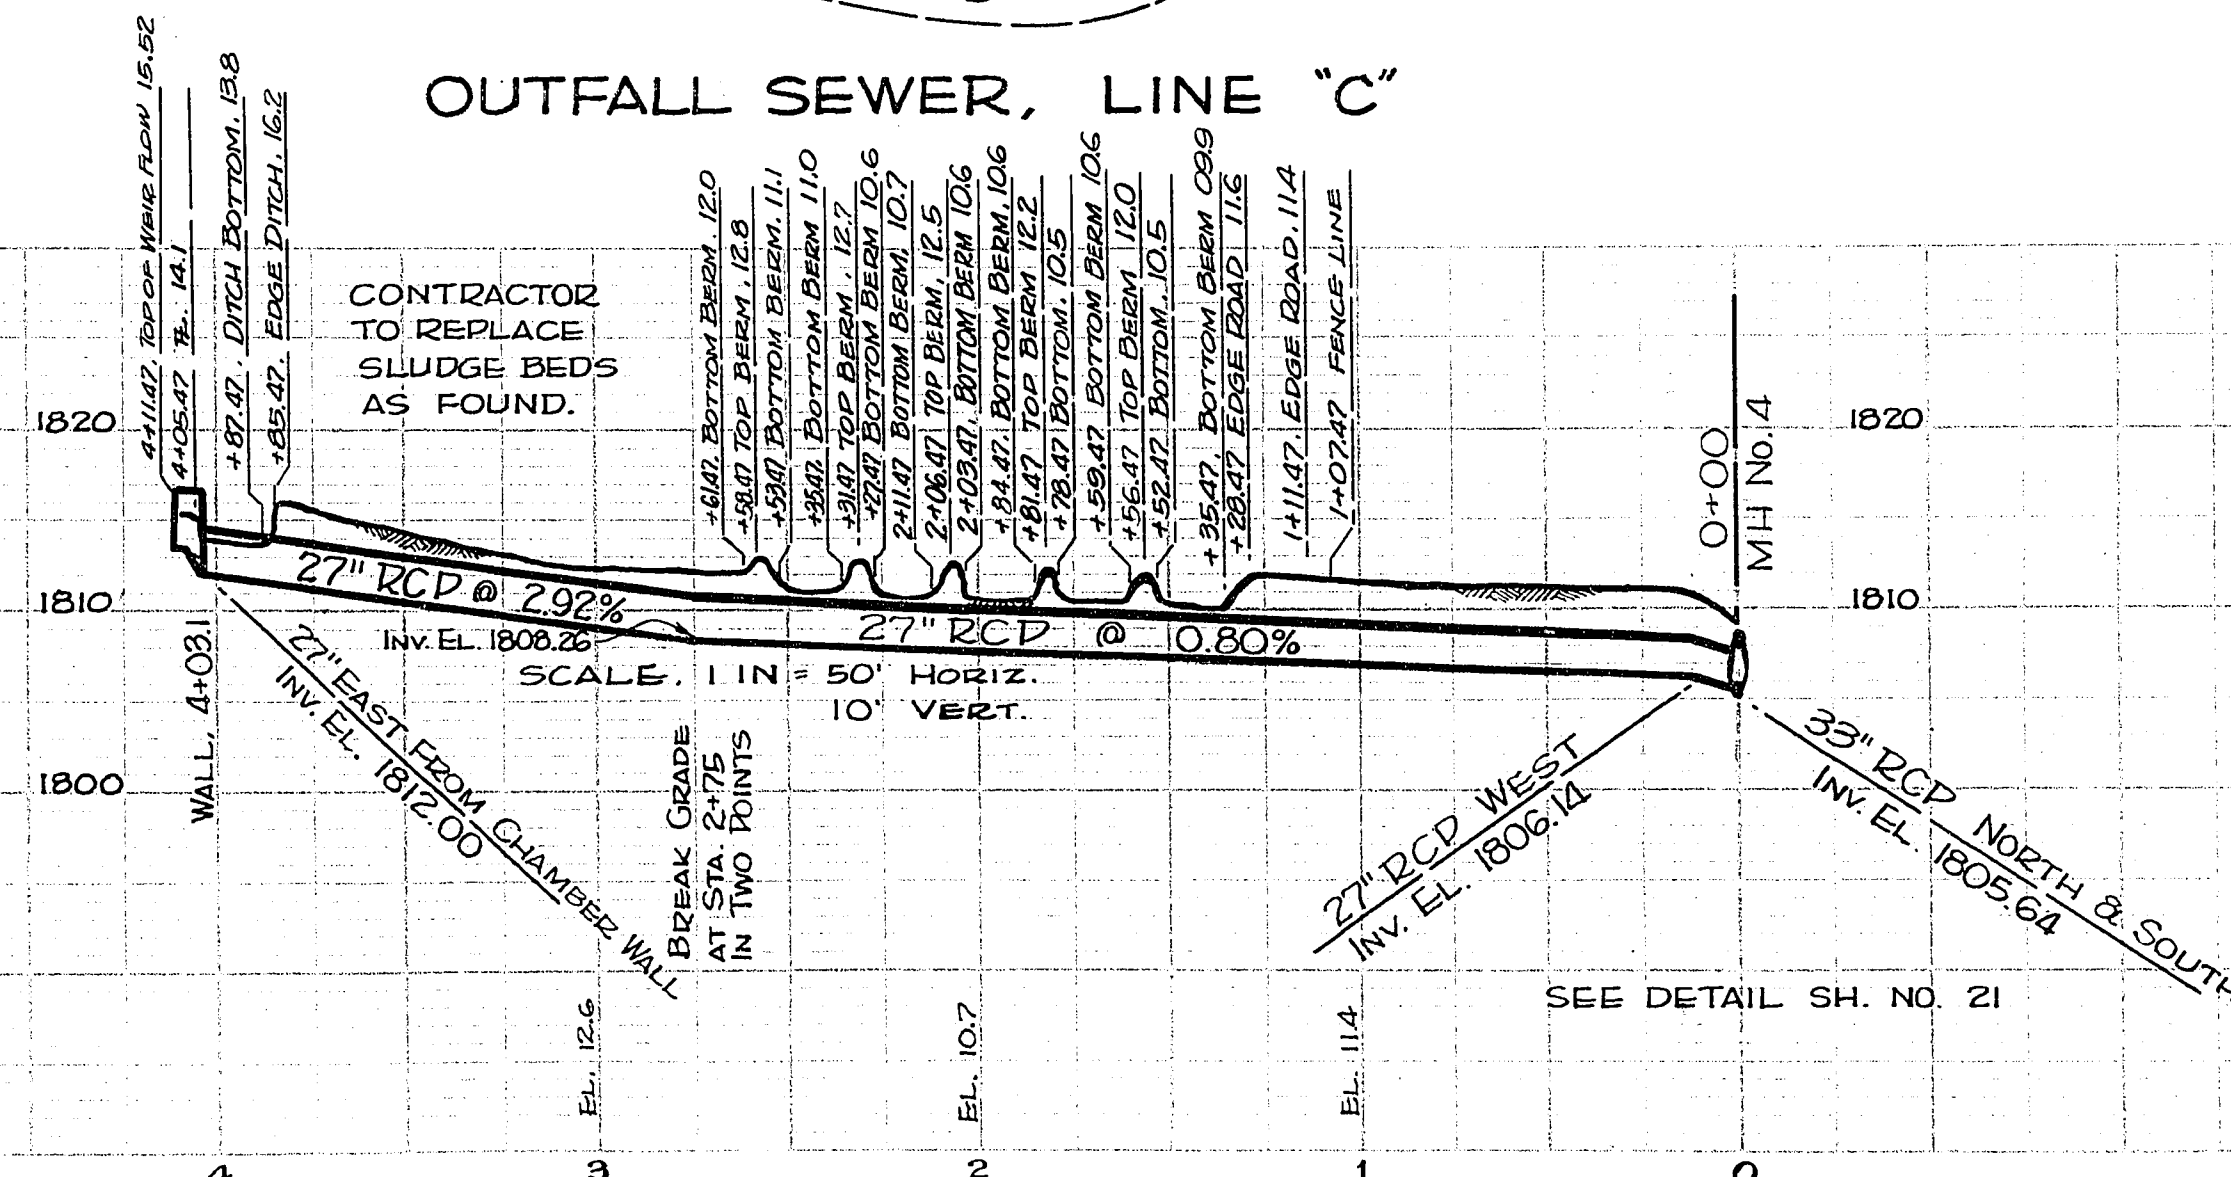

As Built  
SCALE, 1" = 50' HOR.  
10' VERT.

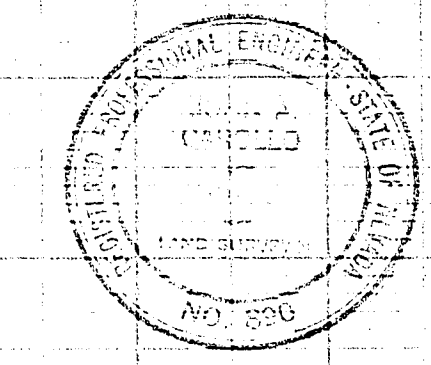

HEADMAN, FERGUSON & CAROLLO PHOENIX, ARIZONA			
LAS VEGAS NEVADA			
OUTFALL SEWER & OUTFALL SEWER LINE C			
DESIGNED G.C.W.	CHECKED P.A.G.	SHEET NO. 15	TOTAL SHEETS 22
DRAWN G.C.W.		REVISIONS	3682-B-1056

14-1-76 307-V-242