


SCHEDULE B

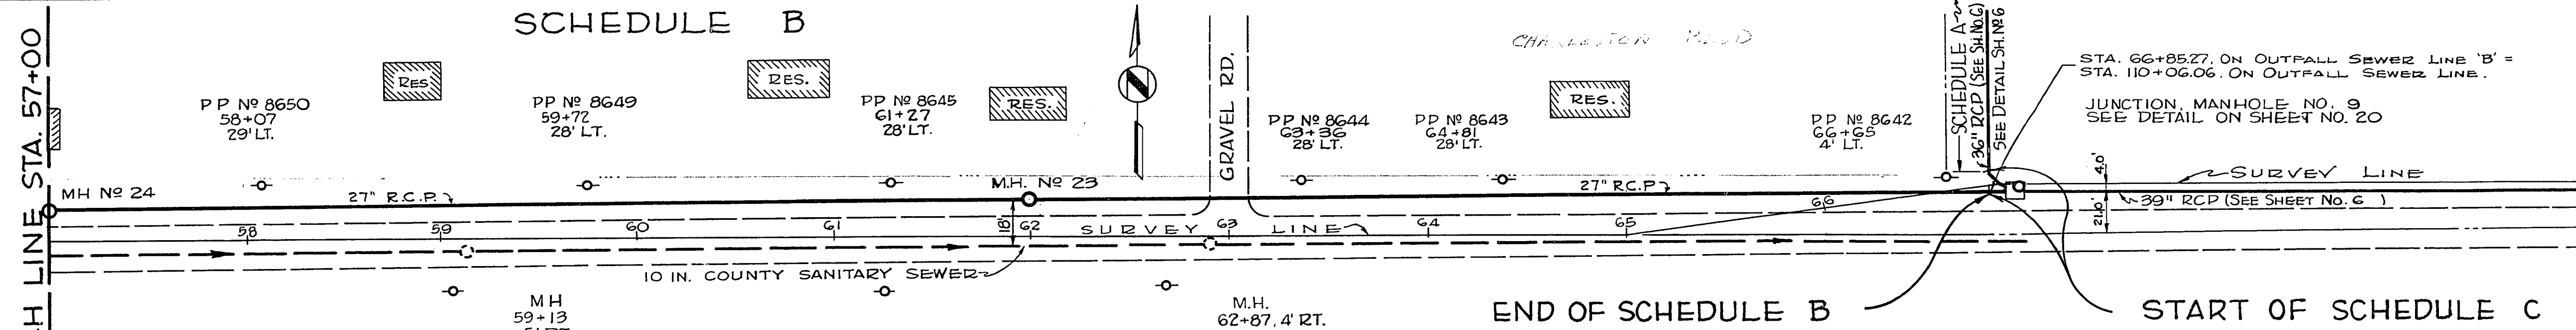


END OF SCHEDULE B

START OF SCHEDULE C



SCALE, 1" = 50' HOR.  
10' VERT.

As Built

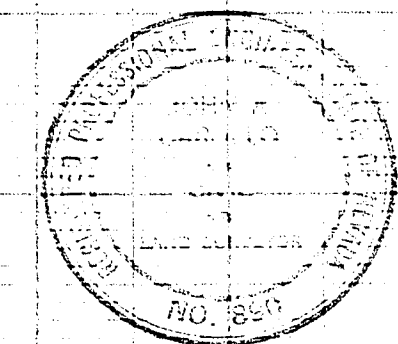

HEADMAN, FERGUSON & CAROLLO			
PHOENIX, ARIZONA			
LAS VEGAS			
NEVADA			
OUTFALL SEWER			
LINE B			
DESIGNED G.C.#	CHECKED J.F.S.	SHEET NO. 18	3679-B-1056
DRAWN G.C.#	TRACED P.A.S.	REVISIONS MAY 1956 TOTAL SHEETS 22	

307-4242