




PLAN
PRESENT SITUATION
AT STA. 0+00, SCHEDULE 'A'

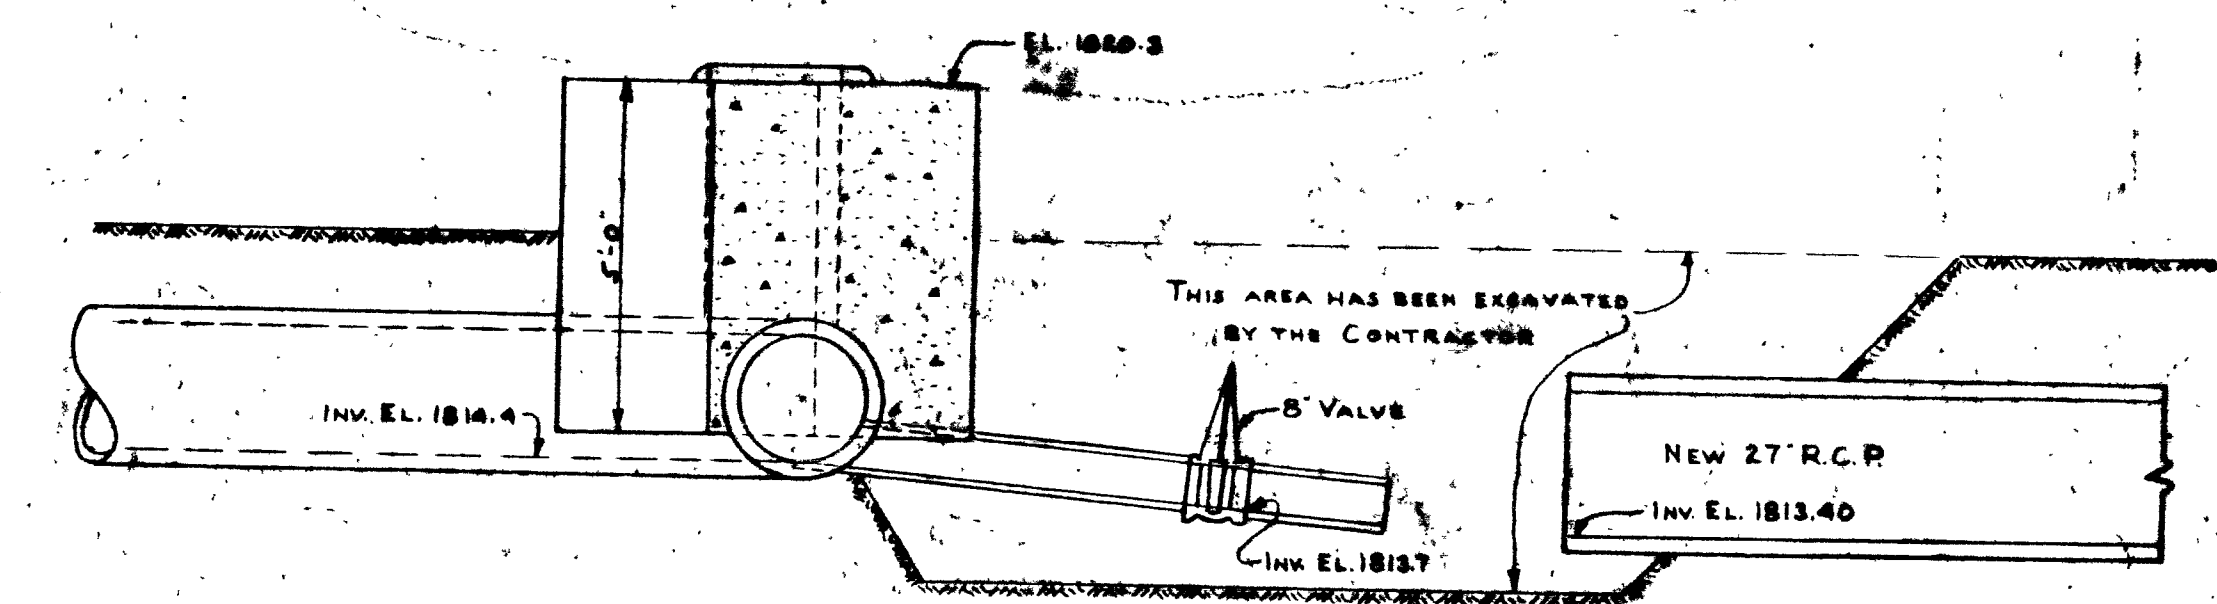


SECTION P-P

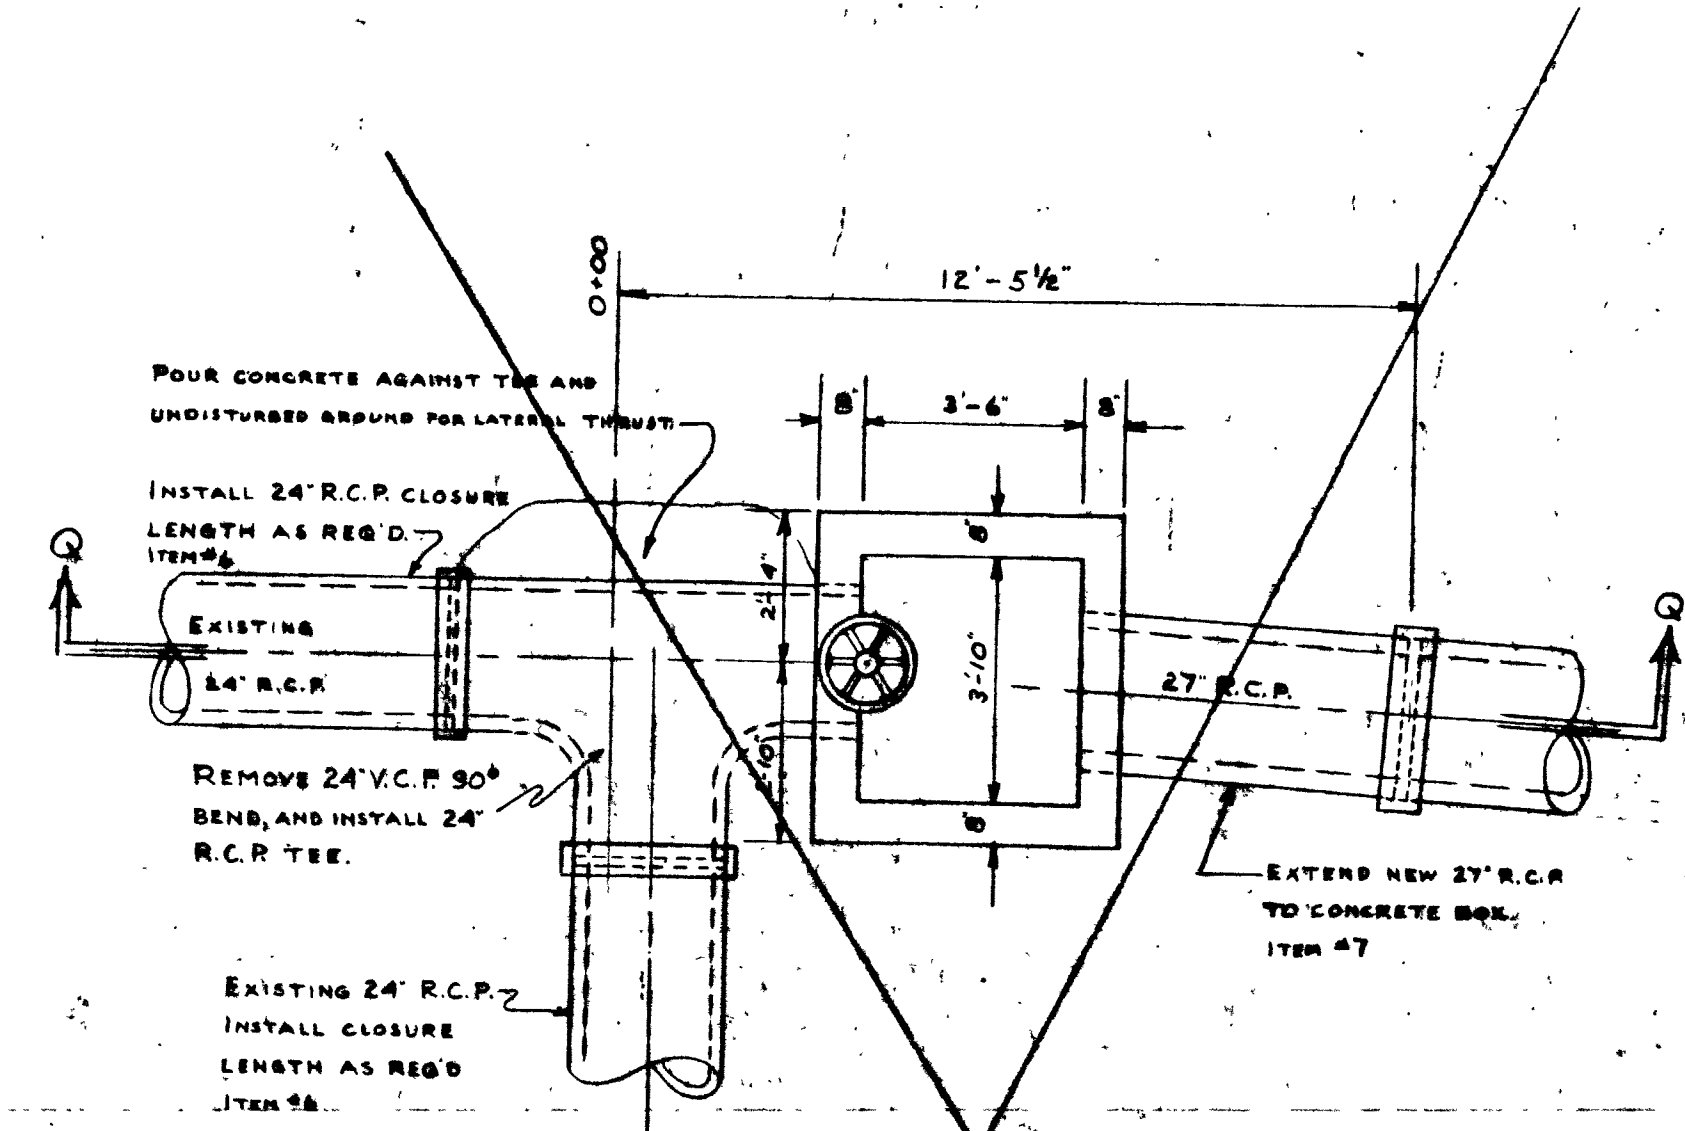


PLAN
CONNECTION WITH TEE

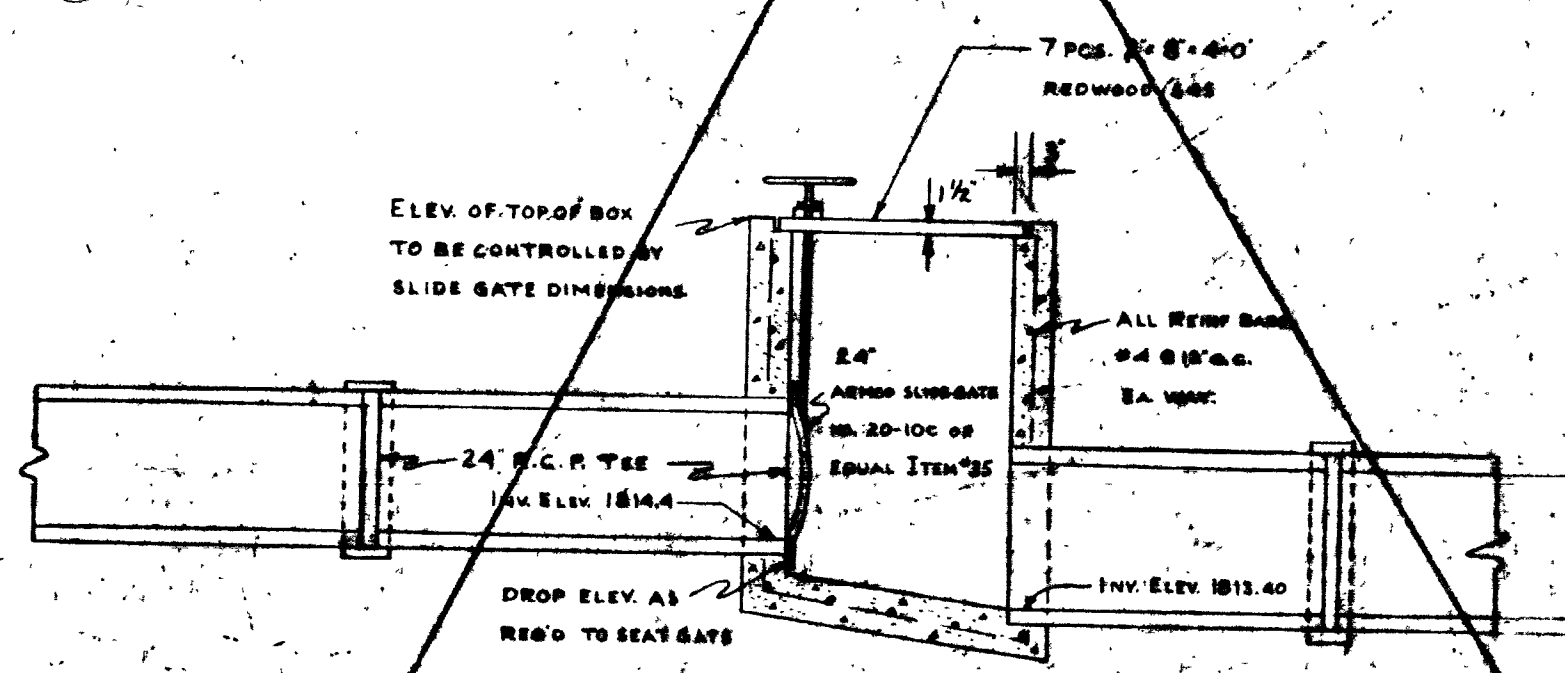

SECTION Q-Q

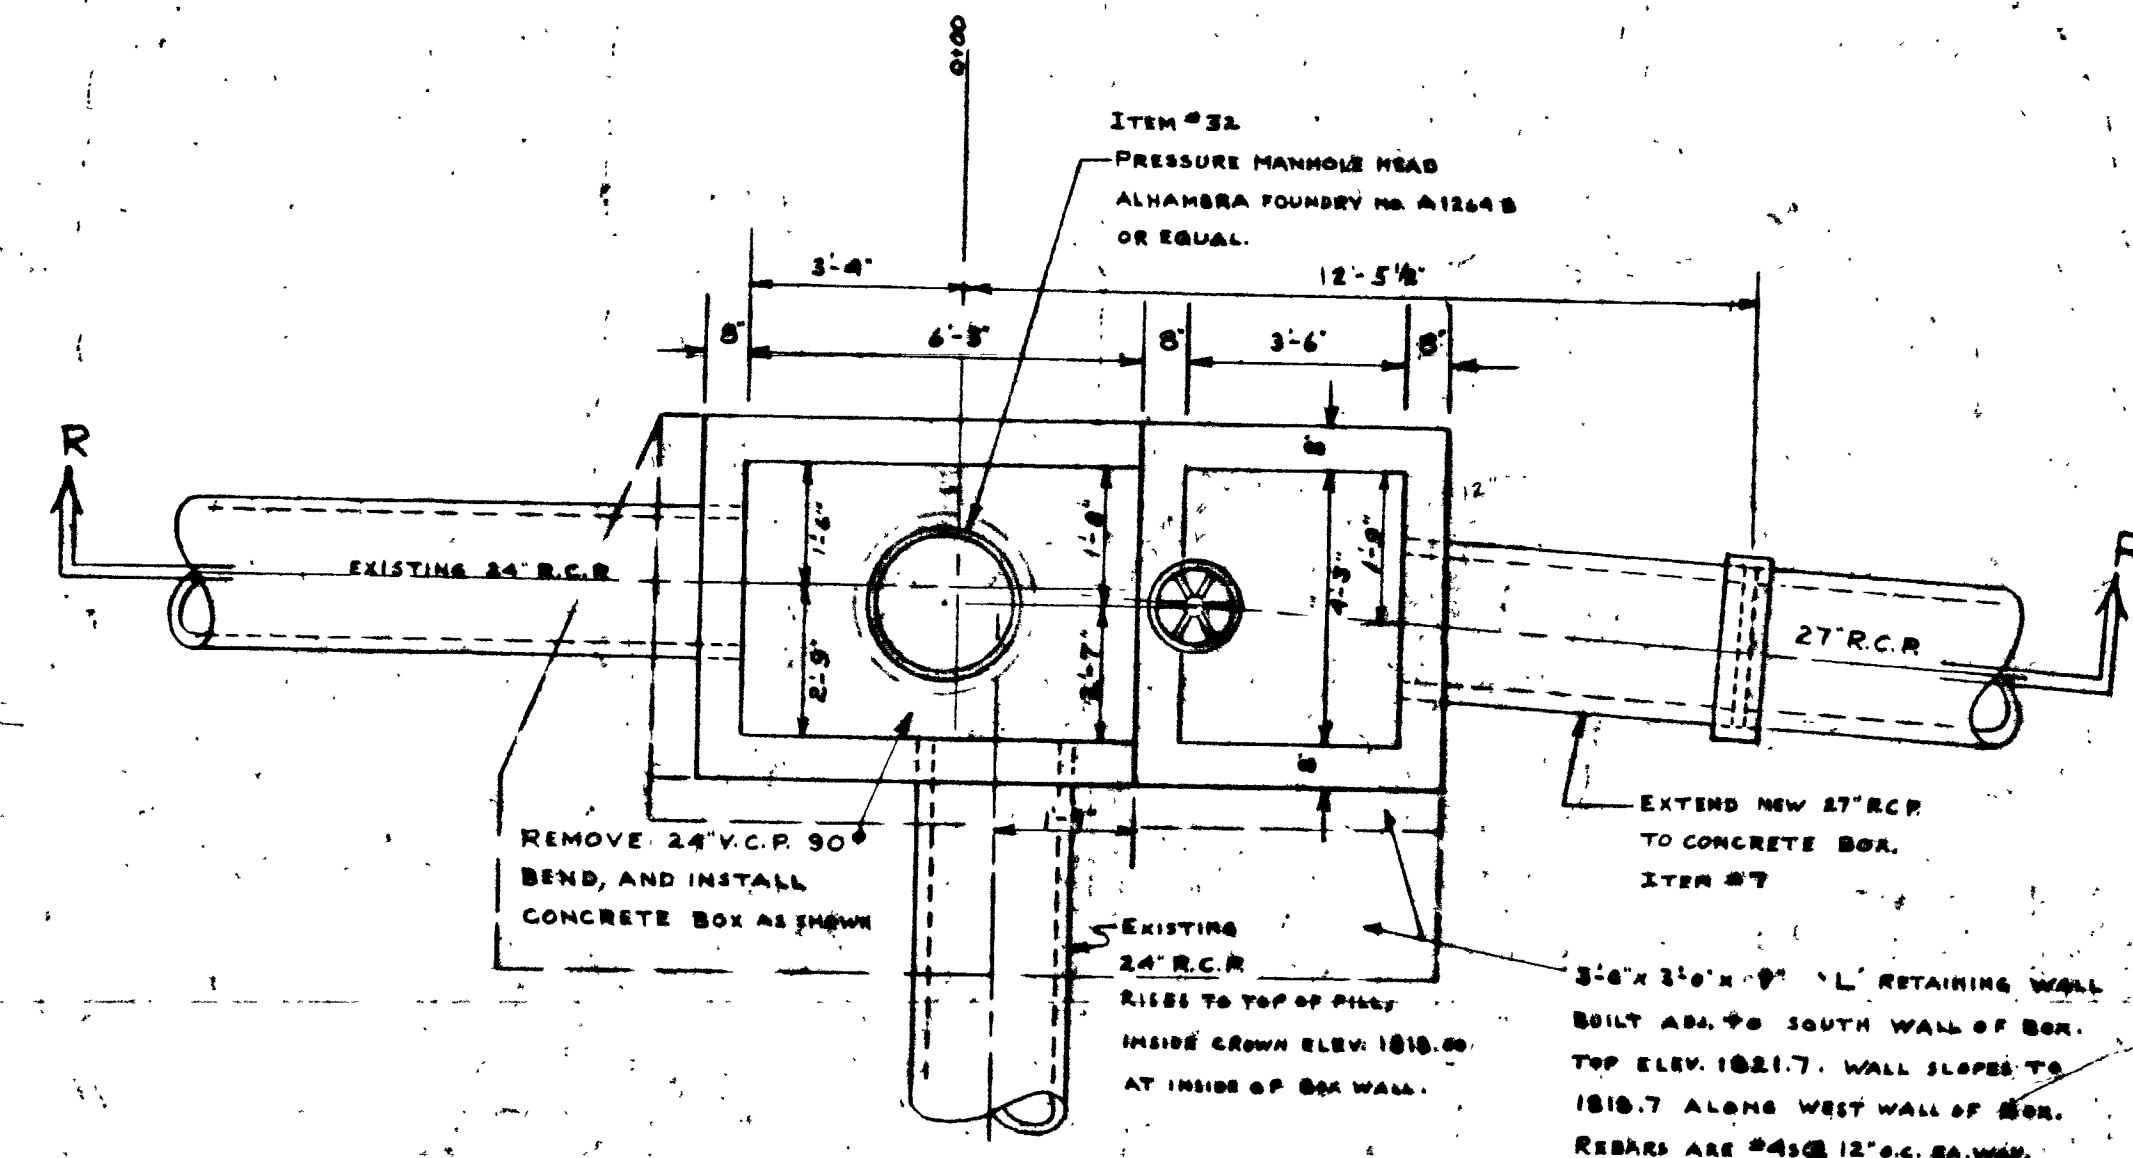

PLAN 'B'
CONNECTION WITH
CONCRETE BOX.

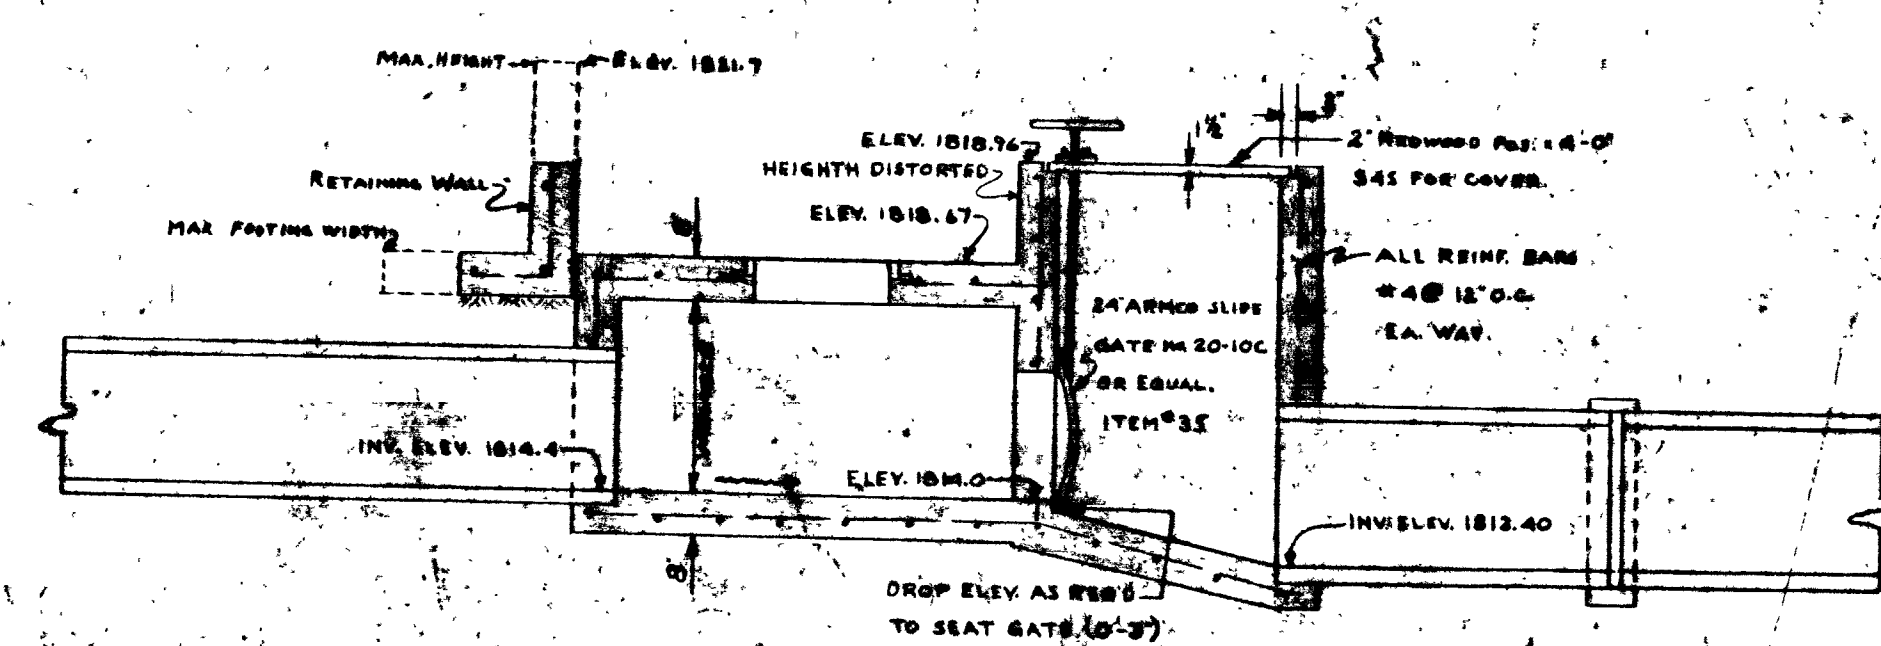

SECTION R-R

AS BUILT 2/1/57

at hand #19157

HEADMAN, FERGUSON & CAROLLO PHOENIX, ARIZONA			
LAS VEGAS NEVADA			
OUTFALL SEWER MODIFICATION AT STA. 0+00 LINE A			
DESIGNED BY R.C.W.	CHECKED BY R.C.W.	DATE JAN 1957	SCALE AS SHOWN
			21A

