

7-6-56

MONUMENT TIE MAP MAP OF VICTORIA VERDE I

LEGEND

- BLOCK NUMBER
- LOT NUMBER
- ⊙ 88' PAD ELEVATION
- ⊙ CURVE NUMBER
- TC TOP CURB ELEV.
- FL FINISH GRADE ELEV.
- AC TOP AC ELEV.
- (90?) EXIST. ELEV.
- 98' FINISH GRADE


CURVE DATA				
No	A	L	T	
1	08°30'14"	150.00'	22.26'	11.15'
2	21°26'50"	150.00'	56.15'	28.91'
3	28°12'40"	150.00'	73.86'	37.65'
4	28°12'40"	129.50'	63.76'	32.94'
5	21°26'50"	170.50'	63.82'	32.29'
6	82°18'53"	20.00'	28.73'	17.48'
7	89°10'53"	20.00'	31.13'	19.72'
8	90°35'06"	20.00'	31.62'	20.21'

BENCH MARK


CLV# 06036 C3
SE COR. OF MALLARD AND
ACRON
ELEV. 2291.72'

NOTES

- CONTRACTOR SHALL FAMILIARIZE HIMSELF WITH THE SOILS REPORT PREPARED BY
- ROUGH GRADE = FINISH GRADE MINUS 0.4' FOR TOP SOIL.
- ALL WORK AND MATERIAL TO CONFORM TO CITY OF LAS VEGAS STANDARDS
- 100W - HPS STREET LIGHT

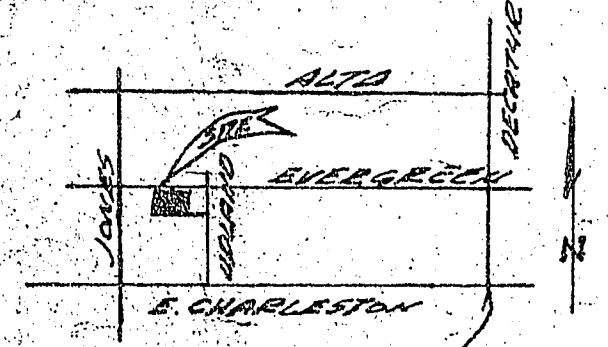

VICINITY MAP NO SCALE

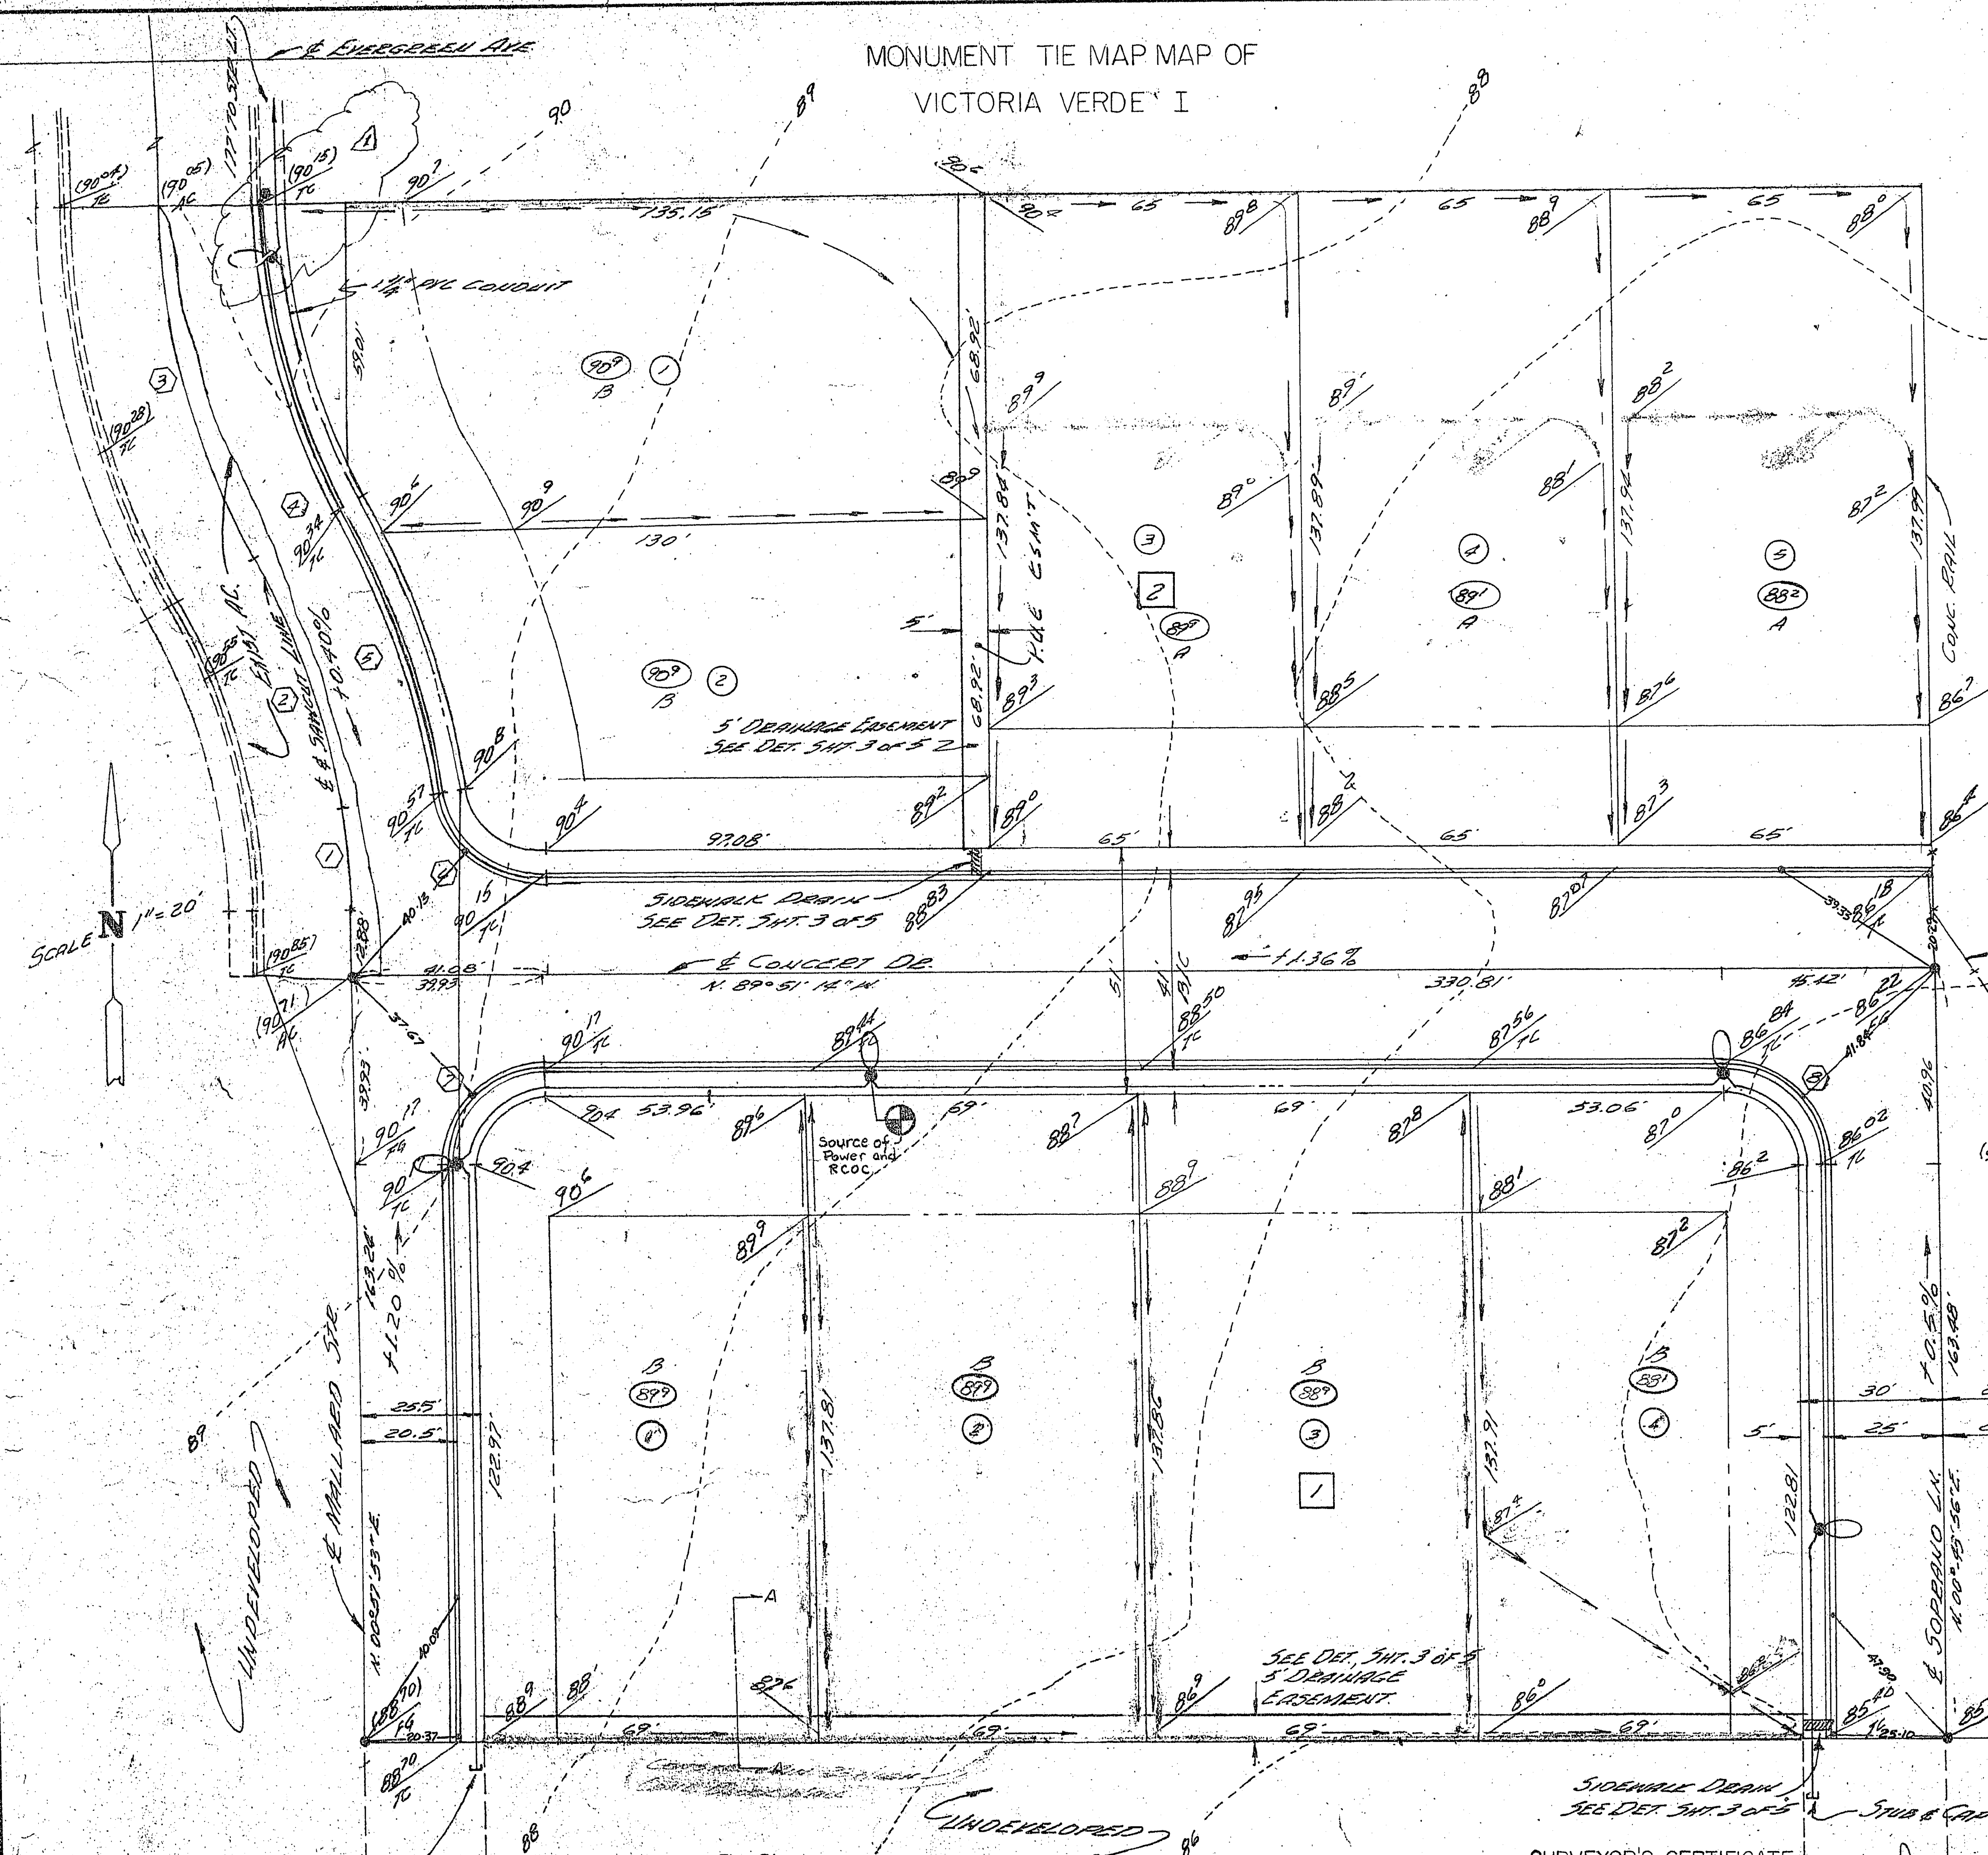

APPROVAL

- Evan Williams* 6-13-79 DATE
C.E.V. ELECTRICAL ENGINEER
- B. Danik* 11-16-77 DATE
MEMPHIS FENCE CO.
- Robert Sims* 11-16-77 DATE
CIVIL ELECTRICAL DEPT.
- John* 11-16-77 DATE
CIVIL ENGINEER
- E. J. Wilson* 11-16-77 DATE
CIVIL QUALITY CONTROL ENGINEER
- Robert* 11-27-77 DATE
CIVIL FIELD OPERATIONS ENGINEER

ENGINEER'S CERTIFICATE

THIS EXHIBIT COMPLIES WITH F.H.A. MINIMUM STANDARDS AND LOCAL ACCEPTABLE STANDARDS AND REQUIREMENTS.

Mark L. Rupp 10-4-78
MARK L. RUPP
R.P.E. #1726

SURVEYOR'S CERTIFICATE

I, RICHARD L. HAFEN, A REGISTERED LAND SURVEYOR, DO HEREBY CERTIFY THAT THE MONUMENTS HAVE BEEN SET AND THE TIES ESTABLISHED AS SHOWN HEREON.

Richard L. Hafen 5/27/80
RICHARD L. HAFEN DATE
R. L. S. 4428

- SET CONC. MONUMENT
- SET LEAD AND TACK IN TOP OF CURB

SECTION A-A
NO SCALE

REVISION		
1	MOVED ST. LOT 70' E SOUTH	MLR 6-12-79
		EBR 6/15/79

GRADING PLAN
OFF-SITE IMPROVEMENT PLANS
FOR
BERT RAPP & EVAN WILLIAMS
SHT. 1 OF 5

05 C-3205-1