
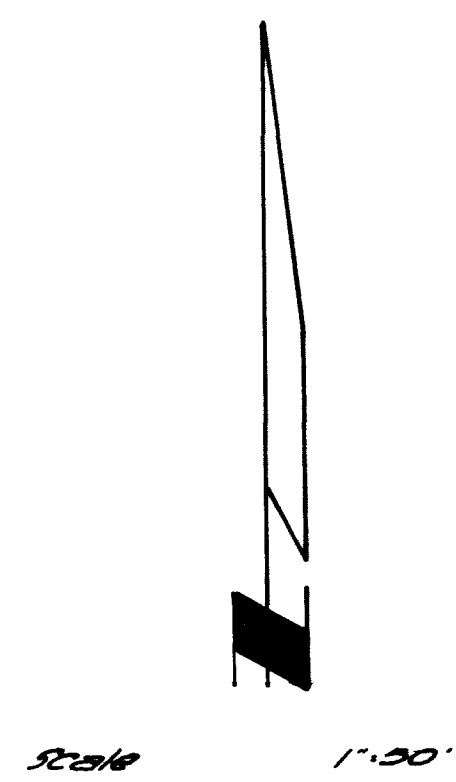


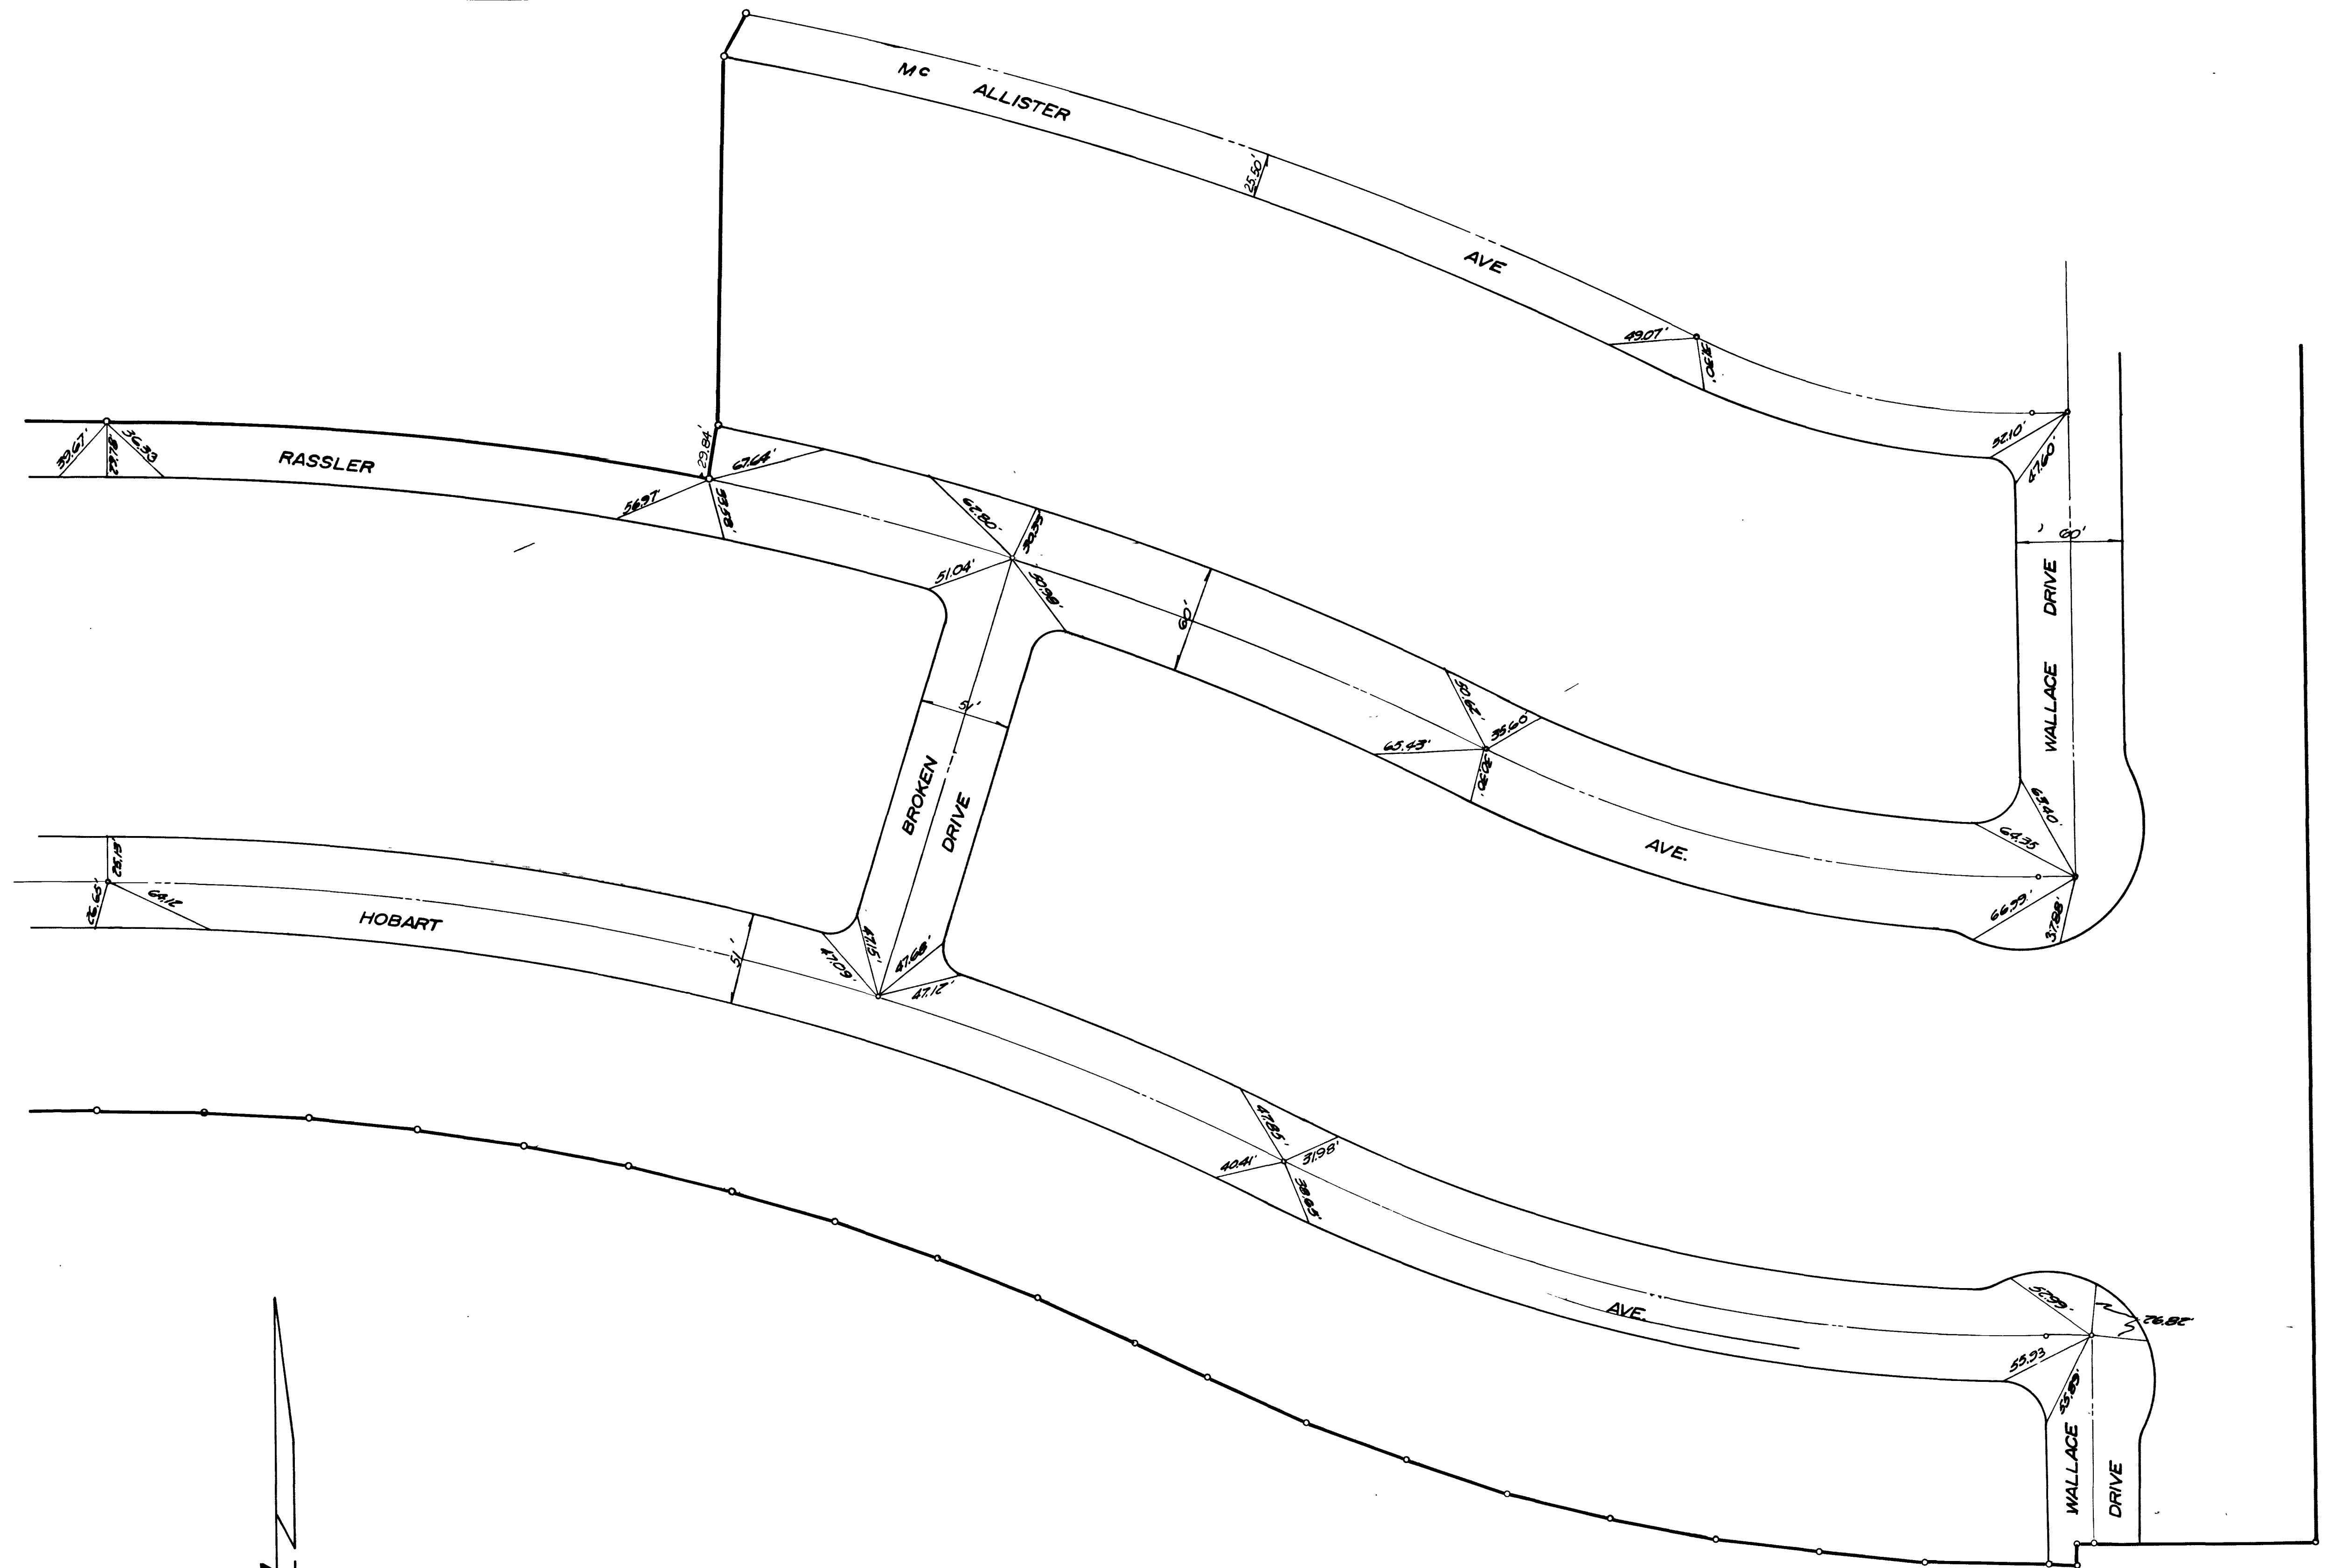


D					
C					
B					
A					
REV.	DATE	DESCRIPTION	BY	APPR.	
<u>MONUMENT MAP</u> CHARLESTON HEIGHTS TRACT NO. 29-B					
DESIGNED	WESTERN ENGINEERS, INC.				
DRAWN	R.L.	LAS VEGAS	NEVADA		SHEET 2
CHECKED	MR	APPROVED	3/31/64		OF 3

2704

058-1040-29B

058-1040-29B

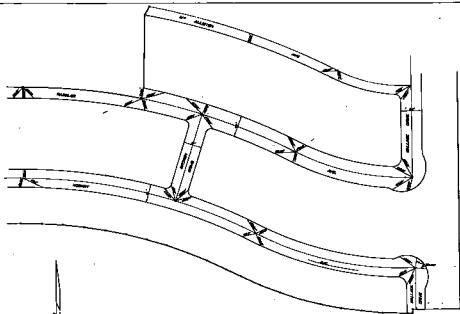

DATE	11/11/71	TIME	10:00
BY	SA [illegible]	REPORT NO.	100-100000
<u>Subject: [illegible]</u> CHARACTER: [illegible] matter In: [illegible]			
NAME	WALTER HENRIKSON, JR.		
DATE	11/11/71	TIME	10:00