


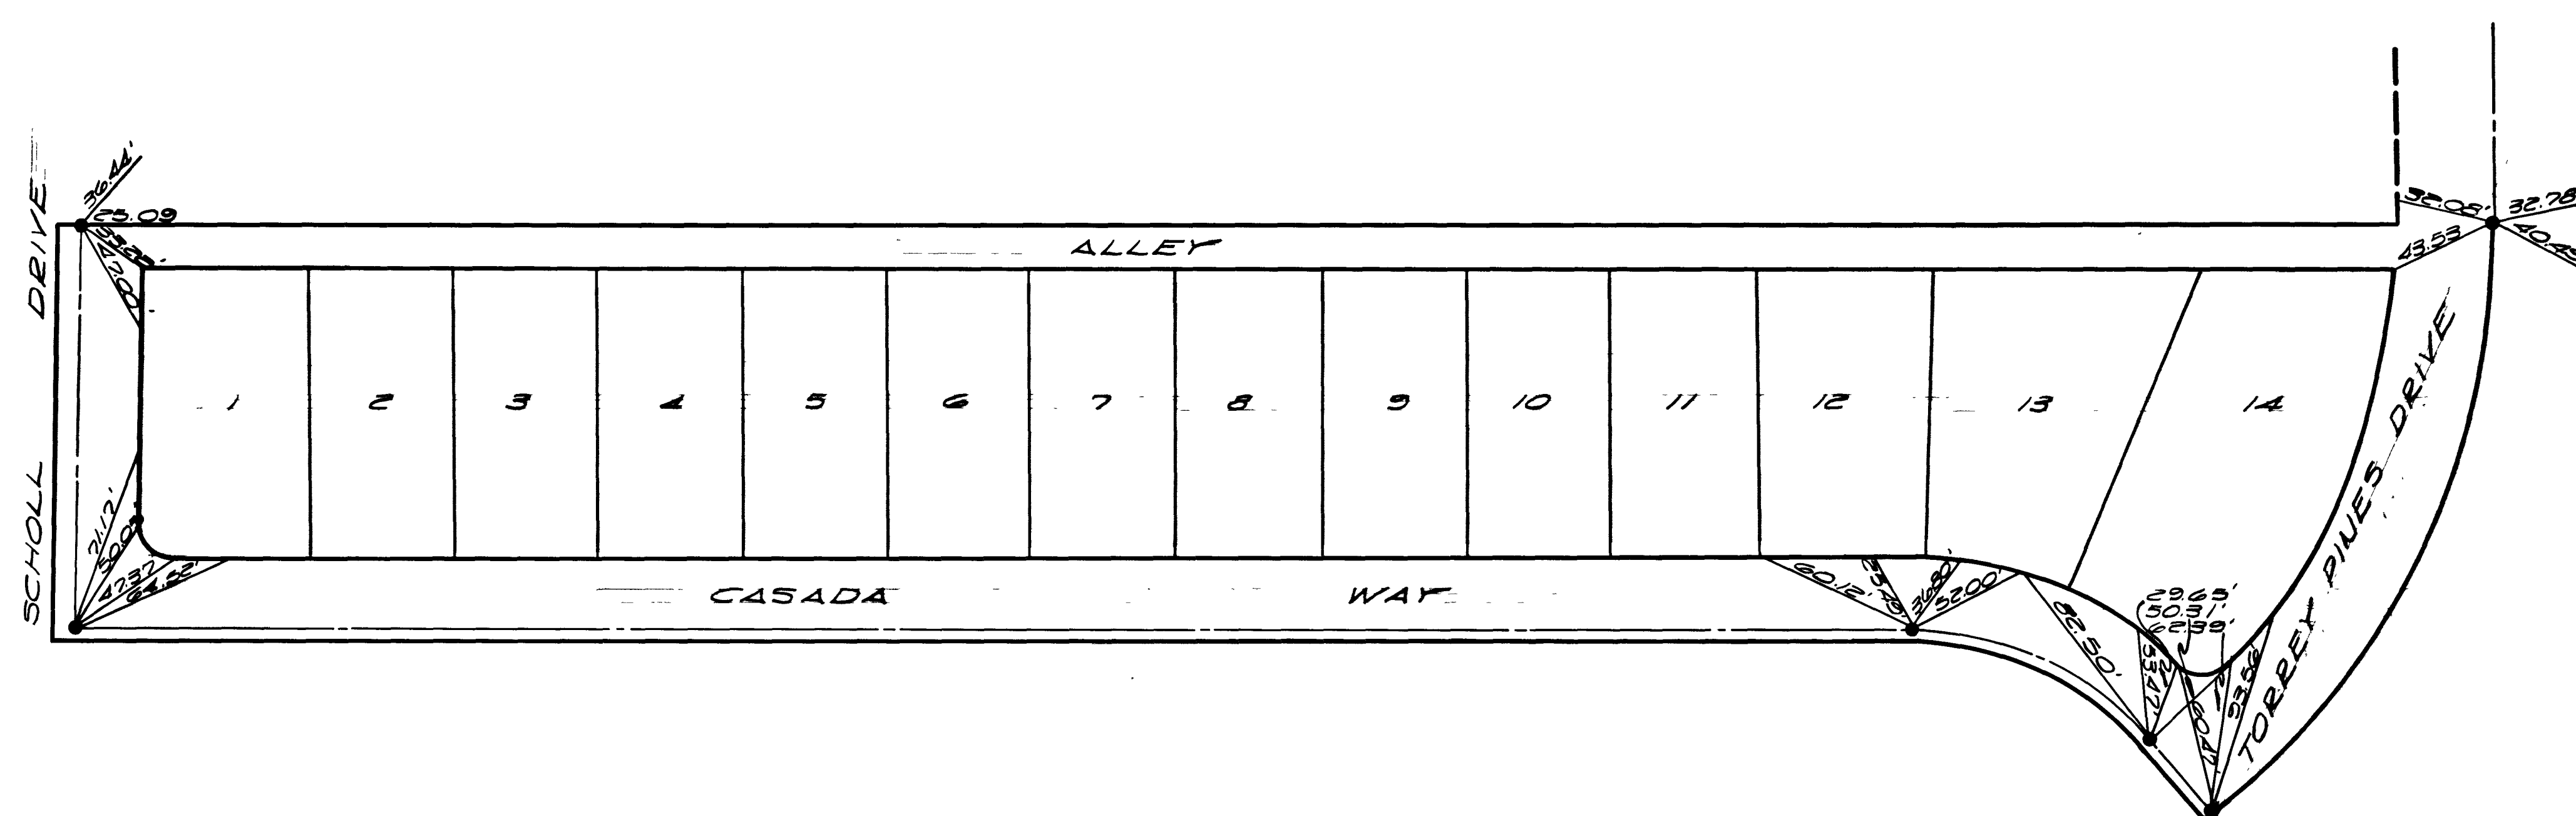

SCALE
1" = 50'

NOTES


1. MONUMENTS SET BY R.L.S. 1412.
2. ALL MONUMENT REFERENCE TIES ARE CHIS. CROSSES IN TOP OF CURB.

MONUMENT MAP	
FOR	
CHARLESTON HEIGHTS 27B	
DESIGNED BY L.S.	WESTERN ENGINEERS, INC. LAS VEGAS, NEVADA
SHEET 1 OF 1	

2701

2-b 99

058-1040-27C
058-1040-27C

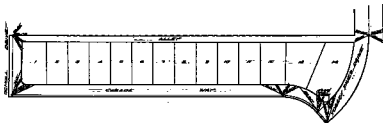

1. DIMENSIONS OF ALL PARTS
 2. DIMENSIONS OF ALL PARTS
 3. DIMENSIONS OF ALL PARTS

PRELIMINARY PLAN 1. PLAN DIMENSIONS OF ALL PARTS	
1. PLAN 2. ELEVATION 3. SECTION	1. PLAN 2. ELEVATION 3. SECTION