


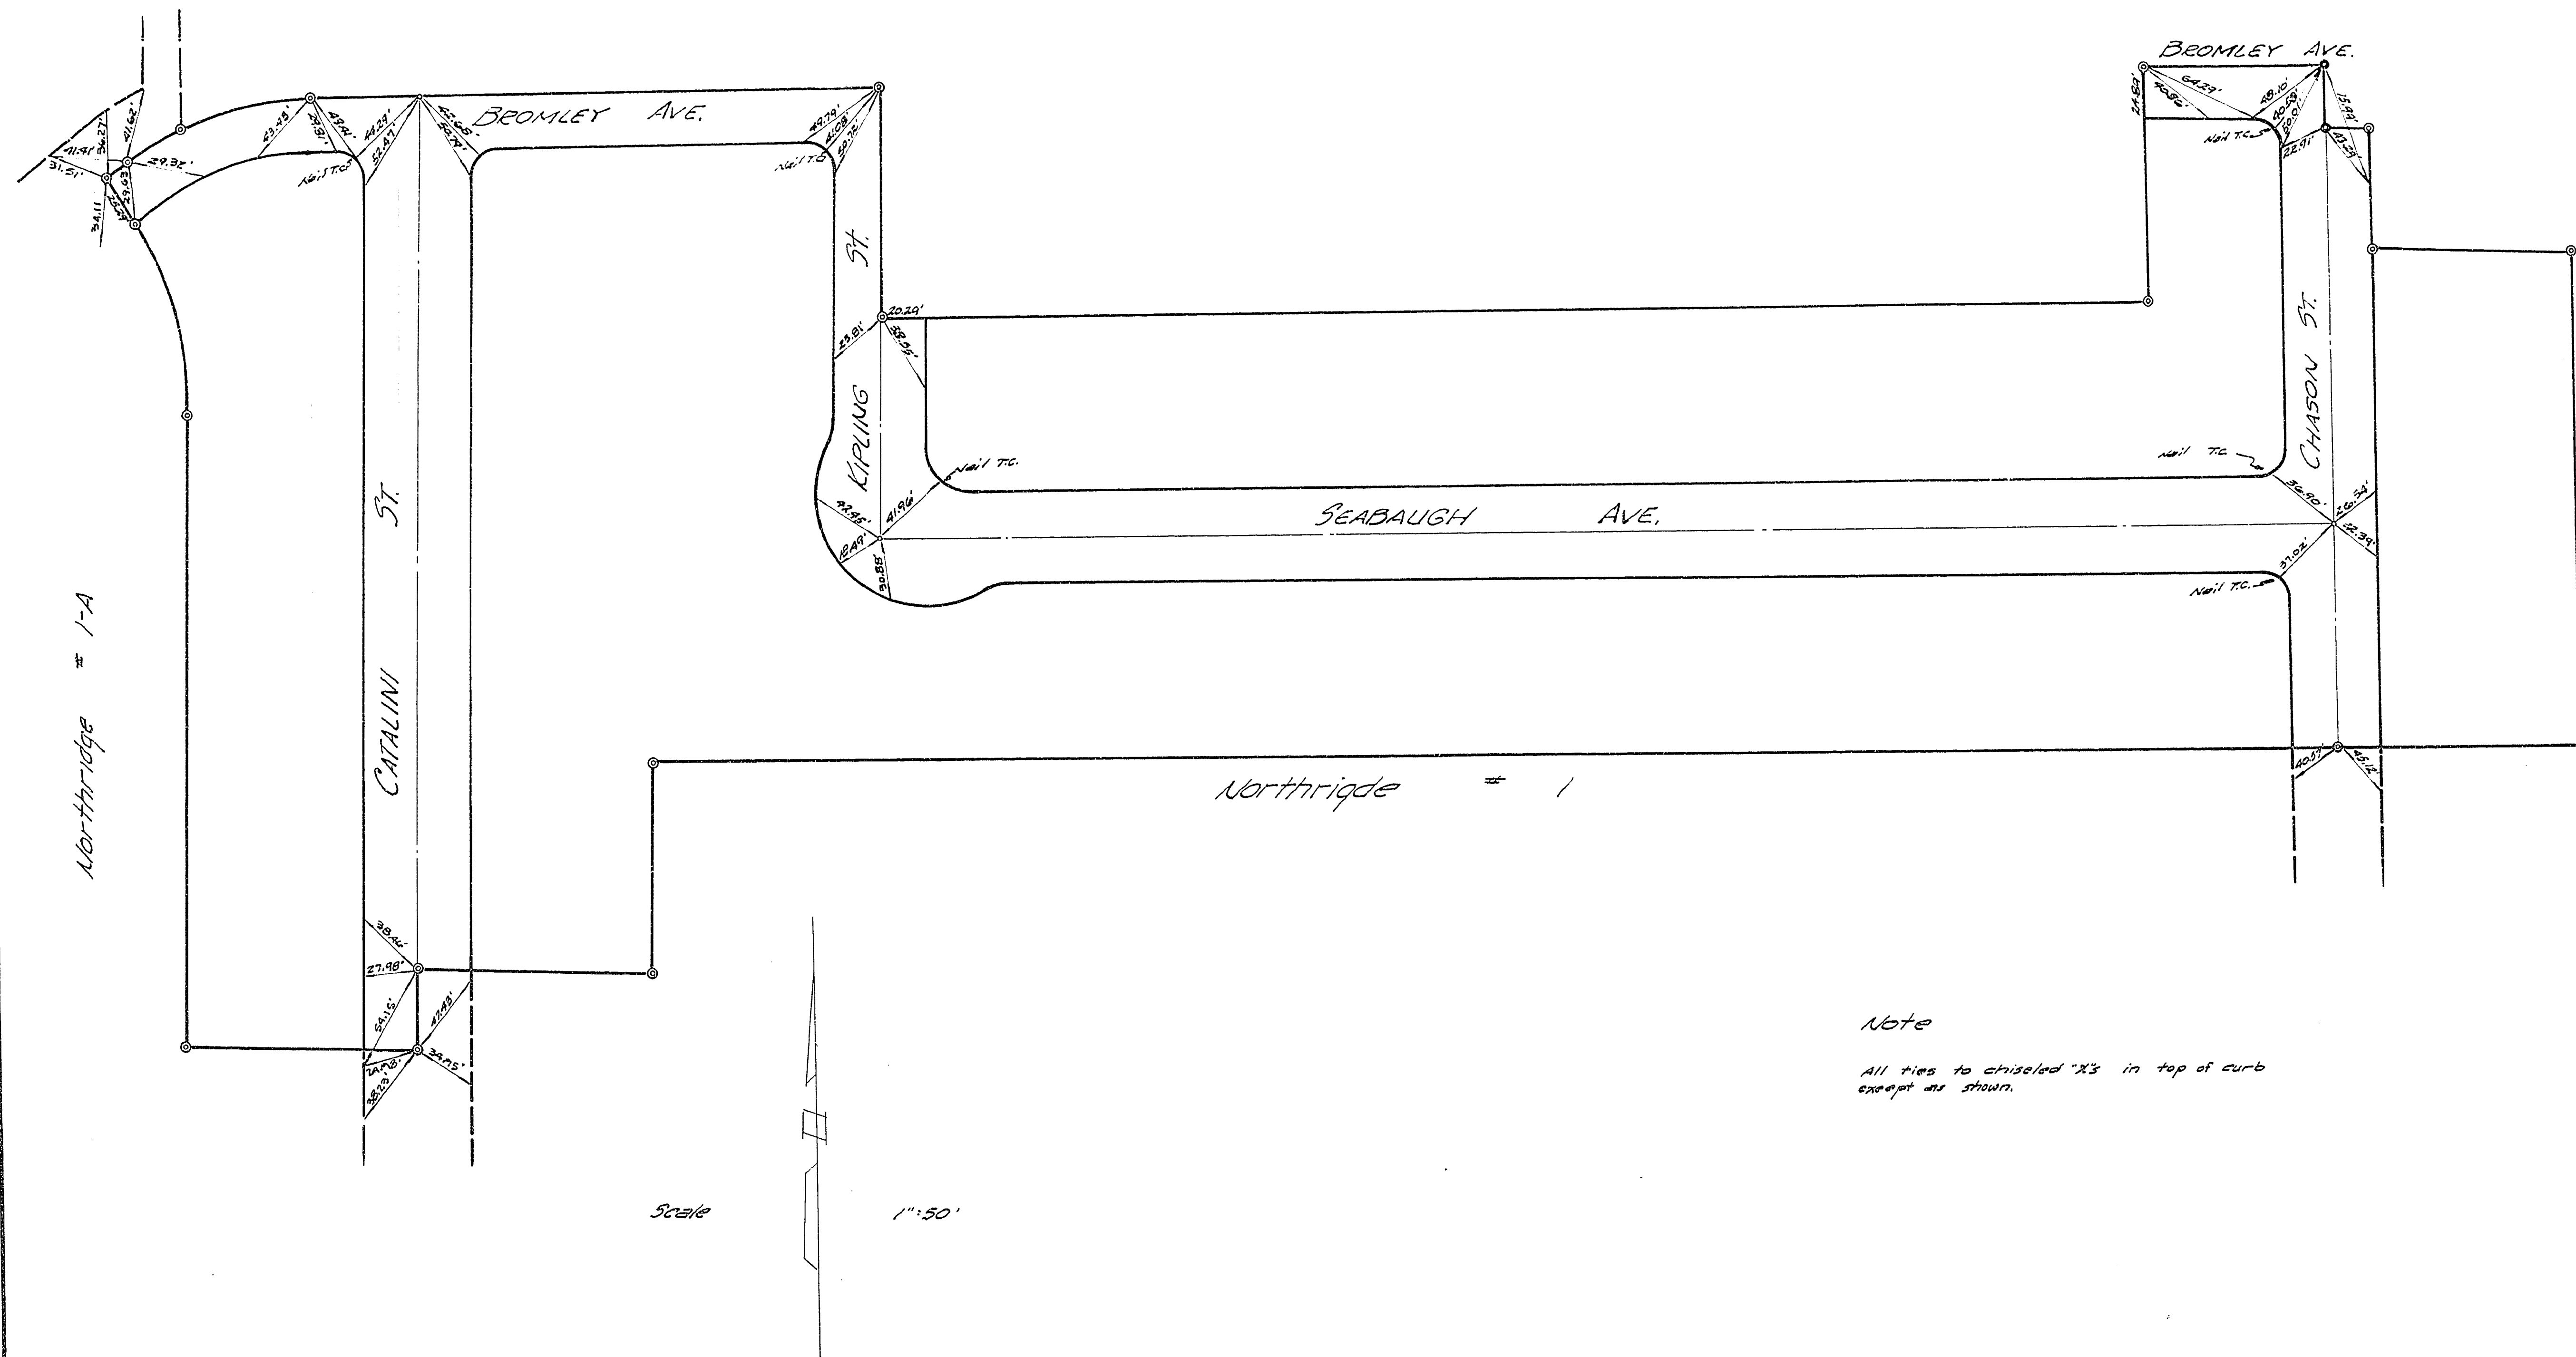

Note

All ties to chiseled "X's" in top of curb except as shown.

MONUMENT MAP		
AMENDED NORTH RIDGE UNIT #2		
DESIGNED	TROYER ENGINEERING, INC. 900 W. SUMMIT RD. SUITE D LAS VEGAS, NEVADA	SHEET 1 OF 1
DRAWN		
CHECKED		
APPROVED <i>[Signature]</i> DATE 12-10-64		

564 058-2290-2