



PLAN	DATE
	BY
NO.	SURVEYED
	NOTE BOOK
	ALIGNMENT CHECKED
	RT. OF WAY CHECKED

PROFILE	DATE
	BY
NO.	SURVEYED
	NOTE BOOK
	GRADES CHECKED
	STRUCTURE NOTATIONS CHKD

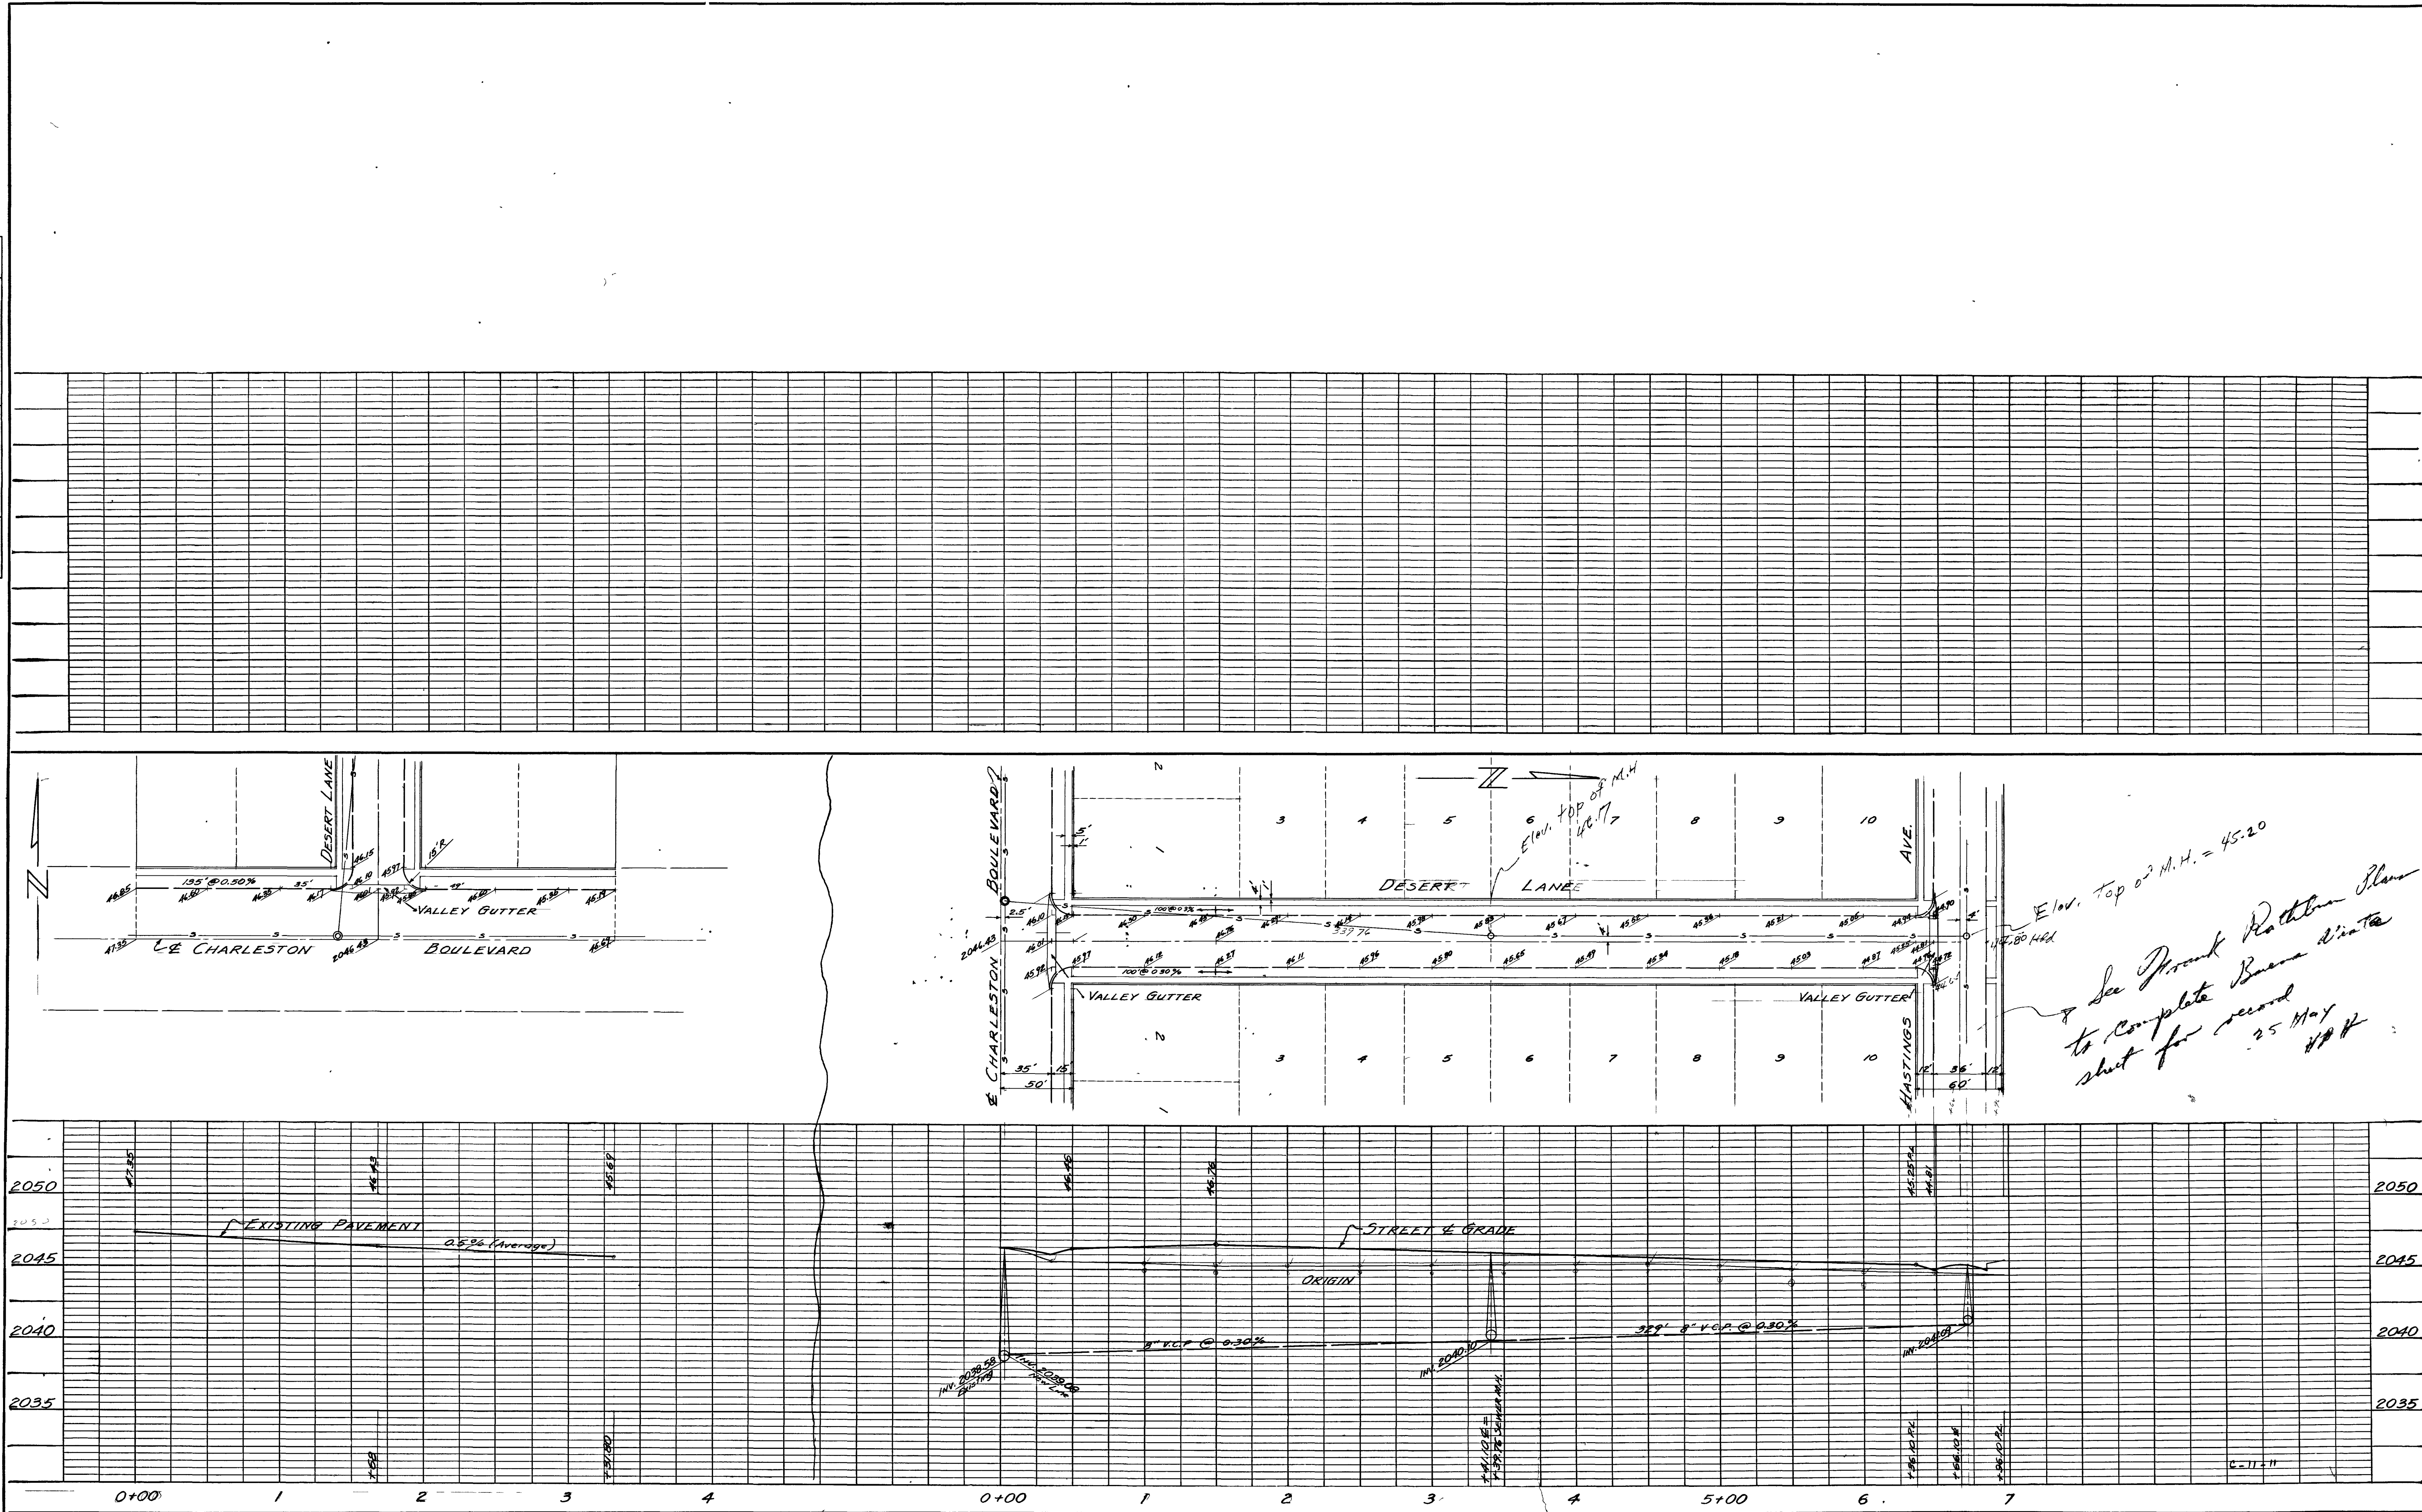

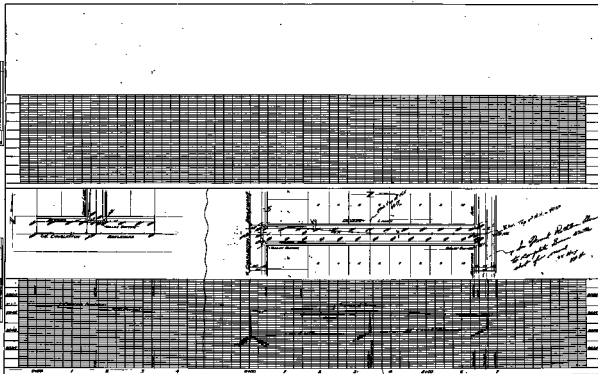

DESERT LAKE - North of Charlotte and (from High School)

St. 61 - 1077-1088