


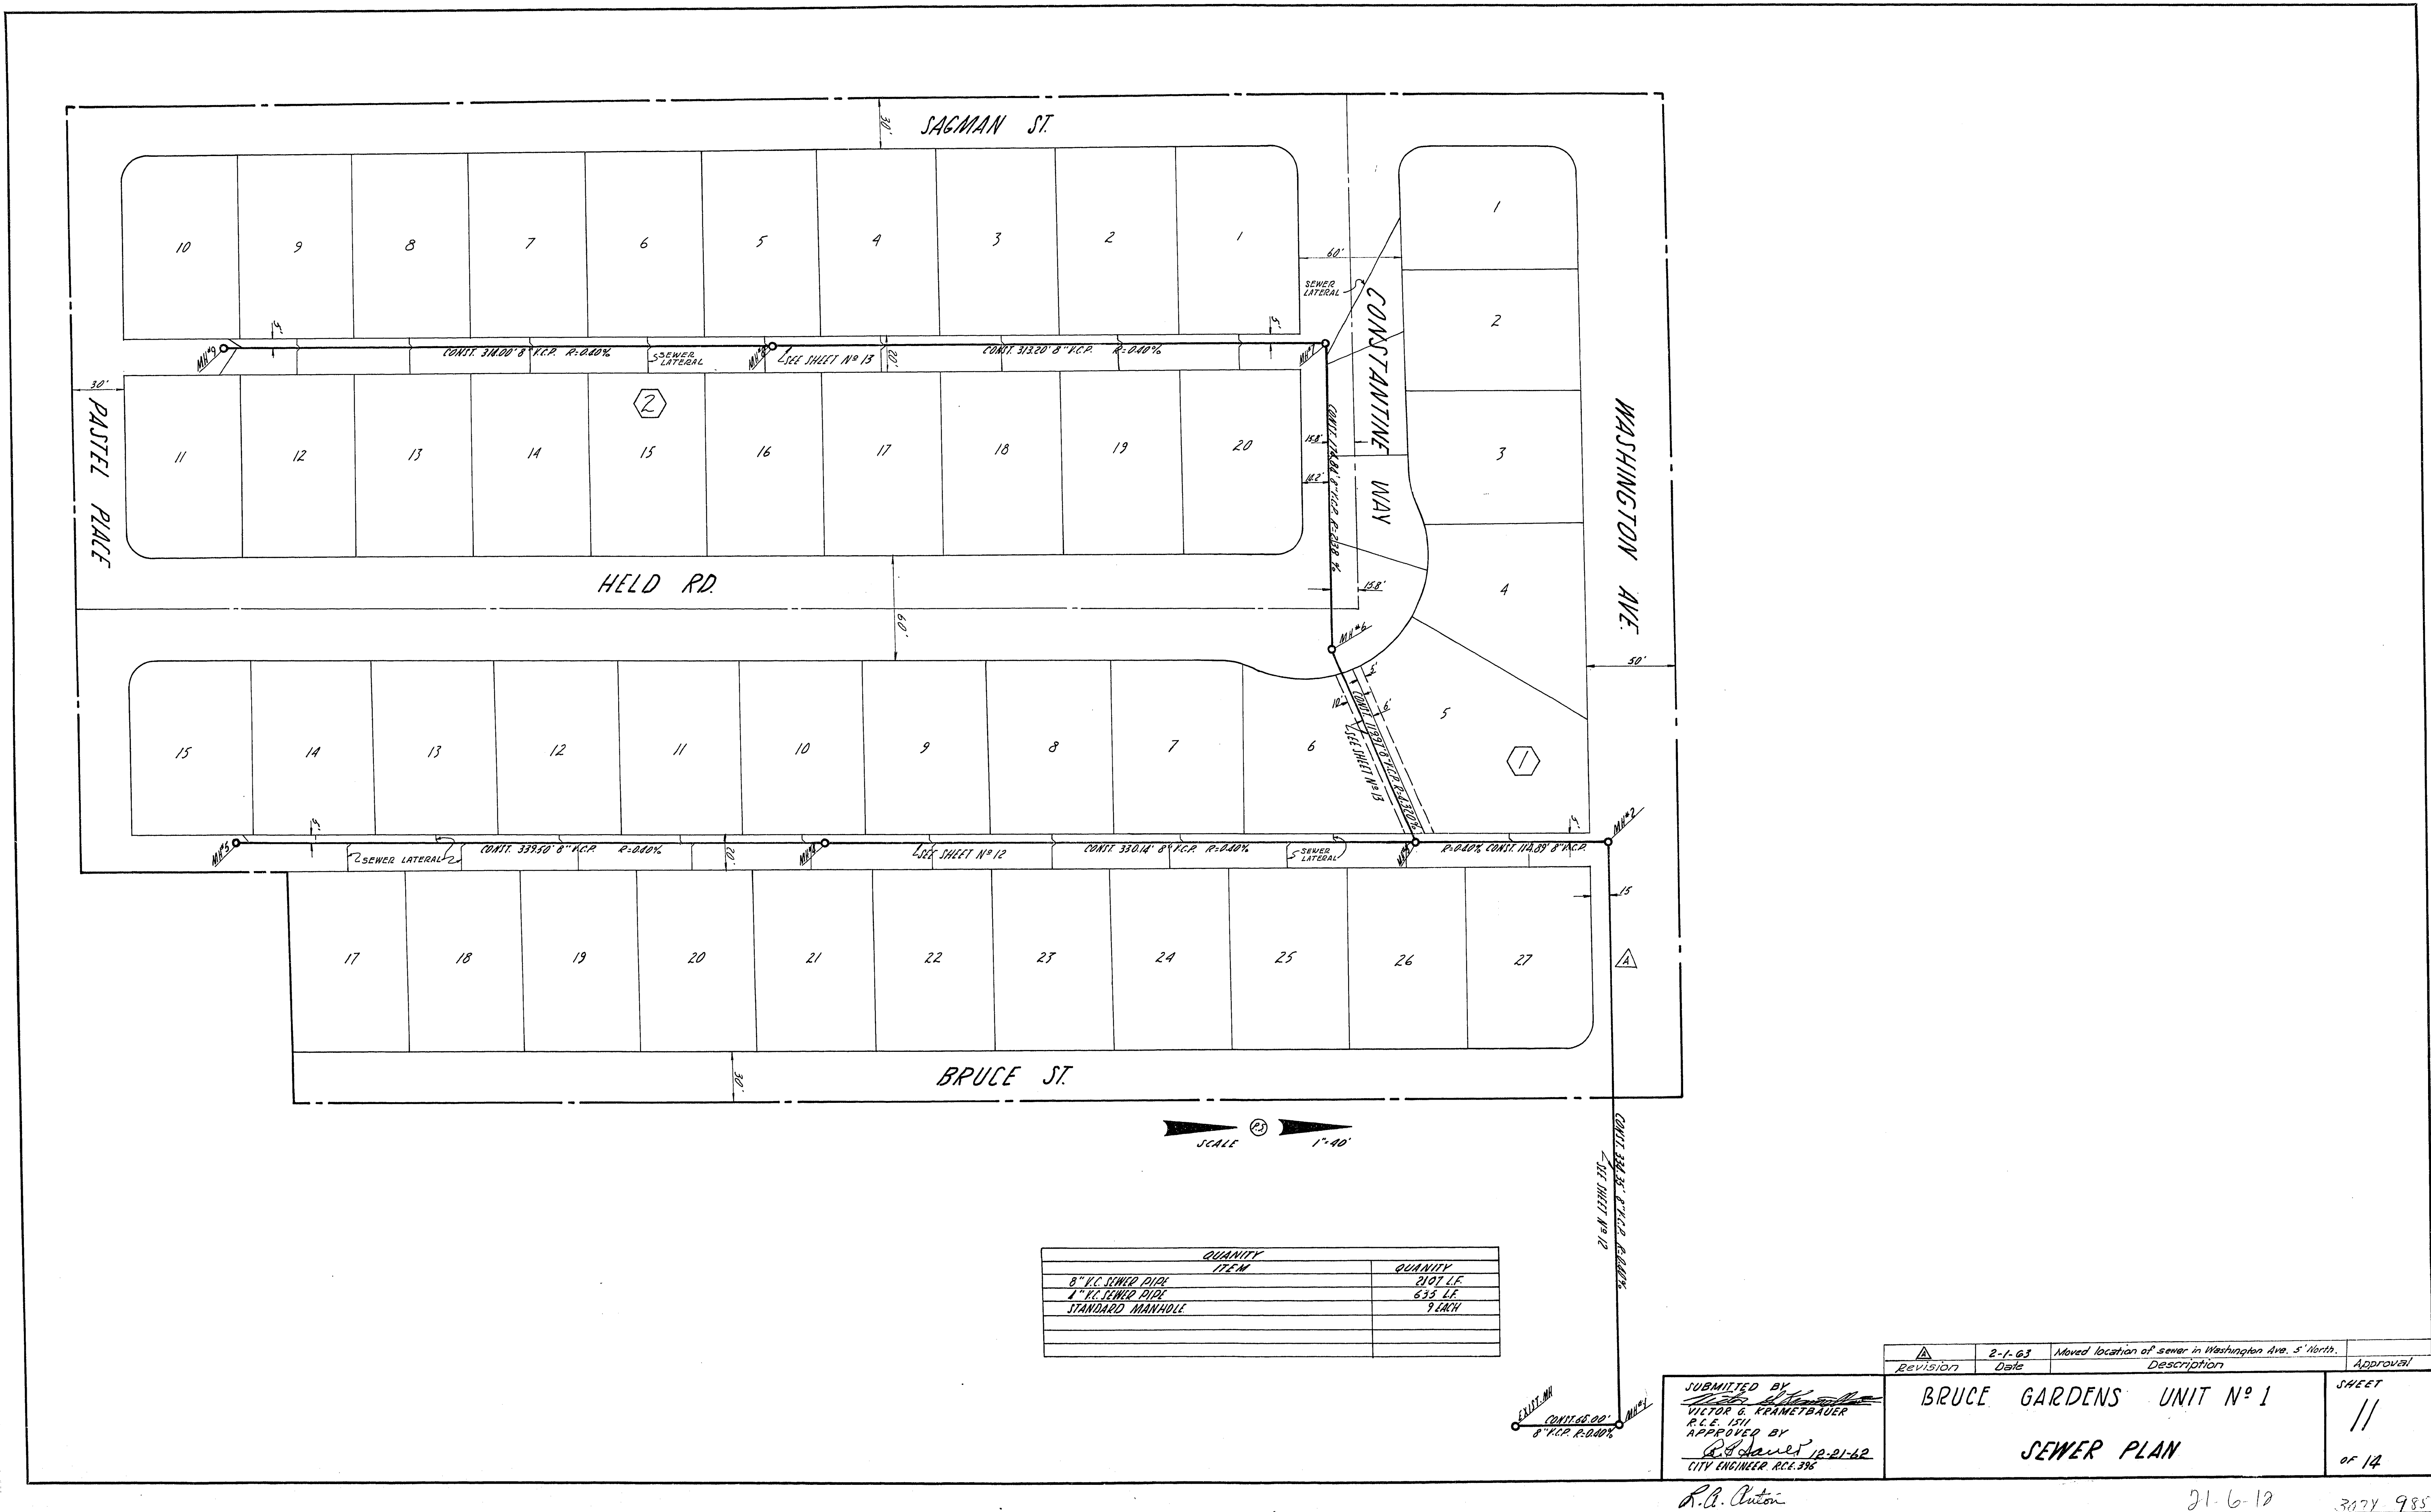

QUANTITY	QUANTITY
ITEM	ITEM
8" R.C. SEWER PIPE	2107 LF
4" R.C. SEWER PIPE	633 LF
STANDARD MANHOLE	9 EACH

SUBMITTED BY <i>[Signature]</i> VICTOR E. KRANETBAUER R.E. 154 APPROVED BY <i>[Signature]</i> 12-21-62 CITY ENGINEER, RCE 316	2-1-63	Moved location of sewer in Washington Ave. S. North.	SHEET // OF 14
	Revision	Description	
BRUCE GARDENS UNIT No. 1 SEWER PLAN			

R.A. Burton 21-6-12 317Y 985-1