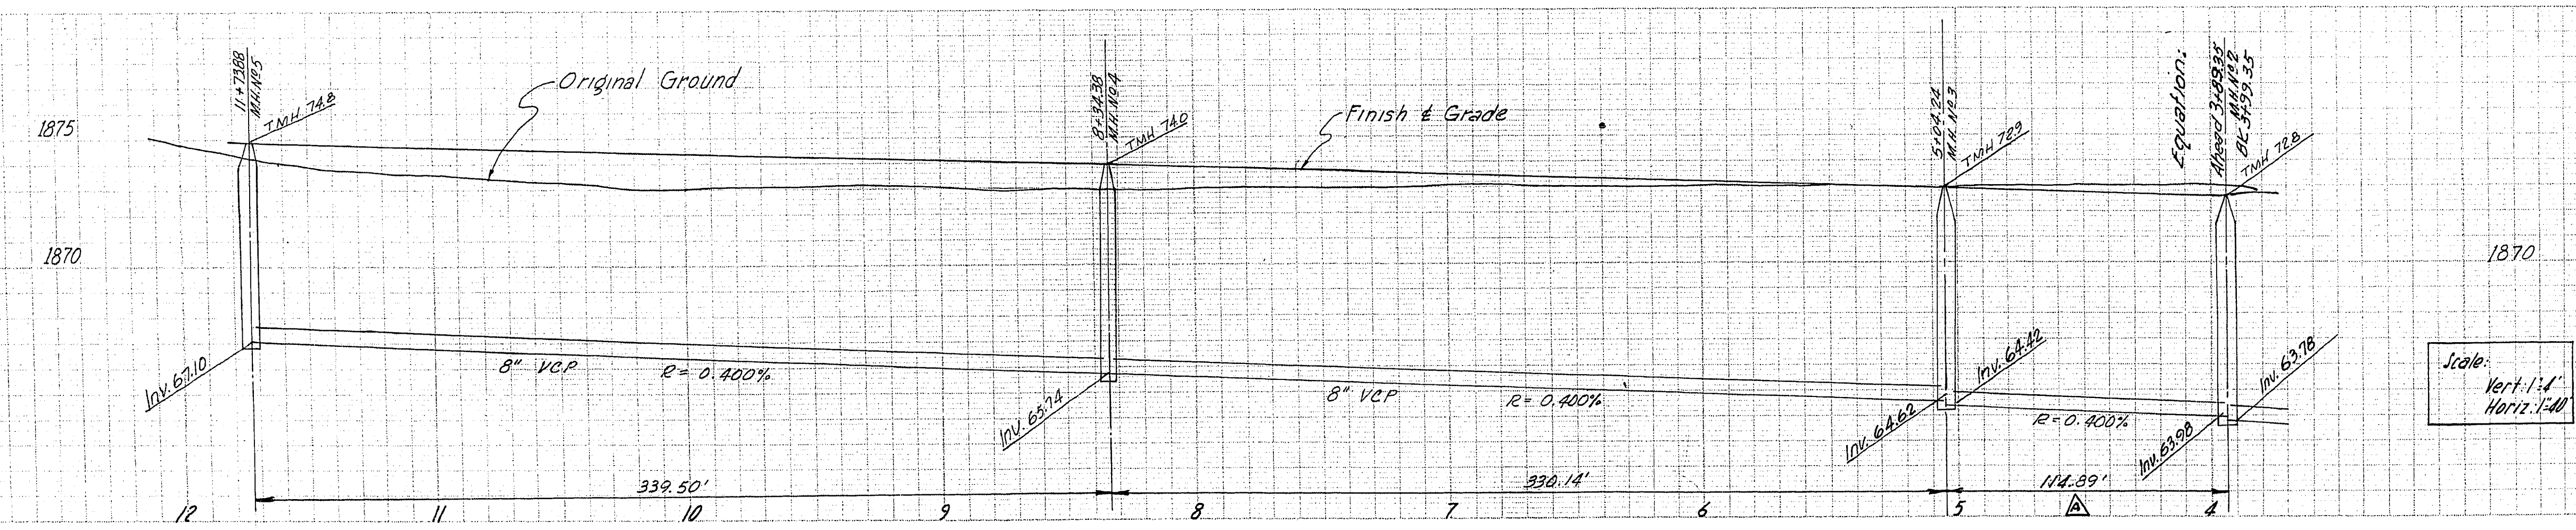
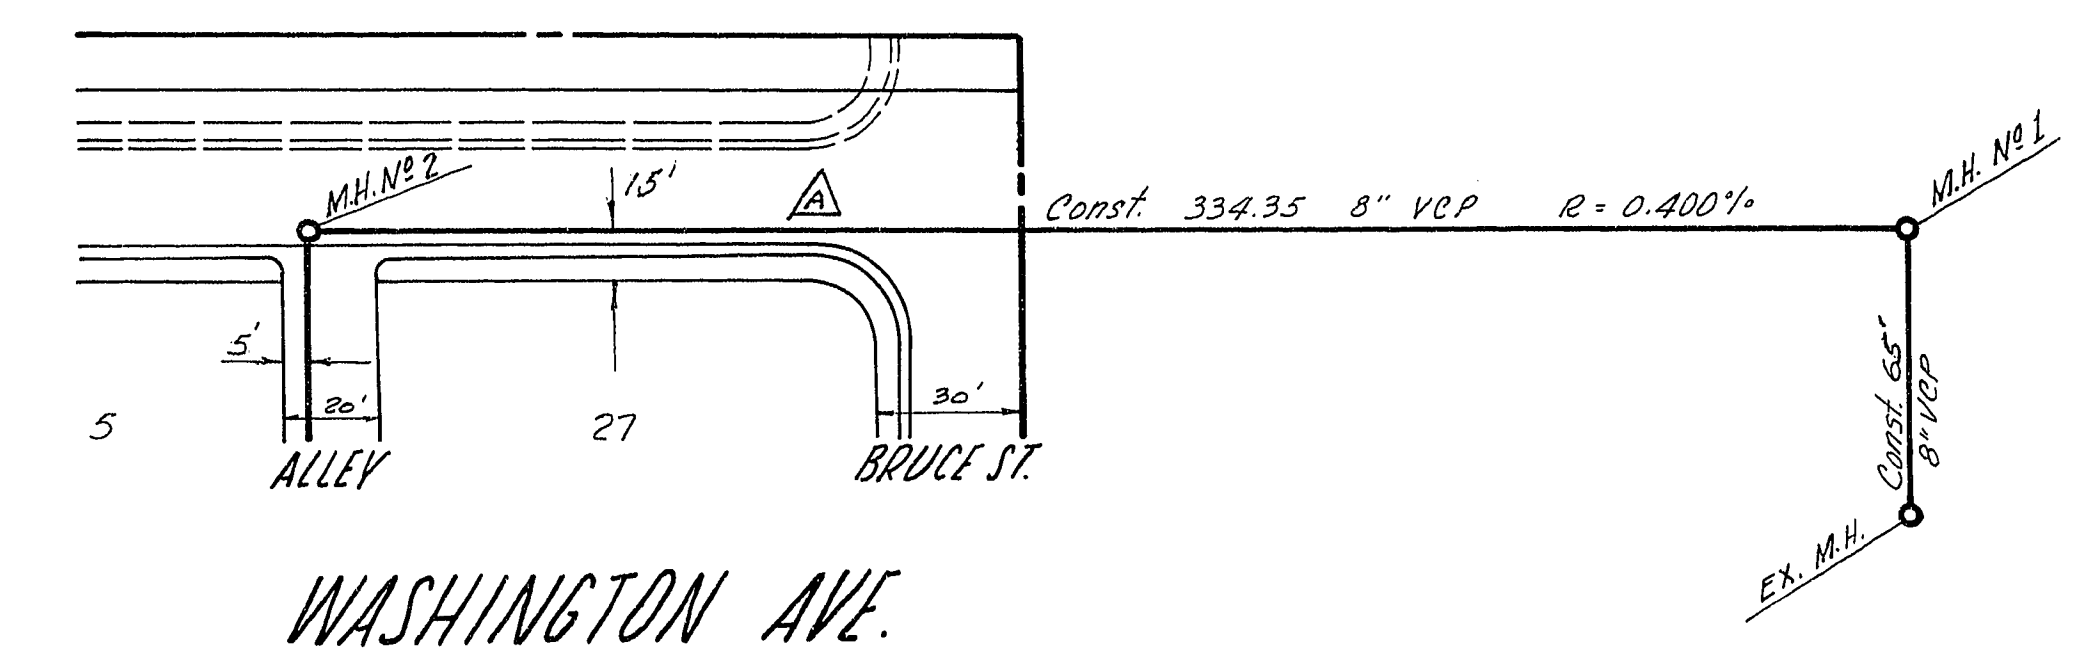
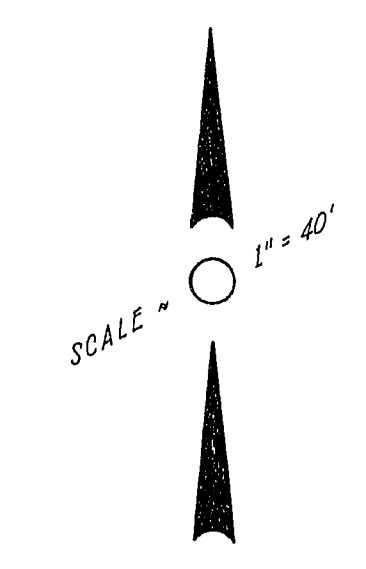
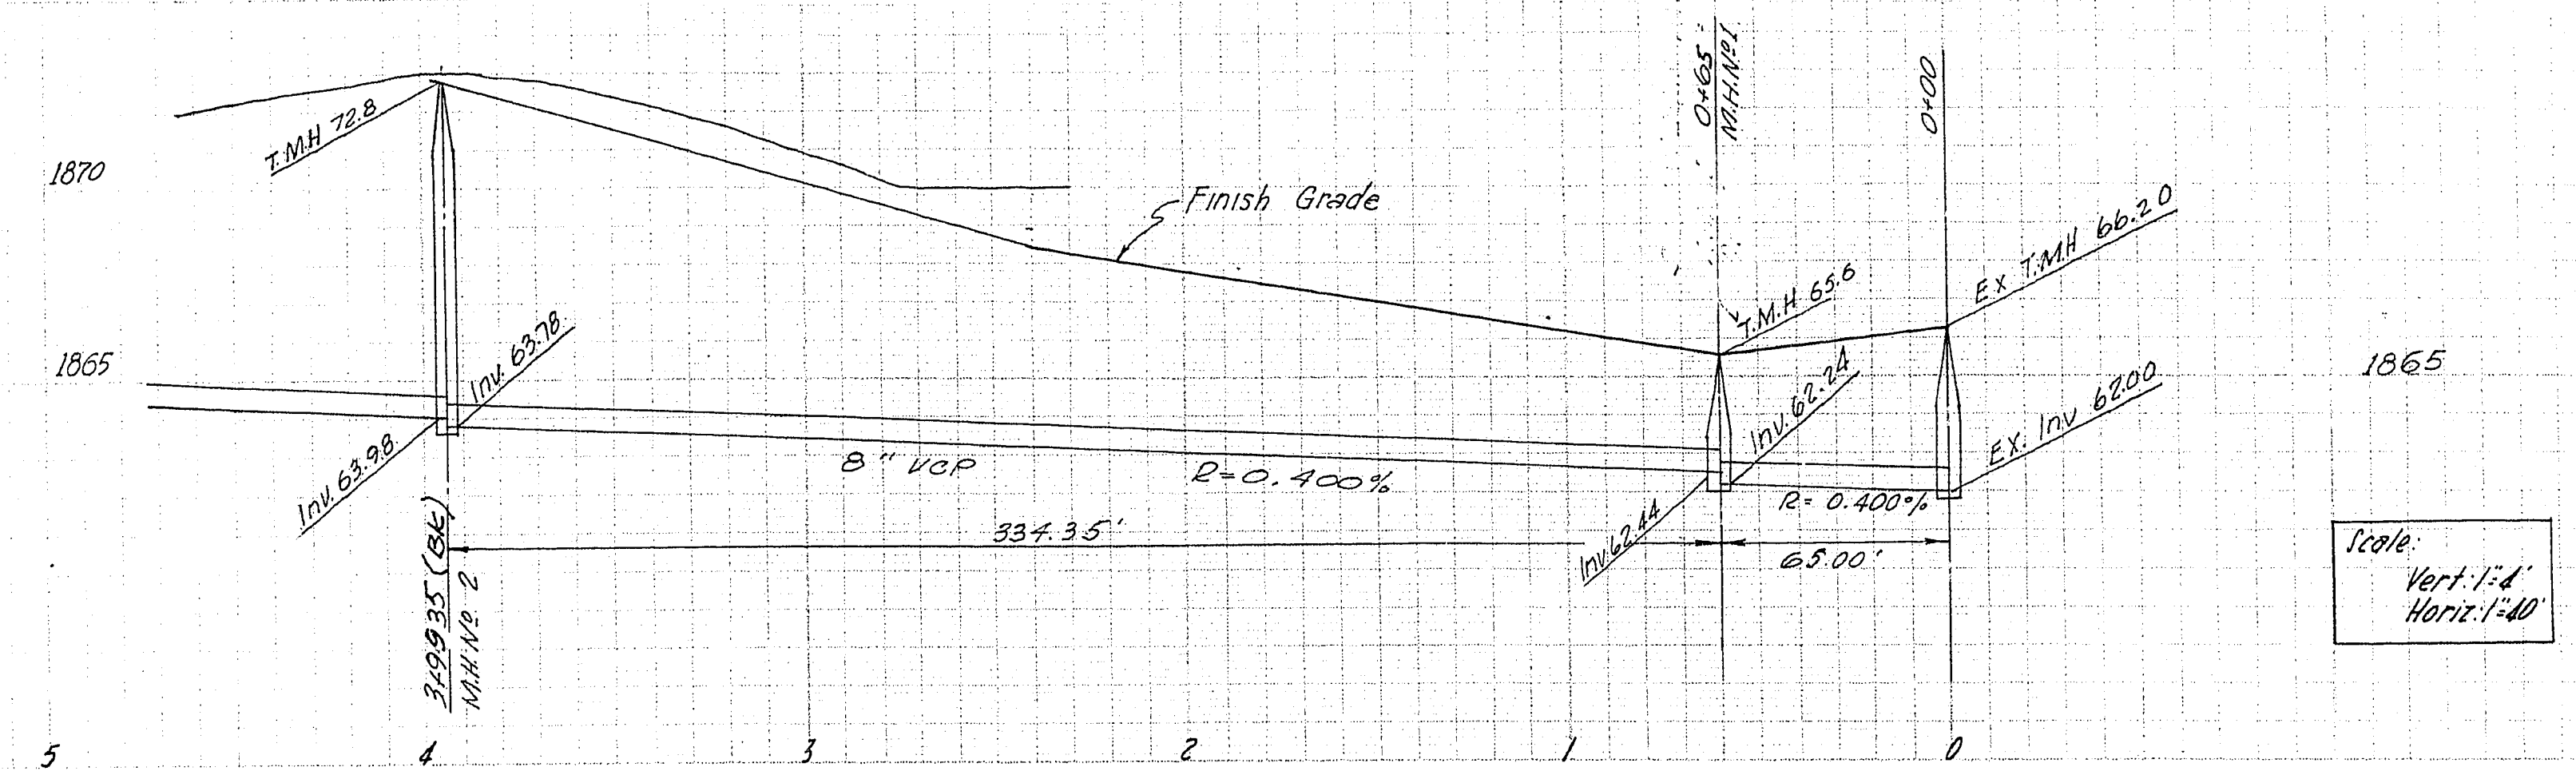


SUBMITTED BY <i>[Signature]</i> VICTOR E. KEMMEBAUER P.E. No. 511 APPROVED BY <i>[Signature]</i> 12-21-62 CITY ENGINEER R.L. 376		Revision	Date	Description	Approval
BRUCE GARDENS UNIT N° 1			2-1-63	MOVED location of sewer in Washington S north and revised stationing.	
SEWER PLAN					
SHEET 12 OF 14					

[Handwritten signature]

21-613

307Y 985-1