

LAMB BLVD.

LAMB BLVD.


SURVEYOR'S CERTIFICATE

I, KENNETH D. FARRIMOND, A PROFESSIONAL LAND SURVEYOR IN THE STATE OF NEVADA, DO HEREBY CERTIFY THAT THE MONUMENTS HAVE BEEN SET AND THE TIE DISTANCE IS AS SHOWN HEREON. THE SURVEY WAS COMPLETED ON _____

LEGEND:


- FOUND MONUMENT AS INDICATED
- SET MONUMENT AS INDICATED

SCALE 1"=50'

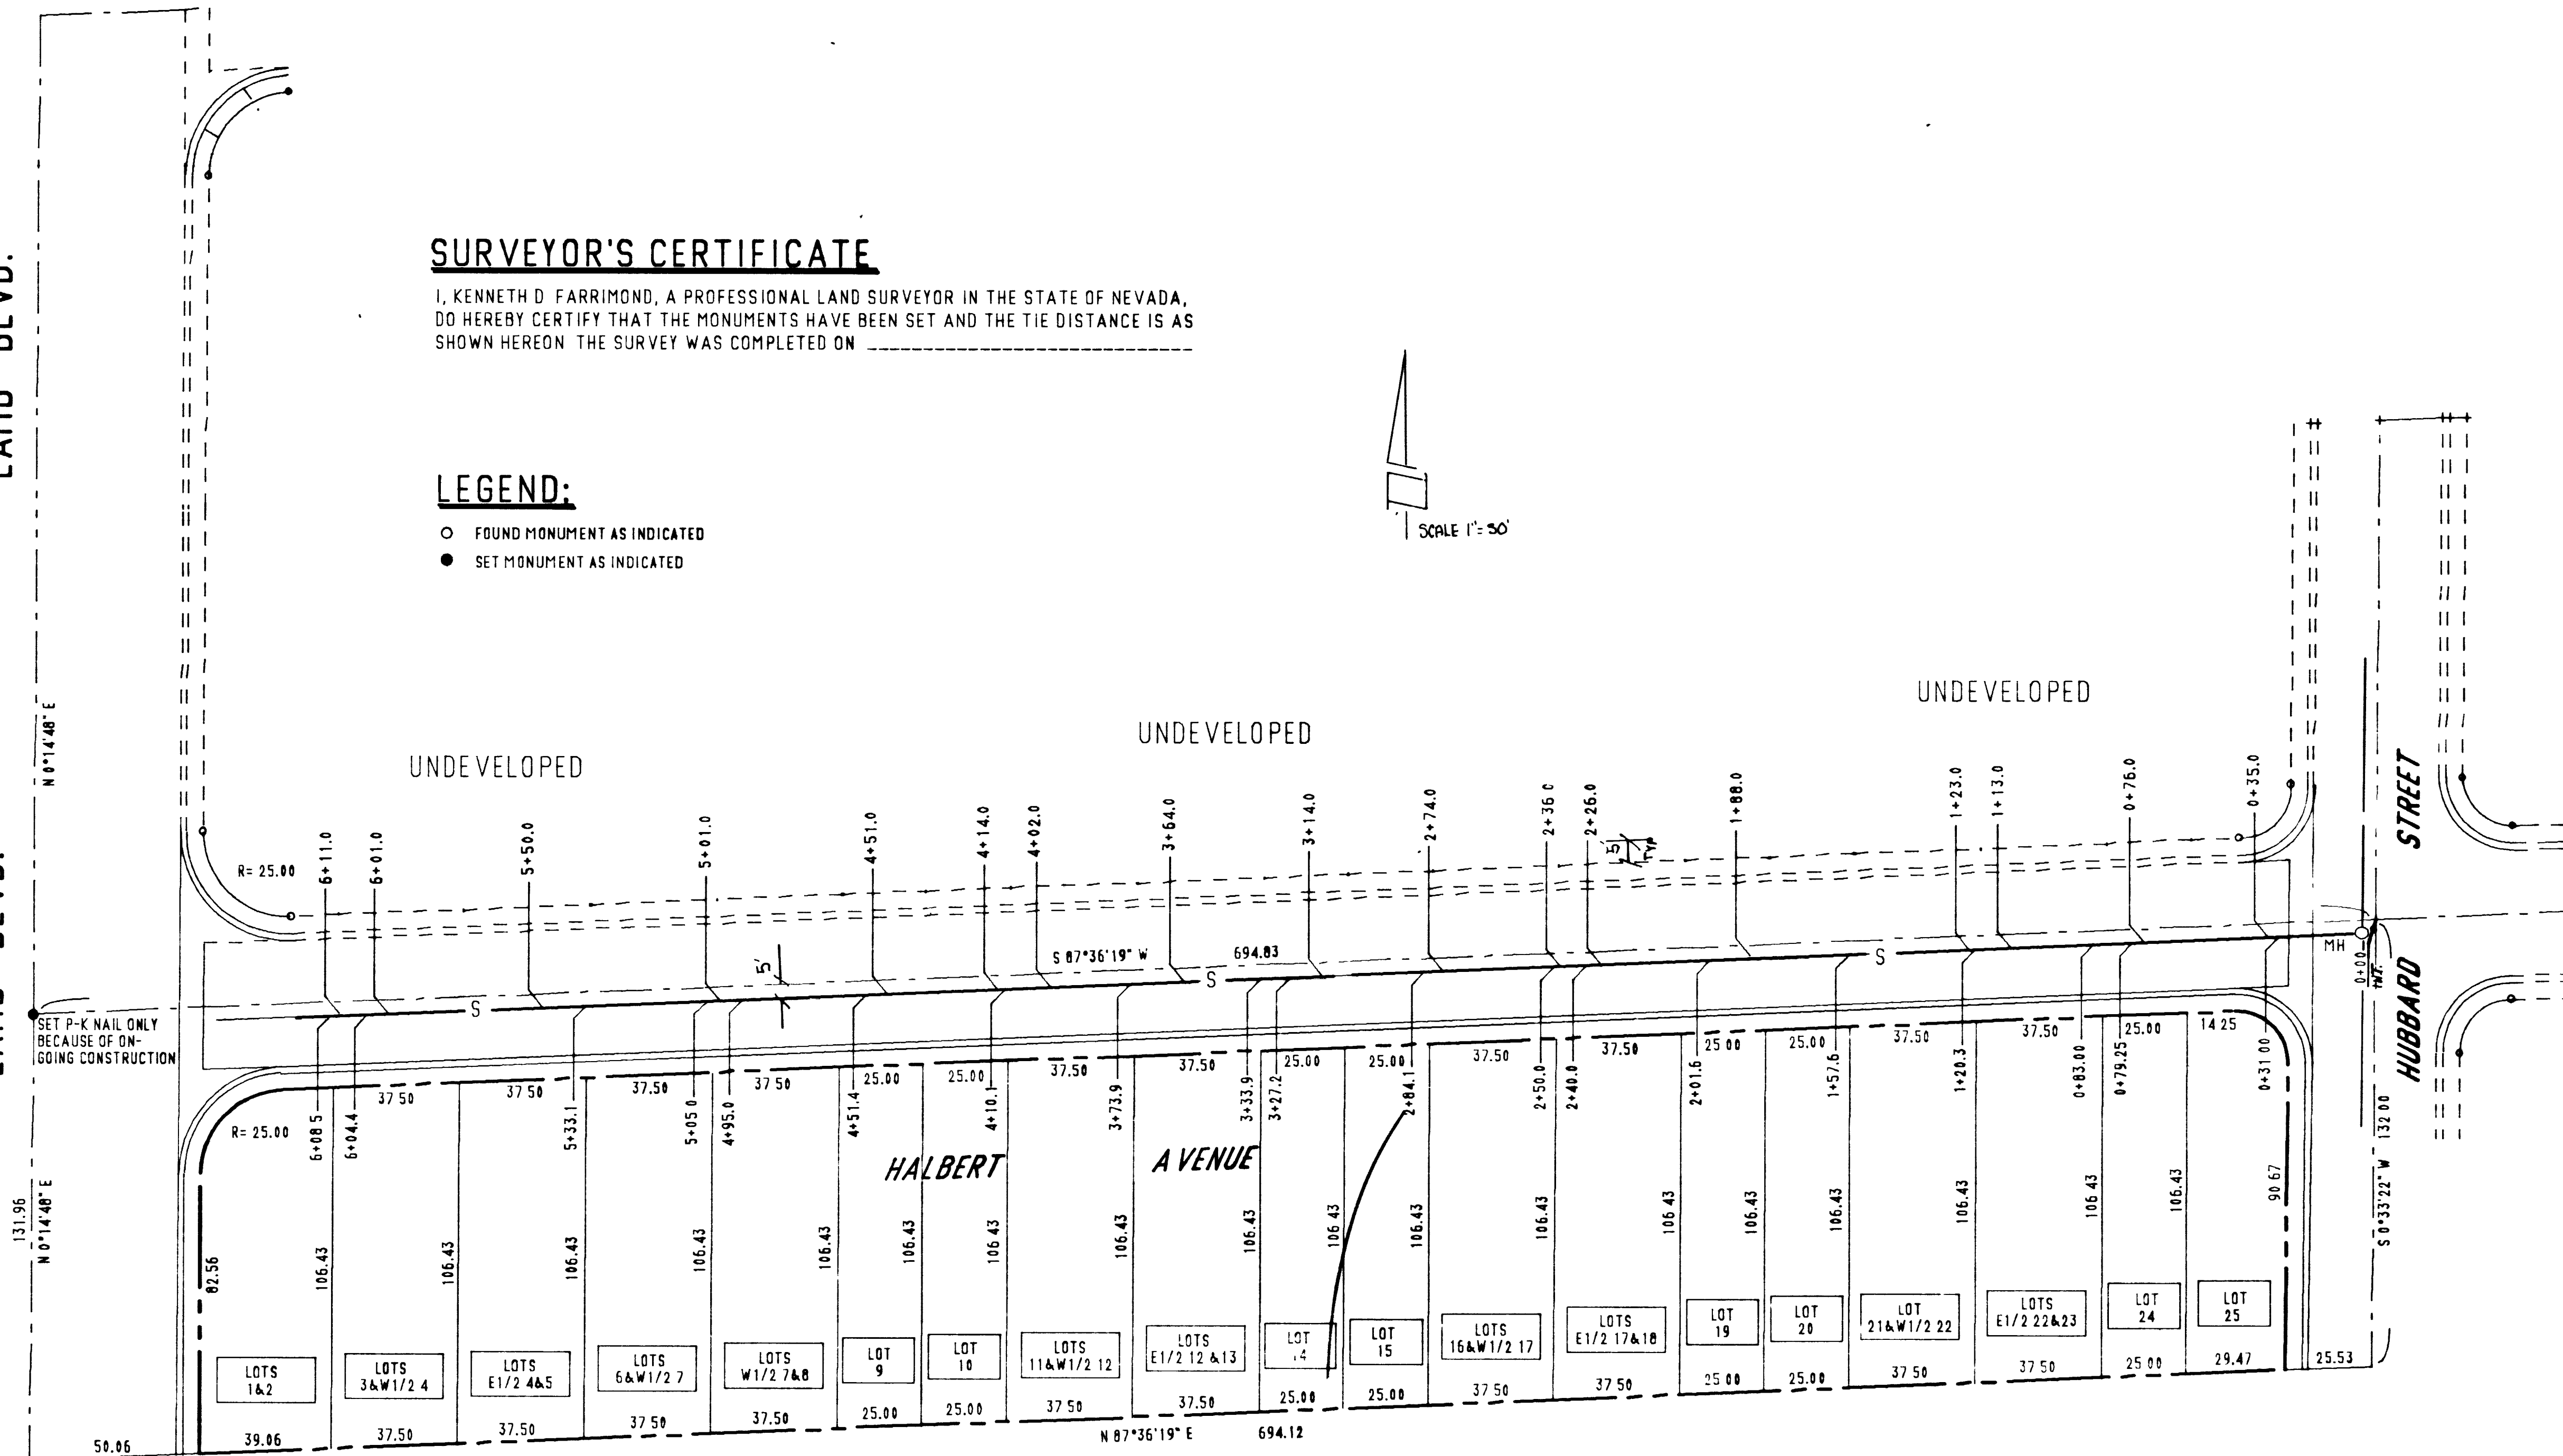

SEWER AS-BUILT NOTES

THE SEWER LATERALS HERE-ON INDICATED WERE LOCATED BY PAINT MARKS ON EXISTING CURB AND BY MARK-UPS FROM CONSTRUCTION PERSONNEL IN THE FIELD, THEREFORE THE ACCURACY MAY NOT BE AS GOOD AS EXPECTED, SO THESE LINES WERE LOCATED BY THE BEST MEANS POSSIBLE.

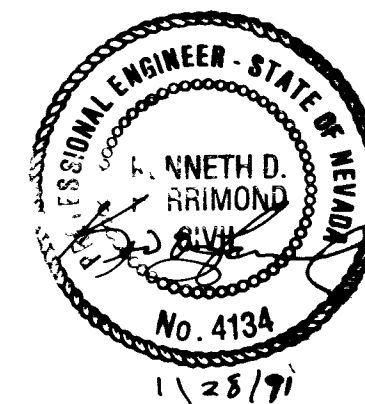

SEWER AS-BUILT PLAN
BOULDER HEIGHTS ADDITION TRACT 1 PHASE 9
A PORTION OF SECTION 5, T. 20 S., R. 62 E., M.D.B.&M.
CLARK COUNTY, NEVADA

KENNETH D. FARRIMOND, P.E., PLS.

3407 S. El Camino Rd.
Las Vegas, Nevada
Phone 457 6113

ENGINEERS/PLANNERS/SURVEYORS

SEWER AS-BUILT PLAN

BOULDER HEIGHTS ADDITION TRACT 1 PHASE 9
A PORTION OF SECTION 5, T. 20 S., R. 62 E., M.D.B.&M.
CLARK COUNTY, NEVADA

SHEET NO.

1 OF 1

32.99

"As Built"

307Y-980A-1-9

26.6.99

LAND BLDG.

LAMB BLVD.

SURVEYOR'S CERTIFICATE

1. IS THERE A PUMPHOUSE, A PUMPEDWELL, AND BATTERY IN THE SOUTHERN HEMISPHERE, OR IS THERE ONLY ONE THAT THE PUMPHOUSE AND BATTERY ARE THE SAME DISTANCE IN AN INVERSE DIRECTION, THE OTHER TWO BEING ONE?

LEGEND:

- (C) 1999-2000 by the author
 (D) 1999-2000 by the publisher

1999

UNIFORMITY STATE

UNIONVILLE, Pa. —

www.fishbase.org

SENIOR AD-ADULT NOTES

THE UNIVERSITY OF CHICAGO PRESS, 5 EAST LEXINGTON AVENUE, NEW YORK, N.Y. 10017-2453
 THE UNIVERSITY OF CHICAGO PRESS, 100 Brook Hill Drive, West Nyack, N.Y. 10994-2133
 THE UNIVERSITY OF CHICAGO PRESS, 32 Avenue of the Americas, New York, N.Y. 10013-2473
 THE UNIVERSITY OF CHICAGO PRESS, 100 Brook Hill Drive, West Nyack, N.Y. 10994-2133
 THE UNIVERSITY OF CHICAGO PRESS, 32 Avenue of the Americas, New York, N.Y. 10013-2473

SEWER AS-BUILT
PLAN

MCALDEN HEIGHTS ADDITION TRACT 1 PHASE 9
A PORTION OF SECTION 1, T. 28 N., R. 10 E., N. 43.00 PL. 14.00
CLARK COUNTY, MISSOURI

SEWER AS-BUILT PLAN
BOULDER HEIGHTS ADDITION TRACT - PHASE 5
A PORTION OF SECTION 31, 25 E., R. 22 E., N.E. 24 N.
CLATSOP COUNTY, OREGON

1 of 1

2200 E. 17th St., P.O. Box 1000, Ft. Lauderdale, FL 33301
305/531-1111
Fax 305/531-1112