

AS BUILT SEWER


CITY OF LAS VEGAS GENERAL NOTES

1. HOUSE SERVICES SHALL COMPLY WITH WESTERN PLUMBING CODE AS TO SEPARATION DISTANCE.
2. ALL HOUSES TO BE SERVED INDIVIDUALLY AS PER SECTION 313 OF THE UNIFORM PLUMBING CODE.
3. CONTRACTOR SHALL FURNISH THE ENGINEER WITH AS-BUILT DRAWINGS SHOWING THE EXACT LOCATIONS OF ALL HOUSE CONNECTIONS.
4. CONCRETE COLLARS TO BE CONSTRUCTED AROUND ALL MANHOLES AND WATER VALVES ON 60, 80 AND 100 FOOT R/W'S. ASPHALT COLLARS MAY BE USED ON 51 FOOT R/W'S. CONCRETE COLLARS SHALL BE 1/8" TO 1/4" LOWER THAN ADJACENT FINISH GRADE.
5. CHISEL S OR G WHEREVER SEWER OR GAS LINES PASS UNDER CURB.




EXISTING COMMERCIAL

DECATUR AVENUE

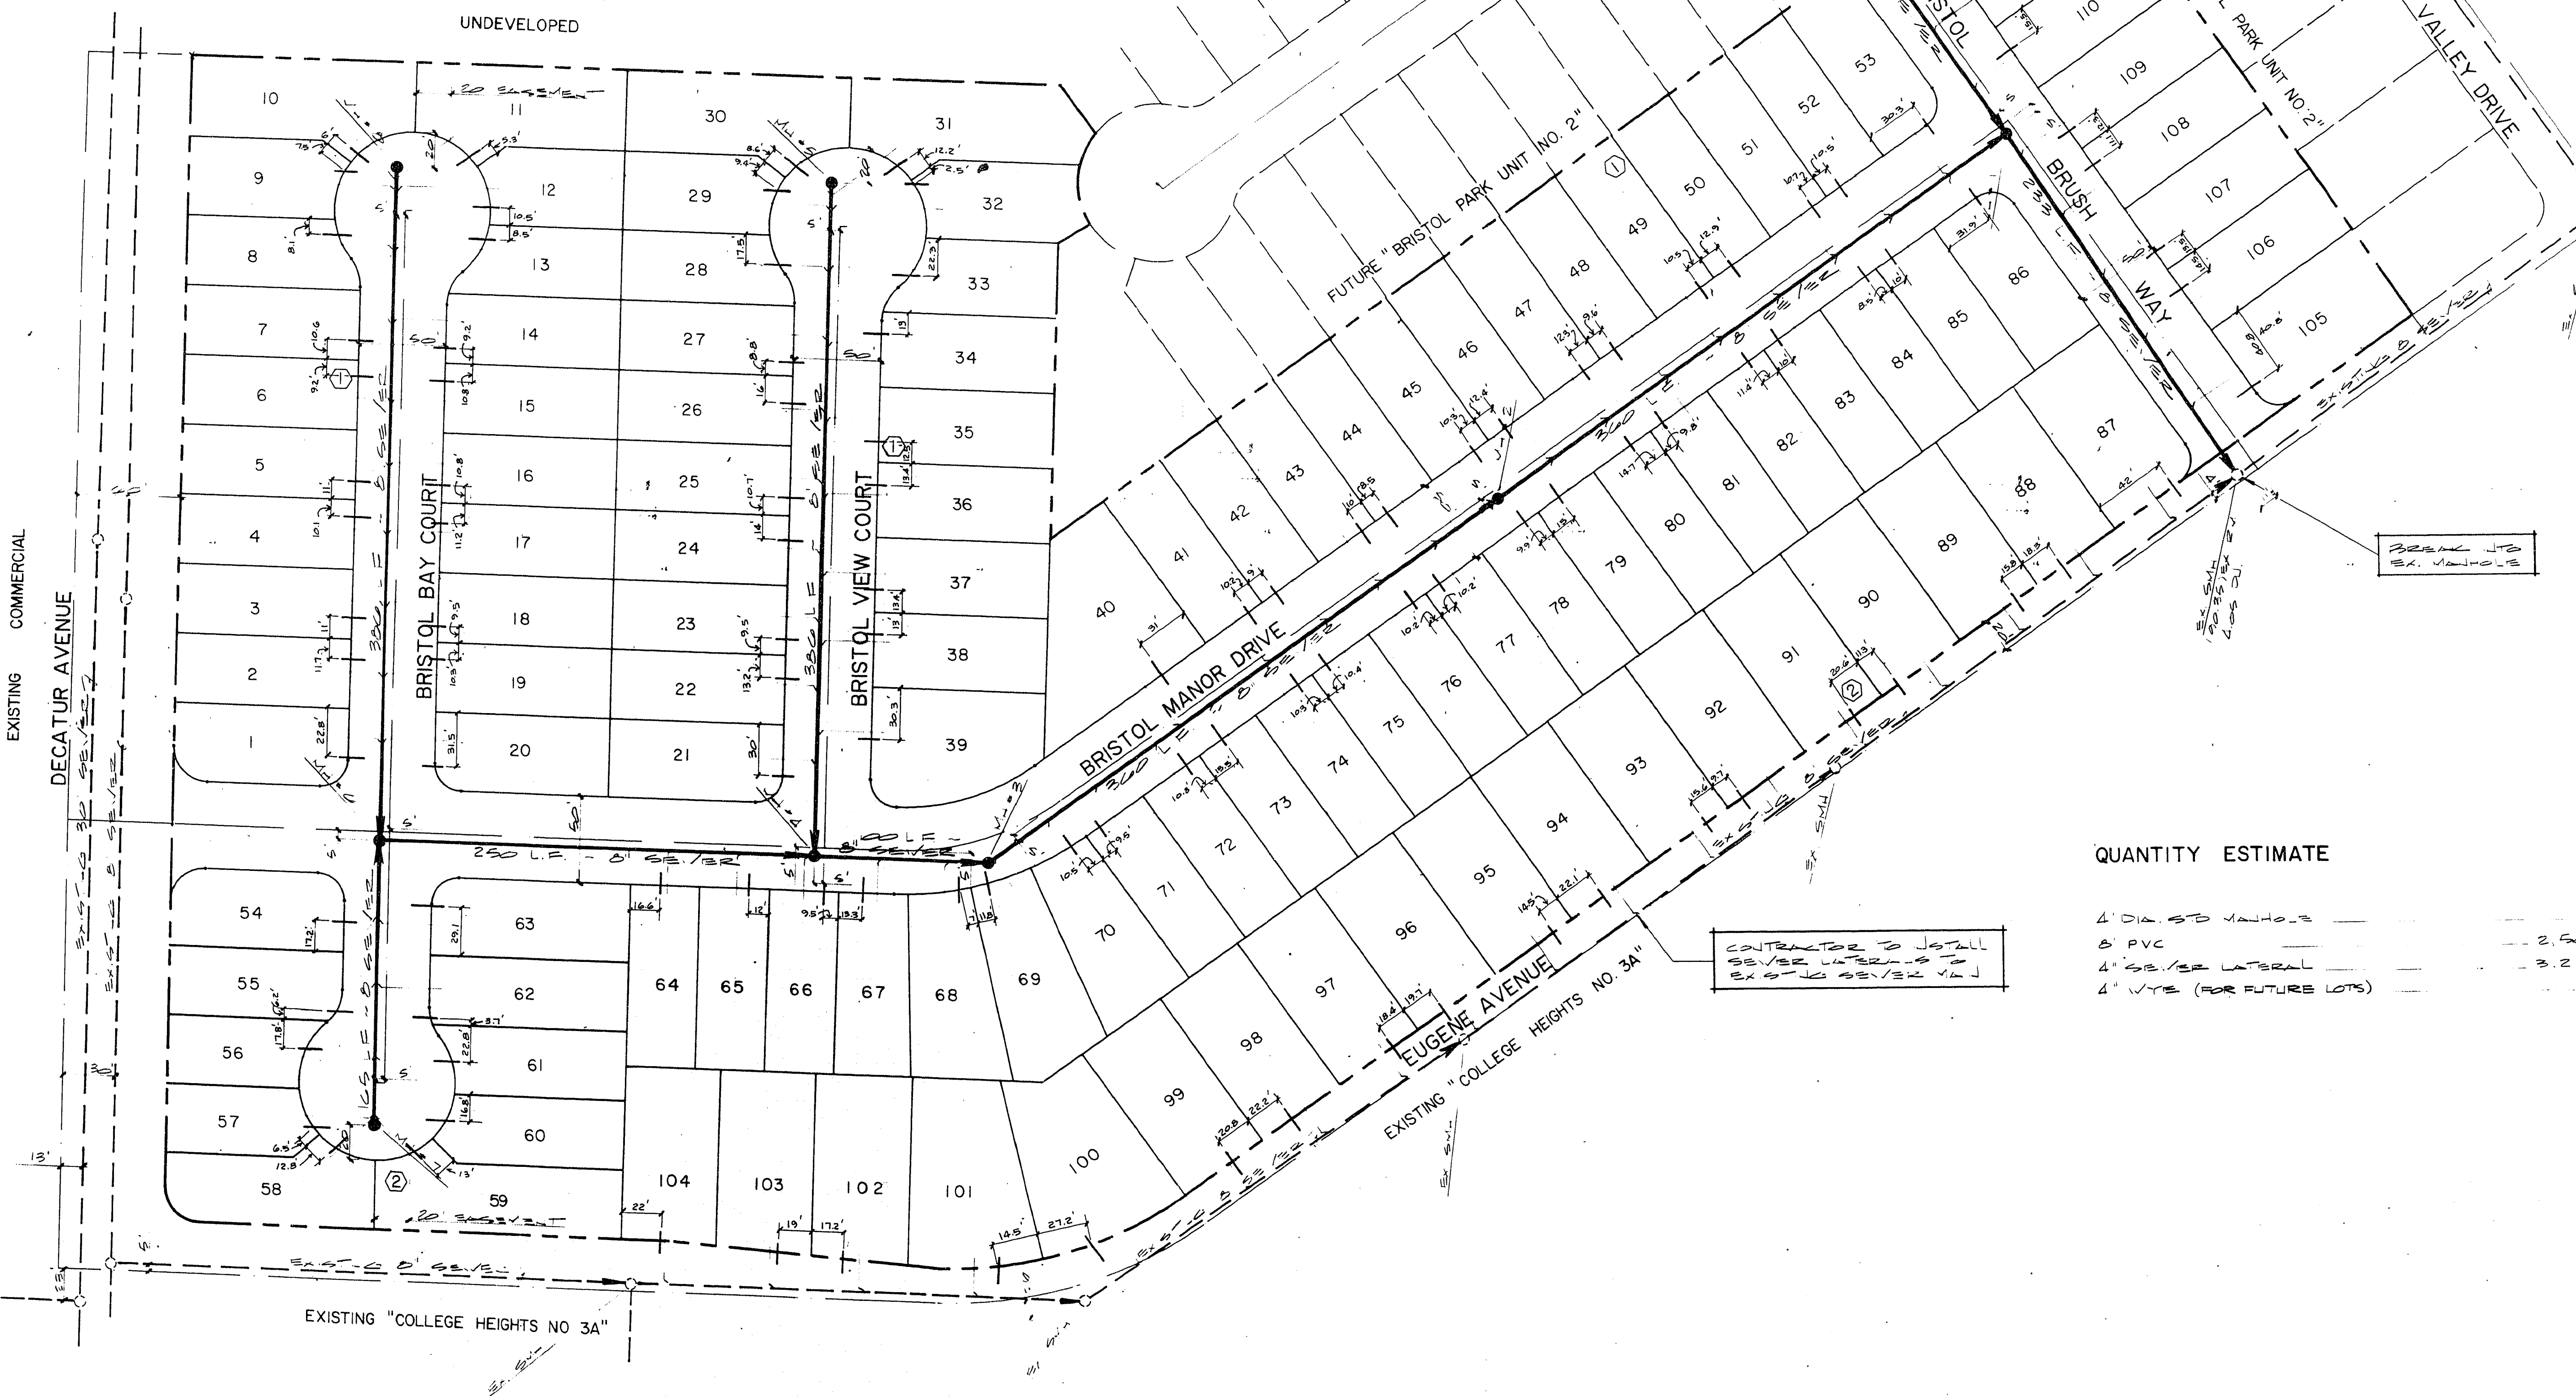

PROJECT SITE

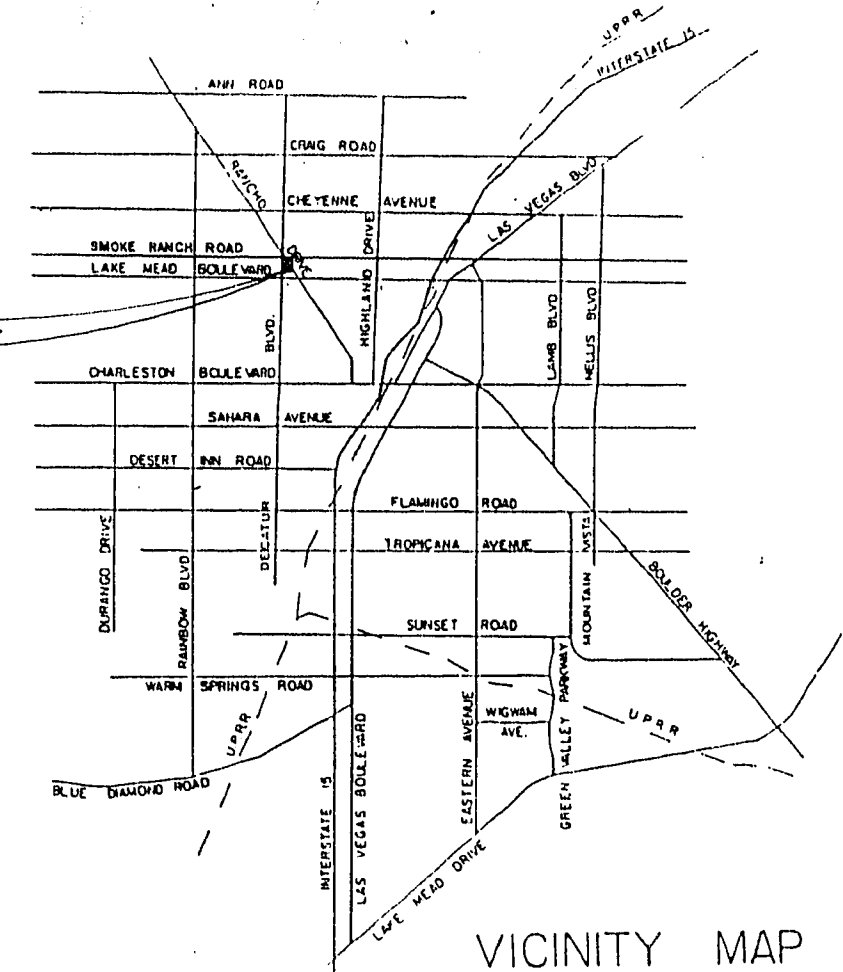

VICINITY MAP

QUANTITY ESTIMATE

4" DIA. STD. MANHOLE	9 EA
8" PVC	2,500 LF
4" SEWER LATERAL	3,211 LF
4" VYE (FOR FUTURE LOTS)	3 EA

CONTRACTOR TO INSTALL SEWER LATERALS TO EXISTING SEWER MAIN

CONTRACTOR TO INSTALL VYE STUDS FOR FUTURE LOTS

SEE 2" SEWER STUDS FOR FUTURE

SEE 2" SEWER STUDS FOR FUTURE

MASTER SEWER PLAN

BRISTOL PARK UNIT NO. 1

WO NO	4050
BY	B.L.D.
DATE	7/80
SCALE	1" = 50'

SHEET	11
OF 17 SHEETS	

CLV SANITATION ENGINEER DATE 10-7-86

ENGINEERS & SURVEYORS INCORPORATED

7022 W. CHARLESTON BLVD.
LAS VEGAS, NEVADA 89117
PHONE 202 / 363-6415

SUBMITTED BY: *Paul E. Lafferty*