
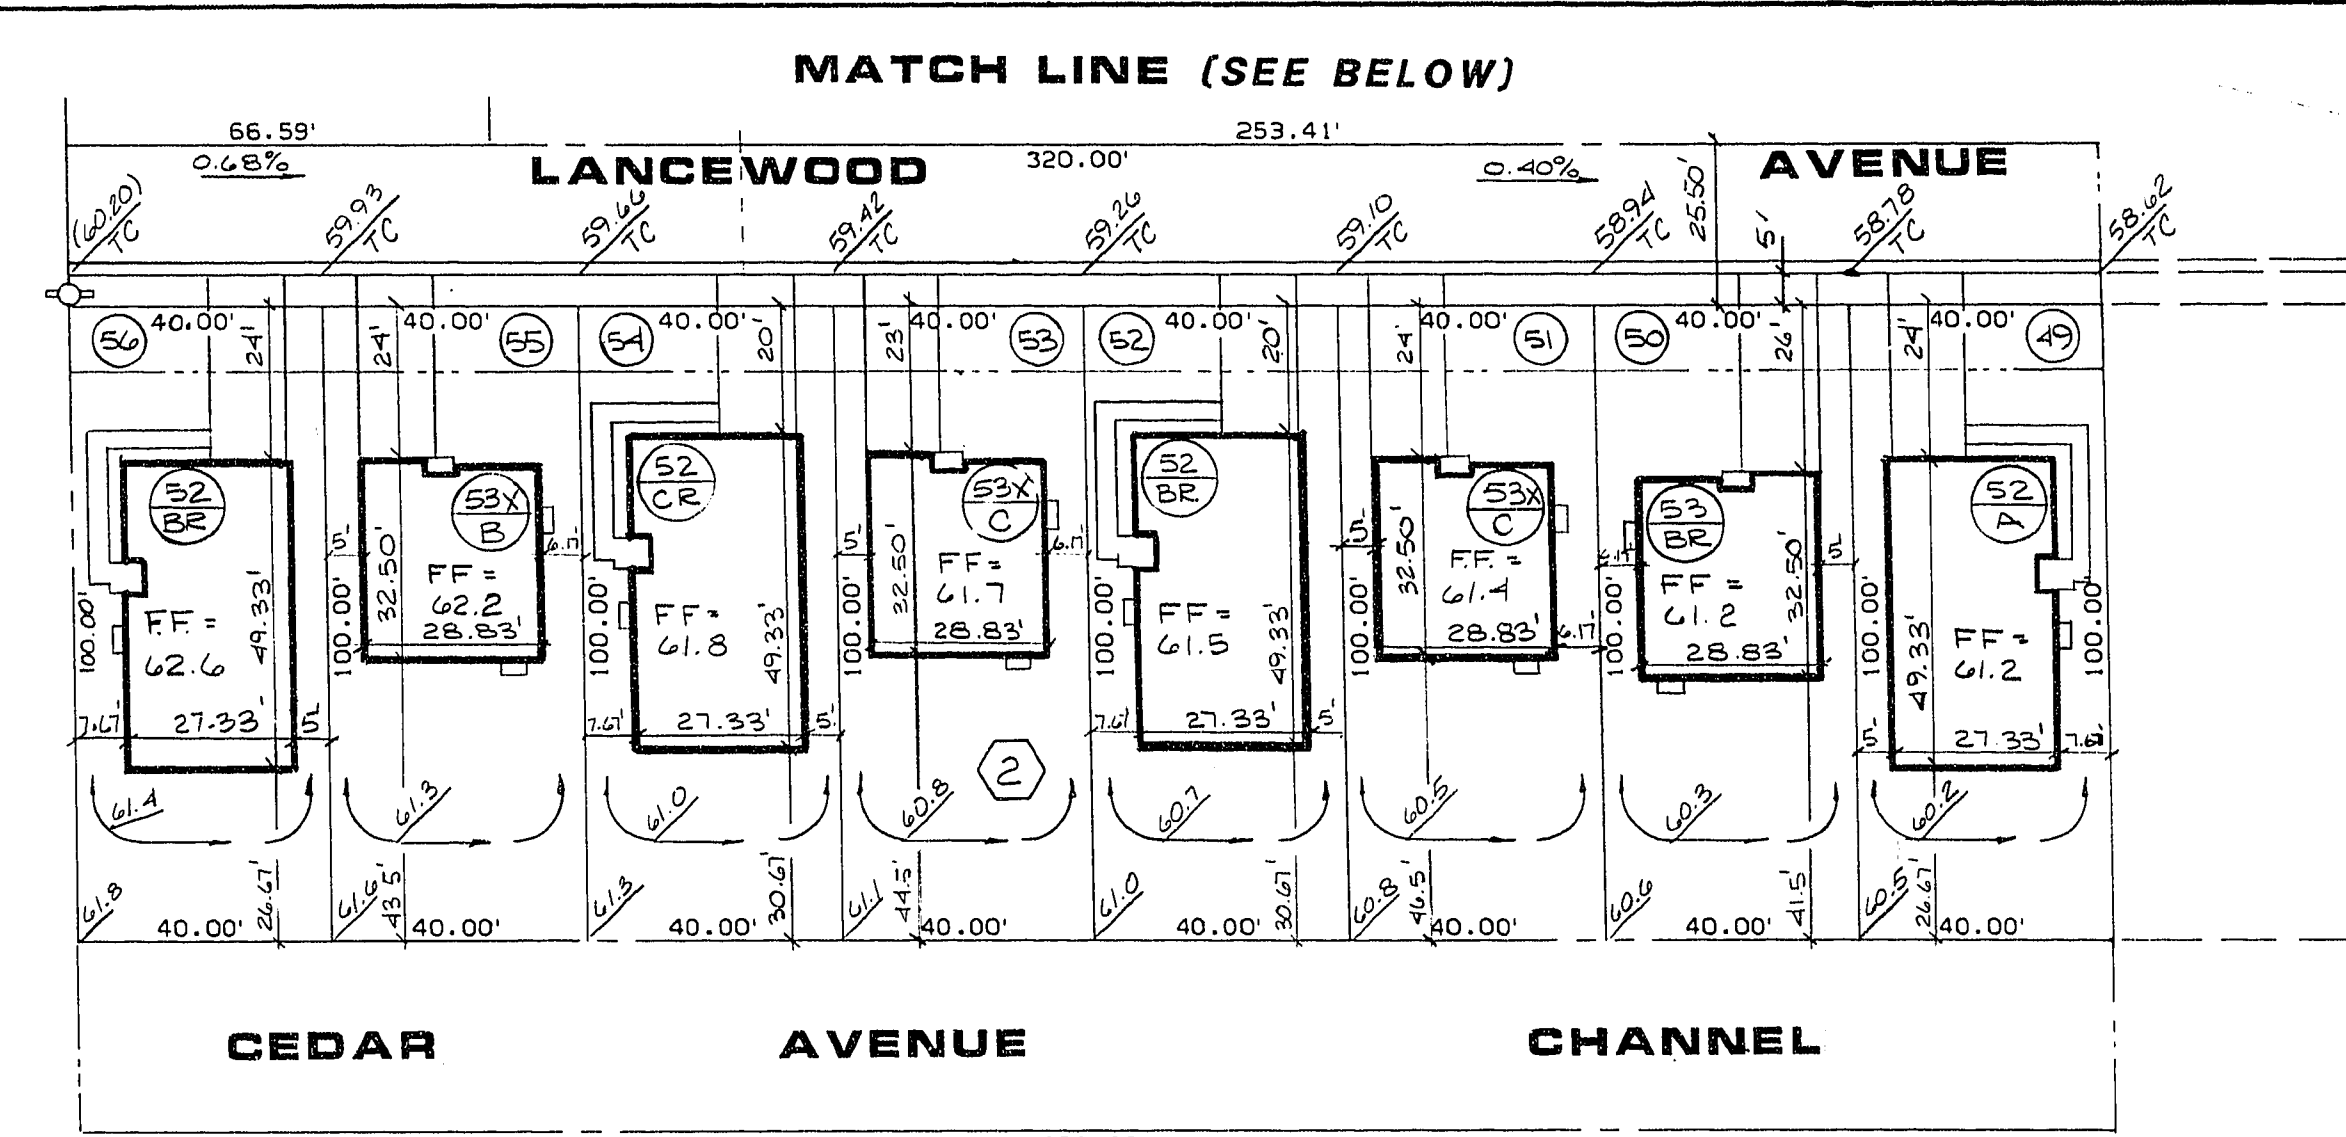


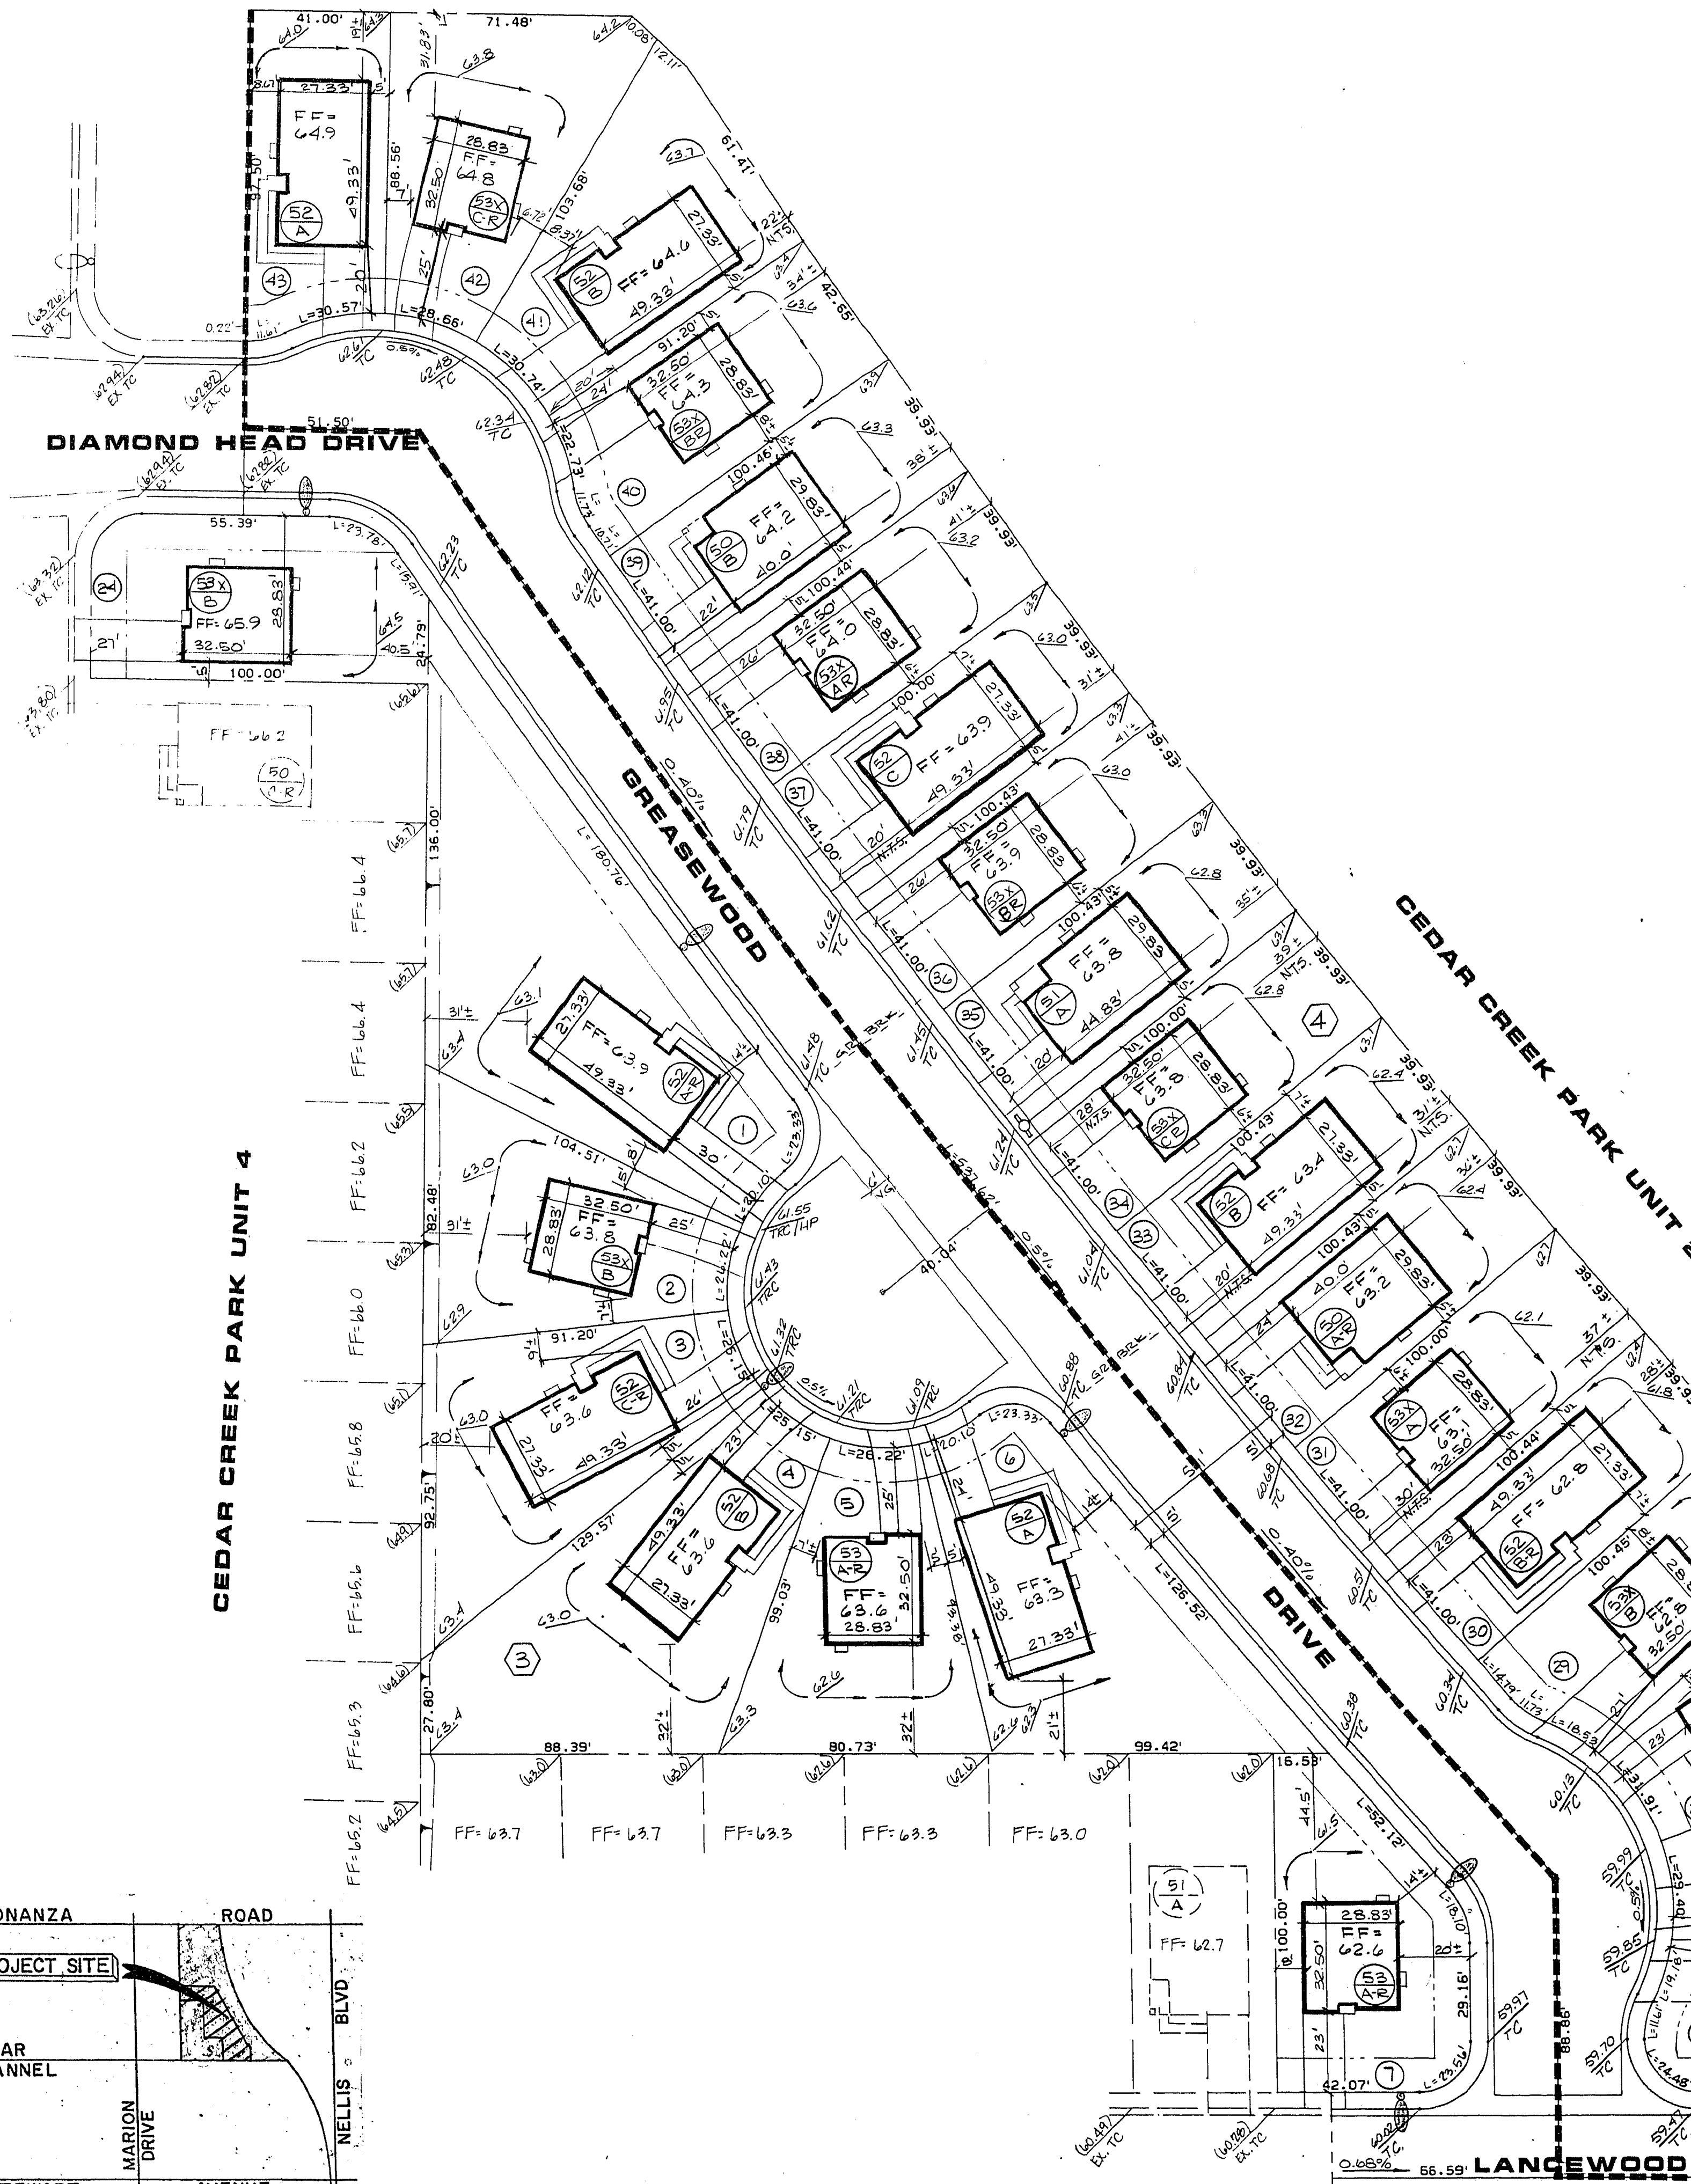

TABULATION

PHASE I					PHASE II			
PLAN	BLOCK 2	BLOCK 3	BLOCK 4	TOT TOT	PLAN	BLOCK 4	TOT TOT	
50	A				50	A	1	
	B					B	1	
	C					C		2
51	A				51	A	1	
	B					B		
	C					C	1	2
52	A	1 6		3	52	A	27 43	2
	B	4	24	4		B	41 33	3
	C	3		2		C	37	1
53	A	5 7		2	53	A		
	B			1		B		
	C			3		C		
53X	A		23	1	53X	A	31 38	2
	B	2 24	25	4		B	26 29 36	4
	C			2		C	34 42	2
TOTAL LOTS				19	TOTAL LOTS			18

X - TWO STORY ○ DENOTES REVERSE

APPROVED FOR CONSTRUCTION
Frank L. Kovara 7-25-83
FRANK L. KOVARA, V.P.
METROPOLITAN DEV. CORP. DATE

FINISH FLOOR "AS-BUILT" CERTIFICATION

Gene D. Krametzauer 2/12/85
GENE D. KRAMETZAUER, R.L.S. DATE
NEVADA CERT. NO. 6201


SPECIAL NOTICE
THESE PLANS ARE PRODUCED FOR THE LIMITED PURPOSE OF ASSISTING THE WORKMEN IN PERFORMING THEIR DUTIES IN CONFORMITY WITH NORMAL ENGINEERING AND CONSTRUCTION PRACTICES. THESE PLANS MAY NOT DEPICT EXACTLY THE DIMENSIONS OF THE PROJECT WHEN ACTUALLY CONSTRUCTED DUE TO CHANGES AND MODIFICATIONS DEEMED NECESSARY DURING THE COURSE OF CONSTRUCTION.

GENERAL NOTES

- ALL GRADES SHOWN ARE FINISH GRADE.
- FINISH GRADE ELEVATION AT OUTSIDE EXTERIOR OF HOUSE IS 0.7' BELOW FINISH FLOOR IN ALL CASES.
- SEE ENGINEER FOR BLOCK AND RETAINING WALL CONSTRUCTION DETAILS.

LEGEND

- LOT NUMBER
- ④ BLOCK NUMBER
- TOP OF CURB
- FF= 62.4 FINISH FLOOR ELEVATION
- DRAINAGE SWALE
- BLOCK WALL
- BUILDING SETBACK LINE
- SCARP
- FIRE HYDRANT (EXIST'G)
- STREET LIGHT
- HOUSE MODEL
- N.T.S. NOT TO SCALE

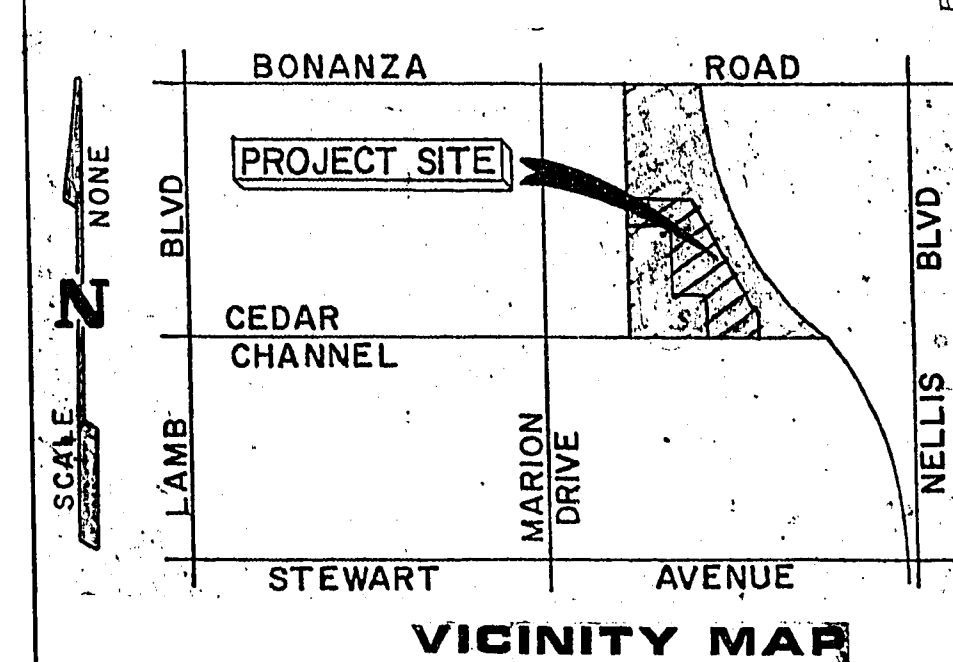

REVISION

REV	DATE	BY	DESCRIPTION
1	7/20/83	EDP	REV. MODELS, LOT 3, 4, 24, 25, 26, 999, 1000

CONSULTING ENGINEERS • PLANNERS
2800 WEST SAHARA AVENUE BUILDING 4 SUITE B
LAS VEGAS, NEVADA 89102 PHONE (702) 873-5550

7/15/83
MICHAEL S. KOZUMI, P.E.
NEV. CERT. NO. 4311

FOR METROPOLITAN DEVELOPMENT
CEDAR CREEK PARK UNIT 3

PLOT PLAN

WO NO. 3032-3
BY DMD
DATE
SCALE 1" = 30'

SHEET
1
OF 1 SHEETS

87-6-56 As Built 107Y-1020-3