
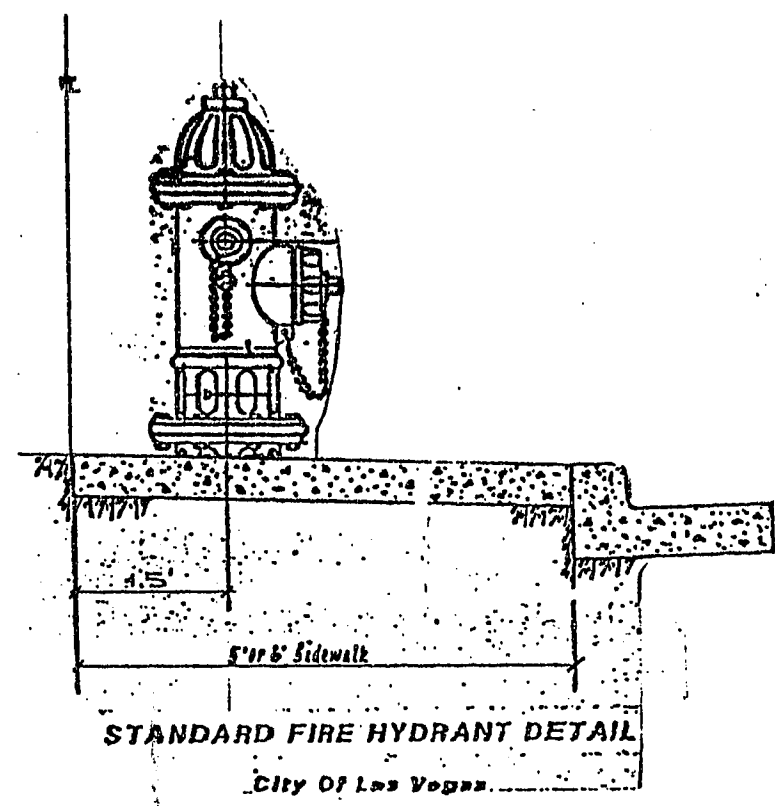


EXISTING CEDAR CREEK PARK UNIT 1

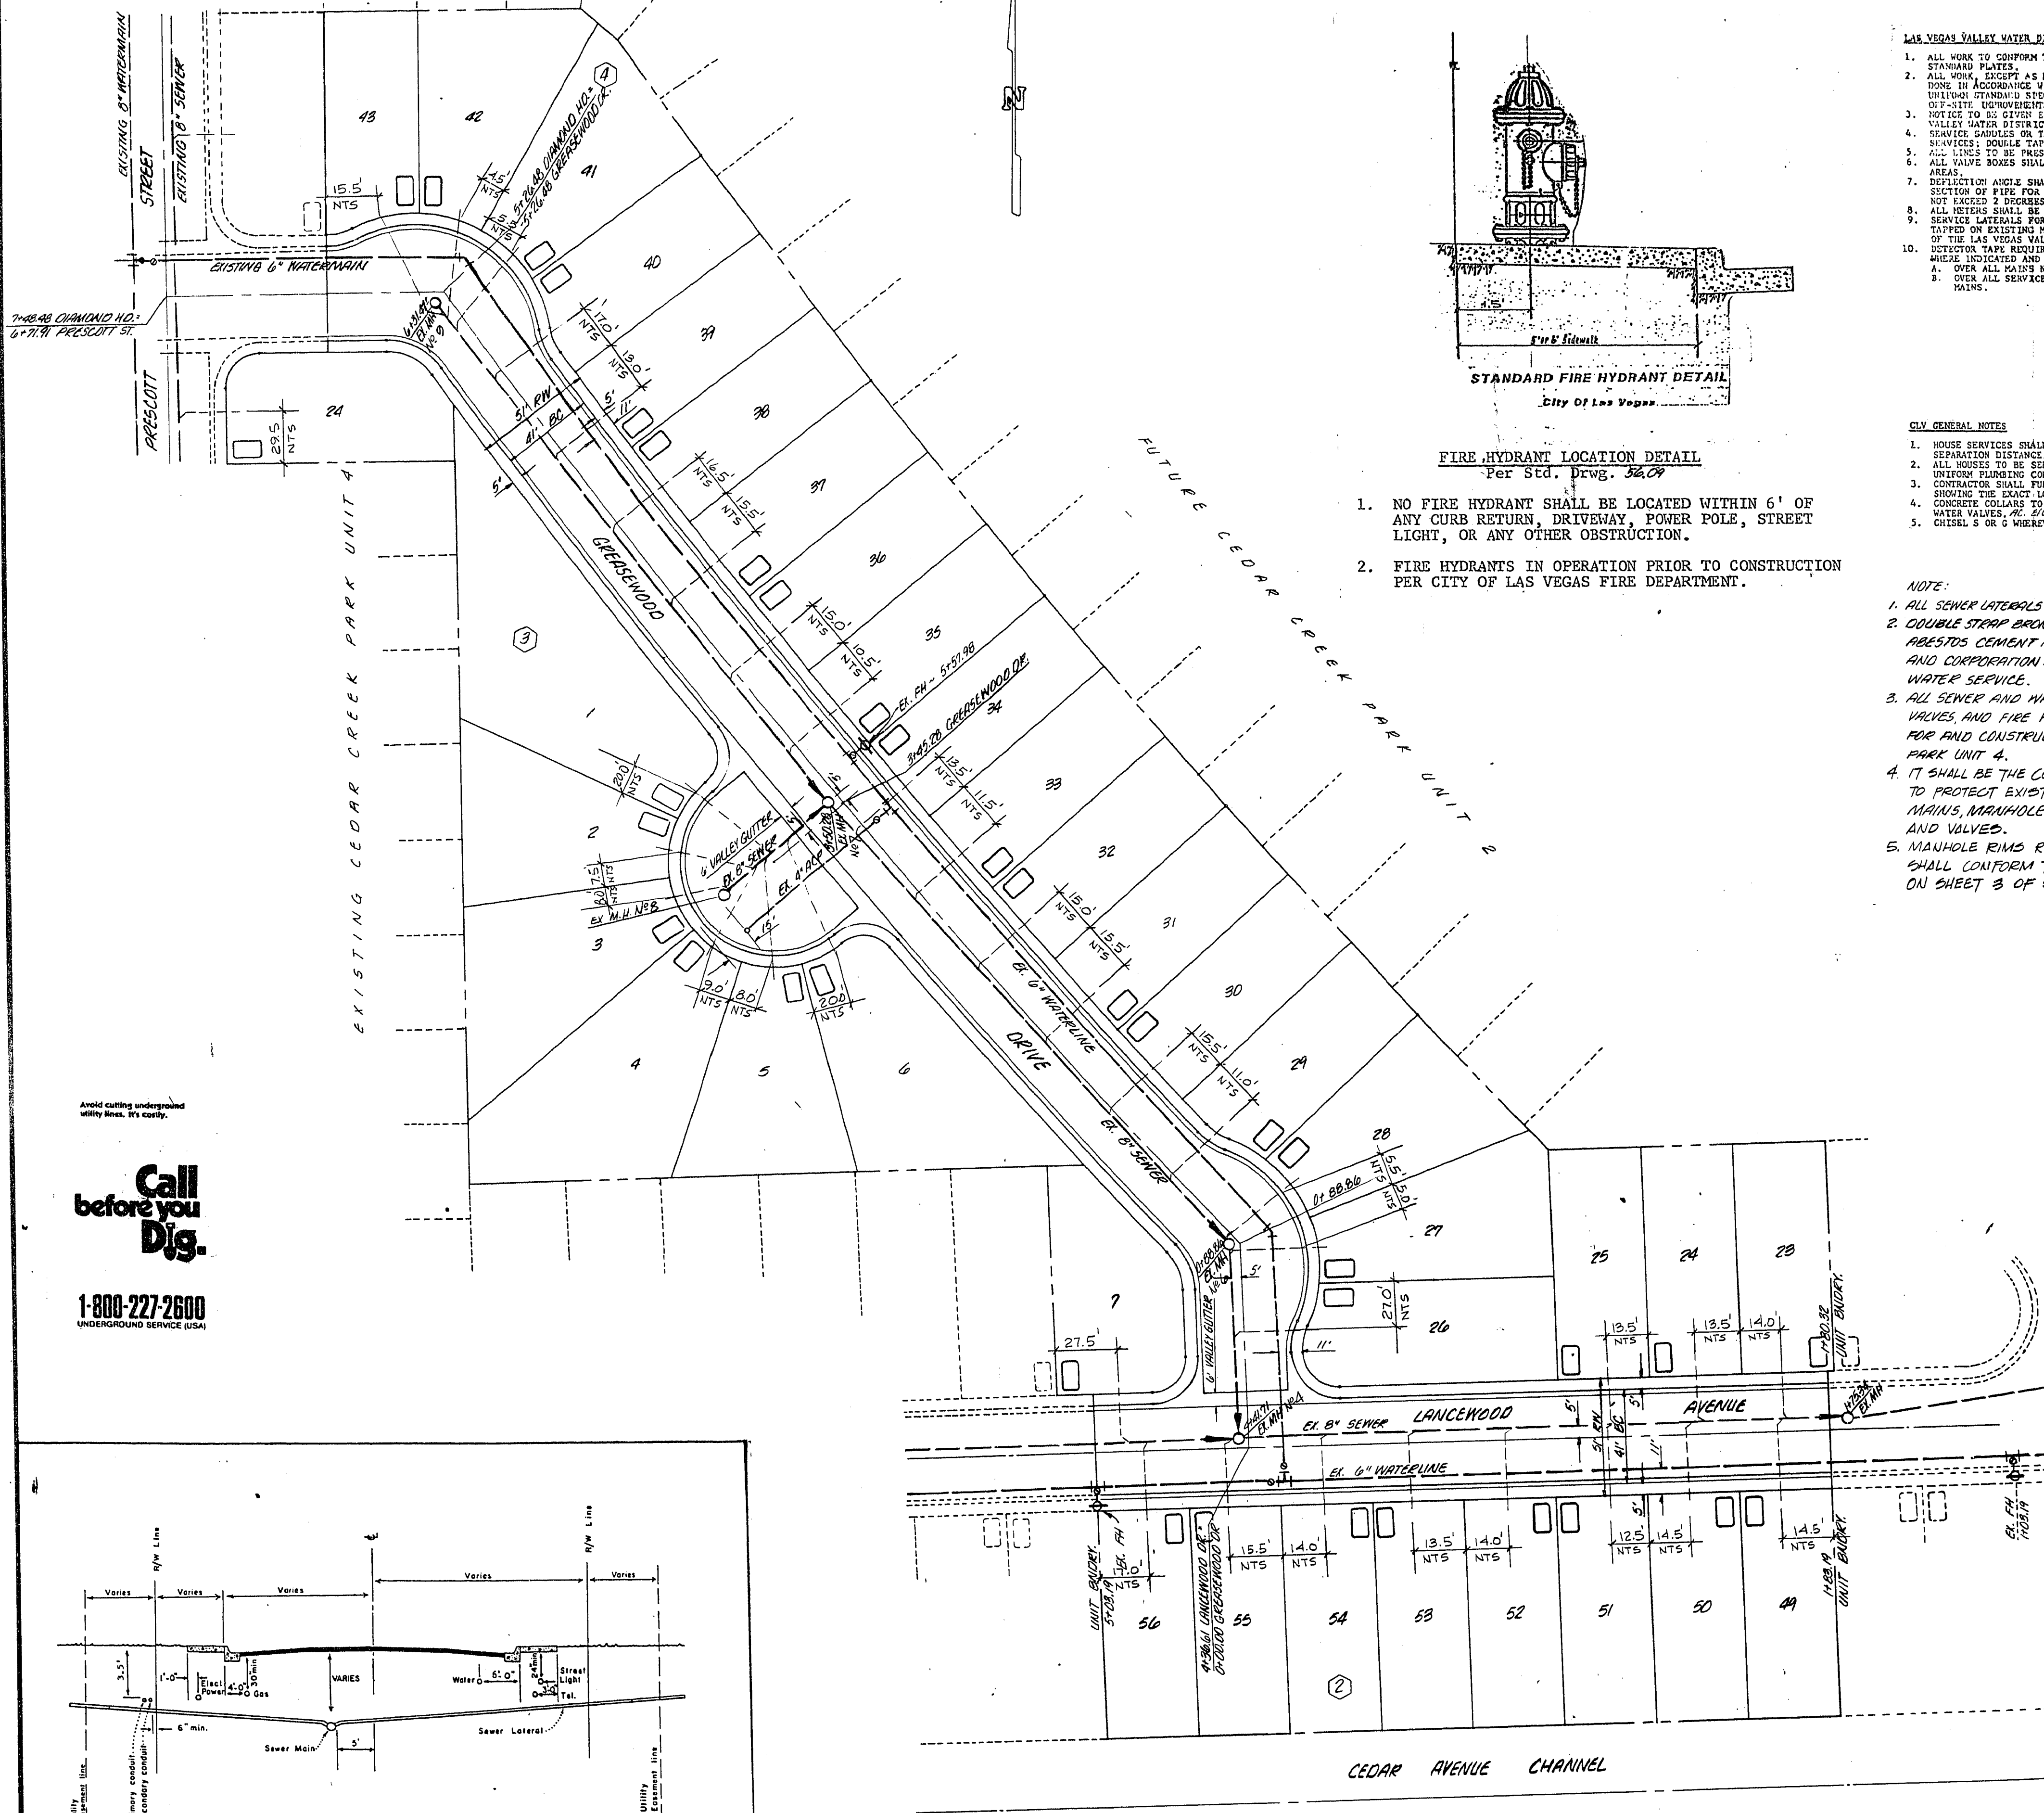


FIRE HYDRANT LOCATION DETAIL
Per Std. Drawg. 54.09

1. NO FIRE HYDRANT SHALL BE LOCATED WITHIN 6' OF ANY CURB RETURN, DRIVEWAY, POWER POLE, STREET LIGHT, OR ANY OTHER OBSTRUCTION.
2. FIRE HYDRANTS IN OPERATION PRIOR TO CONSTRUCTION PER CITY OF LAS VEGAS FIRE DEPARTMENT.

- LAS VEGAS VALLEY WATER DISTRICT NOTES
1. ALL WORK TO CONFORM TO LAS VEGAS VALLEY WATER DISTRICT STANDARD PLATES.
 2. ALL WORK, EXCEPT AS MODIFIED HEREON OR BY NOTE NO. 1, SHALL BE DONE IN ACCORDANCE WITH THE MOST CURRENT DRAFT OR EDITION OF UNIFORM STANDARD SPECIFICATIONS FOR PUBLIC WORKS CONSTRUCTION OFF-SITE, UTM MOVEMENTS, CLARK COUNTY AREA.
 3. NOTICE TO BE GIVEN ENGINEERING DEPARTMENT OF THE LAS VEGAS VALLEY WATER DISTRICT 48 HOURS PRIOR TO ACTUAL CONSTRUCTION.
 4. SERVICE SADDLES ON TAPPED COLLARS WILL BE REQUIRED ON ALL SERVICES; DOUBLE TAP COLLARS ARE NOT PERMITTED.
 5. ALL LINES TO BE PRESSURE TESTED TO 200 PSI.
 6. ALL VALVE BOXES SHALL HAVE CONCRETE COLLARS AT SURFACE OF PAVED AREAS.
 7. DEFLECTION ANGLE SHALL NOT EXCEED 14 DEGREES PER 13 FOOT SECTION OF PIPE FOR PIPE SIZES SMALLER THAN 14\"/>

- CLV GENERAL NOTES
1. HOUSE SERVICES SHALL COMPLY WITH WESTERN PLUMBING CODE AS THE SEPARATION DISTANCE.
 2. ALL HOUSES TO BE SERVED INDIVIDUALLY AS PER SECTION 313 OF THE UNIFORM PLUMBING CODE.
 3. CONTRACTOR SHALL FURNISH THE ENGINEER WITH AS-BUILT DRAWINGS SHOWING THE EXACT LOCATIONS OF ALL HOUSE CONNECTIONS.
 4. CONCRETE COLLARS TO BE CONSTRUCTED AROUND ALL MANHOLES AND WATER VALVES, SEE 82PR-822 ON MINOR STREETS.
 5. CHISEL S OR 6 WIRELESS SEWER OR GAS LINES PASS UNDER CURB.

- NOTE:
1. ALL SEWER LATERALS ARE EXISTING.
 2. DOUBLE STRAP BRONZE SERVICE SADDLE OR ASBESTOS CEMENT FACTORY TAPPED COLLAR, AND COPPERATION STOP, EXIST FOR EACH WATER SERVICE.
 3. ALL SEWER AND WATER MAINS, MANHOLES, VALVES, AND FIRE HYDRANTS, WERE BONDED FOR AND CONSTRUCTED WITH CEDAR CREEK PARK UNIT 4.
 4. IT SHALL BE THE CONTRACTOR'S RESPONSIBILITY TO PROTECT EXISTING SEWER AND WATER MAINS, MANHOLES, LATERALS, HYDRANTS, AND VALVES.
 5. MANHOLE RIMS REQUIRING ADJUSTMENT SHALL CONFORM TO THE ELEVATIONS SHOWN ON SHEET 3 OF 5.

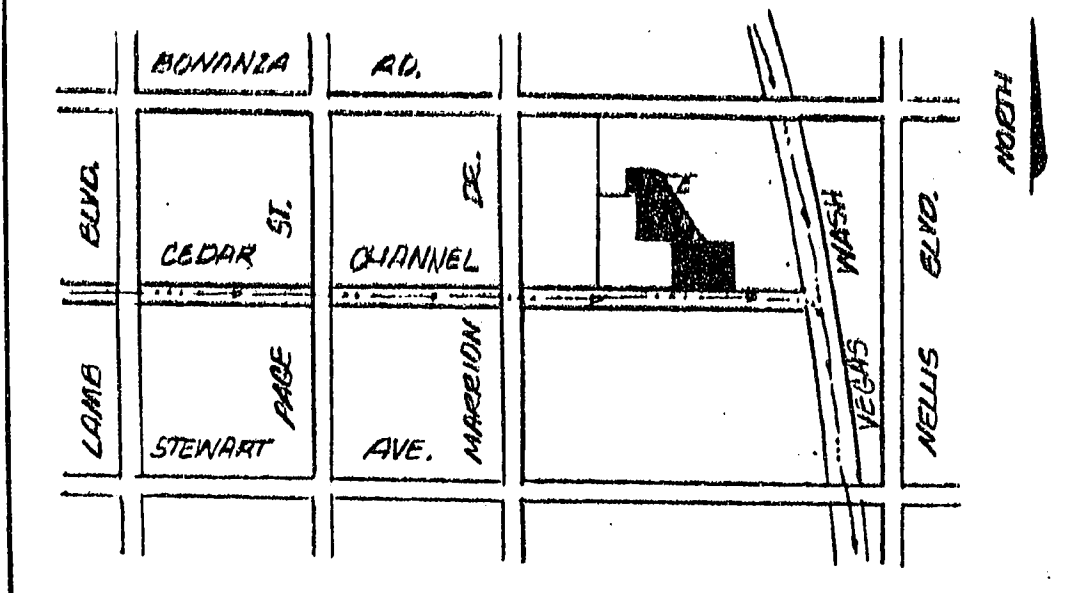

VICINITY MAP

LEGEND AND QUANTITIES ESTIMATE

- | | |
|----------------------------|--------|
| 5/8\"/> | 37 EA. |
| EXISTING MANHOLE | |
| EXISTING SEWER LATERAL | |
| EXISTING FIRE HYDRANT | |
| DRIVEWAY LOCATION | |
| EXISTING DRIVEWAY LOCATION | |

SEWER LATERAL "AS-BUILT" CERTIFICATION

Gene D. Krametbauer 2/13/85
GENE D. KRAMETBAUER, R.L.S. DATE
NEVADA CERT. NO. 6201

APPROVALS


[Signature] 7-13-83
CITY OF LAS VEGAS, CITY ENGINEER DATE

CITY OF LAS VEGAS, QUALITY CONTROL DATE

[Signature] 7-5-83
CITY OF LAS VEGAS, FIRE MARSHALL DATE


[Signature] 7-5-83
CITY OF LAS VEGAS, SANITARY ENGINEER DATE

Call before you Dig.
1-800-227-2600
UNDERGROUND SERVICE (USA)

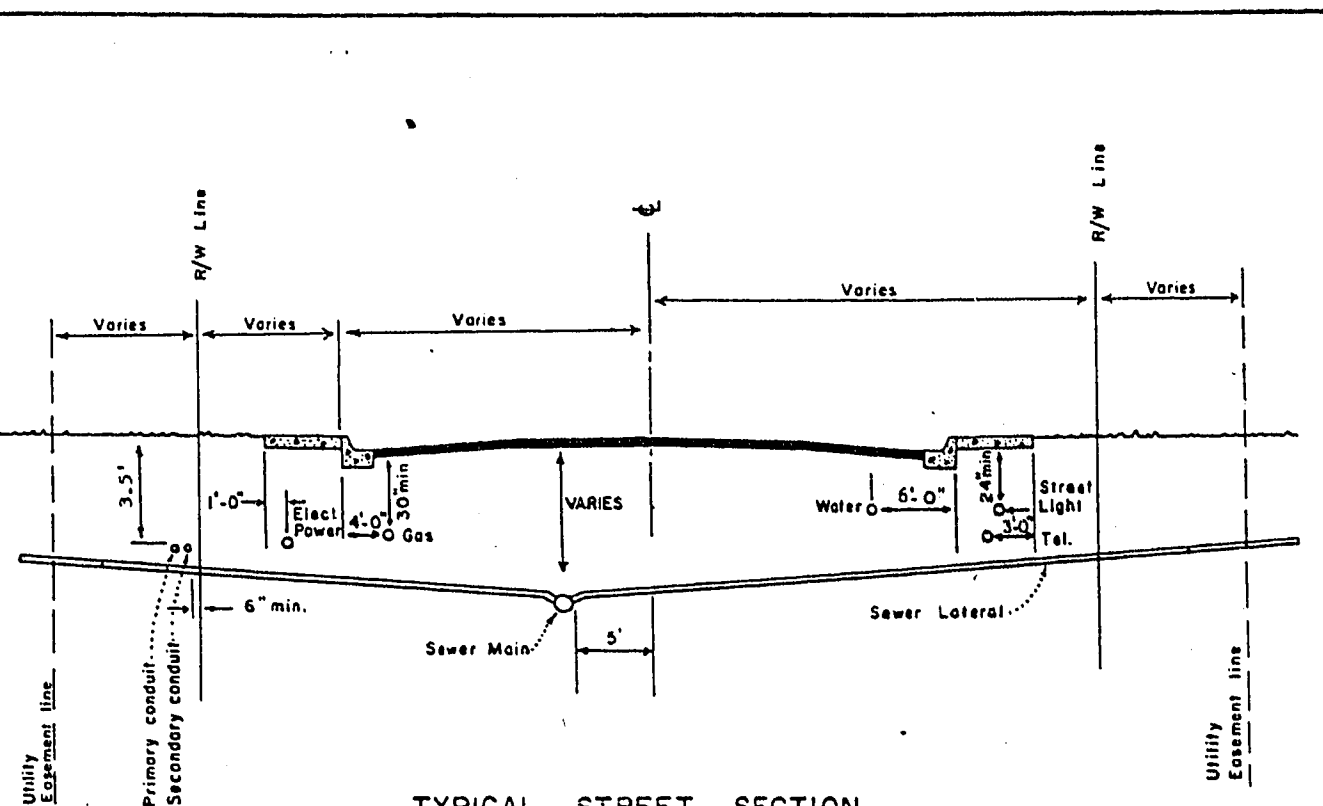

- NOTES:
1. One 5' section of pipe shall be laid past the property line or utility easement if applicable.

12/15/82

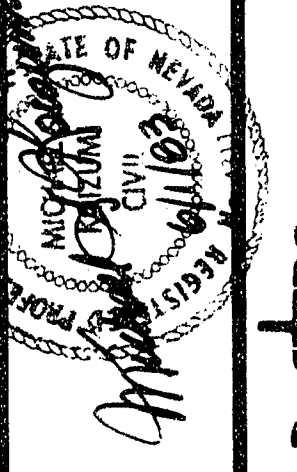

MASTER SEWER AND WATER PLAN
MAF NO. 307Y-1020-3 N 1/2, N.E. 1/4 SEC. 32-2, T. 20S., R. 62 E.
PROJECT CEDAR CREEK PARK UNIT 3

WO NO. 2032-3
BY VEB
DATE JUNE, 1983
SCALE 1\"/>

SHEET 4
OF 5 SHEETS

As Built 22-6-60 307Y-1020-3