


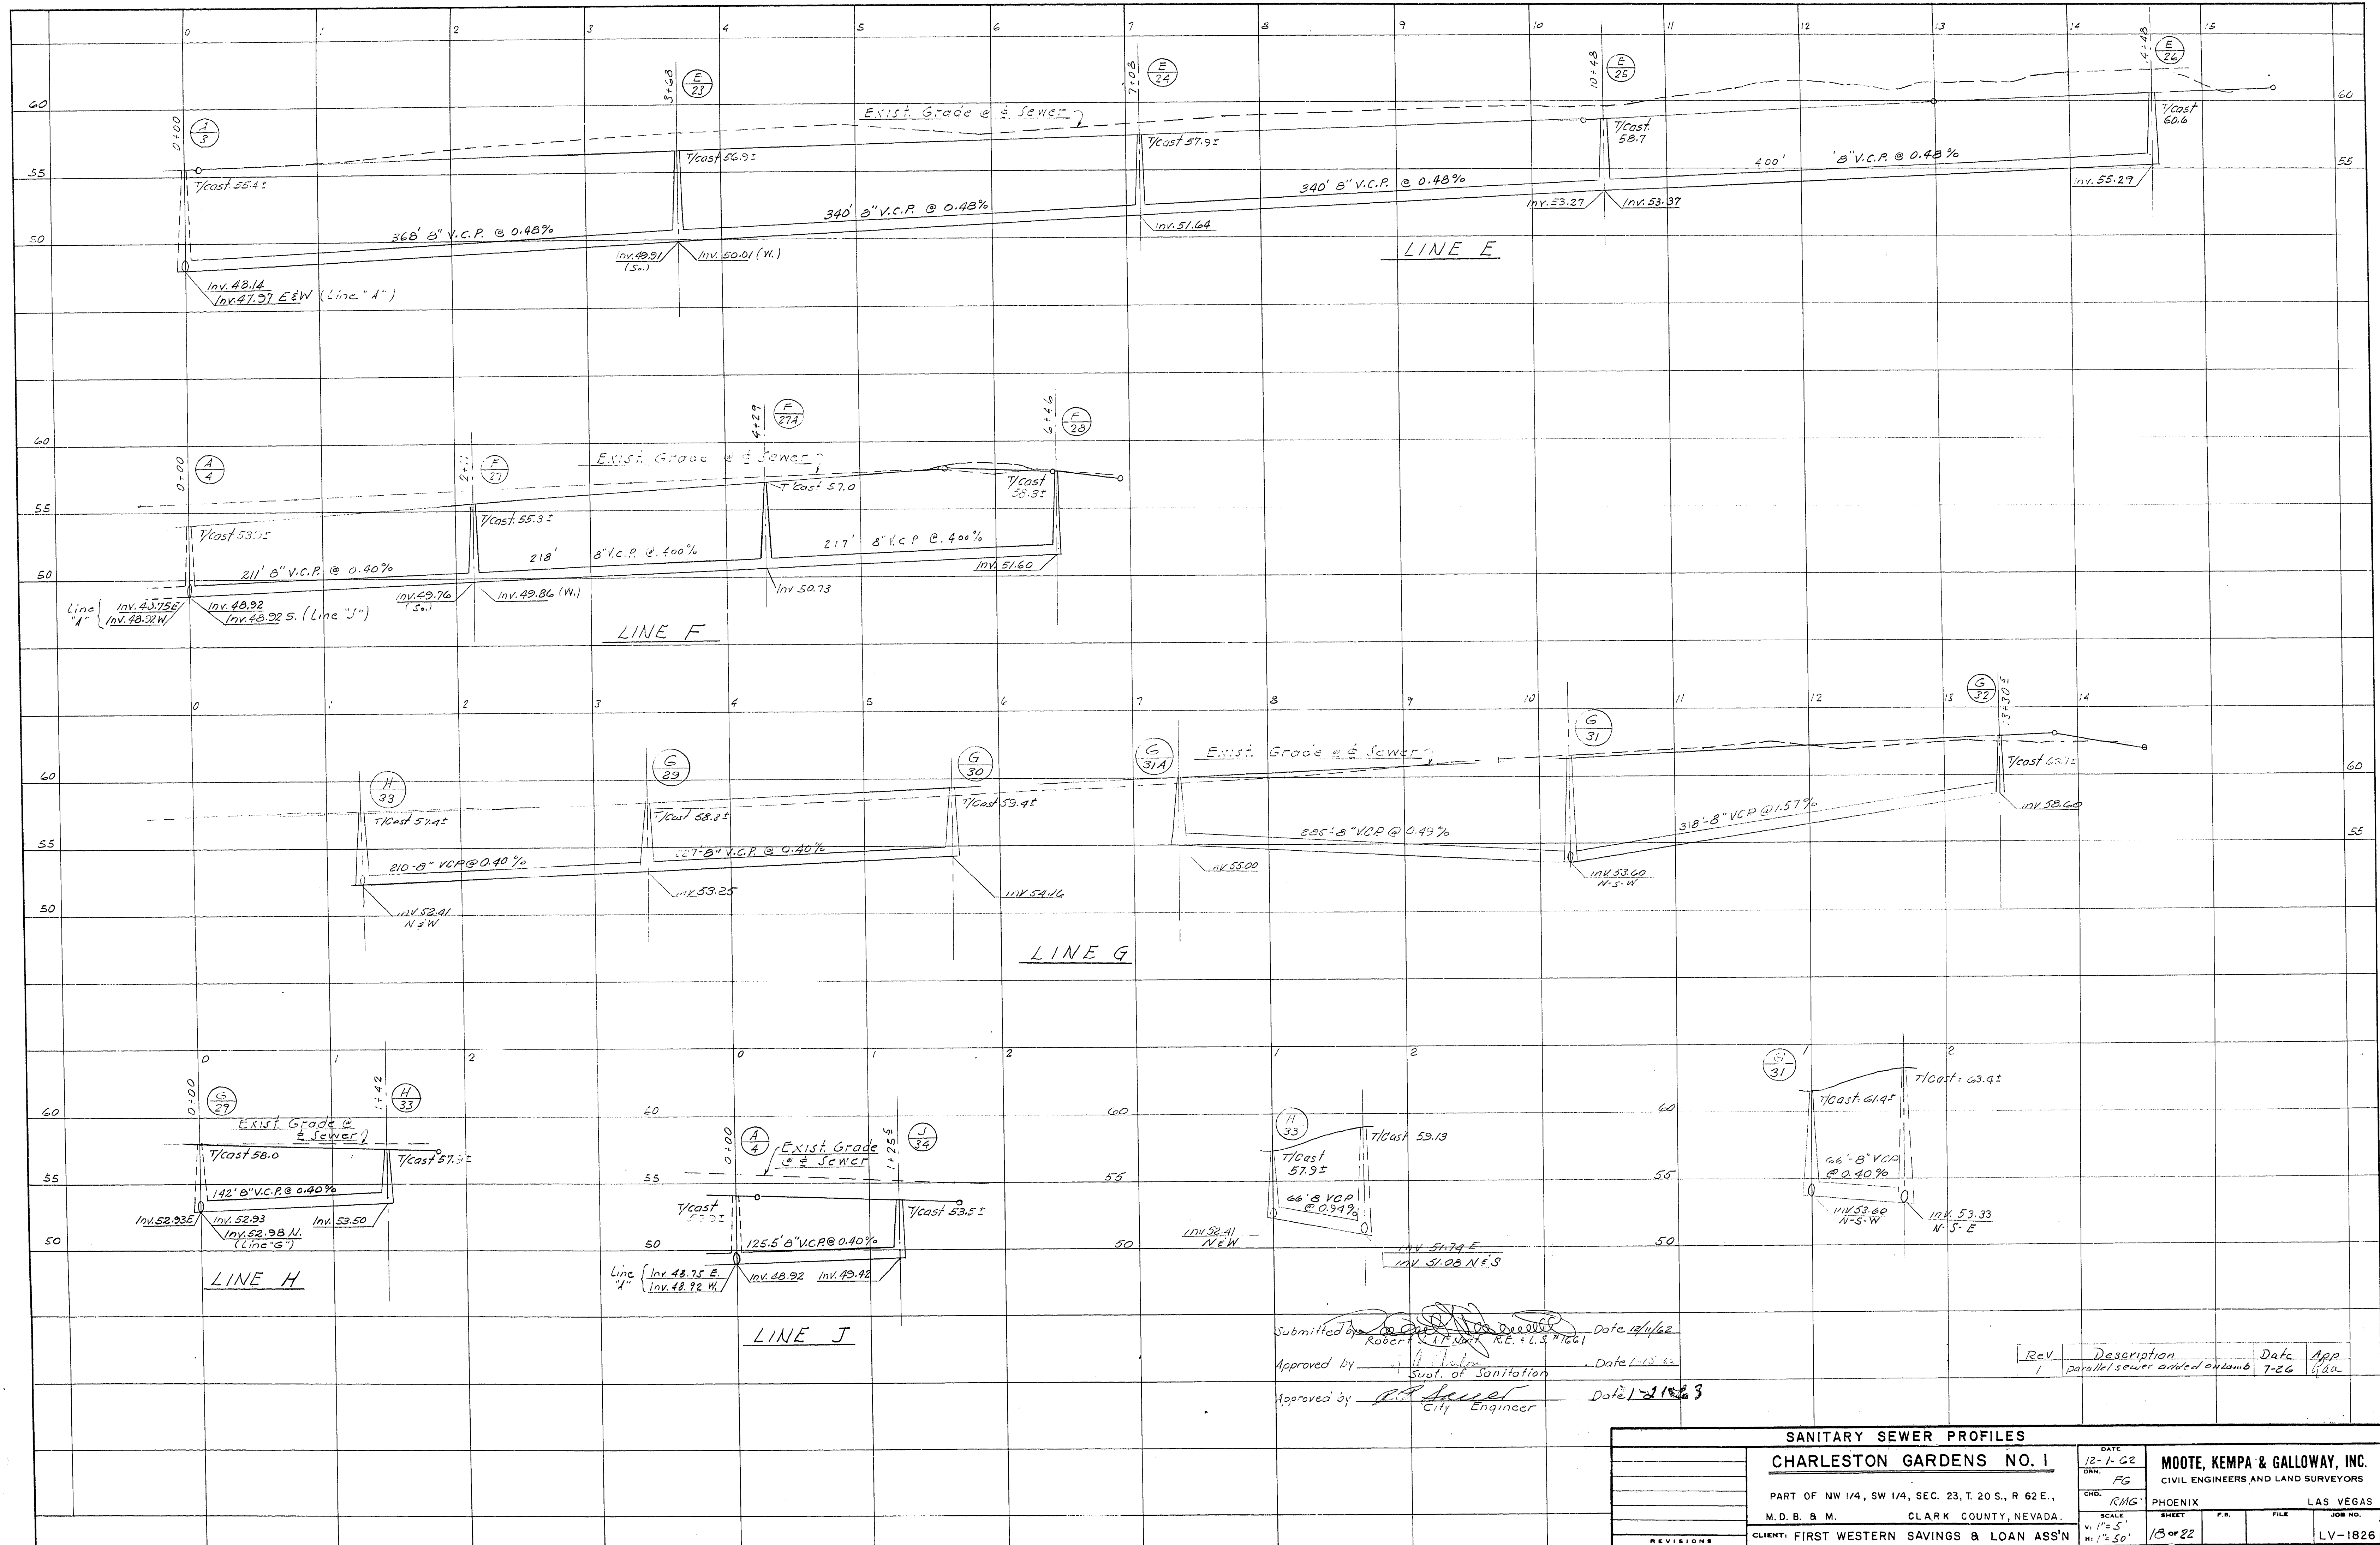

Submitted by *[Signature]* Date 12/1/62
Robert L. Kempa, R.E., L.S. #1661
Approved by *[Signature]* Date 1-15-63
Supt. of Sanitation
Approved by *[Signature]* Date 1-15-63
City Engineer

Rev.	Description	Date	App.
1	parallel sewer added on line 6	7-26	6/60

SANITARY SEWER PROFILES			
CHARLESTON GARDENS NO. 1			
PART OF NW 1/4, SW 1/4, SEC. 23, T. 20 S., R. 62 E., M.D.B. & M. CLARK COUNTY, NEVADA.		DATE 12-1-62 DWN. FG CHKD. RMS	MOOTE, KEMPA & GALLOWAY, INC. CIVIL ENGINEERS AND LAND SURVEYORS LAS VEGAS
CLIENT: FIRST WESTERN SAVINGS & LOAN ASS'N		SCALE V: 1"=5' H: 1"=50'	SHEET 13 OF 22 JOB NO. LV-1826

24-10-42 3074-1039-1