


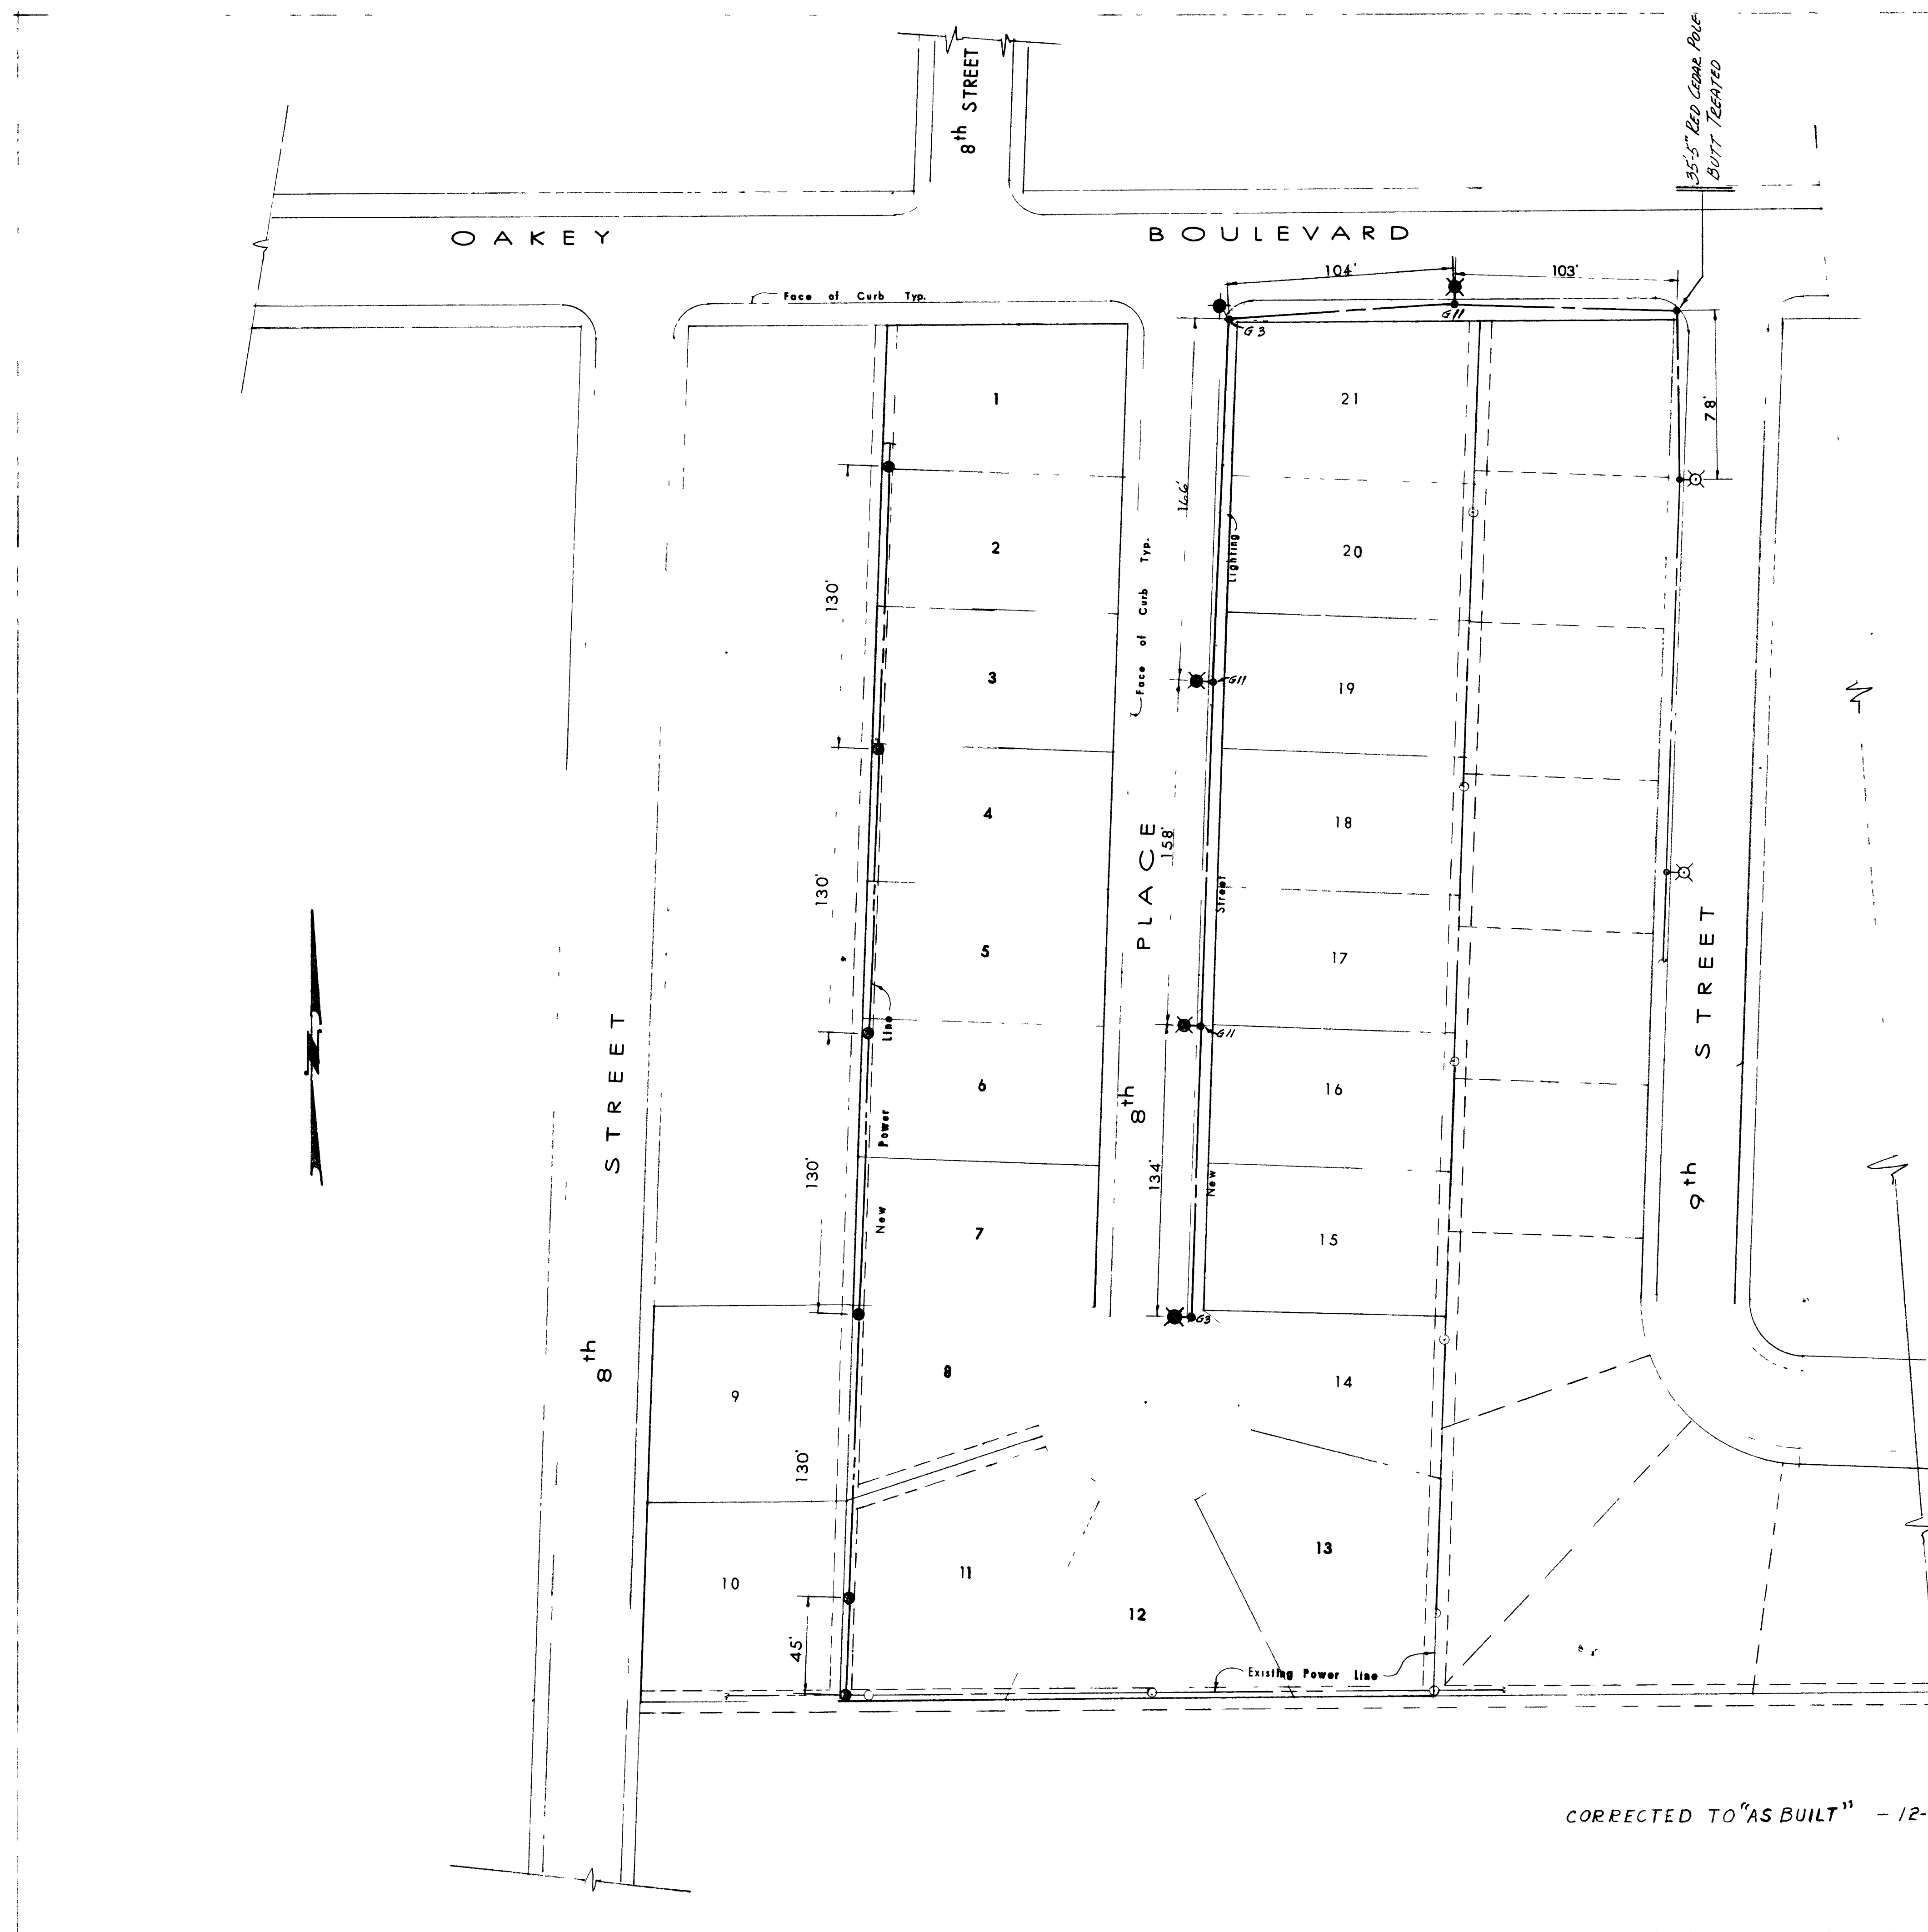

CORRECTED TO "AS BUILT" - 12-13-54 by: R&R

LEGEND

- NEW UNION METAL CO. STREET LIGHT POLE
- I.E.S. TYPE 3 DISTRIBUTION REFRACTOR LUMINAIRE
- MEDIUM HARD-DEATH BALE #6 COPPER WIRE - 2 CONDUCTORS
- EXISTING STREET LIGHT STANDARD
- NEW POWER LINE
- EXISTING POWER LINE

SPECIFICATIONS

- STANDARD TO BE ULM DESIGN H-300 B1 NO 400 OR EQUAL
- LUMINAIRE SHALL BE LUM. MATERIAL CO. NO 603800-C-628 WITH 1 1/4" SUPPLIER
- OR APPROVED EQUAL. WITH 2500 LUMEN LAMP 6.6 REPLACEMENT TYPE III DISTRIBUTION.
- WIRE FROM OVERHEAD CABLE TO LUMINAIRE SHALL BE #8 TYPE EE - 5000 IN.
- 3 GAUGE POLES FOR INTERMEDIATE
- 11 GAUGE POLES FOR INTERMEDIATE
- FOOTINGS TO CONFORM TO CITY OF LAS VEGAS SPECIFICATIONS

AS BUILT

APPROVED:

[Signature]
DIRECTOR OF PUBLIC WORKS
LAS VEGAS, NEVADA
[Signature]
CITY ELECTRICIAN

ACRES ADDITION TRACT
ELECTRICAL

POWER DISTRIBUTION

and

STREET LIGHTING

Scale: 1" = 40'

Date: 4-18-54

Drawn By: *[Signature]*
SHEET 5 of 5

207Y-800-1
15-6-94

