


POINT	NORTH	EAST
900	4230.172	4641.922
901	4189.560	4595.913
902	4189.482	4564.056
903		
904		
905	4191.297	4489.049
906	4191.105	4409.549
907	4203.611	4412.019
908	4191.011	4371.050
909	4111.011	4371.245
910	4061.511	4371.366
911	4110.823	4284.273
912	4090.963	4274.510
913	4110.606	4295.915
914	4097.390	4122.967
915	4097.323	4095.559
916	4116.796	4095.512
917	4097.266	4072.011
918	4081.707	4072.049
919	4184.318	4087.565
920	4248.752	4354.621
921	4241.129	4327.831
922	4259.470	4351.572
923	4325.921	4334.230
924	4358.803	4334.144
925	4356.881	4366.008
926	4391.569	4334.059
927	4391.610	4350.705
928	4405.921	4334.022
929	4406.648	4222.522
930	4432.648	4222.459
931	4432.636	4217.459
932	4439.648	4232.442
933	4439.662	4227.942
934	4348.588	4120.449
935	4343.757	4111.957
936	4393.865	4070.293
937	4262.063	4613.078
938	4277.239	4637.179
939	4276.590	4600.844
940	4386.572	4600.572
941	4386.346	4598.073
942	4428.346	4507.970
943	4424.334	4502.980
944	4428.362	4514.470
945	4325.854	4306.720
POINT	NORTH	EAST
946	4190.334	4514.052
947	4089.871	4514.589
948	4053.416	4550.734
949	4372.484	4769.154
950	4423.201	4769.030
951	4423.326	4764.031
952	4423.104	4777.364
953	4375.803	4655.444
954	4087.544	4384.899

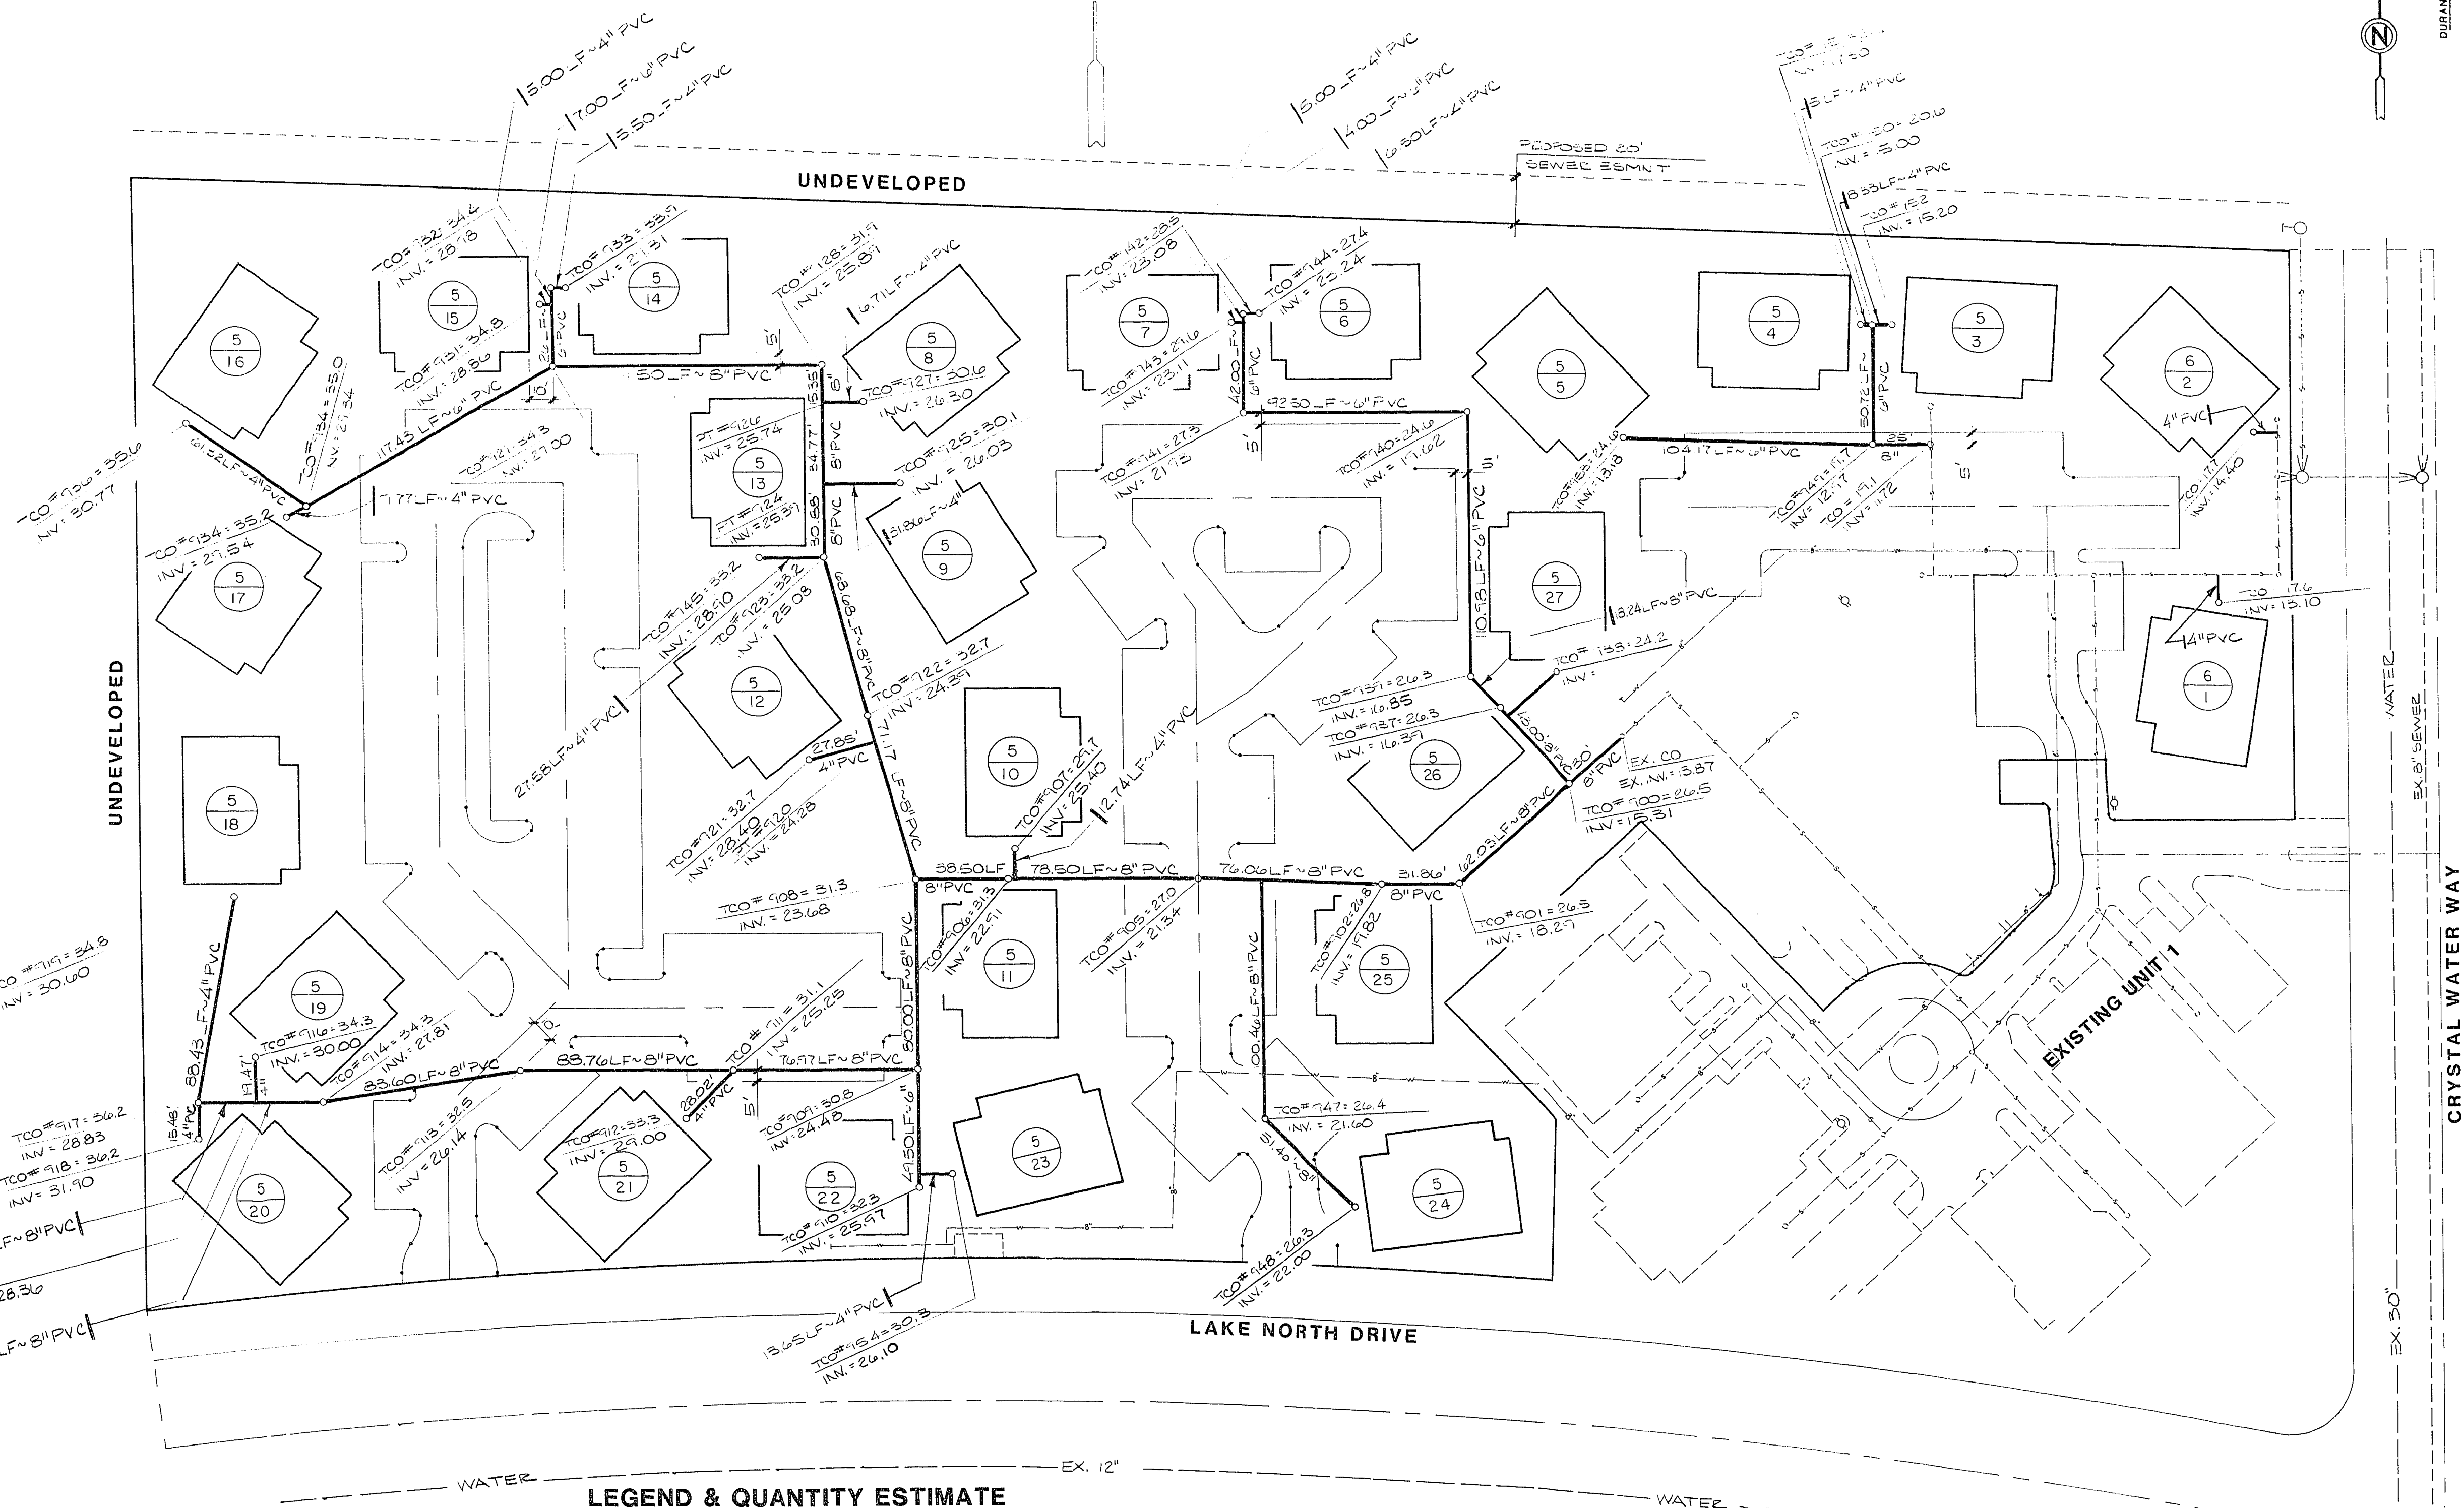

GENERAL NOTES

- House services shall comply with Western Plumbing Code as to separation distance.
- All buildings to be served individually as per Section 313 of the Uniform Plumbing Code.
- Contractor shall furnish the Engineer with as-built drawings showing the exact locations of all building connections.
- Chisel S or G wherever sewer or gas lines pass under curb.
- Backfill shall be any excavated, imported or transported material which is free from large lumps greater than 6\" in diameter and free of organic material. Backfill shall be compacted by flooding or tamping to a density specified by the Soils Engineer.
- Trench notes apply to VCP sewer pipe only. If PVC alternate is used, then trench backfill to comply with the City of Las Vegas inter-office memorandum dated January 25, 1980.
- Backfill to 12\" minimum cover over pipe with selected sand or gravel no larger than 2\" diameter.
- Top of cleanout elevations are ± and shall be adjusted to finish grades after landscaping.

LEGEND & QUANTITY ESTIMATE

0 CLEANOUT	48	EA
8\" PVC SEWER	1263	LF
6\" PVC SEWER	604	LF
4\" PVC SEWER	397	LF

MASTER SEWER PLAN

BAYCLIFF CREEKS UNIT 2

TITLE

WO NO. 3370

BY SCD

DATE

SCALE 1\" = 40'

SHEET

3


OF 4 SHEETS

307Y-843-2

DIVERSIFIED DEVELOPMENT
CITY OF LAS VEGAS

vtm nevada

CONSULTING ENGINEERS - PLANNERS
2300 PASEO DEL PRADO BUILDING A SUITE 100
LAS VEGAS, NEVADA 89102 PHONE (702) 873-7550

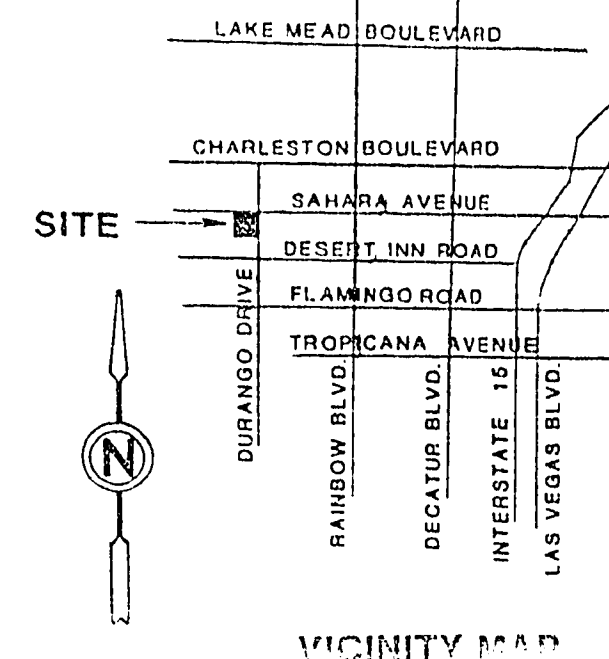

Mydwell
6/10/87