
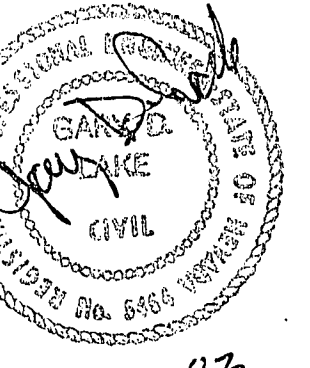
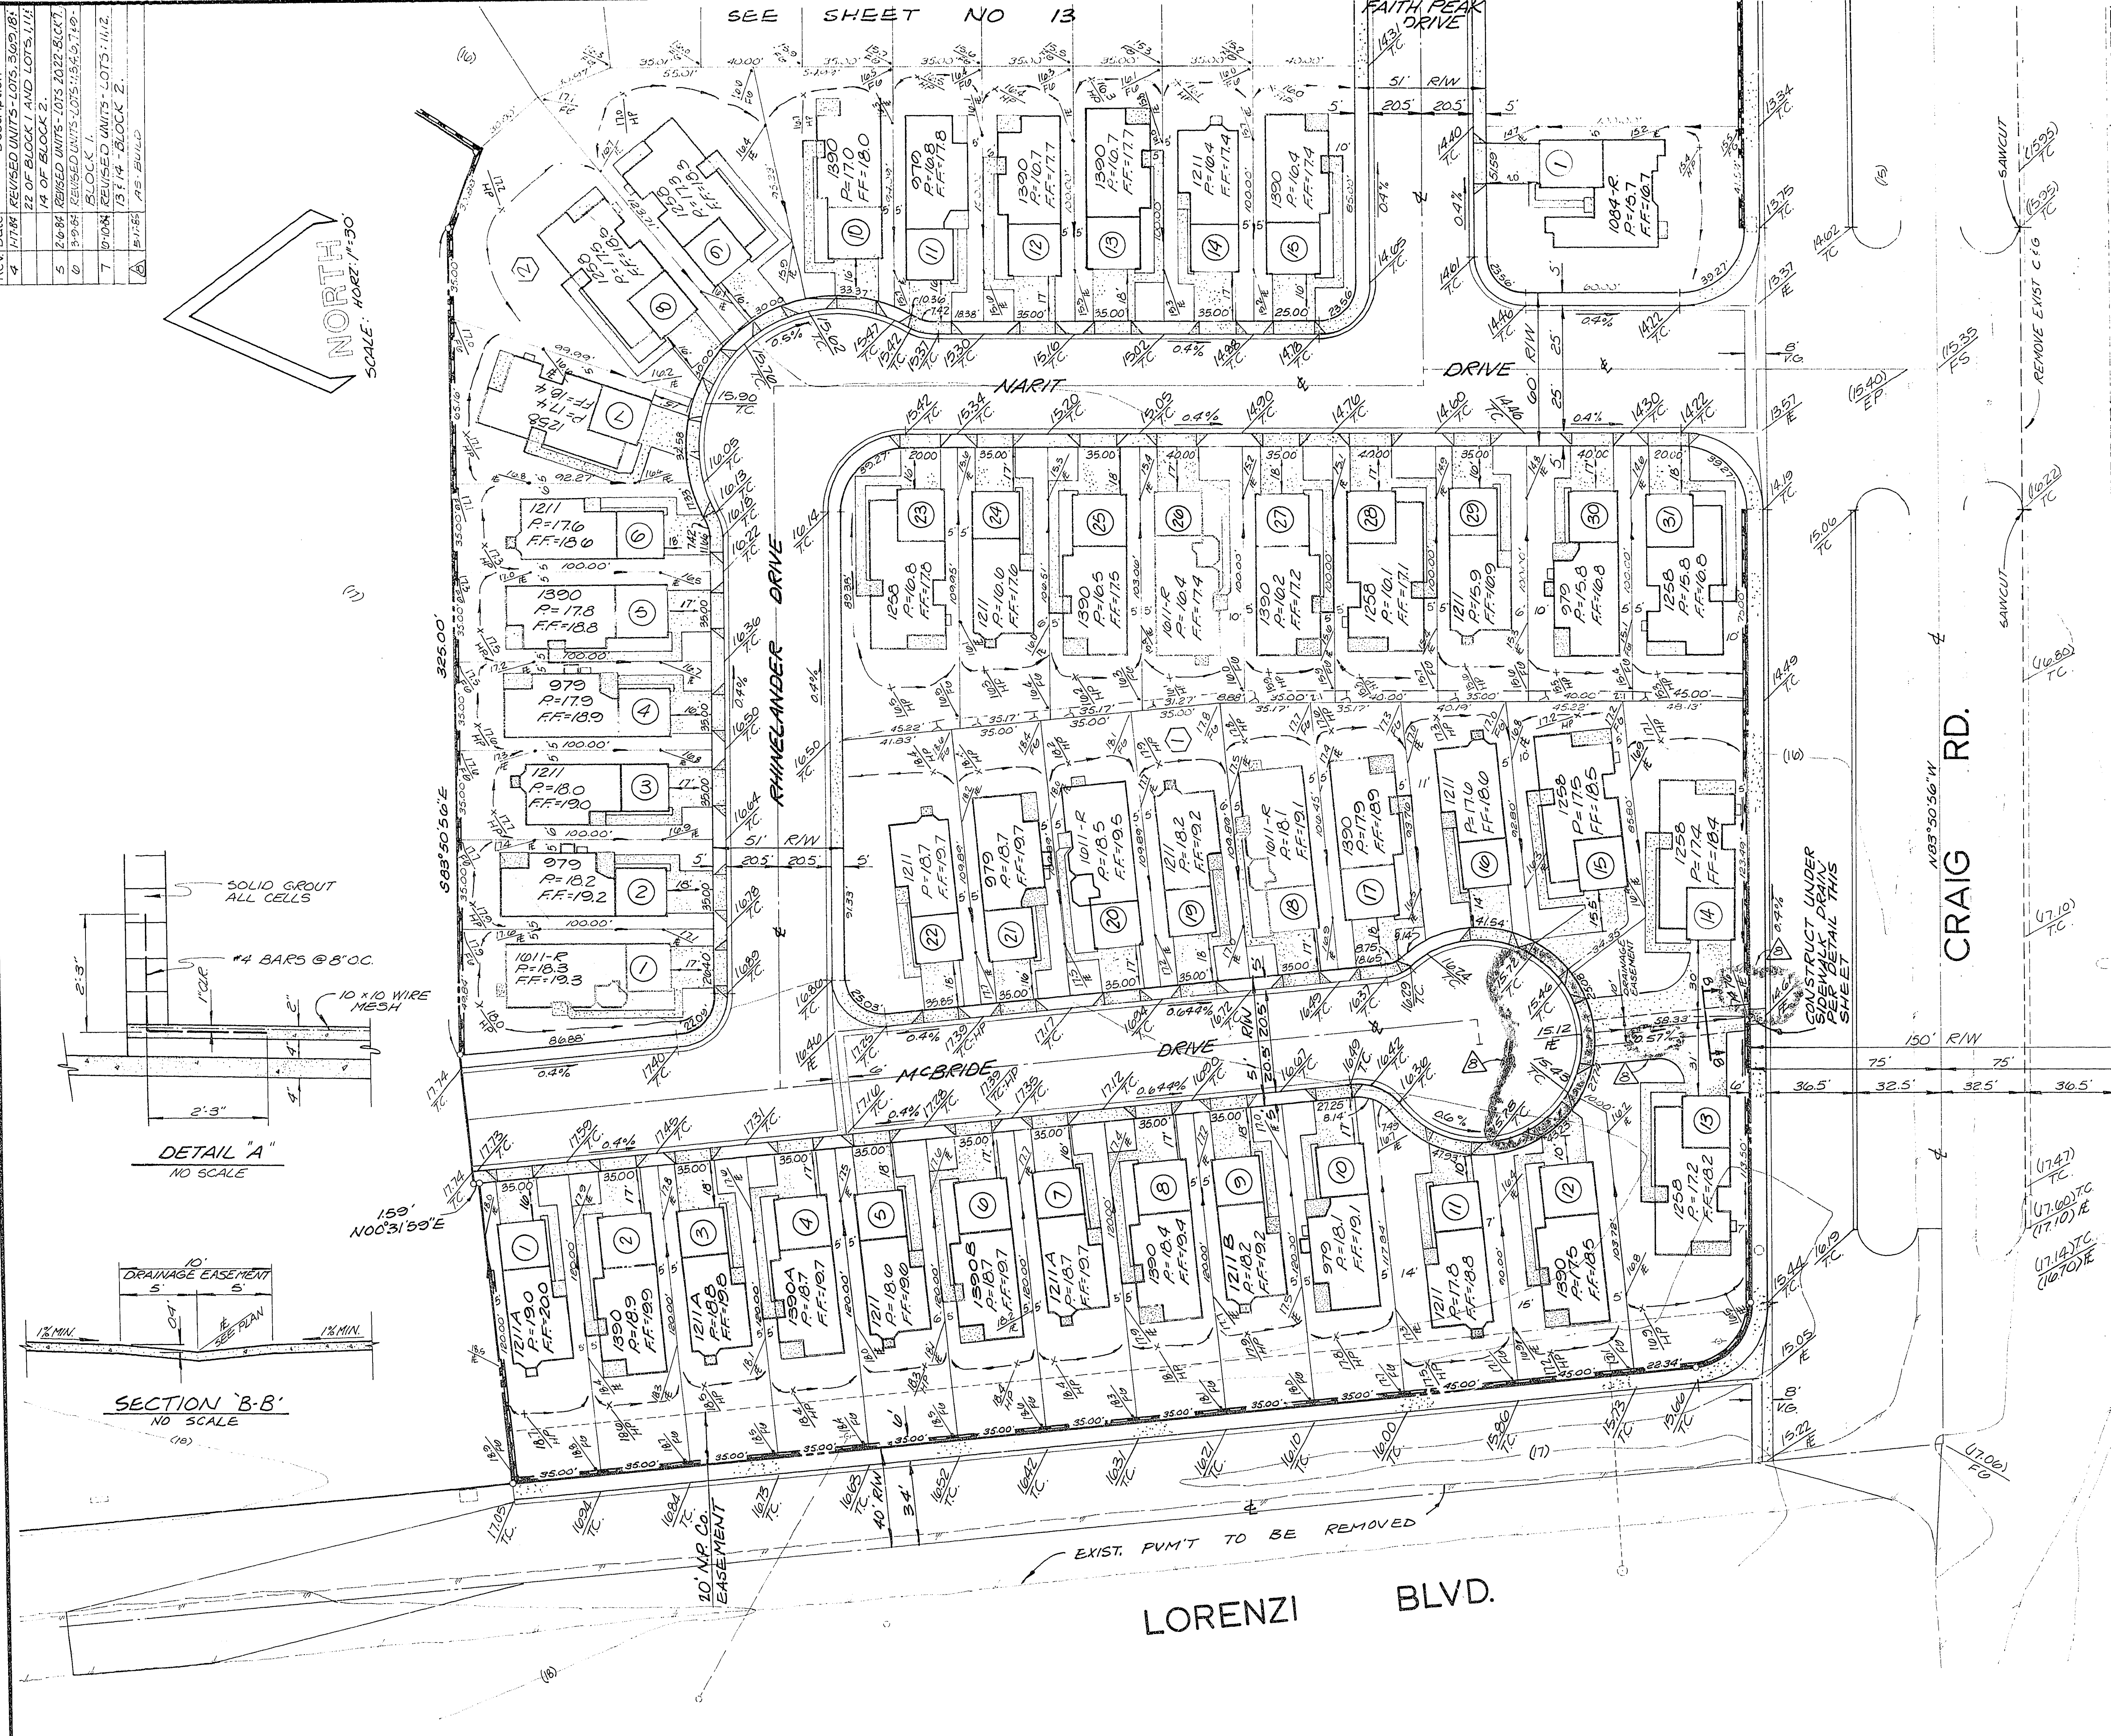
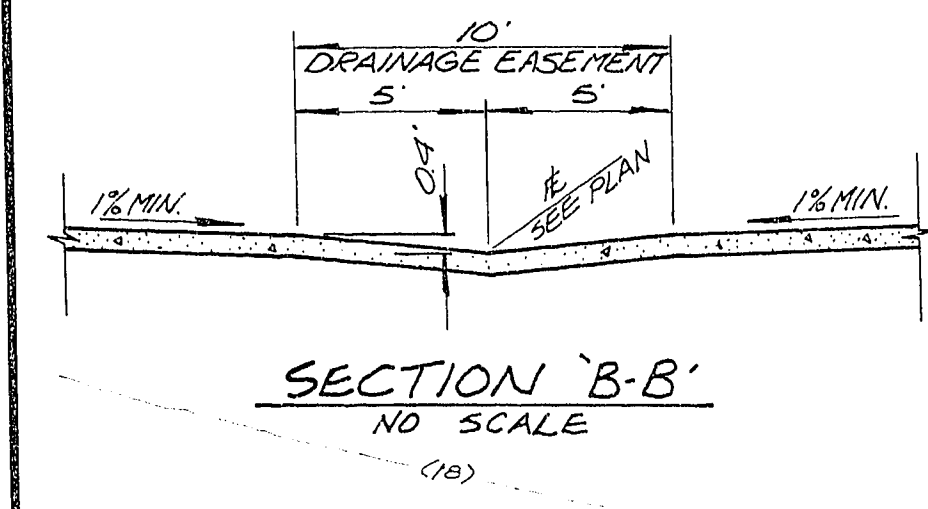
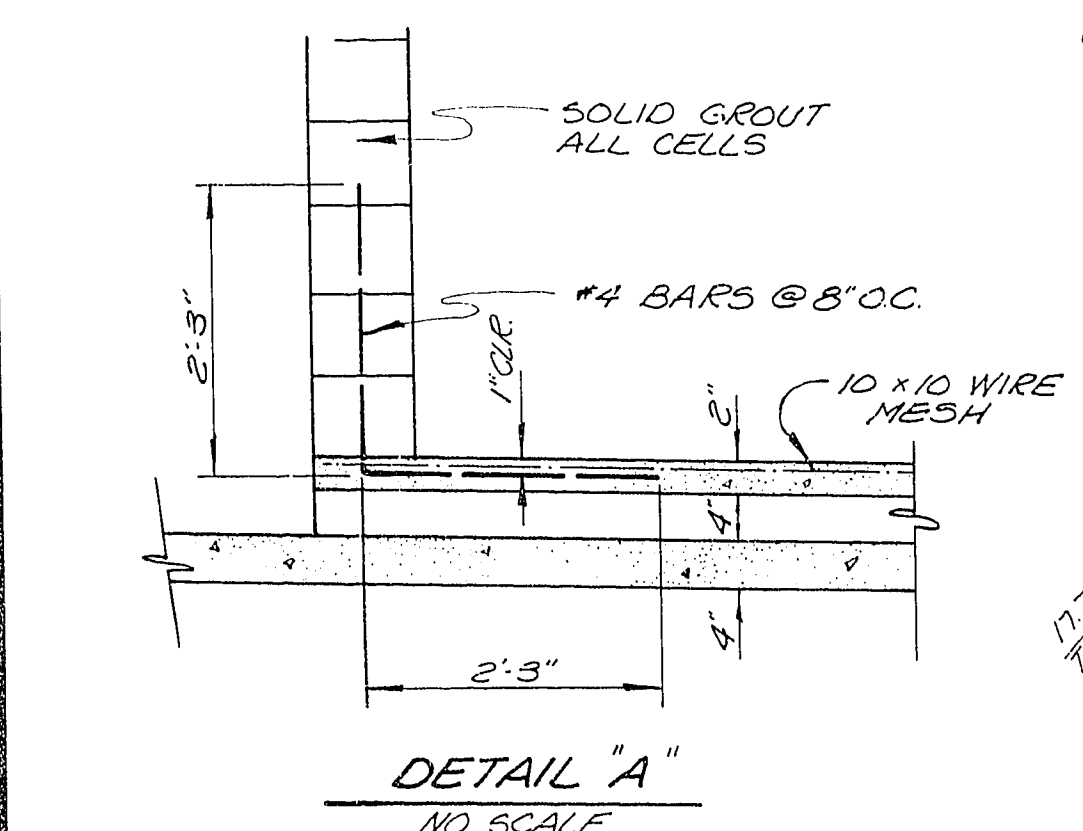


Rev	Date	Description
4	11/14/83	REVISED UNITS - LOTS 1, 2, 3, 4, 5, 6, 7, 8, 9, 10, 11, 12, 13, 14, 15, 16, 17, 18, 19, 20, 21, 22 OF BLOCK 1 AND LOTS 1, 2, 3, 4, 5, 6, 7, 8, 9, 10, 11, 12, 13, 14, 15, 16, 17, 18, 19, 20, 21, 22 OF BLOCK 2.
5	2/6/84	REVISED UNITS - LOTS 1, 2, 3, 4, 5, 6, 7, 8, 9, 10, 11, 12, 13, 14, 15, 16, 17, 18, 19, 20, 21, 22 OF BLOCK 1 AND LOTS 1, 2, 3, 4, 5, 6, 7, 8, 9, 10, 11, 12, 13, 14, 15, 16, 17, 18, 19, 20, 21, 22 OF BLOCK 2.
6	9/9/84	REVISED UNITS - LOTS 1, 2, 3, 4, 5, 6, 7, 8, 9, 10, 11, 12, 13, 14, 15, 16, 17, 18, 19, 20, 21, 22 OF BLOCK 1 AND LOTS 1, 2, 3, 4, 5, 6, 7, 8, 9, 10, 11, 12, 13, 14, 15, 16, 17, 18, 19, 20, 21, 22 OF BLOCK 2.
7	9/10/84	REVISED UNITS - LOTS 1, 2, 3, 4, 5, 6, 7, 8, 9, 10, 11, 12, 13, 14, 15, 16, 17, 18, 19, 20, 21, 22 OF BLOCK 1 AND LOTS 1, 2, 3, 4, 5, 6, 7, 8, 9, 10, 11, 12, 13, 14, 15, 16, 17, 18, 19, 20, 21, 22 OF BLOCK 2.
8	9/12/84	REVISED UNITS - LOTS 1, 2, 3, 4, 5, 6, 7, 8, 9, 10, 11, 12, 13, 14, 15, 16, 17, 18, 19, 20, 21, 22 OF BLOCK 1 AND LOTS 1, 2, 3, 4, 5, 6, 7, 8, 9, 10, 11, 12, 13, 14, 15, 16, 17, 18, 19, 20, 21, 22 OF BLOCK 2.

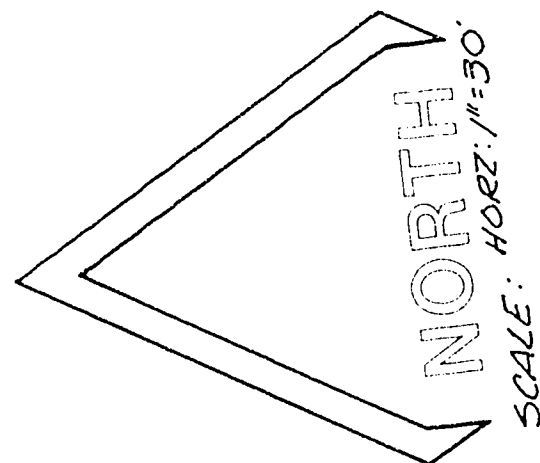


APPROVALS

R.A. Homes DATE: 7/6/83
 CLY CHIEF, LAND DEVELOPMENT AND FLOOD CONTROL

John S. McDaniel DATE: 7-5-83
 CLY CITY ENGINEER

CLY QUALITY CONTROL ENGINEER DATE: _____

John S. McDaniel DATE: 6/15/83
 NEVADA POWER

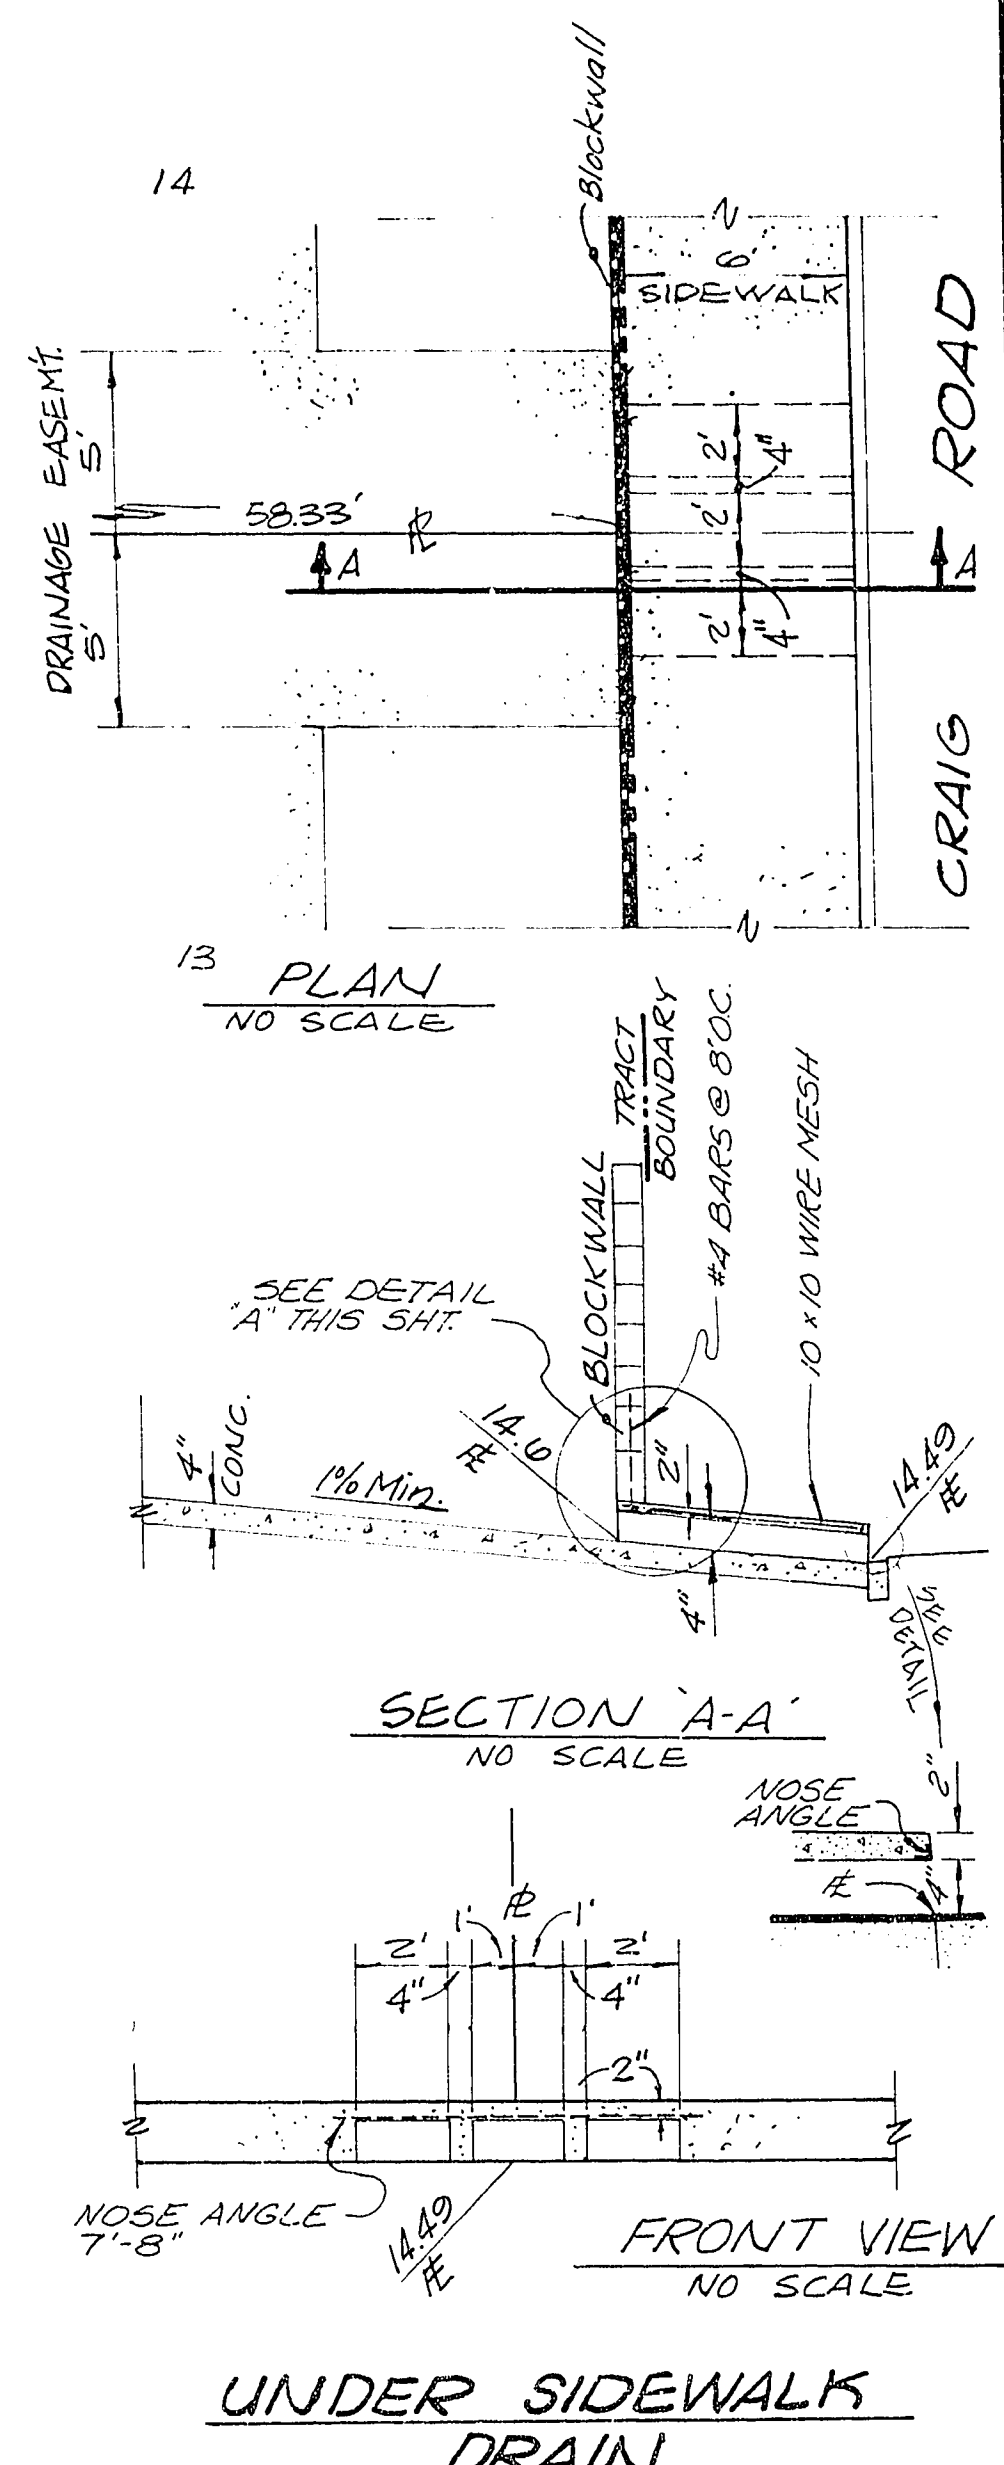

Rev	Date	Description
1	1/11/83	REVISED UNITS - LOTS 1, 2, 3, 4, 5, 6, 7, 8, 9, 10, 11, 12, 13, 14, 15, 16, 17, 18, 19, 20, 21, 22 OF BLOCK 1 AND LOTS 1, 2, 3, 4, 5, 6, 7, 8, 9, 10, 11, 12, 13, 14, 15, 16, 17, 18, 19, 20, 21, 22 OF BLOCK 2.
2	10/18/83	REVISED UNIT - 1, BLOCK 1.
3	1/13/84	REVISED UNIT - LOT 20, BLOCK 1.

FOR MORE REVISIONS SEE OPPOSITE CORNER OF PAGE.

PAWA INCORPORATED OF NEVADA

801 South Ranch Drive • Suite D-3A • Las Vegas, NV 89 106 • (702) 386-0610

R.A. HOMES

BEDFORD VILLAGE WEST UNIT NO. 1

PLOT & GRADING PLAN

SHEET 14

of 14 sheets

