






PLAN
SCALE 1" = 100'

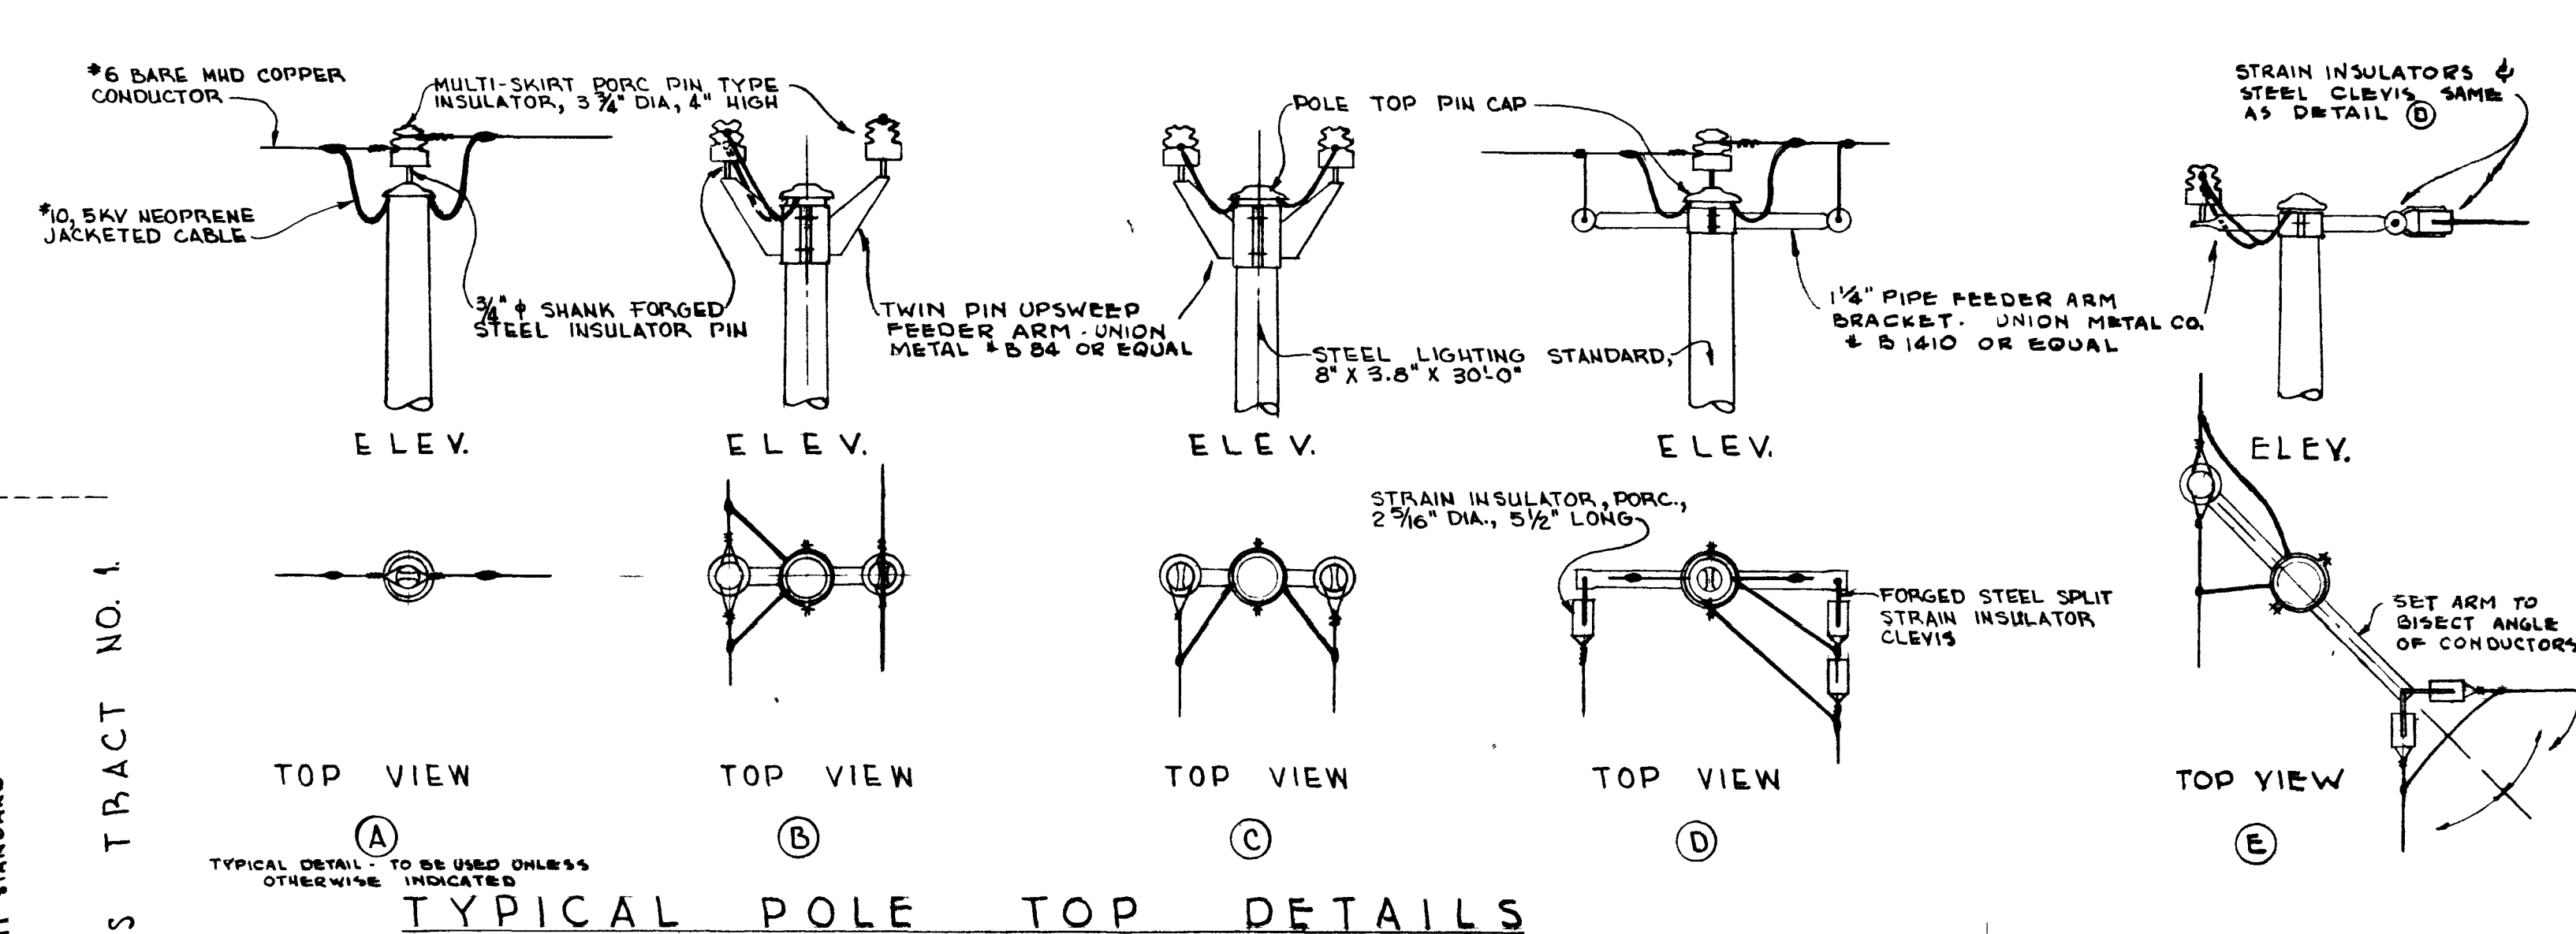

TYPICAL POLE TOP DETAILS
NO SCALE

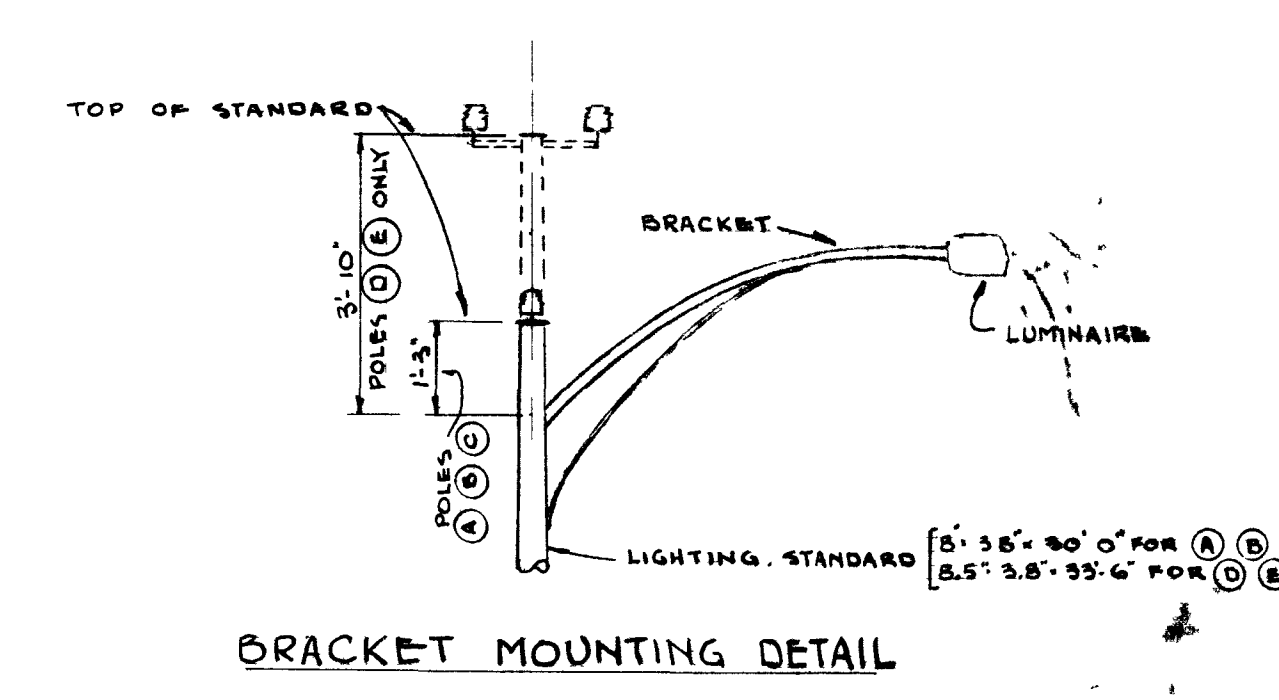

BRACKET MOUNTING DETAIL

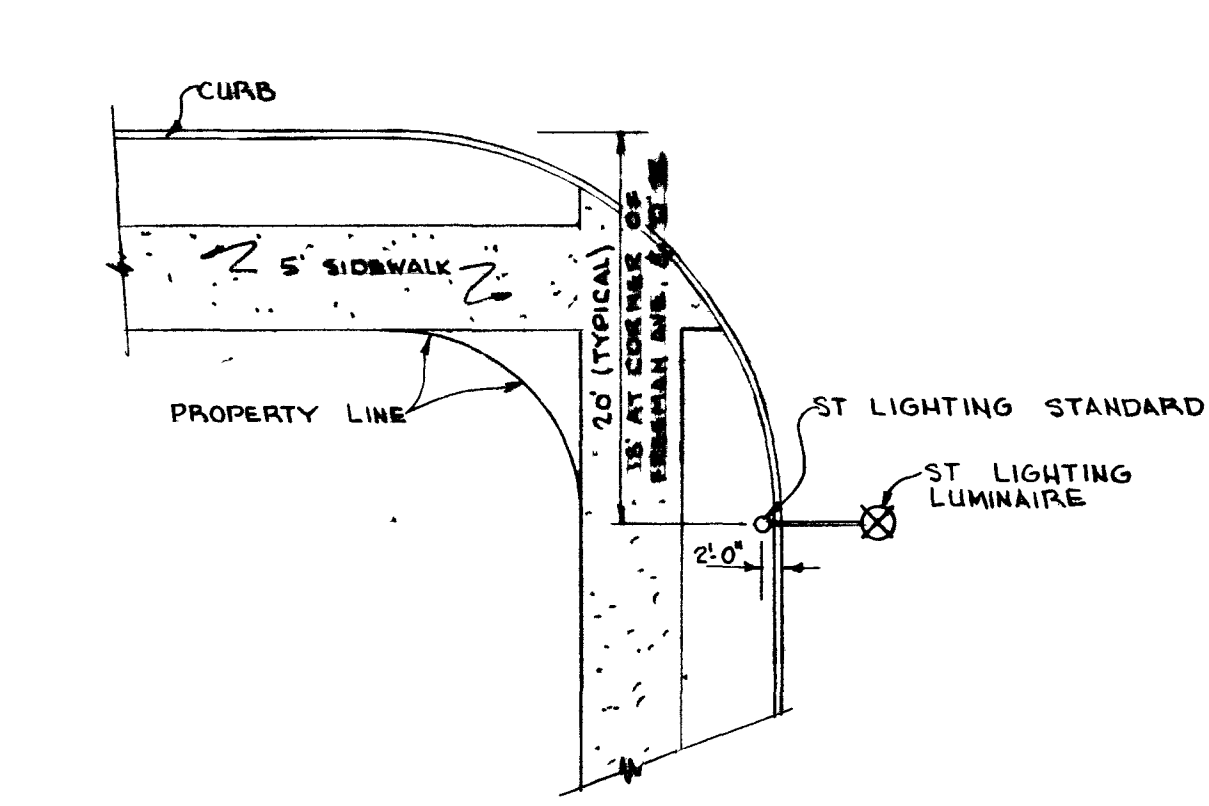

TYPICAL ST. LIGHT LOCATION
AT STREET INTERSECTIONS

- LEGEND
- STREET LIGHTING STANDARD, 11 GA. STEEL
 - STREET LIGHTING STANDARD, 3 GA. STEEL
 - ⊗ STREET LIGHTING LUMINAIRE, W/2500 L SERIES INCANDESC LAMP
 - #6 BARE MHD SINGLE COPPER CONDUCTOR
 - WOOD S.N.P.C.O. POLE

- NOTES
- STREET LIGHTING STANDARDS SHALL BE TAPERED STEEL, 11 GA. FOR 15'-3.5'-30' FOR (A) & (B), 13.5'-3.5'-35' FOR (C) & (D). WITH 6.0" PIPE BRACKET, THICKNESS OF METAL AS INDICATED IN THE LEGEND, SIMILAR AND EQUAL TO UNION METAL CO. DESIGN 400, CATALOG NO. H-300-B1, OR NO. J-330-B1.
 - STREET LIGHTING LUMINAIRES SHALL BE SERIES INCANDESCENT TYPE, 115 TYPE 2 DISTRIBUTION, SIMILAR AND EQUAL TO LINE MATERIAL CO. CATALOG NO. 603800 C 628.
 - STREET LIGHTING INSTALLATION SHALL CONFORM TO "STANDARD SPECIFICATIONS FOR RESIDENTIAL STREET LIGHTING", CITY OF LAS VEGAS.
 - STRINGING SAGS FOR TYPICAL SPAN LENGTHS SHALL BE AS FOLLOWS:
- | SPAN LENGTH | STRINGING SAG |
|-------------|---------------|
| 100 FT | 6 IN. |
| 120 FT | 8 IN. |
| 140 FT | 11 IN. |
| 160 FT | 14 IN. |
| 180 FT | 18 IN. |

APPROVED:
[Signature]
CITY ENGINEER
[Signature]
CITY ELECTRICIAN

REVISED TO AS BUILT 2-17-55 BY BEE

AS BUILT

C-4-20

5/24/54 RELOCATED SIDEWALKS ON DTL OF STREET LIGHT LOCATION AT STREET INTERSECTIONS

PLAN AND DETAILS	
STREET LIGHTING	
FOR	
BERKLEY SQUARE	
CITY OF LAS VEGAS - NEVADA	
SCALE	PERLITER & SORING
AS SHOWN	ENGINEERS
DATE	11
MAY 1954	448 S. BULL. LOS ANGELES
207Y-890-1	OF 1

