

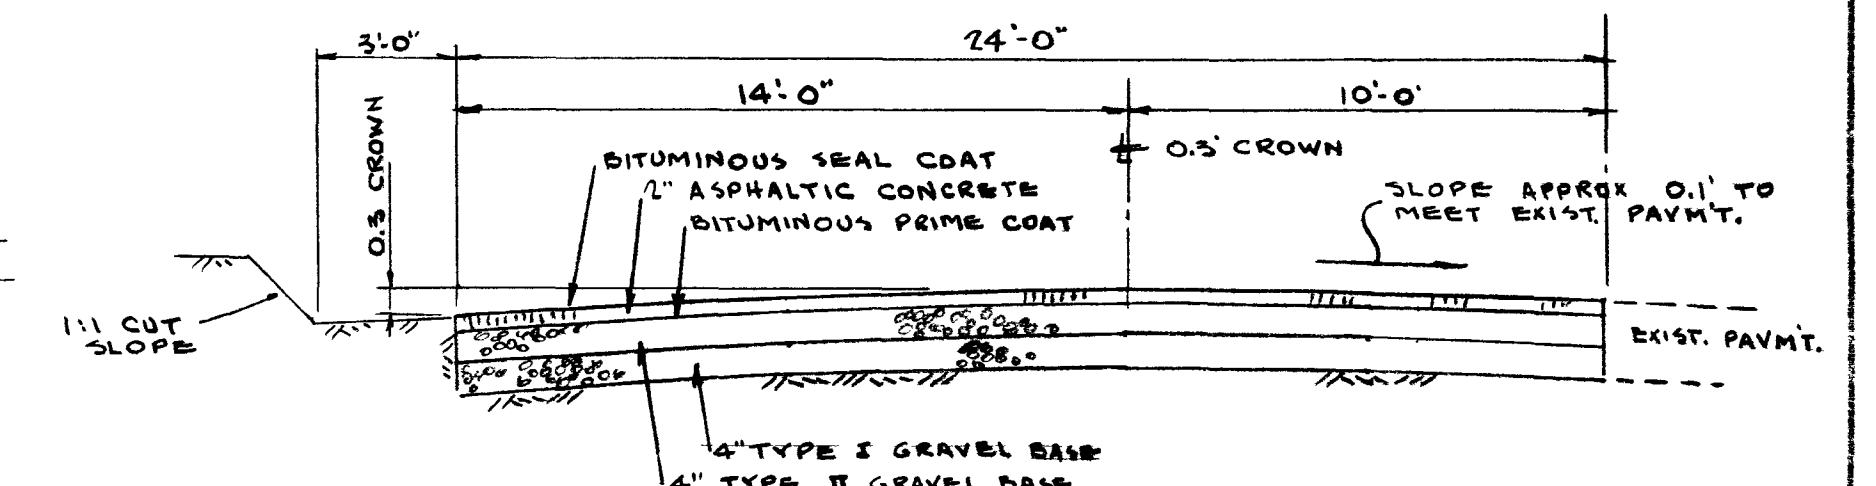
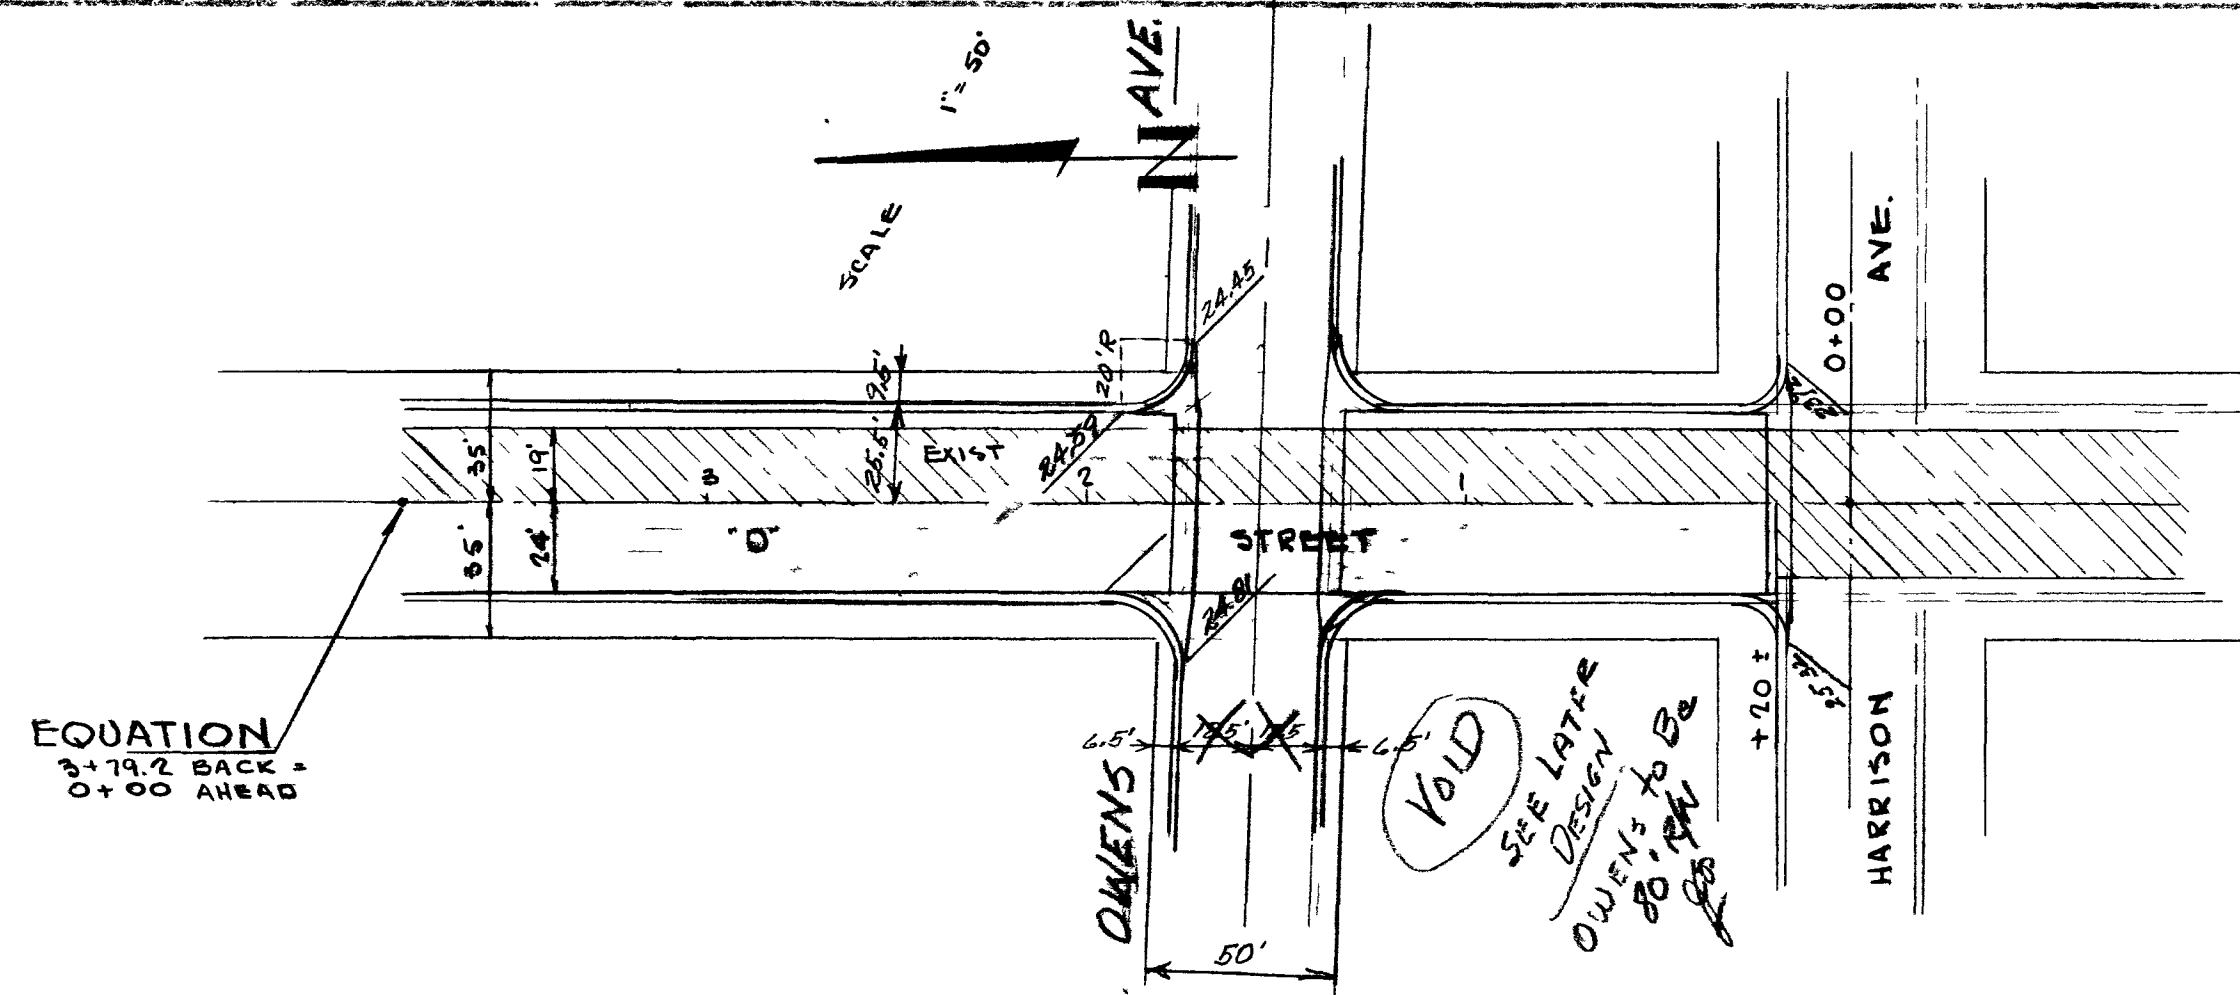
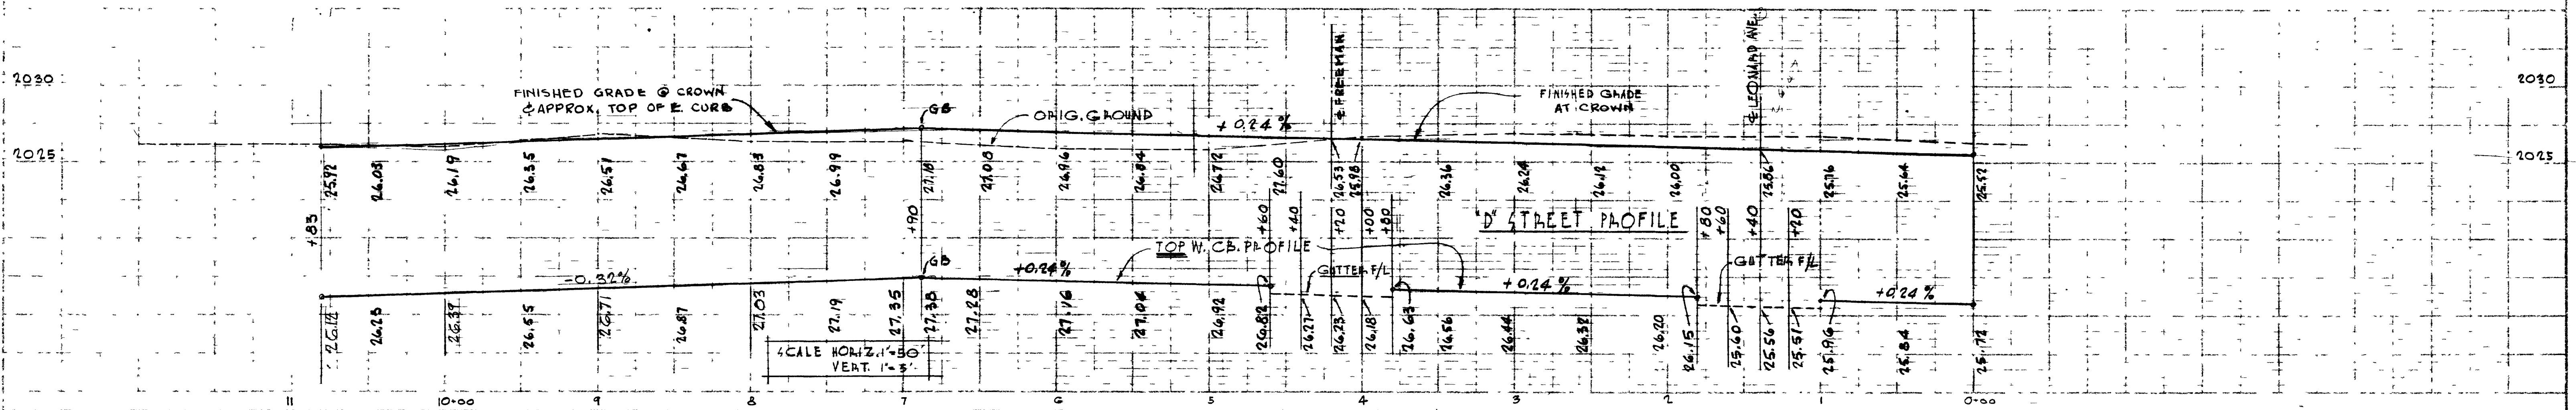


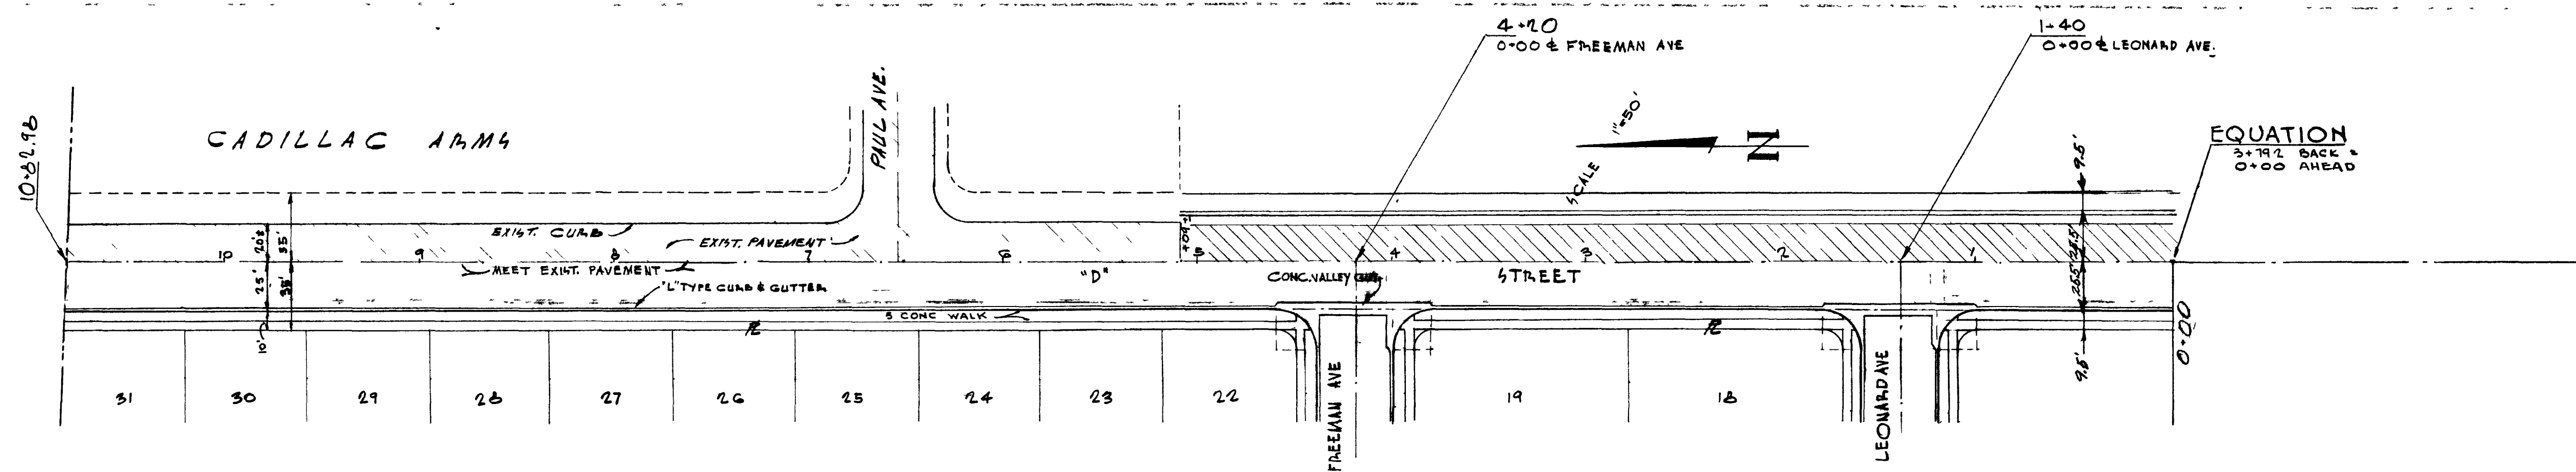

SECTION OF "D" STREET
STA 0+20 TO STA. 3+19.2

Δ 5/25/54 MOVED SIDEWALK TO PL. ADDED NOTE AT HARRISON & D STREET.

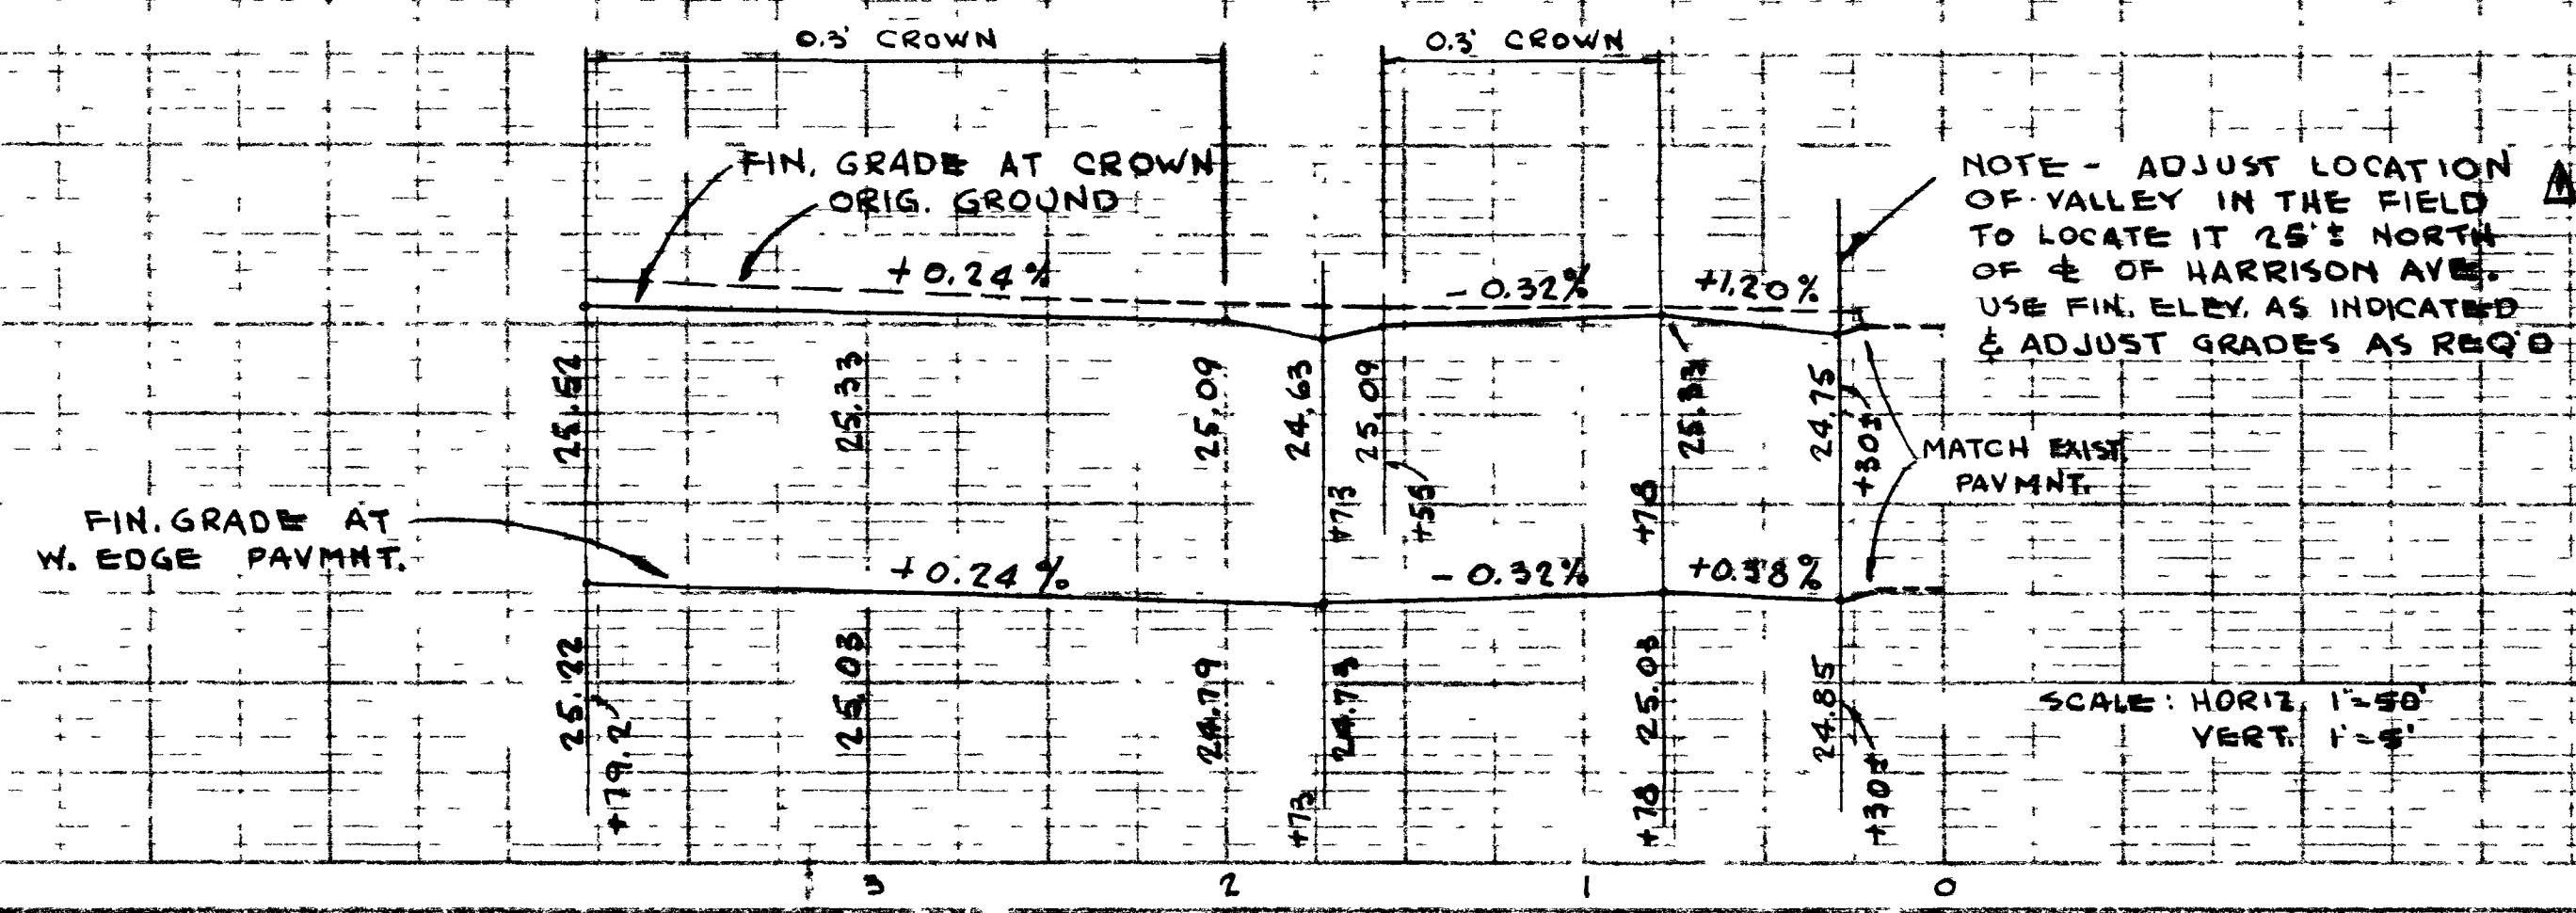

STREET BEAKEY SQUARE

3237

14-6-37

107Y-890-F

APPROVED

