


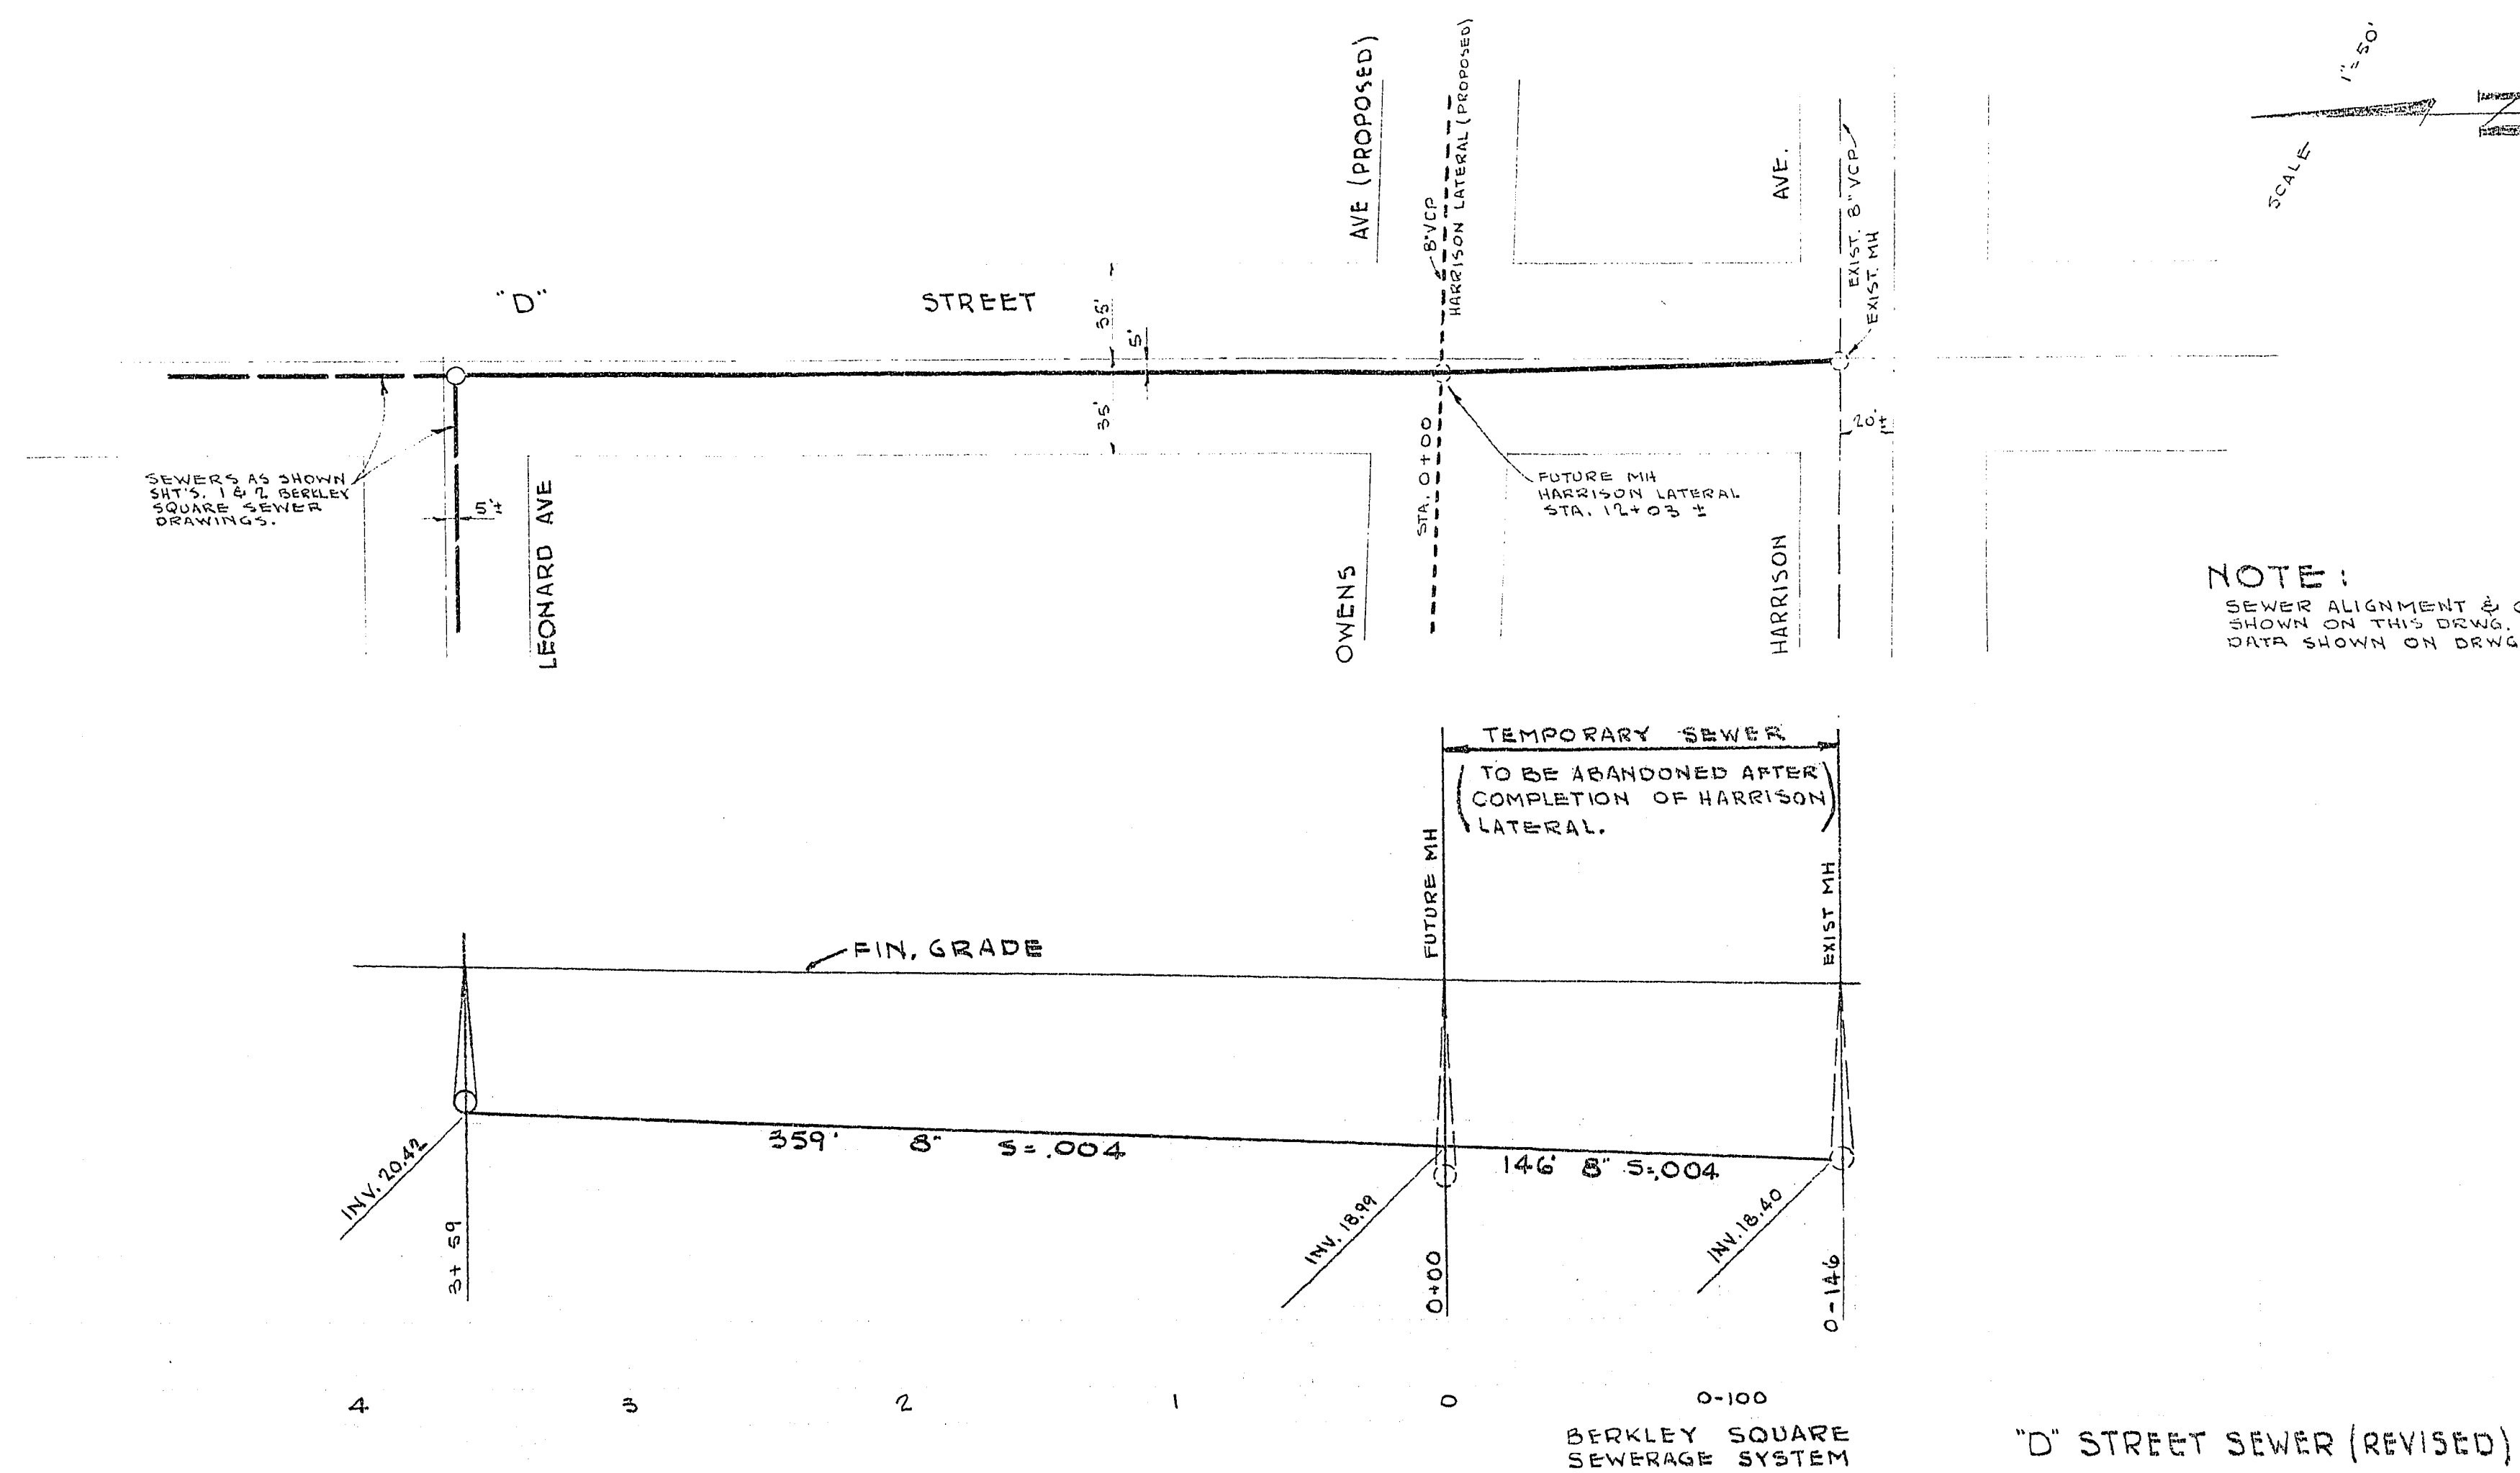

2025
2020
2015
C-3-56

JUNE 22, 1954

"D" STREET SEWER (REVISED)

DRWG. NO. 3 OF 3

14-6-00 307Y-890-1