


BELLEVUE SUBDIVISION
LAS VEGAS, NEVADA

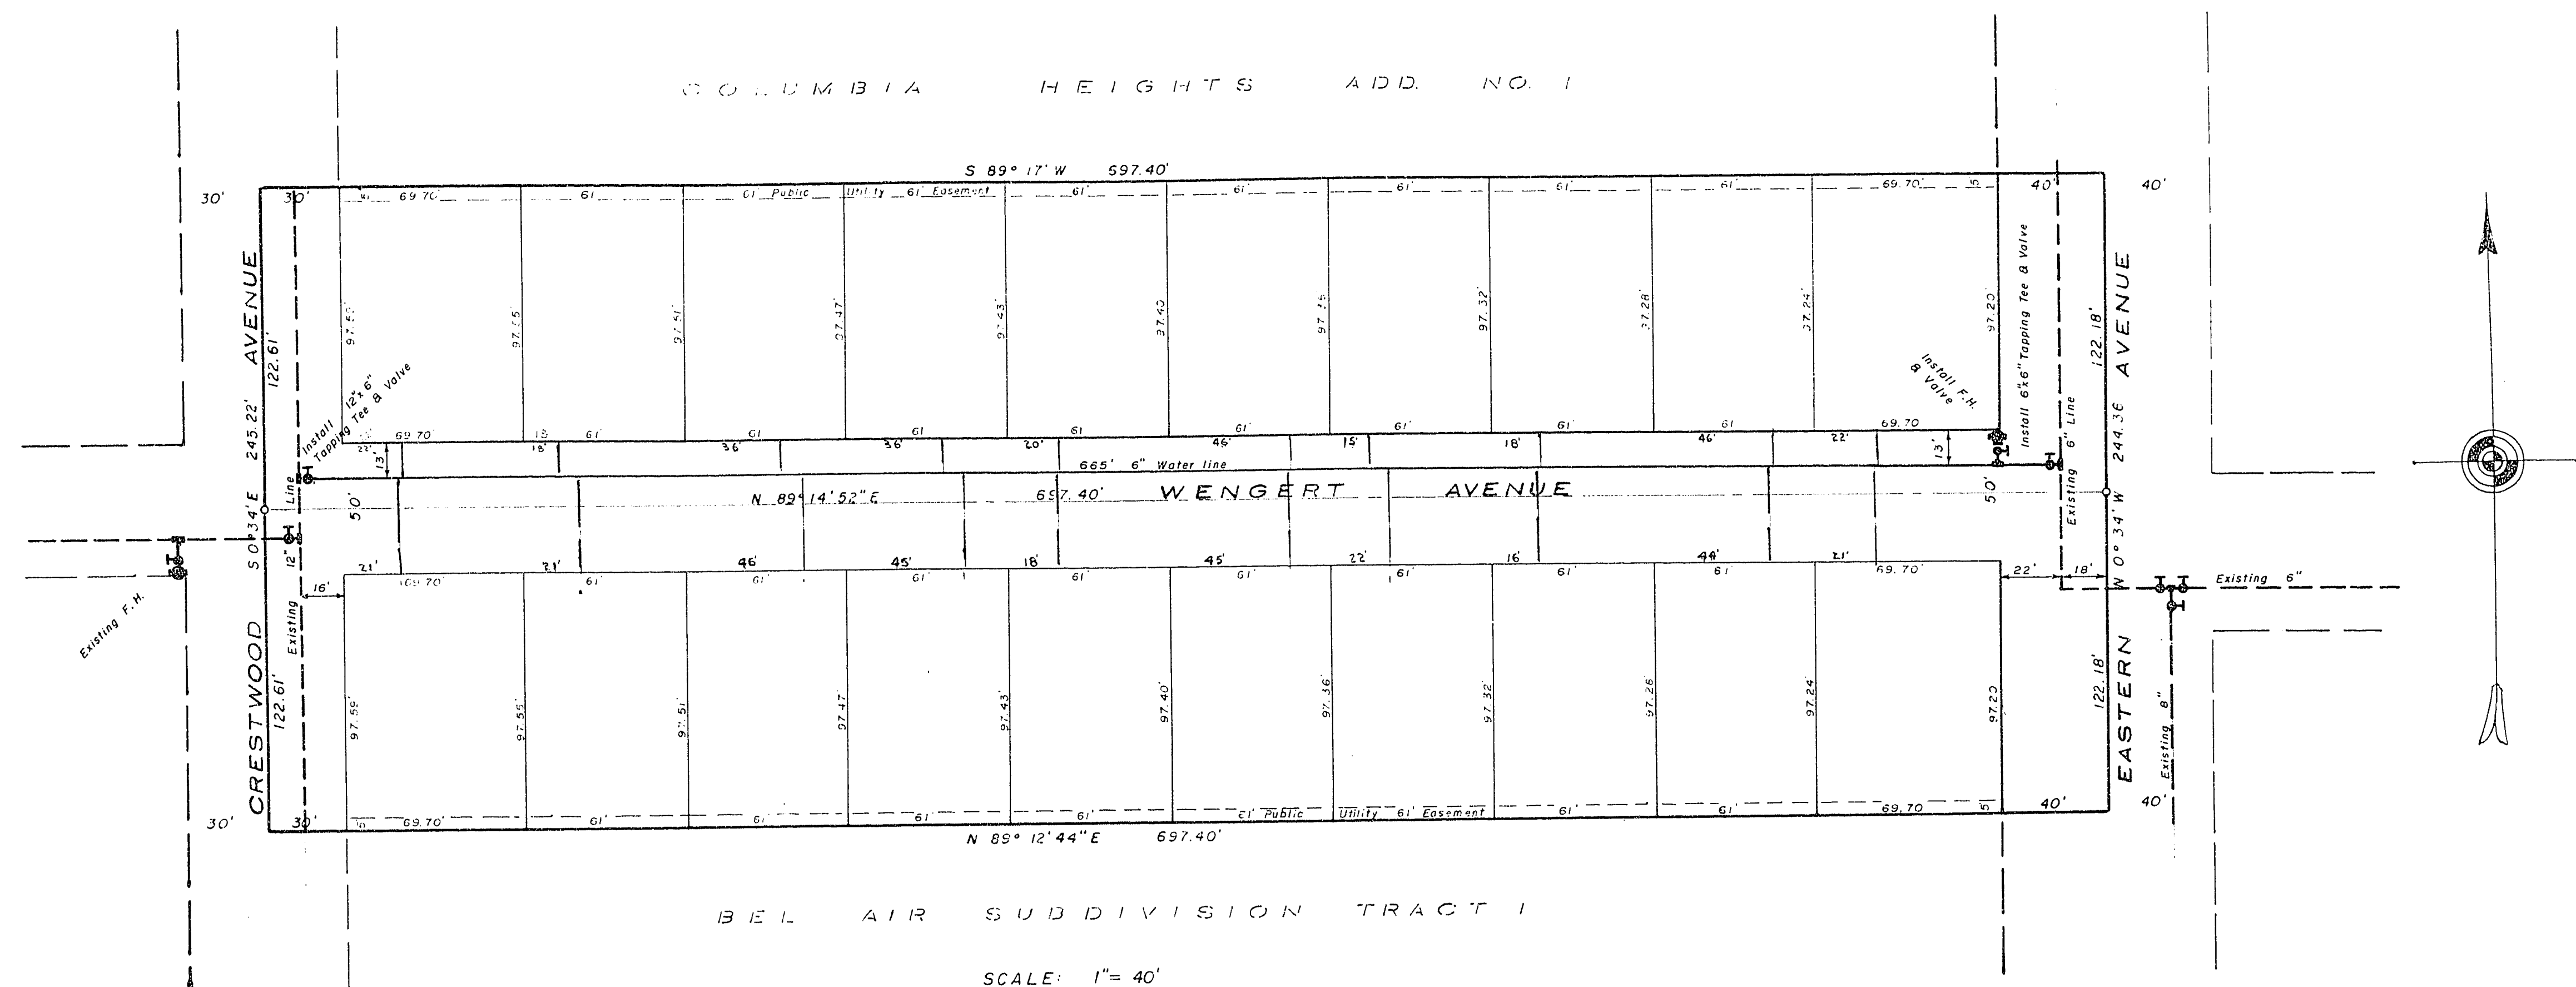

APPROVALS: APPROVED
LAS VEGAS VALLEY WATER DISTRICT
SUBJECT TO CONDITIONS NOTED AND COMPLIANCE WITH THE
SERVICE RULES, WORK TO BE IN ACCORDANCE WITH STANDARD
SPECIFICATION E.T.
BY: *[Signature]* 9/26/59
CHIEF ENGINEER & MANAGER
Las Vegas Valley Water District

[Signature] 3/26/59
Chief - Las Vegas Fire Department

- MATERIALS:
- 665' 6" Water line
 - 1 12"x6" Tapping Tee & Valve
 - 1 6"x6" " " "
 - 1 Fire Hydrant Complete
 - 1 6"x6" Tee
 - 1 6" Valve
 - 12' 6" C.I. pipe
 - 3 Valve Boxes

All construction to conform to L.V.V.W.D. standard
specification any applicable City of Las Vegas requirements.

Approval of this plan by the City of Las Vegas, Nevada,
does not relieve the Subdivider of responsibility for errors
in calculation, design, or planning by the Subdivider's
Engineer or Surveyor.

CITY OF LAS VEGAS
ENGINEERING DEPT.

PREPARED BY
KARSTEN T. BRONKEN
CONSULTING ENGINEER
LAS VEGAS, NEVADA

City of Las Vegas, Nevada
Office of the City Engineer
Approved by: *[Signature]*
Date: 9/30/59

PLAN
WATER SYSTEM
BELLEVUE SUBDIVISION

AS CONSTRUCTED

5678-880-1

166-143