


Charleston Heights # 41-A

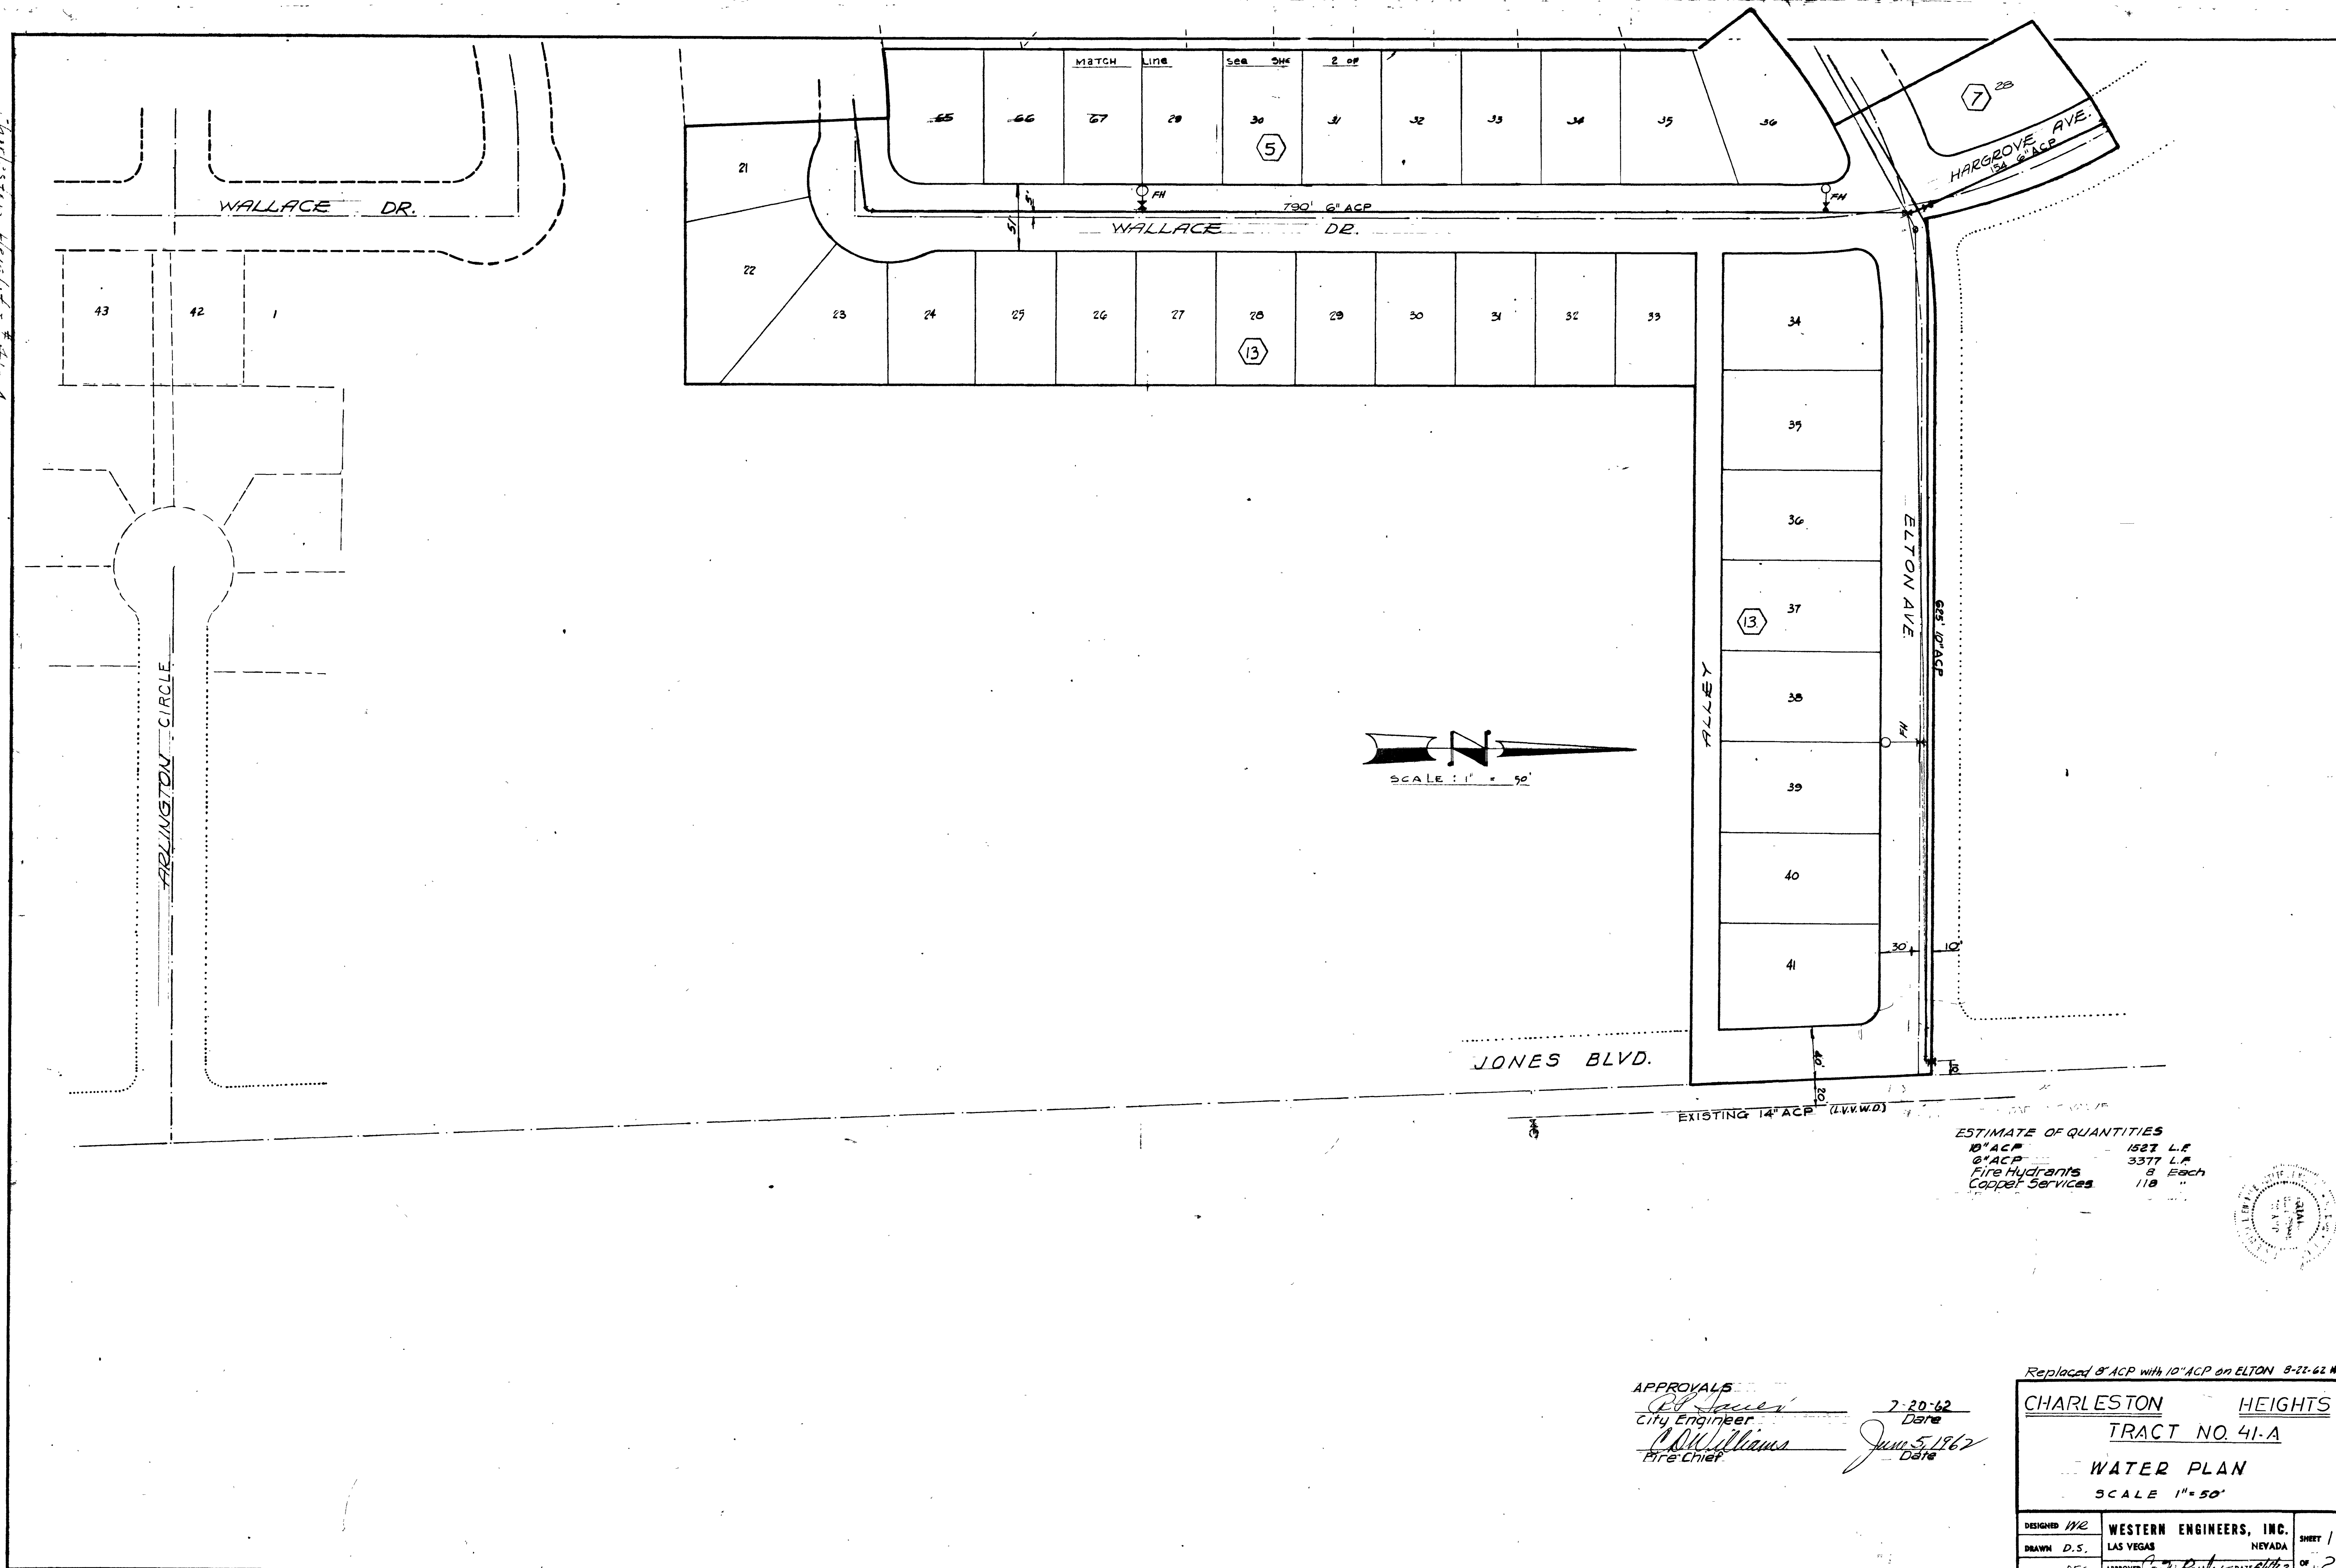

ESTIMATE OF QUANTITIES

|                 |           |
|-----------------|-----------|
| 10" ACP         | 1527 L.F. |
| 6" ACP          | 3377 L.F. |
| Fire Hydrants   | 8 Each    |
| Copper Services | 118 "     |

APPROVALS  
*[Signature]* 7-20-62  
City Engineer Date  
*[Signature]* June 5, 1962  
Fire Chief Date

Replaced 8" ACP with 10" ACP on ELTON 8-22-62 W.

|                    |                                         |
|--------------------|-----------------------------------------|
| CHARLESTON HEIGHTS |                                         |
| TRACT NO. 41-A     |                                         |
| WATER PLAN         |                                         |
| SCALE 1" = 50'     |                                         |
| DESIGNED W.E.      | WESTERN ENGINEERS, INC.                 |
| DRAWN D.S.         | LAS VEGAS NEVADA                        |
| CHECKED D.F.C.     | APPROVED <i>[Signature]</i> DATE 6/1/62 |

3547 567Y-1040-41A

