


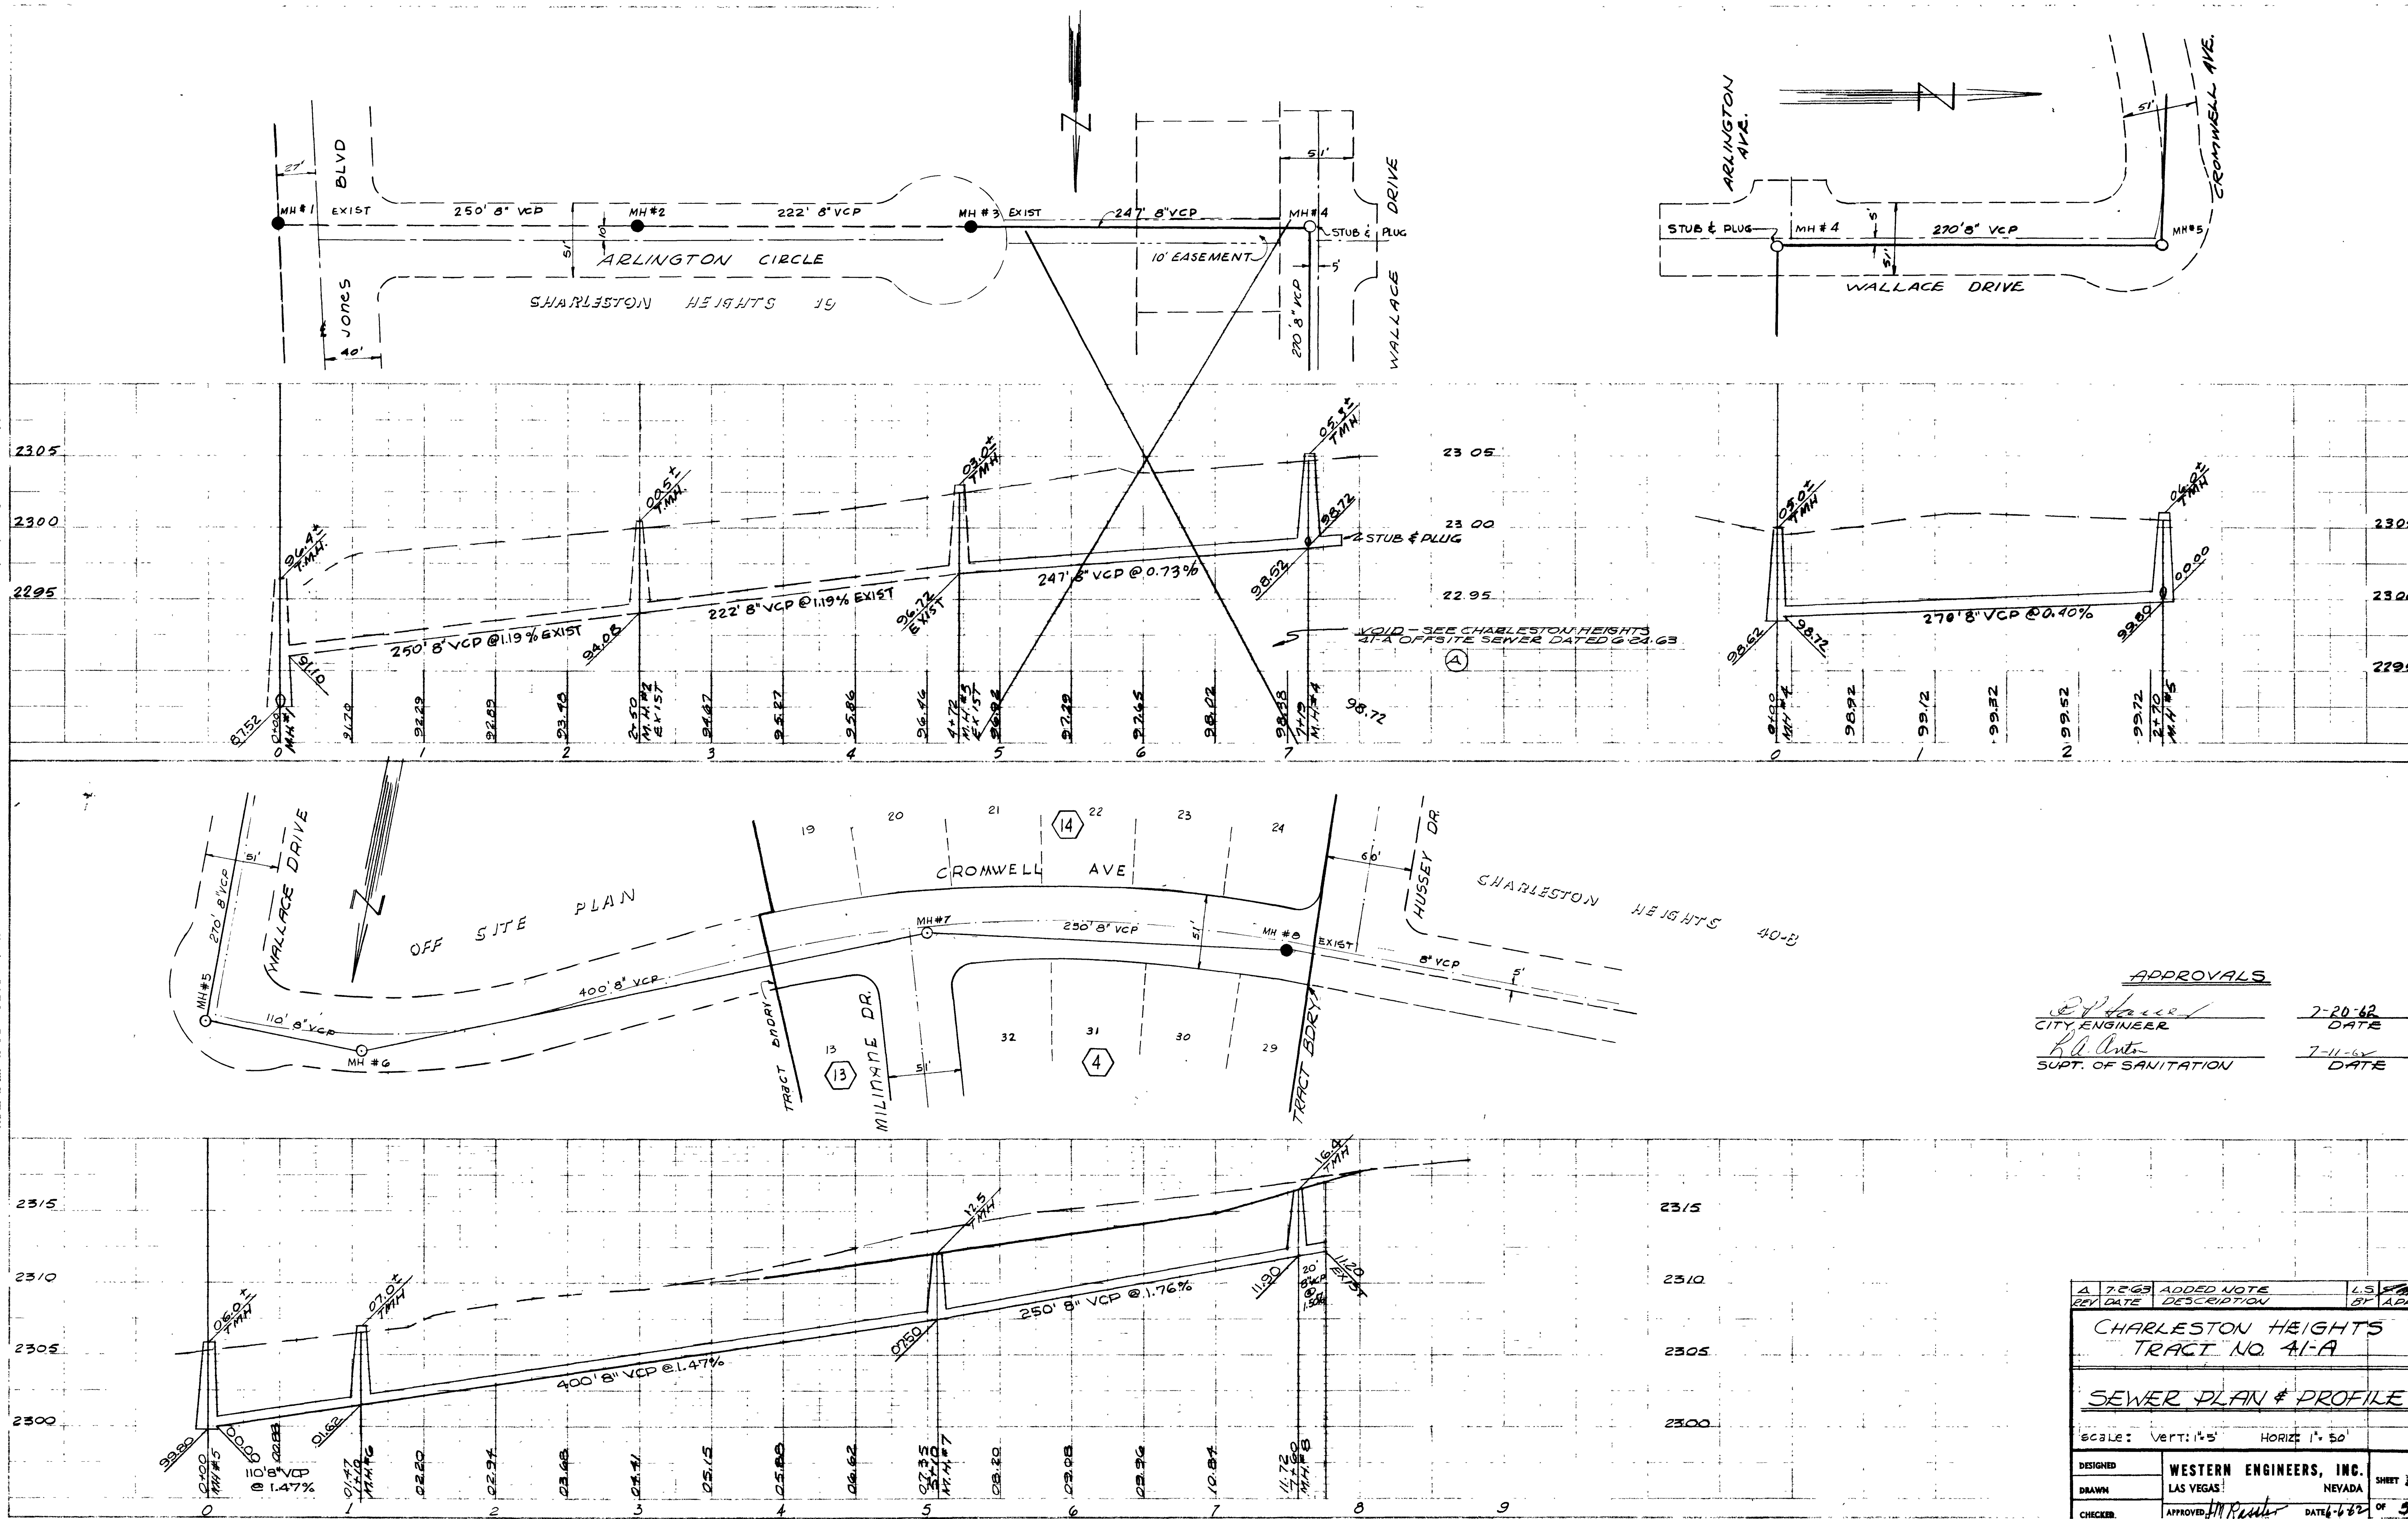


APPROVALS

[Signature] 7-20-62
 CITY ENGINEER DATE

[Signature] 7-11-62
 S.U.P.T. OF SANITATION DATE

REV	DATE	DESCRIPTION	BY	APP
1	7-20-62	ADDED NOTE	L.S.	[Signature]
CHARLESTON HEIGHTS TRACT NO. 41-A				
SEWER PLAN & PROFILE				
Scale: Vert: 1" = 5' Horiz: 1" = 50'				
DESIGNED	WESTERN ENGINEERS, INC.		NEVADA	SHEET 3
DRAWN	LAS VEGAS			
CHECKED	APPROVED: <i>[Signature]</i>		DATE: 6-62	OF 3

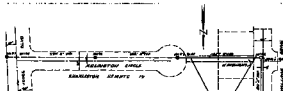

DATE	1914
PROJECT	LEXINGTON STREET
SECTION	SECTION 1
SCALE	1" = 10'
DESIGNED BY	W. H. HARRIS
CHECKED BY	W. H. HARRIS
APPROVED BY	W. H. HARRIS
DATE	1914