


257920

10/77 DIETRICH-POST 21128 .003 FILM

CHARLESTON HEIGHTS TRACT NO. 51-F  
BK. 21 PAGE 20

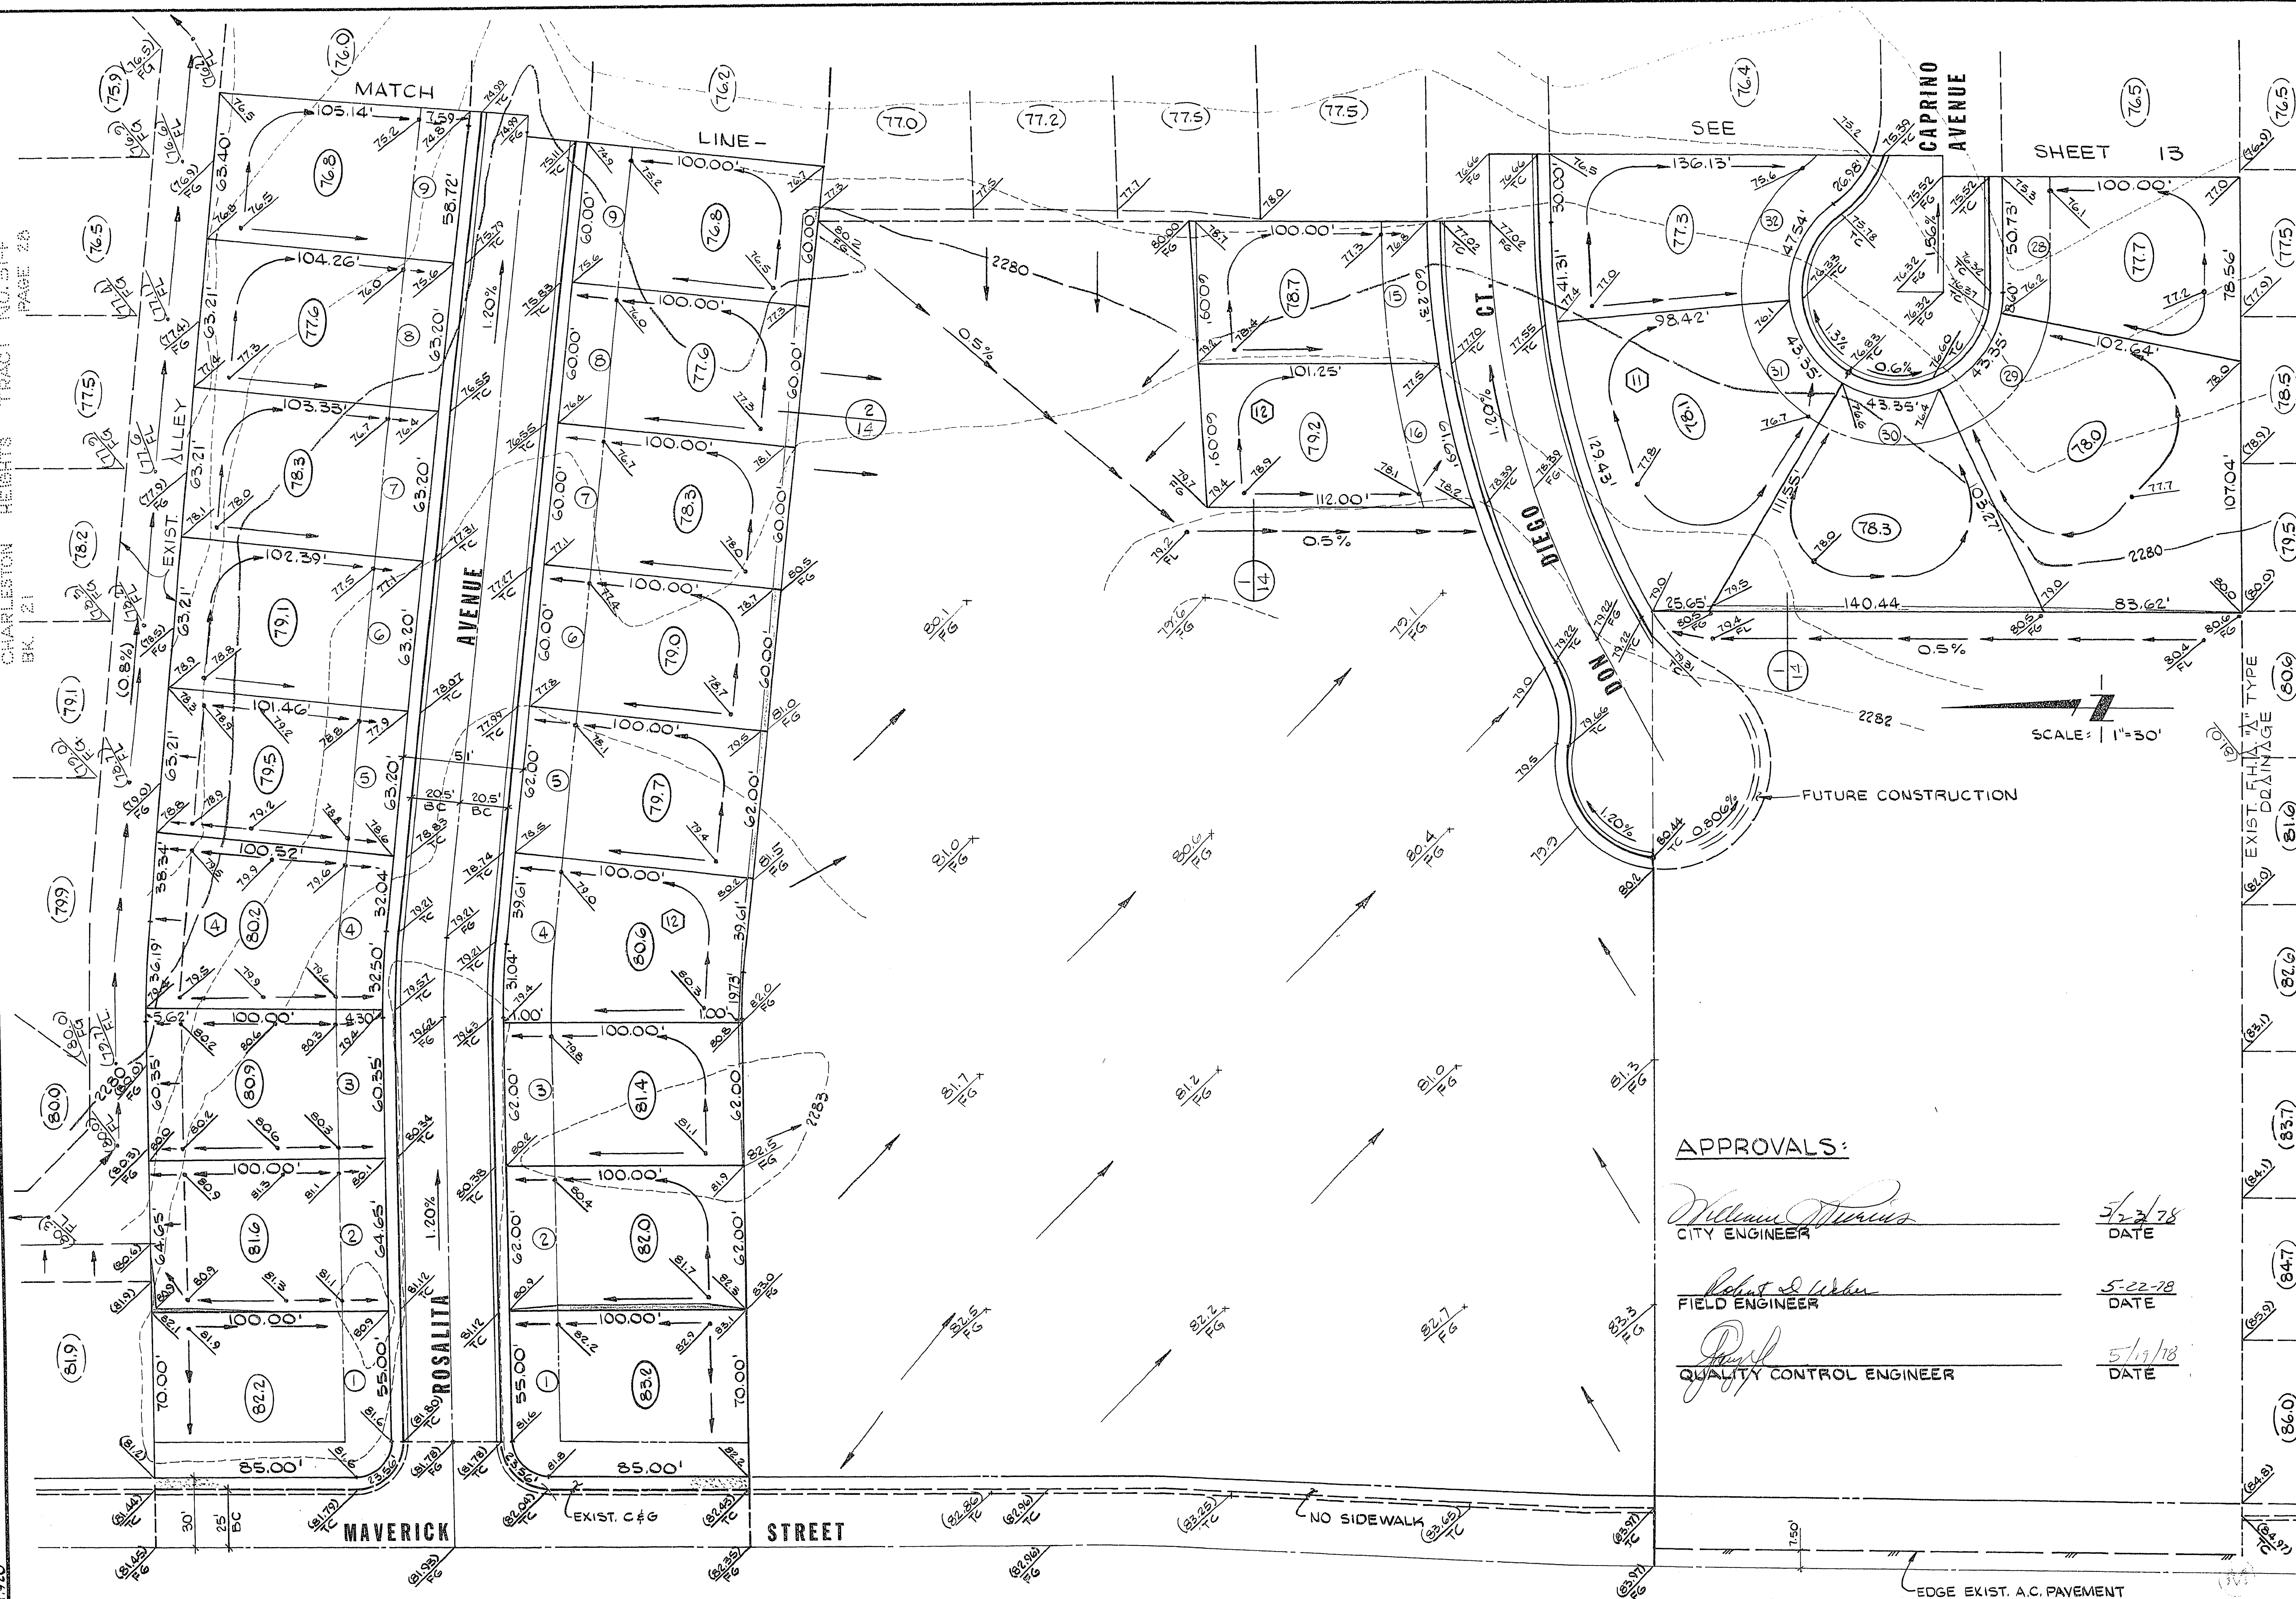

APPROVALS:

*William Morris*  
CITY ENGINEER

5/23/78  
DATE

*Robert D. Walker*  
FIELD ENGINEER

5-22-78  
DATE

*Paul*  
QUALITY CONTROL ENGINEER

5/17/78  
DATE

BECKER DEVELOPMENT CO.

CHARLESTON HEIGHTS TRACT NO. 51-E

GRADING PLAN I

G. C. WALLACE  
Consulting Engineers, Inc.

1100 East Sahara Ave. • Las Vegas, Nevada 89104 • 732-3330

RECOMMENDED

BY: *G. C. Wallace*  
G. C. WALLACE

REV. DATE

DESCRIPTION  
1 5/27/78 REV. RED LINED & LETT'D  
DATED 5/17/78.

SHEET  
12  
OF 14 SHEETS

107Y-1040-51E

