



MATCH LINE - SEE SHT. 13

CHARLESTON HEIGHTS TRACT NO. 51-H

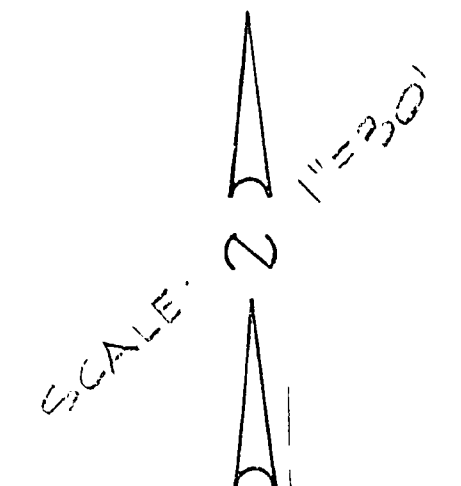

MATCH LINE - SEE SHT. 15

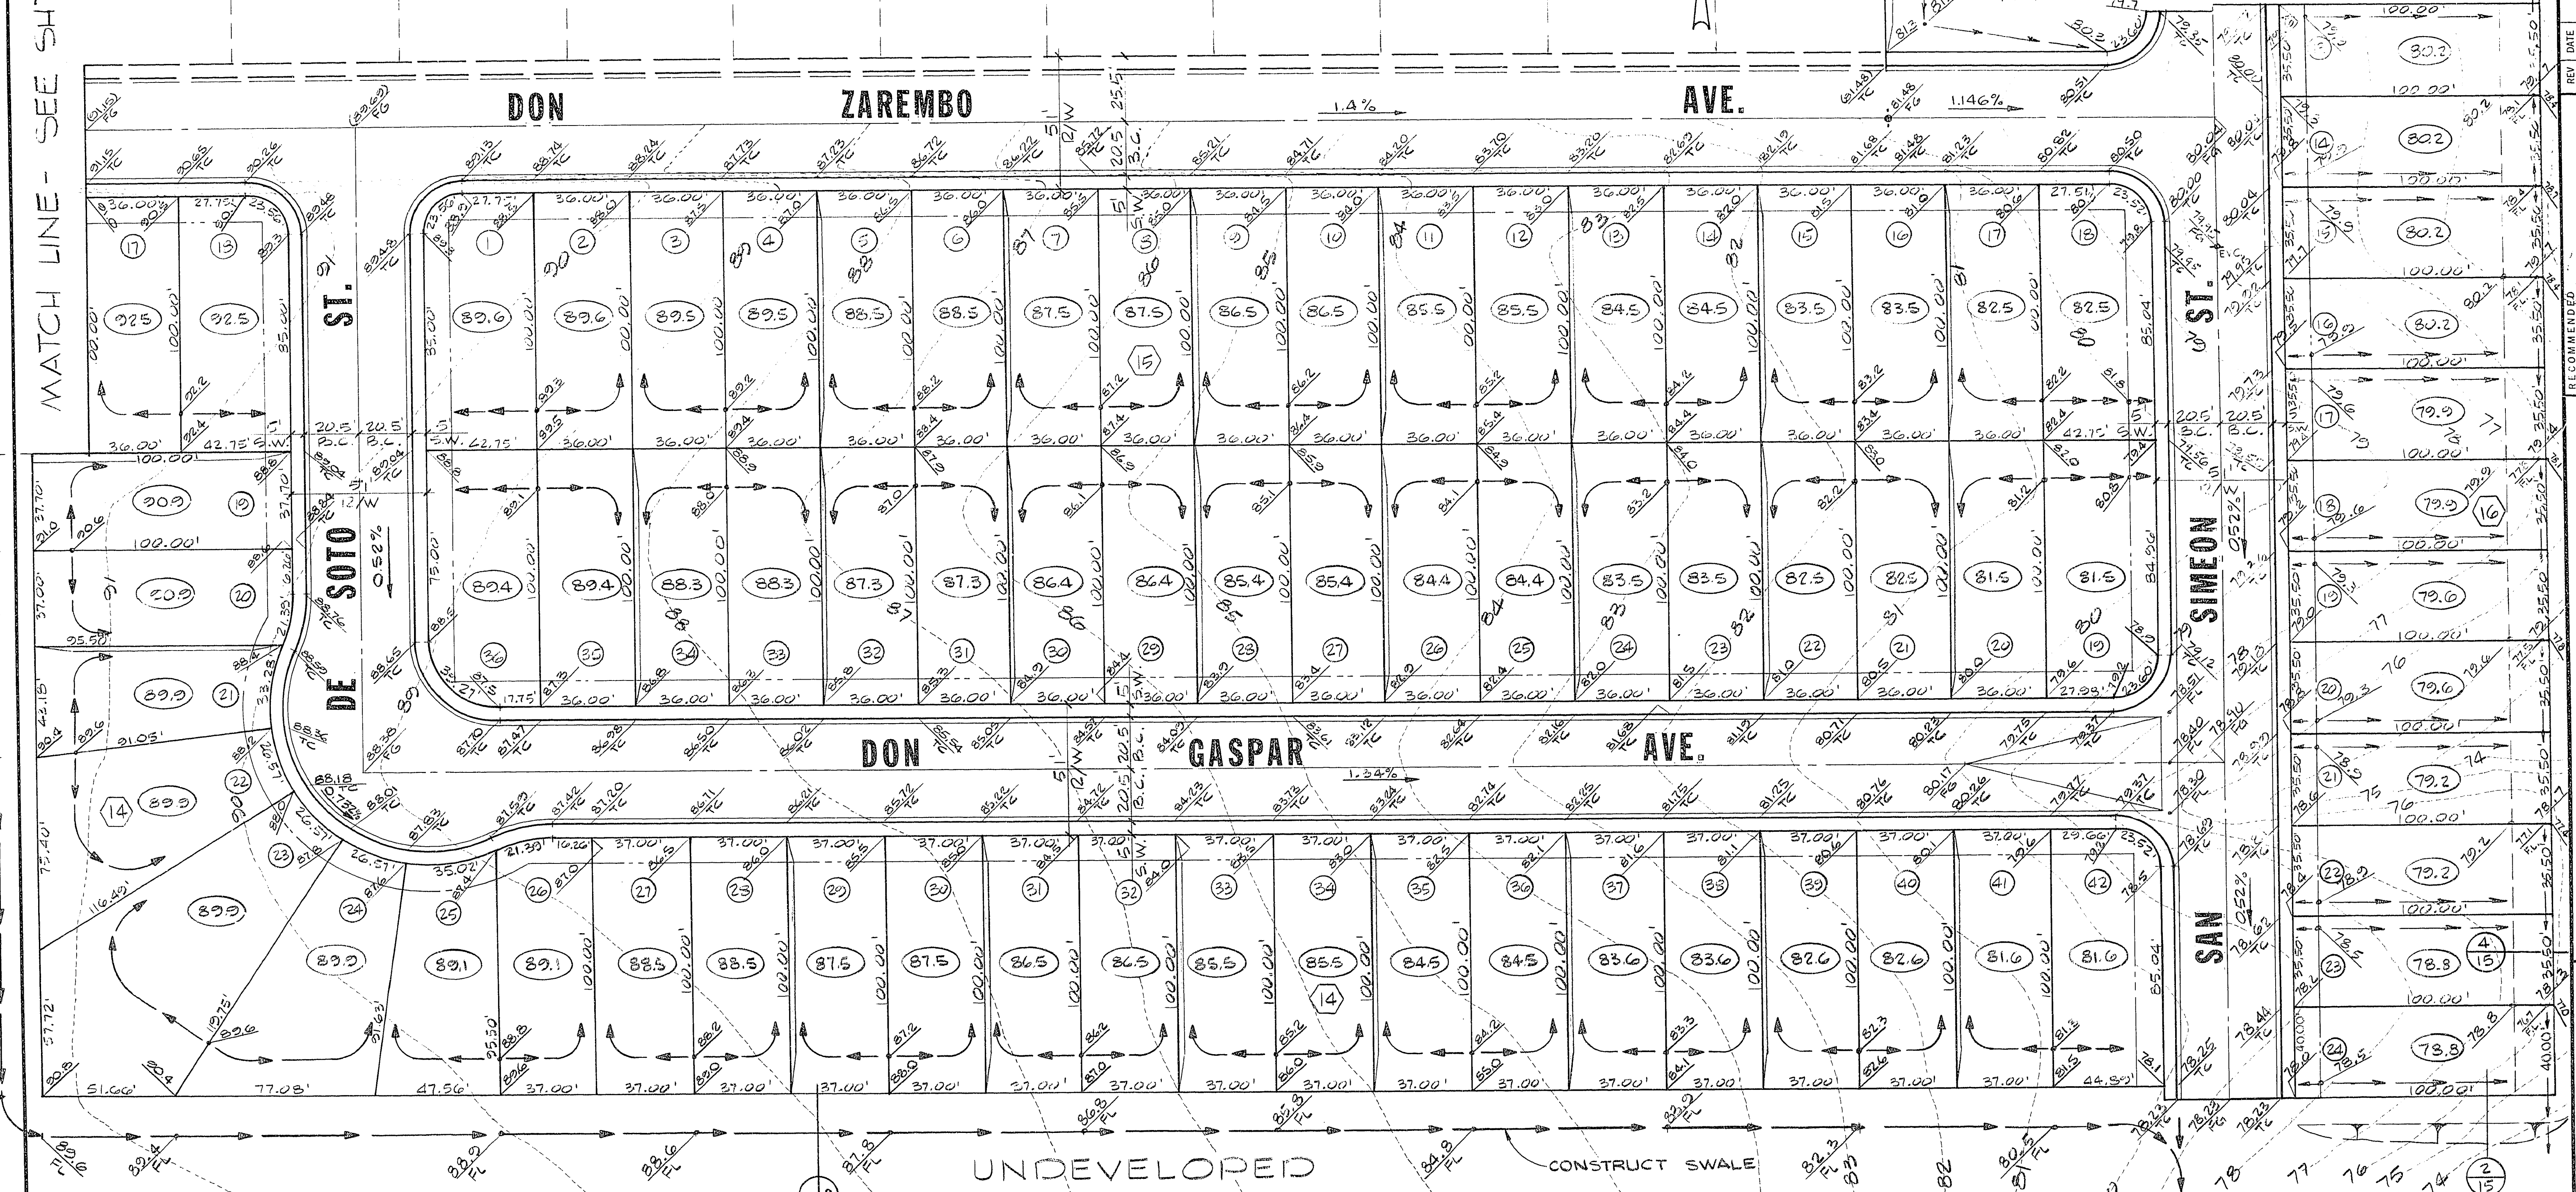

APPROVALS:

[Signature] 3/16/79
C.L.V. ENGINEER DATE

N/A
C.L.V. FIELD OPERATIONS ENG'R. DATE

[Signature] 3-15-79
C.L.V. QUALITY CONTROL ENG'R. DATE

RECOMMENDED BY: <i>[Signature]</i> DATE: 3/16/79 R.E. NO. 11176		DESCRIPTION
		ADDED SWALE TO LOTS 1 THRU 24 BLK. 16 PER P.H.A.
		RESTATED LOT LINE FOR LOTS 5-104 BLK. 16 FENCED ST. NAME PER P.H.A. 4-11-78 AVE. TO DON GASPAR AVE. PER C.L.V. 4-11-78
BECKER & SONS CHARLESTON HEIGHTS TRACT NO. 51-A3 GRADING PLAN II		SHEET 14 OF 16 SHEETS