

SCALE 1" = 50'

ESTIMATED QUANTITIES


8" VCP	2717 LF
M.H.	8 EA
4" VCP LATERALS	1140 LF

APPROVALS

CITY OF LAS VEGAS ENGINEER 7/14/71
DATE


SANITATION SUPT. DATE

BM
8/30/71

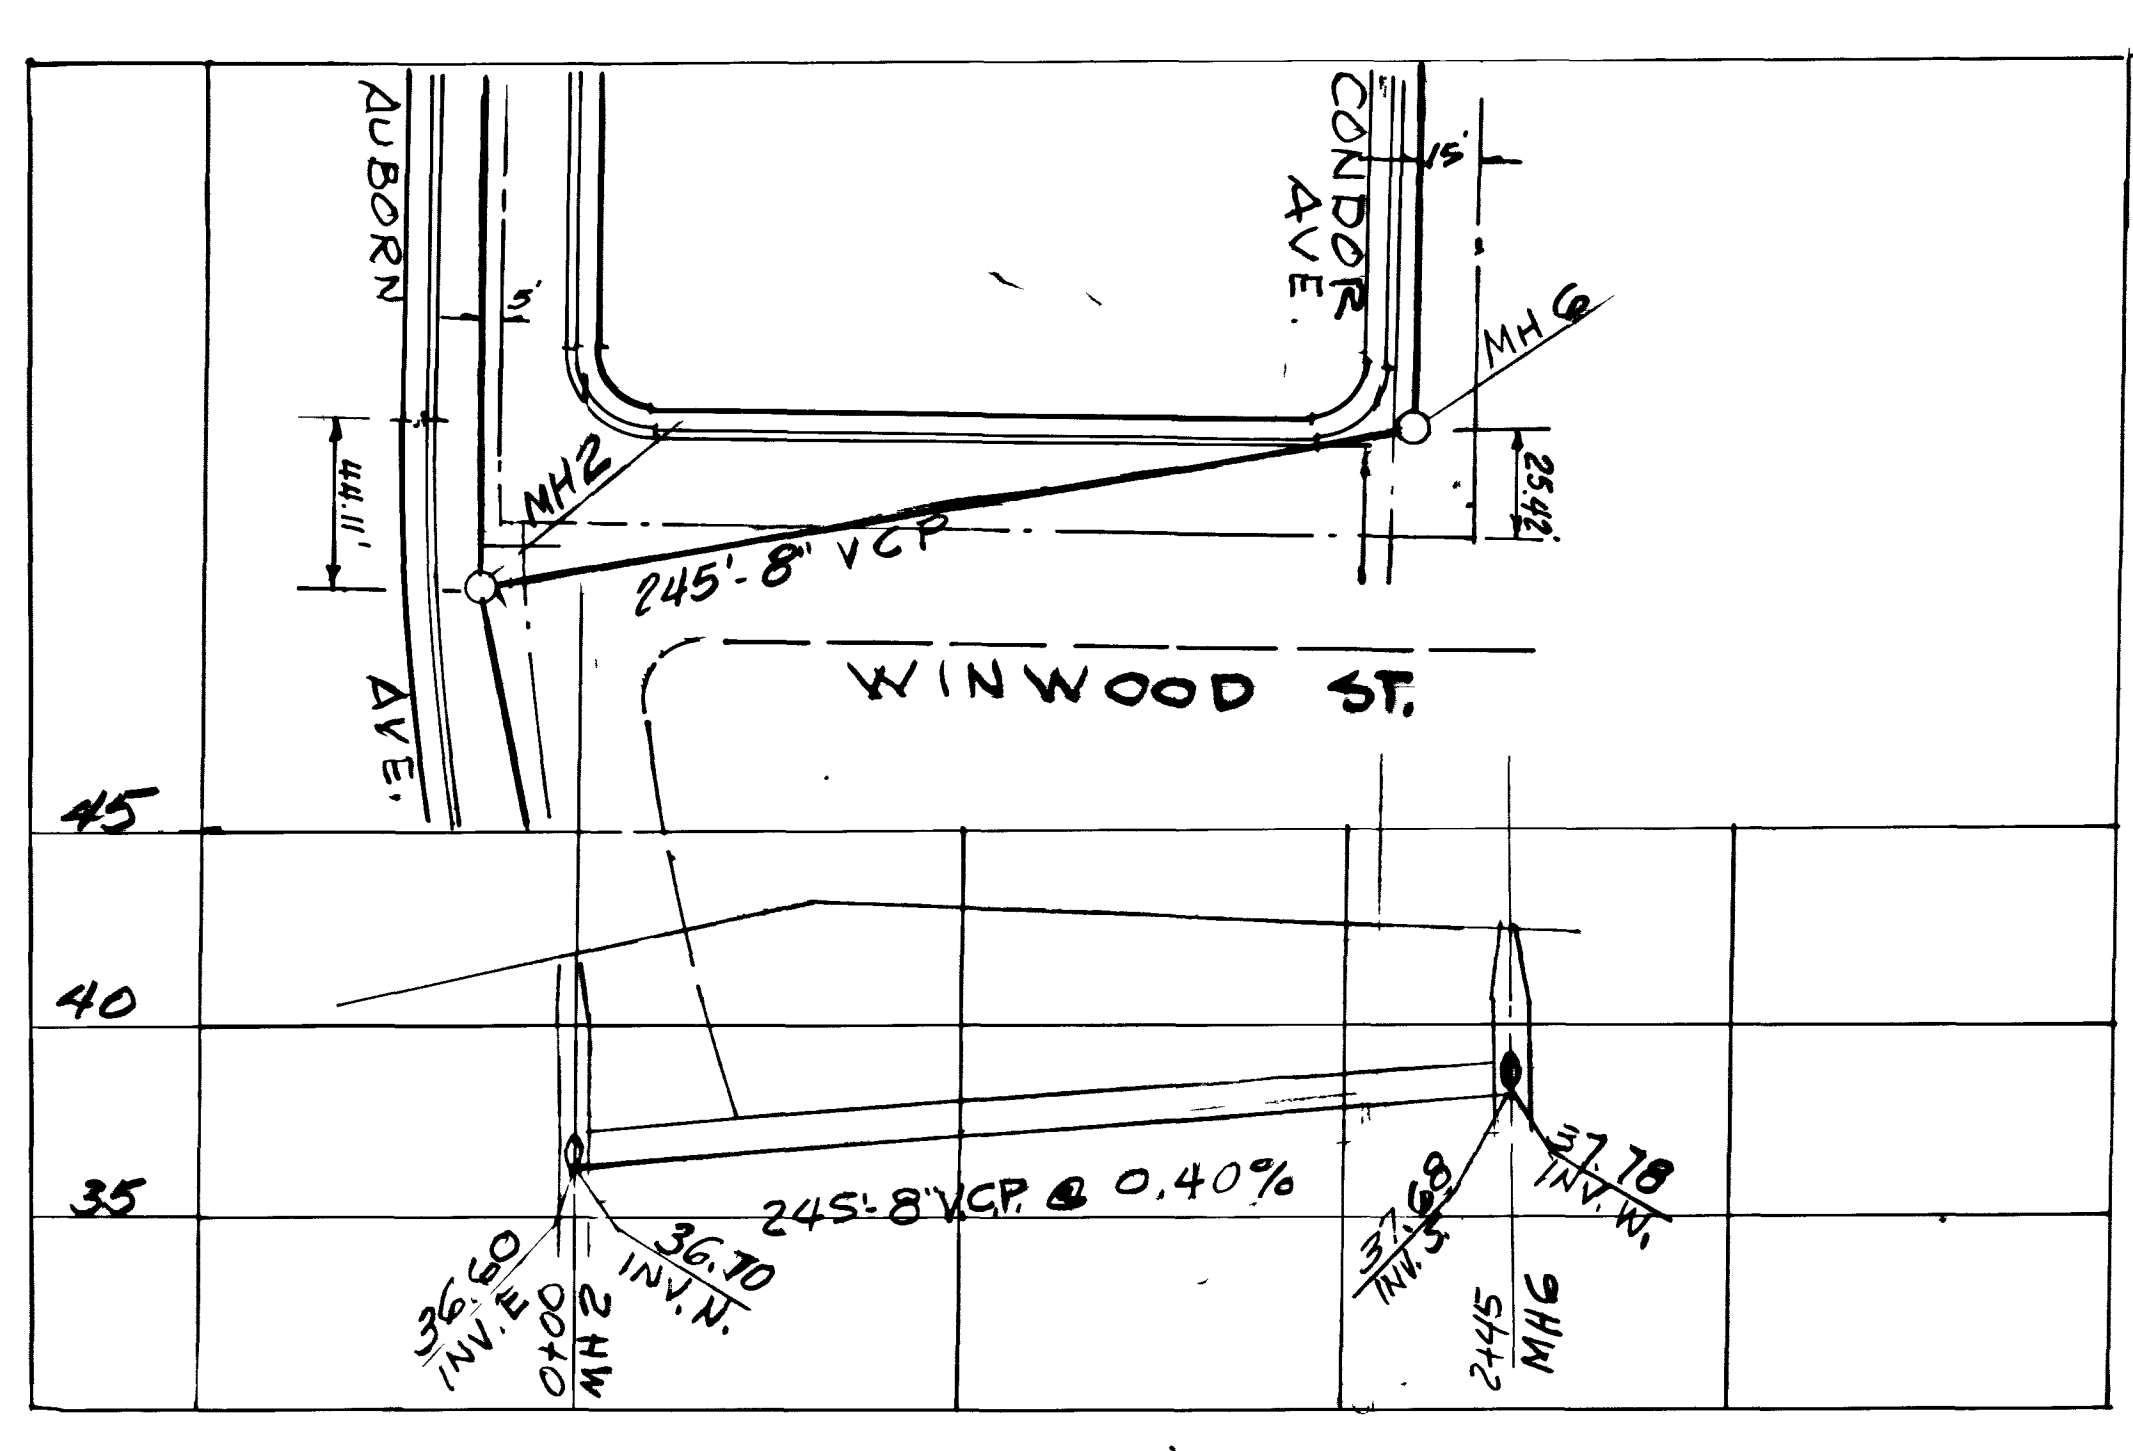

"AS-BUILT" PLAN

D			
C			
B			
A	7/14/71	ADDED STA. & LATERALS	JMR
REV	DATE	DESCRIPTION	BY APPR.
CHARLESTON HEIGHTS TRACT NO. 50-D, UNIT 4			
SEWER PLAN			
DESIGNED	JMR	J. M. RASSLER	NEVADA
DRAWN	PM	LAS VEGAS	SHEET 4
CHECKED	JMR	APPROVED	DATE 8/25/71

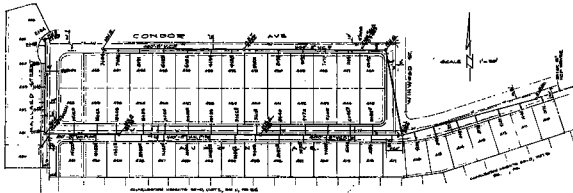


DEVELOPER: HANCOCK BROS. CO., INC., 100 W. 42ND ST., N.Y.C.

APPROVALS:

_____	ARCHT. DRG. BOARD	1-1-57
_____	ENGINEER	DATE
_____		BY

ESTIMATED QUANTITIES:

sq YOP	2717	sq
sq IN	8	sq
sq YOP MATERIALS	1148	sq

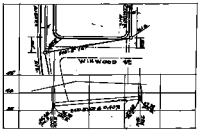

"AS-BUILT" PLAN

HANCOCK BROS. CO.	
CHALLENGER BROS. TRUST CO. UNIT 4	
SEWER PLAN	
DATE	1-1-57
BY	J. H. SADDLES
CHECKED BY	
SCALE	

420 2014 1/57