



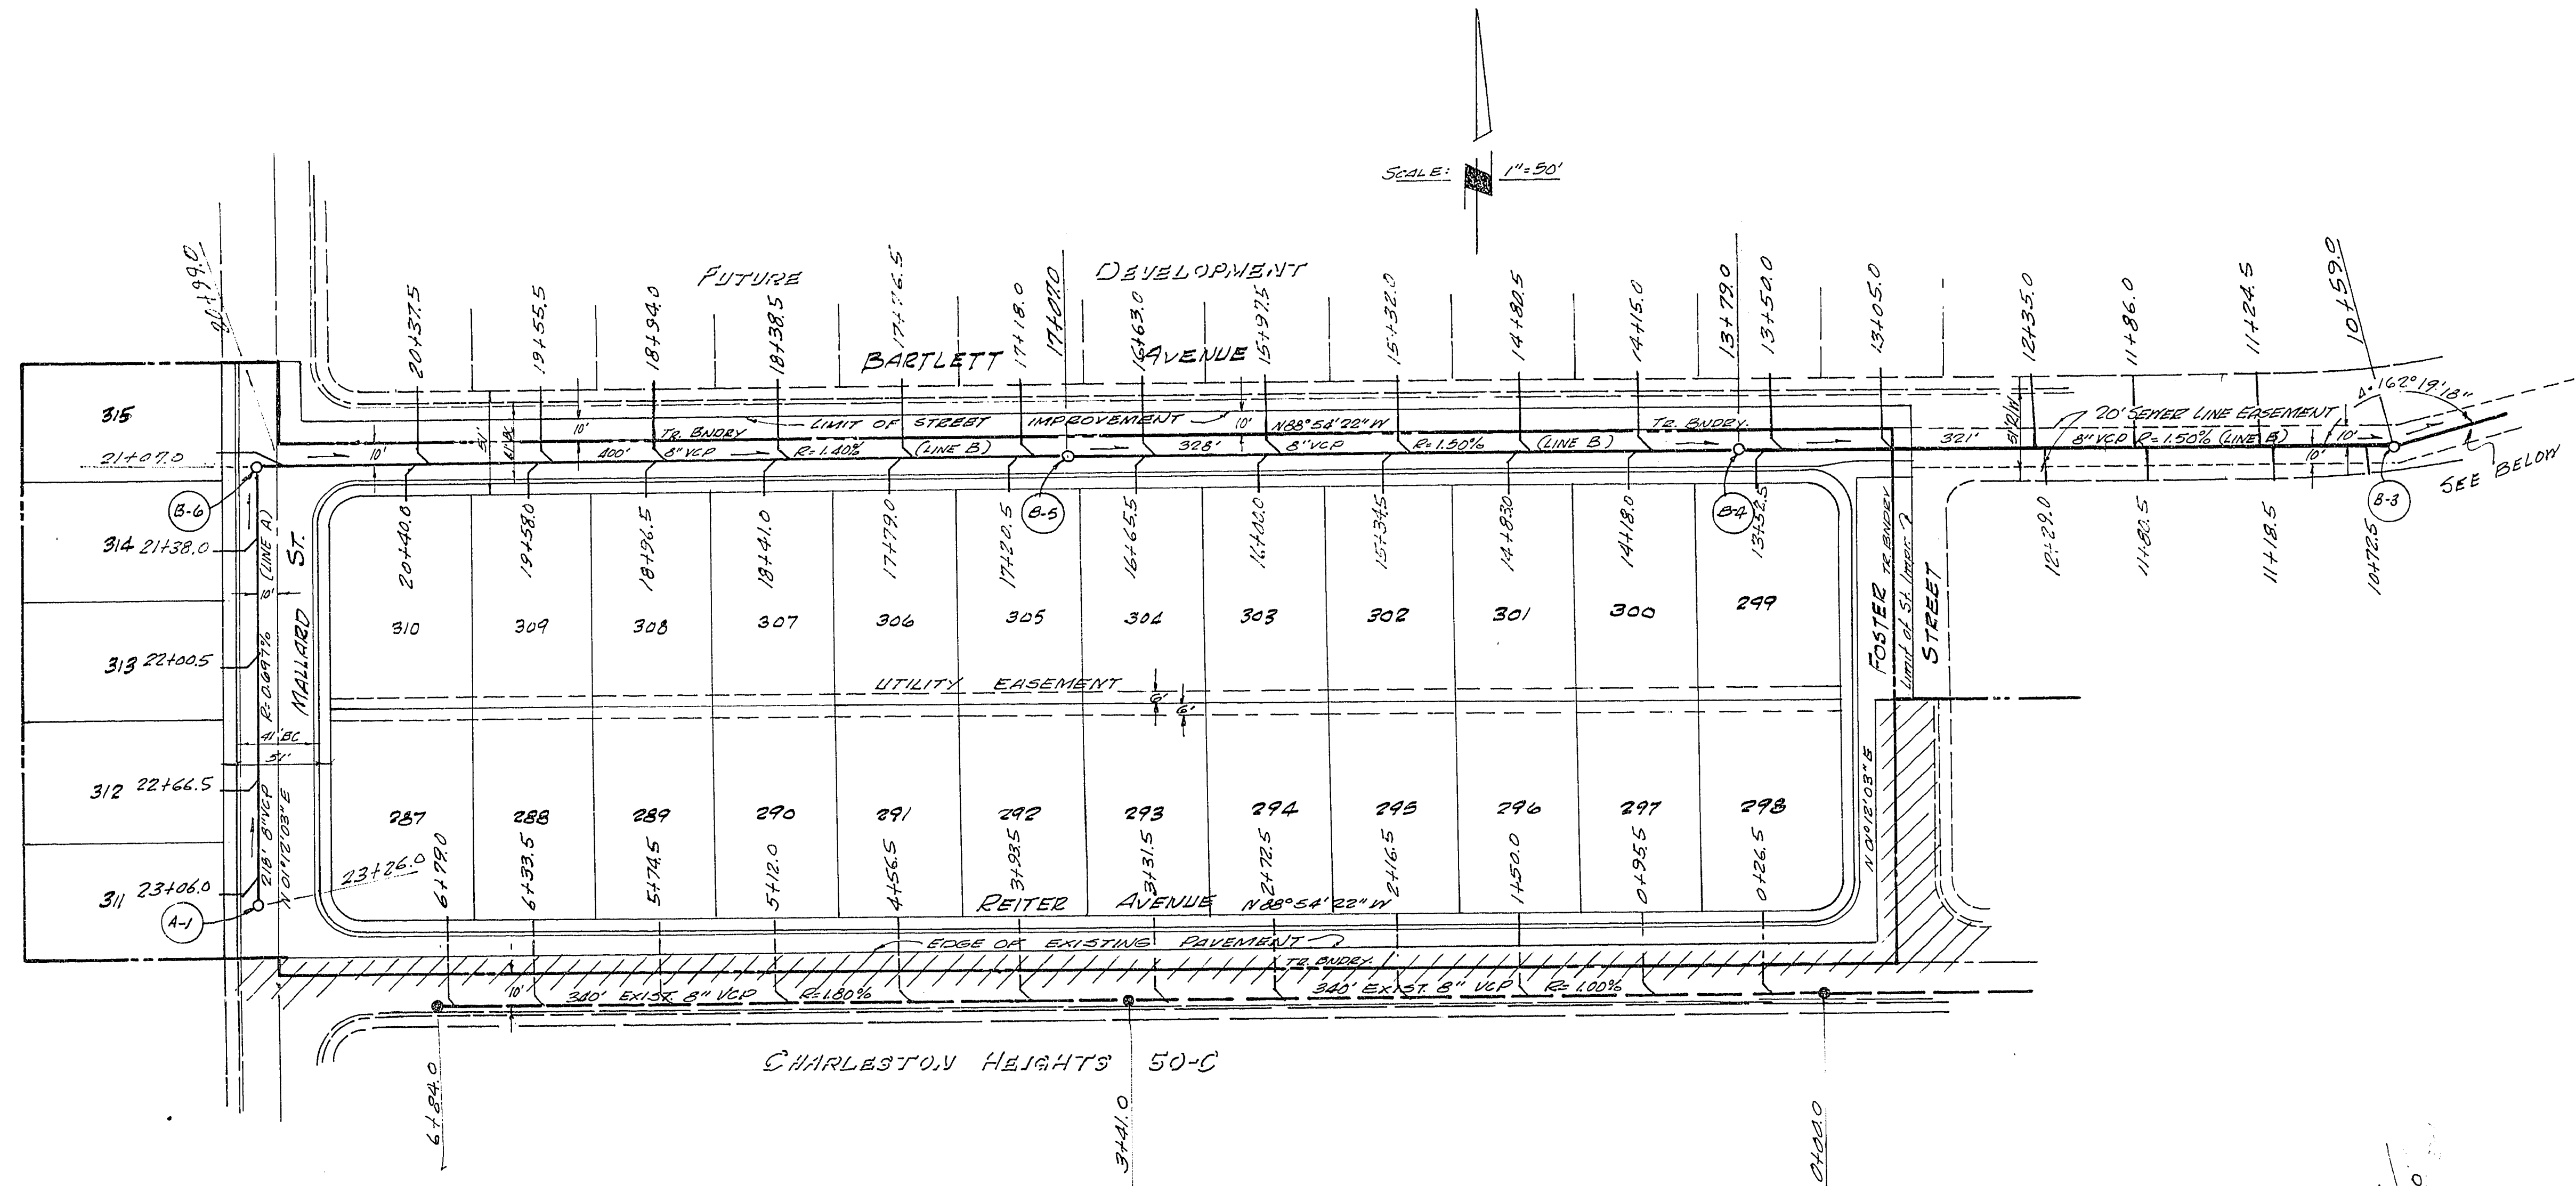

LEGEND & QUANTITIES

Standard Concrete Manholes 8 EA.
 8" VCP 2429 L.F.
 1" House Laterals 30 EA.
 Exist. 8" VCP
 Exist. Manhole

NOTE: House Laterals for Lots 287 thru 298 previously installed (Charleston Hts. 50-C).
 All other House Laterals to be located in Field.
 BENCH MARK: CLV BM NO 460, SPIKE IN N. SIDE TEL. POLE @ EUGENE & JONES EL: 2264.50

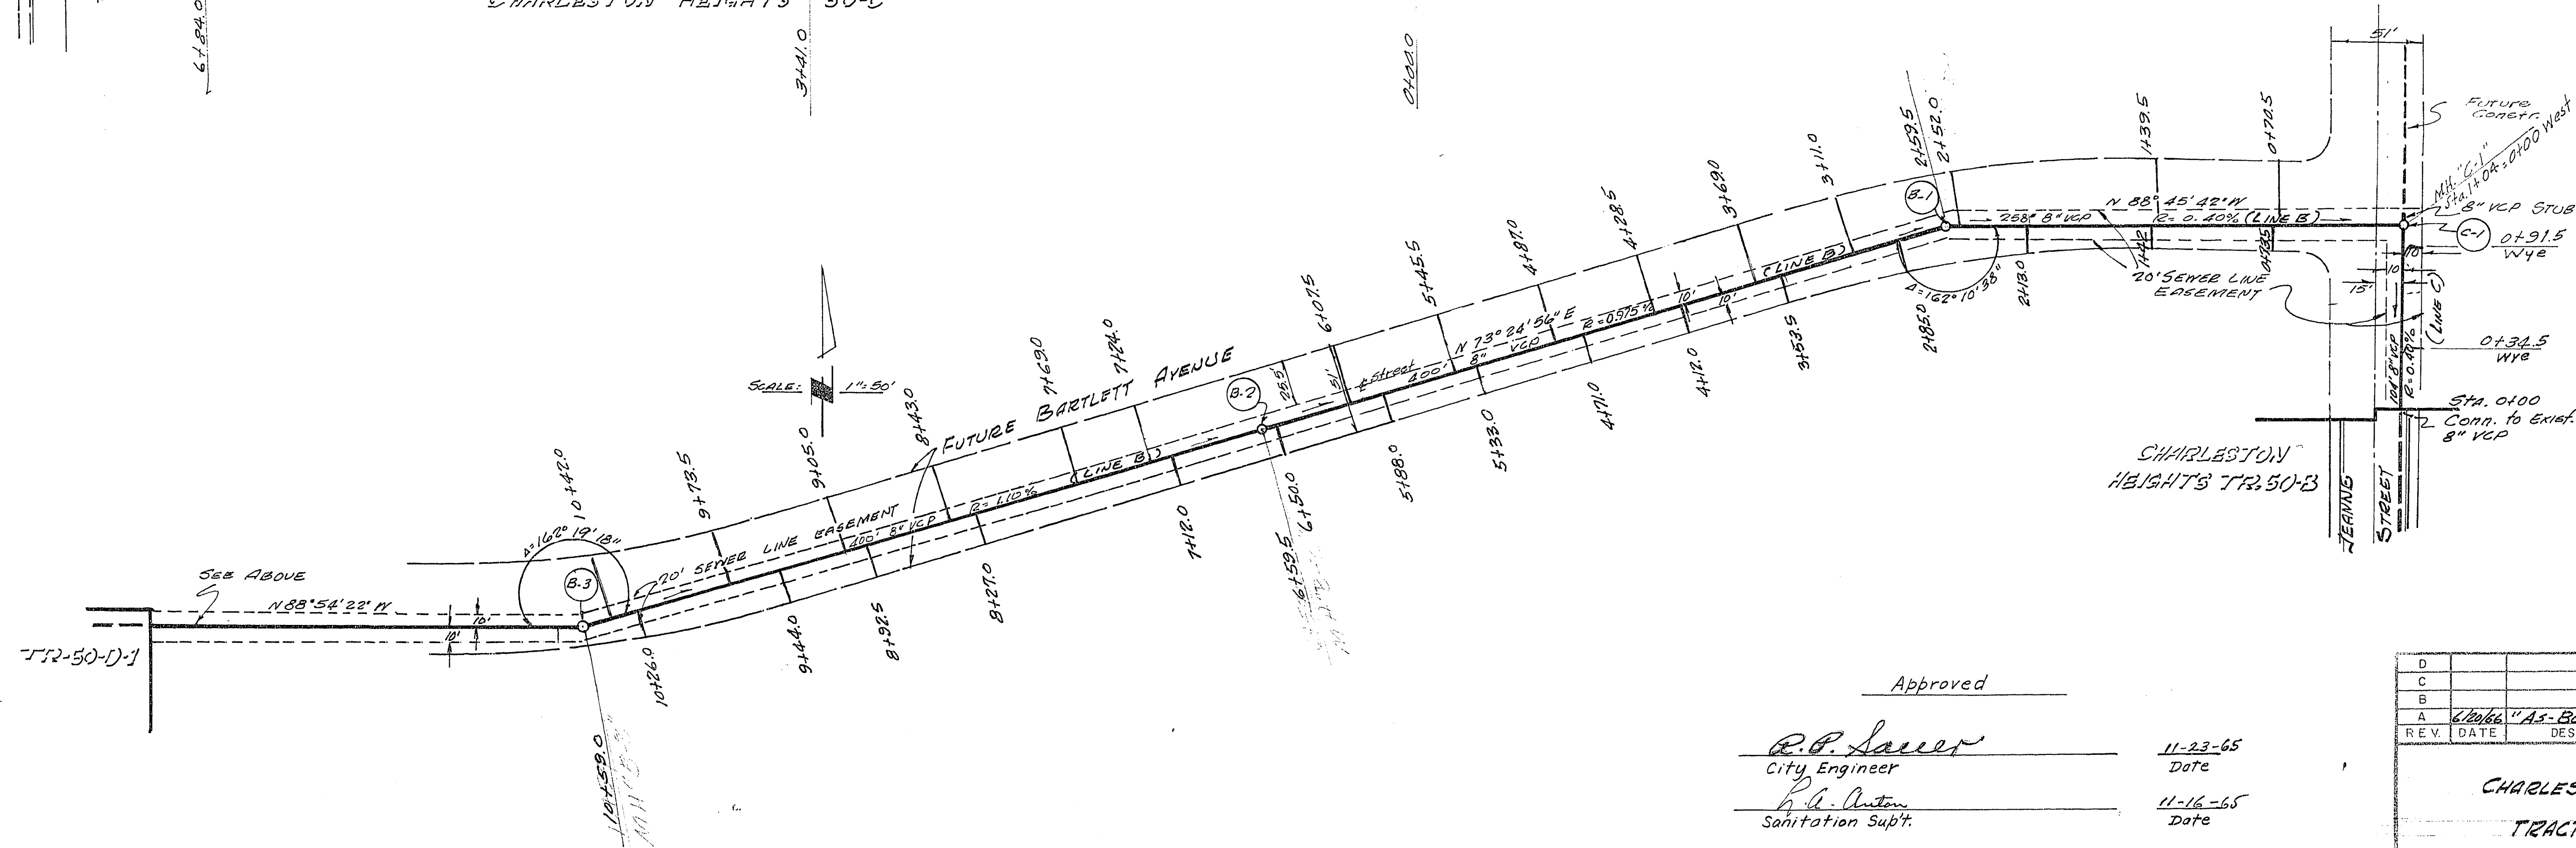

Approved

R. P. Sawyer
 City Engineer
R. A. Anton
 Sanitation Subt.

11-23-65
 Date

11-16-65
 Date

REV.	DATE	DESCRIPTION	BY	APPR.
A		Check "As-Built"	JR	
B				
C				
D				

DESIGNED	RP	TRAJAN ENGINEERING, INC.	
DRAWN	RP	LAC VEGAS, NEVADA	
CHECKED	MR		

307 Y. 10420-50D-1