


SEWER LATERAL AS-BUILTS

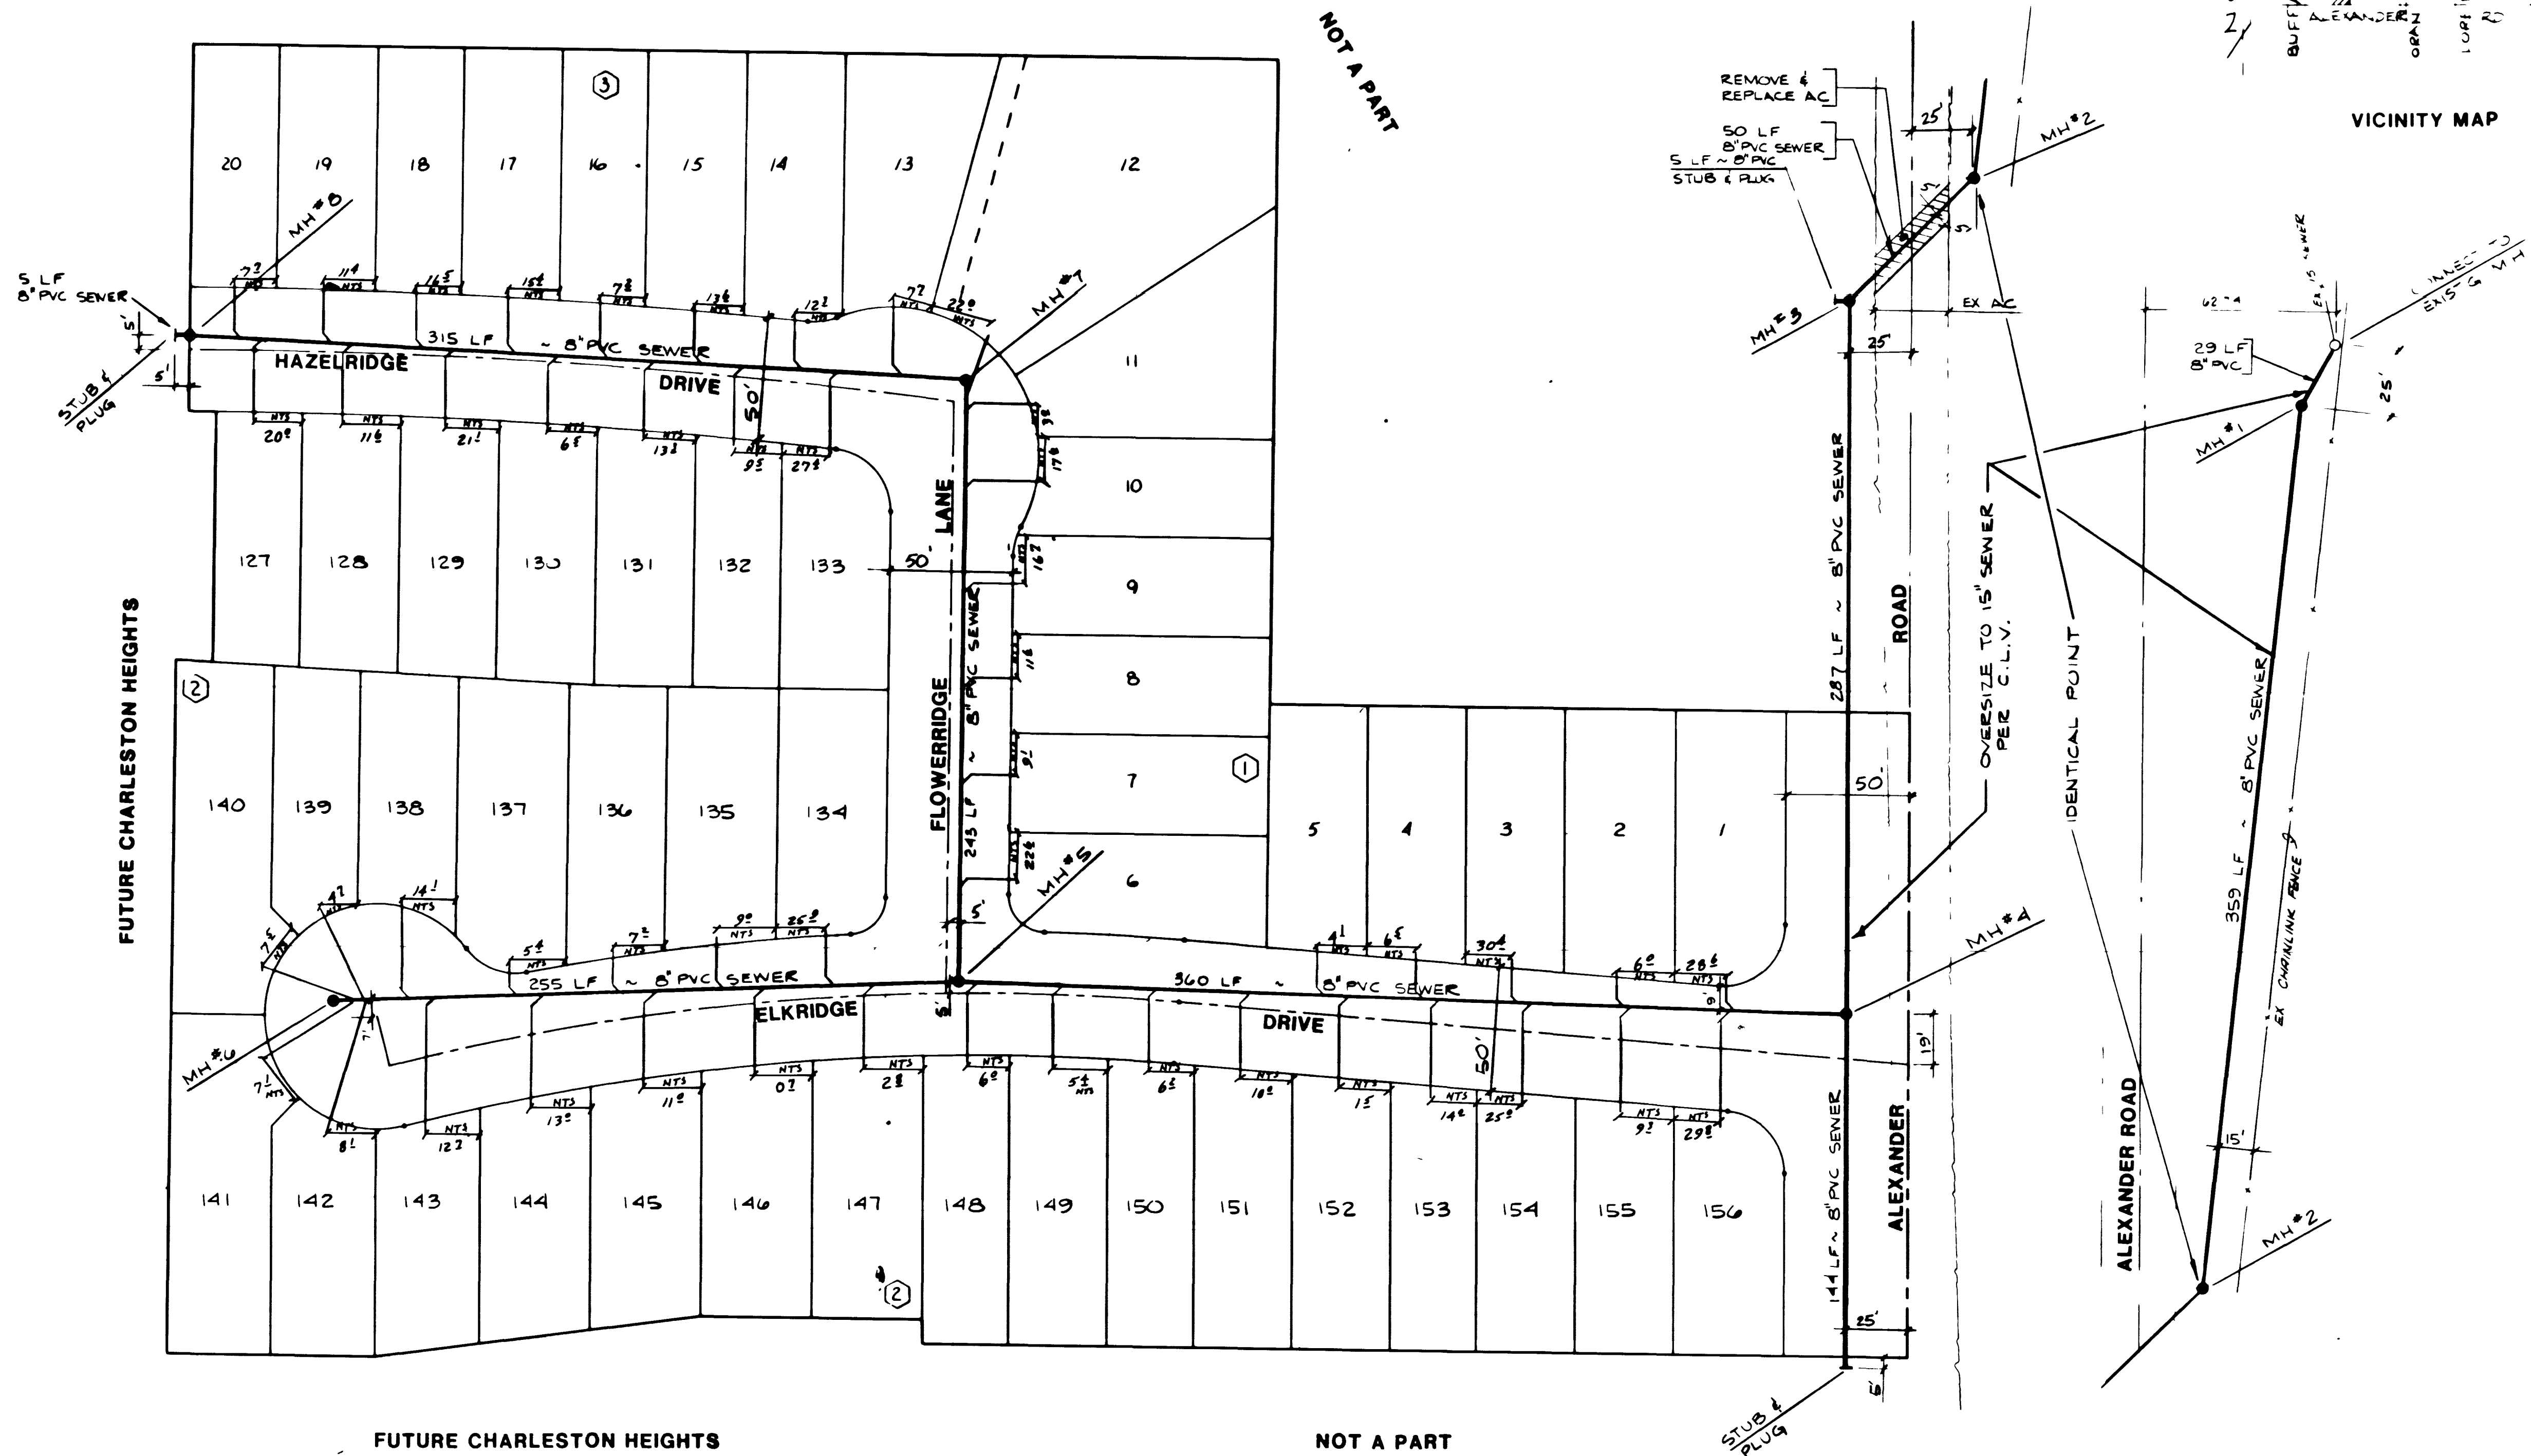

SEWER LATERAL "AS-BUILT" CERTIFICATION

GENE D. KRAETZNER, P.E.
NEVADA CERT. NO. 1201

5/2/90

MANHOLE COORDINATES


NO.	NORTH	EAST
2	4970.46	5775.87
3	5020.46	5775.17
4	5022.45	5439.17
5	5383.35	5452.16
6	5638.20	5444.02
7	5379.80	5095.13
8	5695.44	5712.16

C L V SEWER NOTES

- ALL SANITARY SEWER INSTALLATIONS SHALL CONFORM TO THE STANDARD DETAILS AND SPECIFICATIONS OF THE CITY OF LAS VEGAS, AND SHALL ALSO CONFORM TO THE OFFICIAL STANDARD SPECIFICATIONS FOR PUBLIC WORKS CONSTRUCTION OF OFF-SITE IMPROVEMENTS, CLARK COUNTY AREA, LATEST EDITION, UNLESS OTHERWISE NOTED.
- CHISEL "5" OR "6" IN CHORD WIRE SEWER OR GAS LATERALS PASS UNDER THE ROAD.
- POLYETHYLENE GLASS REINFORCED (PGR) SEWER PIPE SHALL MEET ASTM D-2688 OR IN SPECIFICATIONS, AND INSTALLED WITH SAND BEDDING AND BACKFILL OF TYPE II BINDER.
- ALL MANHOLES IN PAVED STREETS 30" DIA. AND LARGER, SHALL HAVE CONCRETE CHAMBERS.
- THE SADDLES SHALL BE USED TO CONNECT SEWER LATERALS TO EXISTING MAIN LINES UP TO 12" DIA. SIZE. CONNECTIONS TO 15" OR LARGER MAINS SHALL REQUIRE SPECIAL PROCEDURES.
- A SEWER MAIN CROSSING OVER A WATER MAIN, OR LESS THAN 18" UNDER A WATER MAIN MUST BE REINFORCED CONCRETE ENCASED PIPE FOR A DISTANCE NOT LESS THAN 10' FEET EACH SIDE OF THE CENTER LINE OF THE WATER MAIN.

QUANTITY ESTIMATE

STD MANHOLE	8 EA
DROP MANHOLE	1 EA
8" PVC SEWER MAIN	2067 LF
4" PVC SEWER LATERAL	1005 LF
WYES	50 EA

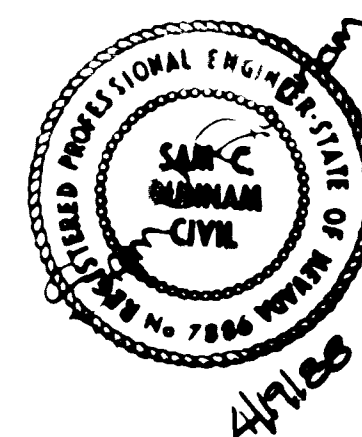

PLASTER DEVELOPMENT

LAS VEGAS, NEVADA



CONSULTING ENGINEERS - PLANNERS
2300 PARK DRIVE, SUITE 100
LAS VEGAS, NEVADA 89102 (702) 633-5500

MASTER SEWER PLAN

CHARLESTON HEIGHTS TRACT 63
UNIT 1

NO. 3179-1

BY RPF/JDS

DATE APRIL 88

SCALE 1"=40'

6

OF 13 SHEETS

3074-1040-63-1

SEWER LATERAL "Pig-Belly" CERTIFICATION




LINE	START	END
1	100+00	100+50
2	100+50	101+00
3	101+00	101+50
4	101+50	102+00
5	102+00	102+50
6	102+50	103+00

CCV REVIEW NOTES

1. Review of the plan and profile drawings.
2. Review of the proposed construction details.
3. Review of the proposed construction methods.
4. Review of the proposed construction materials.
5. Review of the proposed construction schedule.
6. Review of the proposed construction cost estimate.

QUANTITY ESTIMATE

PIPE	100' x 12"	100'
MANHOLE	100' x 12"	100'
OF THE SAME SIZE	100' x 12"	100'
OF THE SAME SIZE	100' x 12"	100'

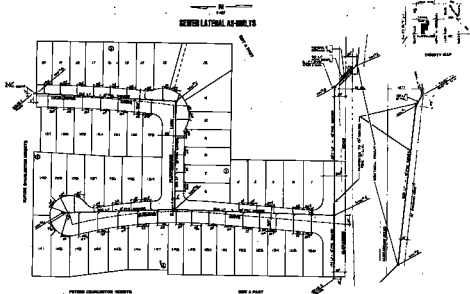

PLASTER DEVELOPMENT
LAS VEGAS, NEVADA

CHARLESTON HEIGHTS TRACT 03
SHEET 1

MASTER SEWER PLAN

CHARLESTON HEIGHTS TRACT 03
SHEET 1

100' x 12"

100' x 12"

