


VTN NEVADA'S AS BUILT RECORD
 AS BUILT PROJECT ENGINEER: Charley R Johnson 12/10/19
 APPROVED: _____ DATE _____
 CITY OF LAS VEGAS ENGINEER: _____ DATE _____
 APPROVED _____
 CLV CITY ENGINEER: _____ DATE _____
 CLV SANITATION ENGINEER: _____ DATE _____
 CLV FIELD OPERATIONS ENGINEER: _____ DATE _____
 CLV QUALITY CONTROL ENGINEER: _____ DATE _____


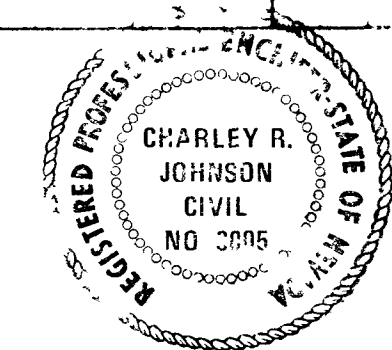


Submitted By Charley R Johnson 12/12/28
Charley R Johnson RPE DATE
Neu Cert No 3005

VTN CONSULTING ENGINEERS & PLANNERS
 2209 PARADISE ROAD
 LAS VEGAS, NEVADA

CHARLESTON RAINBOW
 UNIT 17A
 SEWER PLAN & PROFILE
 DUCHARME AVENUE
 APLIN AVENUE

Scale	1/4" = 10'-0"	Date	12/12/28	Sheet	8	of	11
Horz	1" = 40'	Des	EVJ				
Vert	1" = 4'	CHK	EVJ				

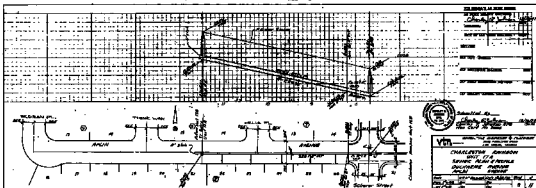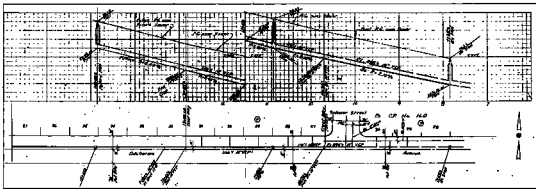

EXPLANATION

SEWER MAIN

SEWER BRANCH

WATER MAIN

STREET LIGHT

CROSSING

DRAINAGE

SLOPE

VERTICAL CURVE

Scale: 1" = 100'

Approved by: _____

Checked by: _____

Drawn by: _____

DATE: _____

V.M. ENGINEER & ARCHITECT

CHARLESTON, GEORGIA

SEWERAGE DEPARTMENT

PLANS

NO. _____

DATE: _____