



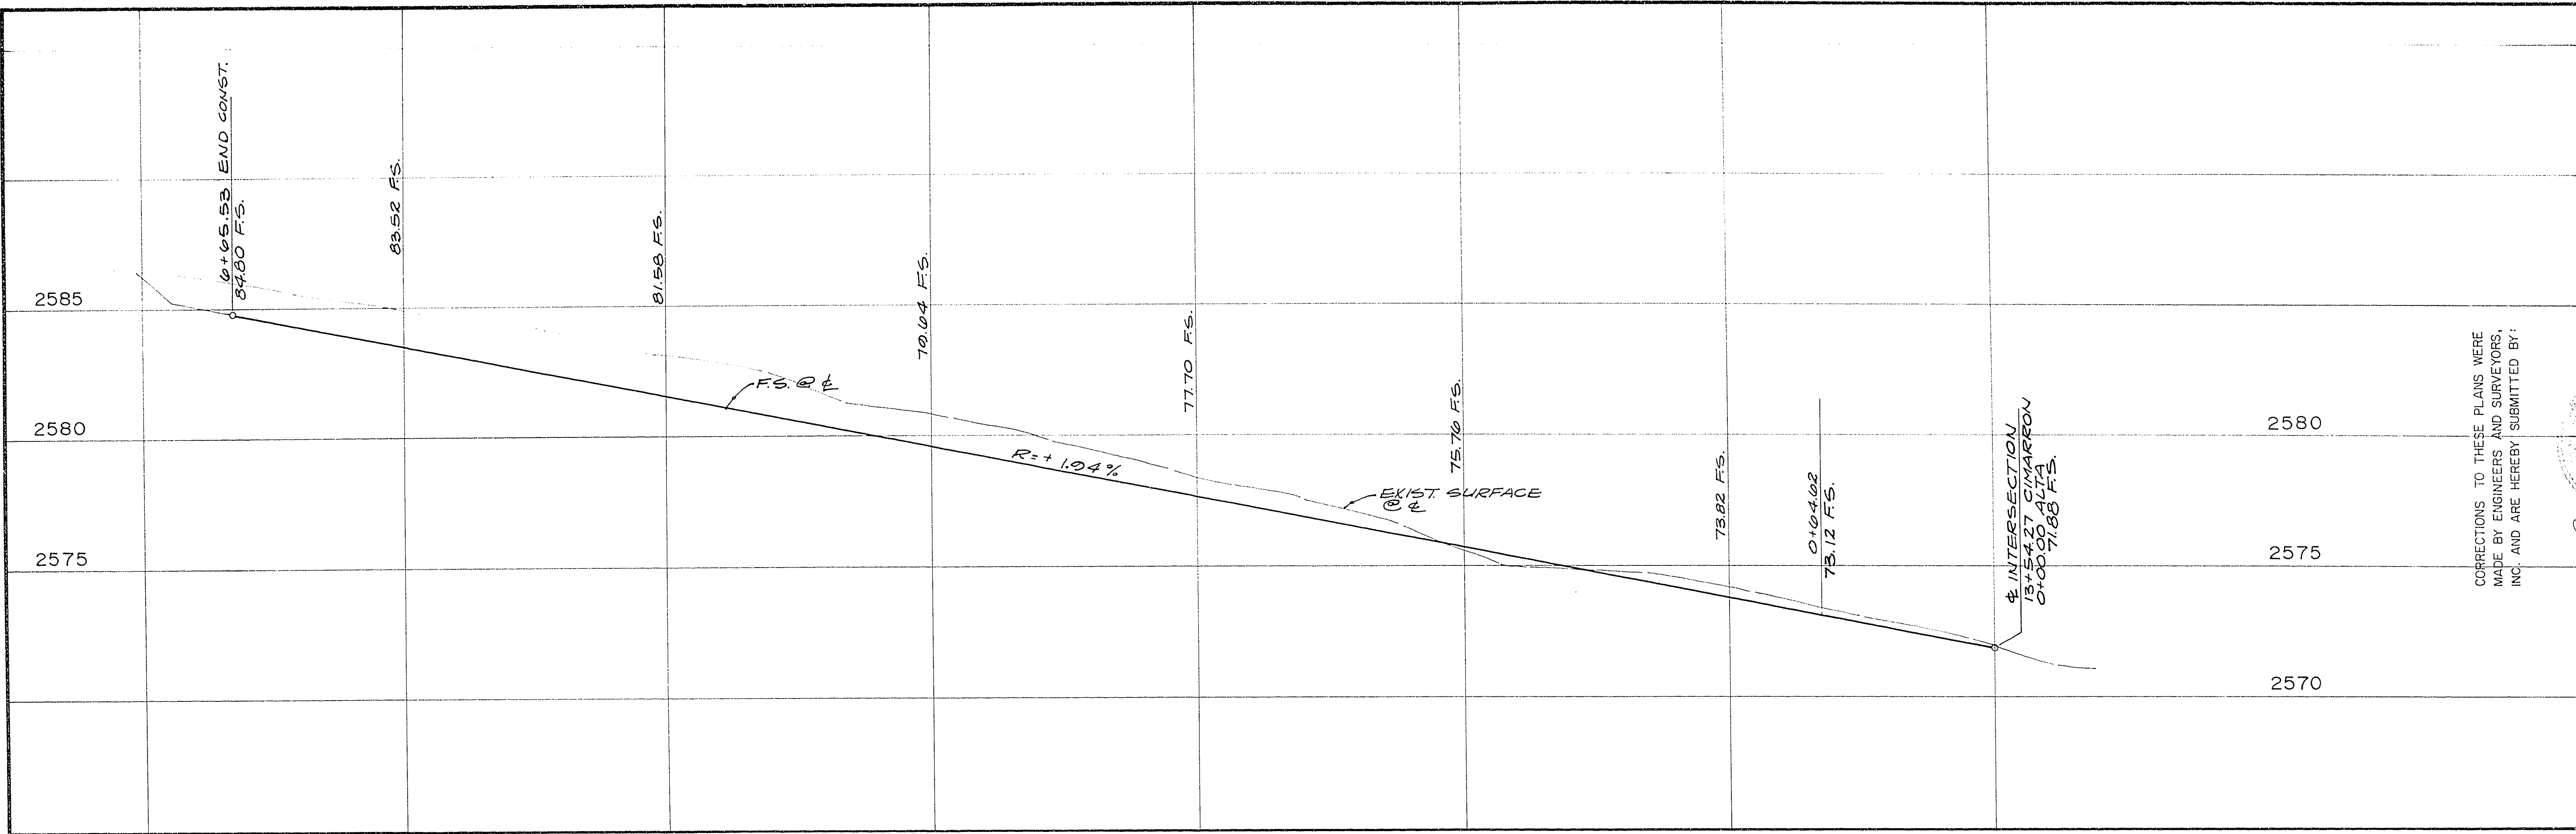

CORRECTIONS TO THESE PLANS WERE MADE BY ENGINEERS AND SURVEYORS, INC. AND ARE HEREBY SUBMITTED BY:

Rev.	Date	Description
1		
2		
3		
4		
5		


Recommended by
Paul E. Valentine
 PAUL E. VALENTINE, P.E.
 NEVADA CERTIFICATE NO. 5516
 DATE

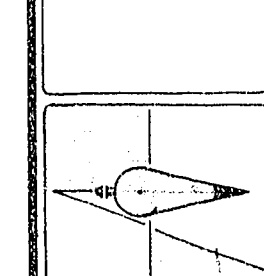

GARY D. LAKE P.E.
 CONSULTING ENGINEER
 219 WATER STREET, HENDERSON, NEVADA 89005

PLASTER DEVELOPMENT INC.
 CIMARRON HEIGHTS UNIT NO. 4
 ALTA DR.
 STREET IMPROVEMENT PLAN

SHEET
5
 of 6 sheets

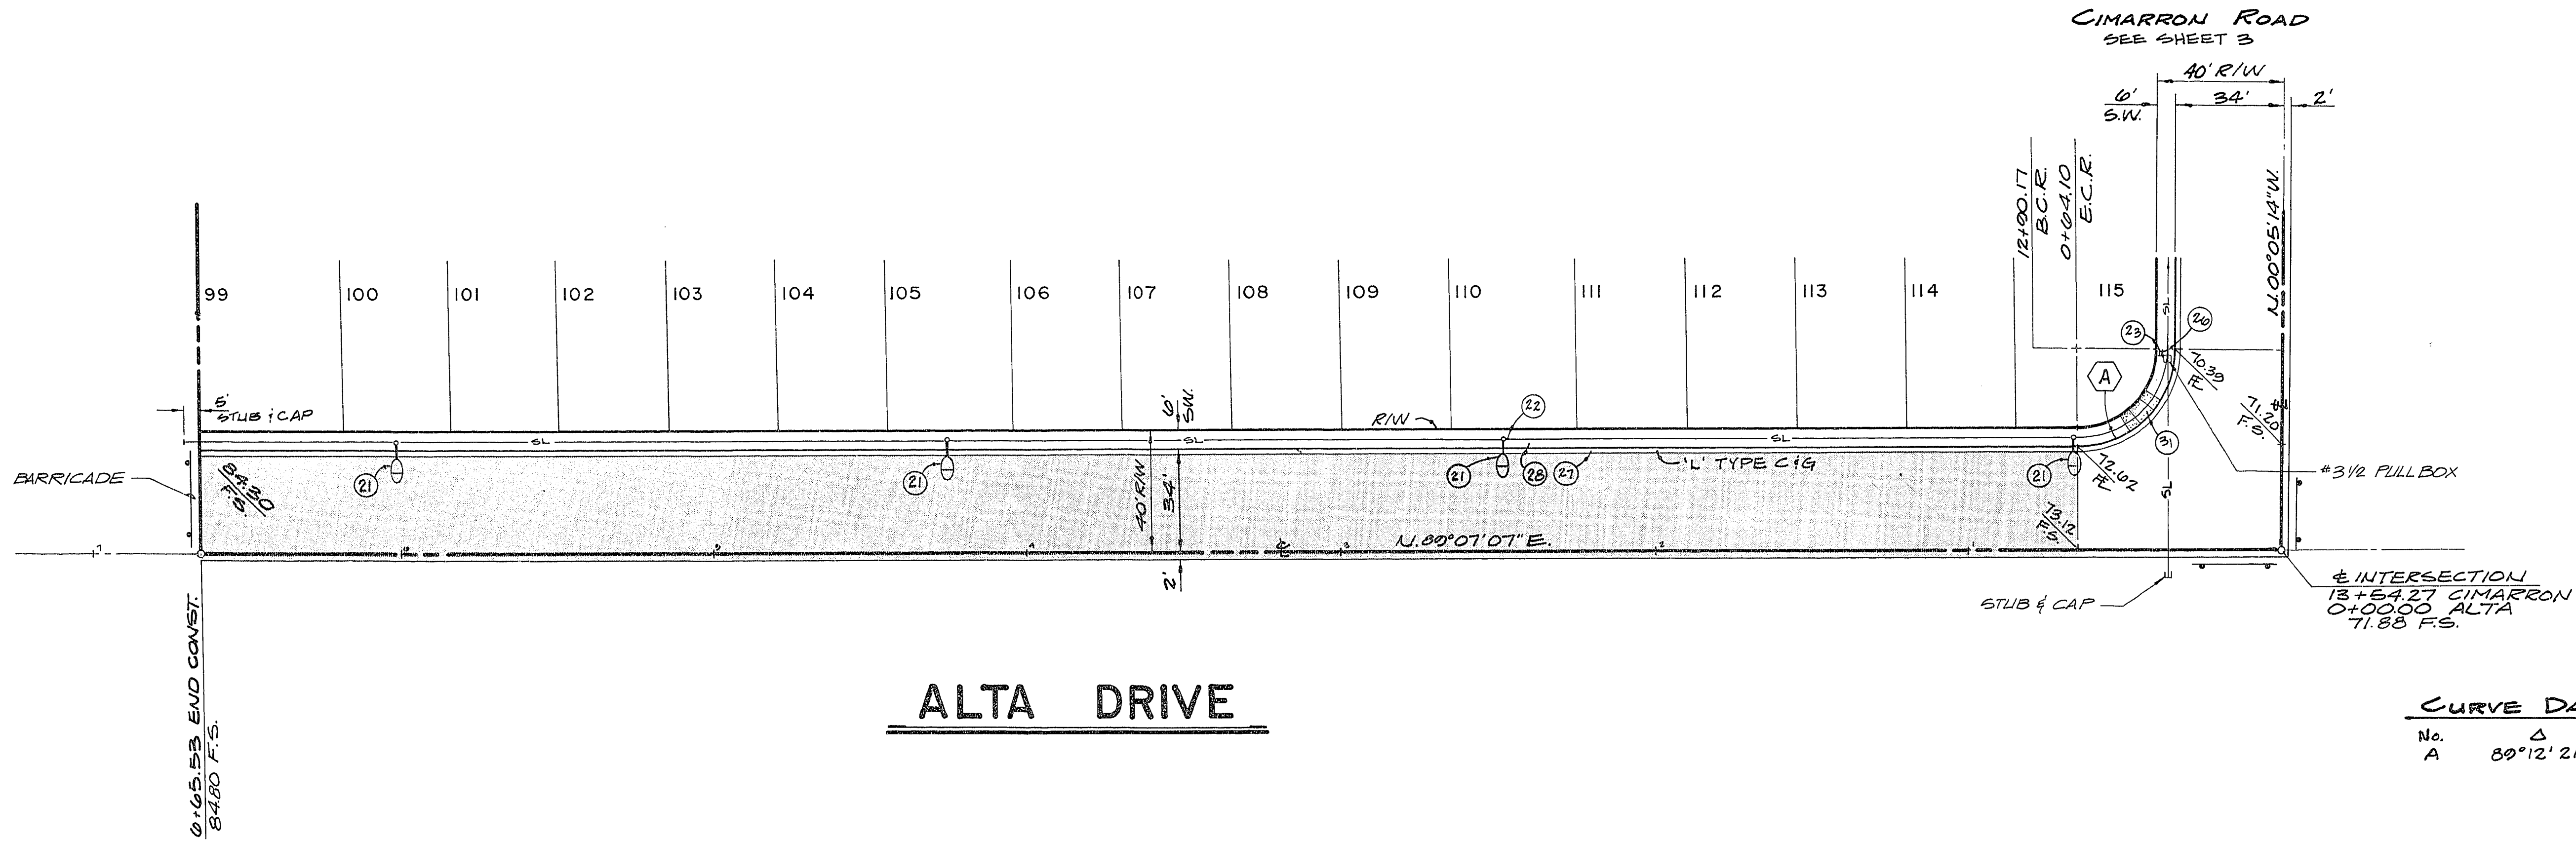

No.	Δ	R	L	T
A	89°12'21"	31.00'	43.54'	30.57'

APPROVALS

CL.V.
 C.L.V. CHIEF, LAND DEVELOPMENT &
 FLOOD CONTROL

6-10-85
 DATE