

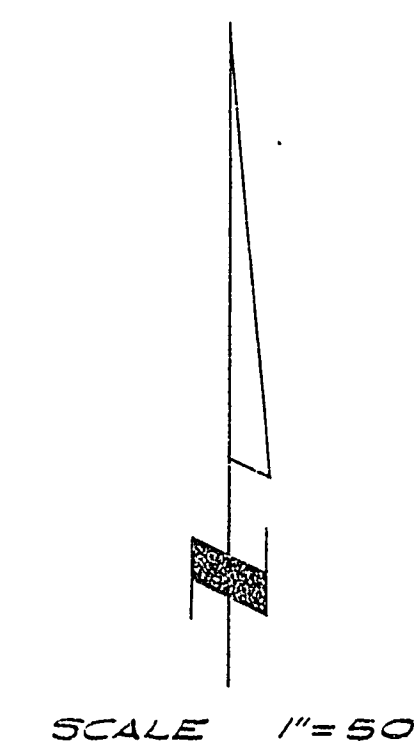


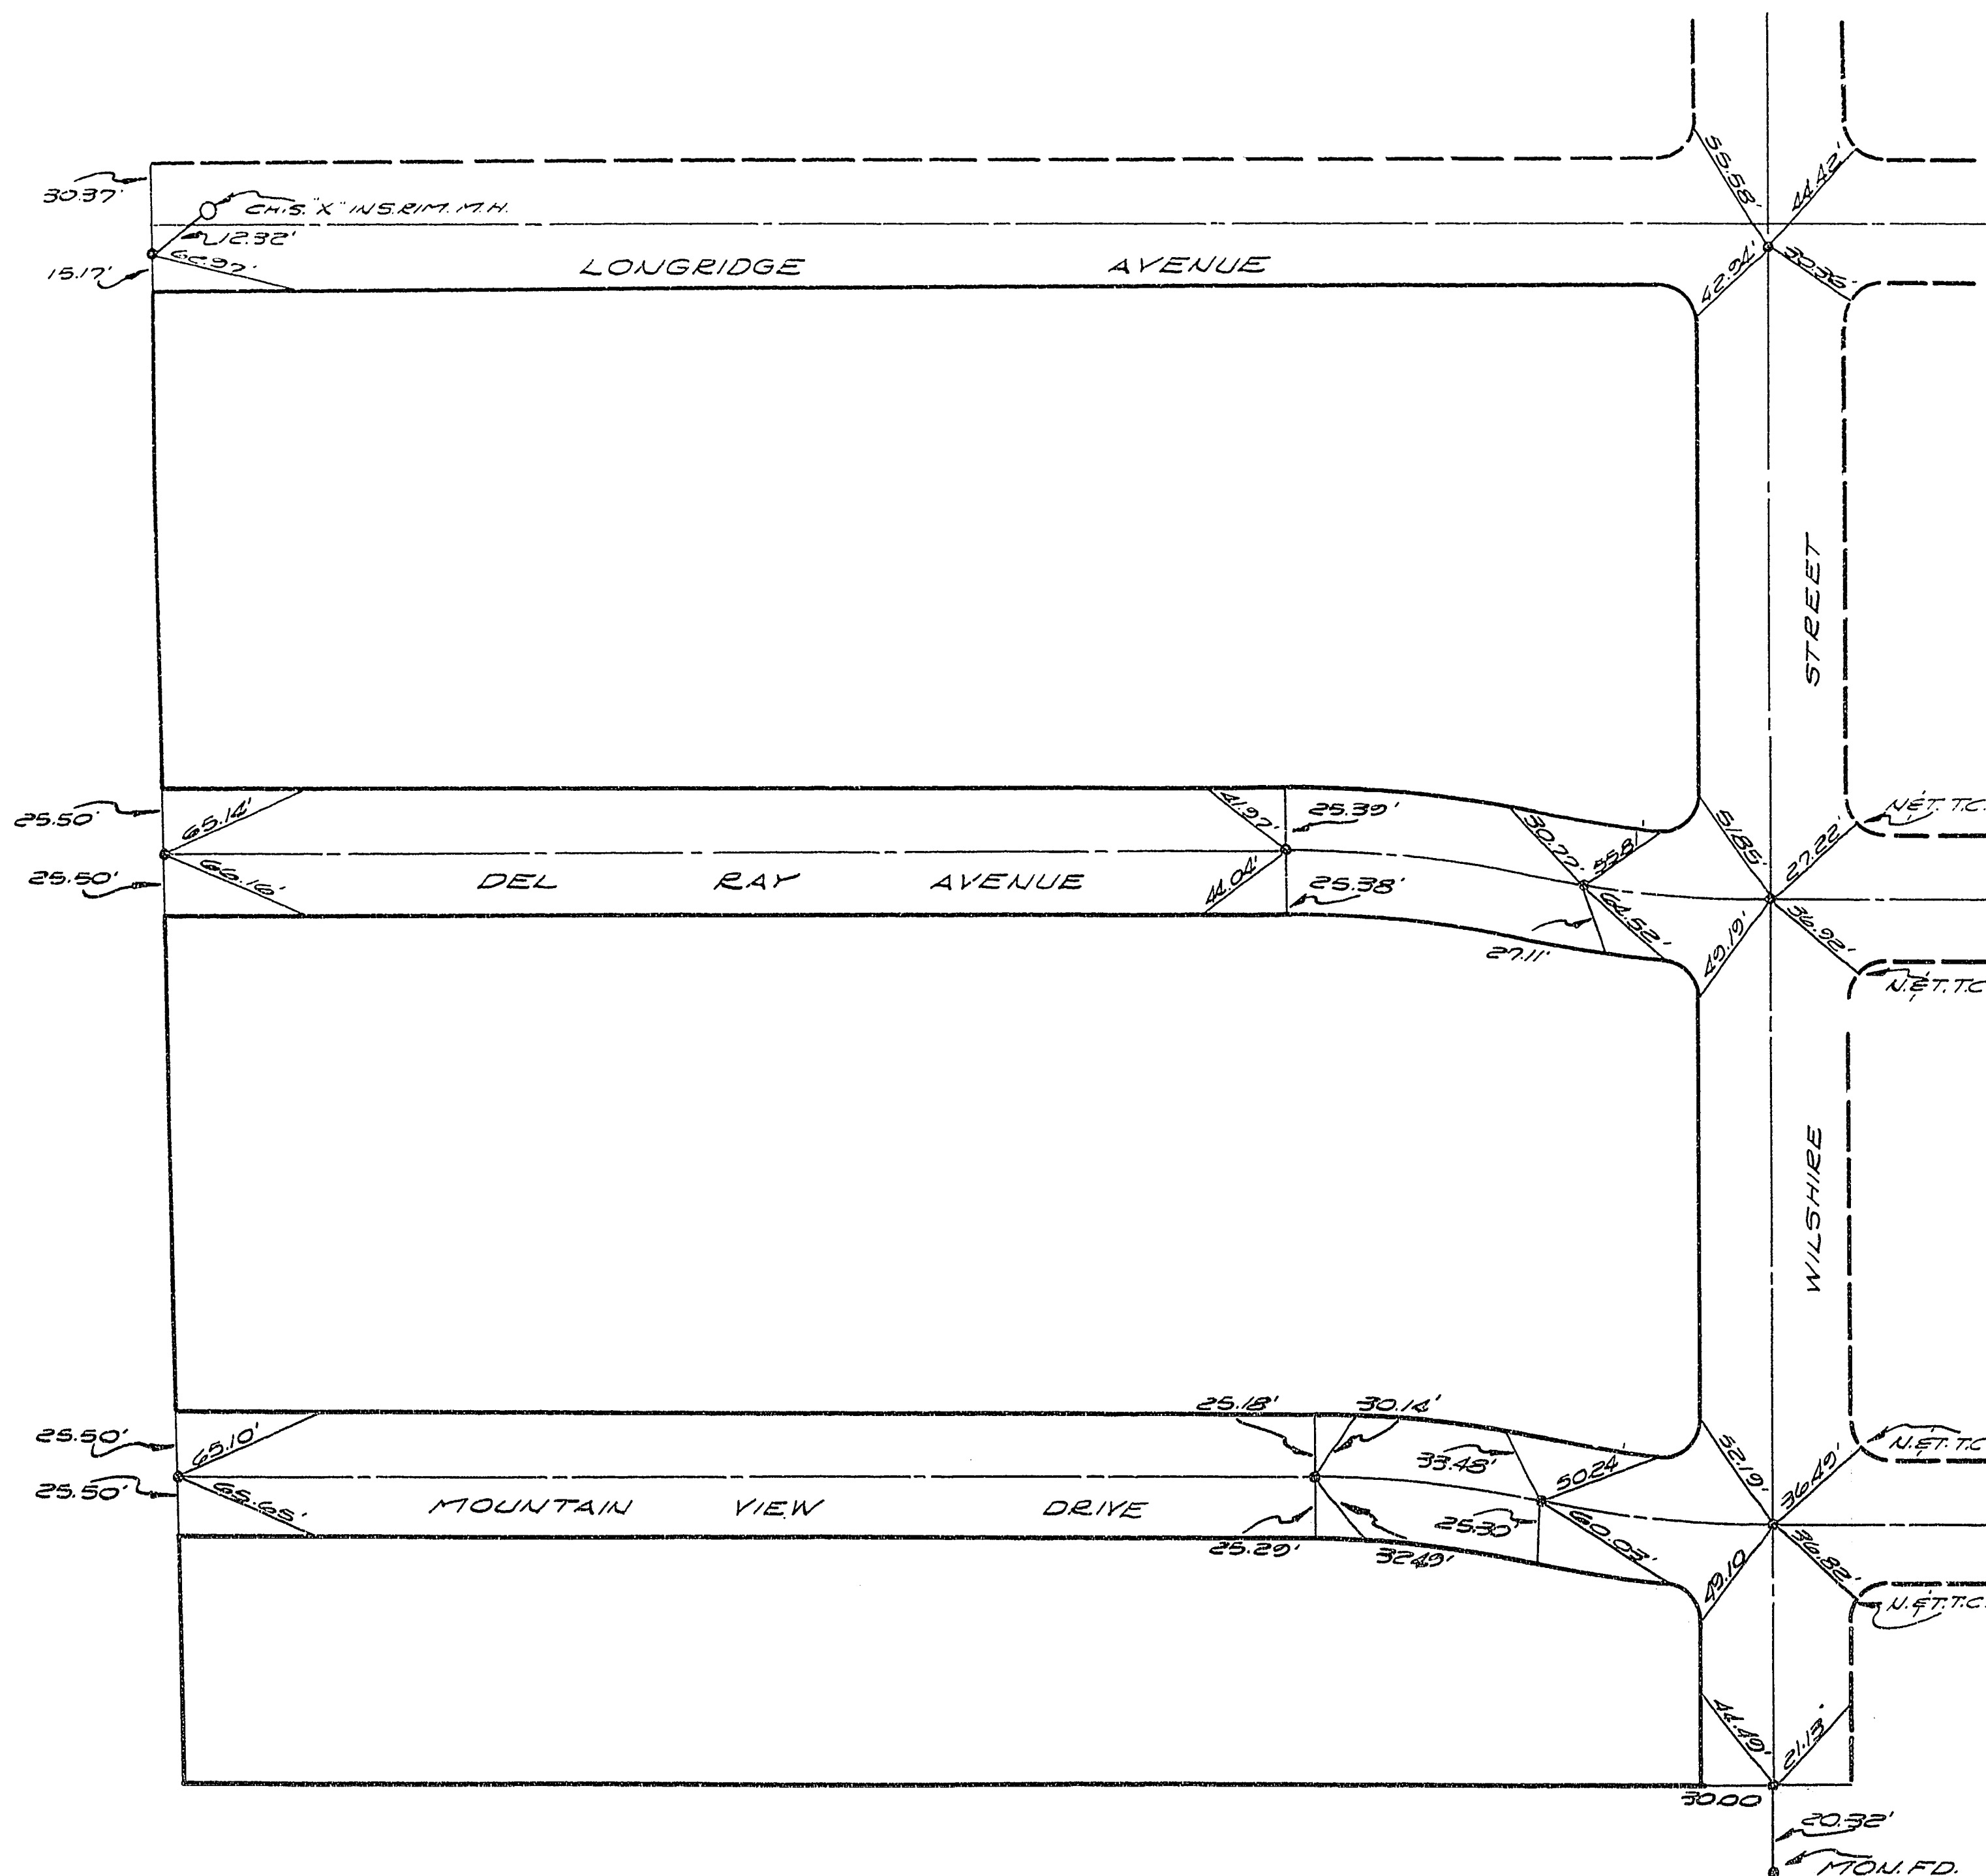

NOTES
 1. ALL MONUMENTS SET BY R.L.S. 1412.
 2. UNLESS INDICATED OTHERWISE, ALL MONUMENT REFERENCE TIES ARE CHIS. 'X'S' BACK OF CURB.

MONUMENT MAP		
FOR		
CHARLESTON HILLS # 2		
DESIGNED	WESTERN ENGINEERS, INC.	SHEET 1
DRAWN L.S.	LAS VEGAS NEVADA	OF 1
CHECKED gaw	APPROVED <i>[Signature]</i>	DATE 5-28-63

3-6-117

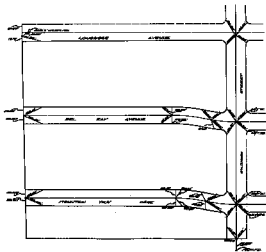

ALL PROJECTIONS ARE BY AIR AND
 HORIZONTAL DISTANCE

PROJECT NAME			
DATE			
AUTOMATICALLY PRINTED			
NO.	DATE	NO.	DATE
100	10/10/10	100	10/10/10

2/10/11