


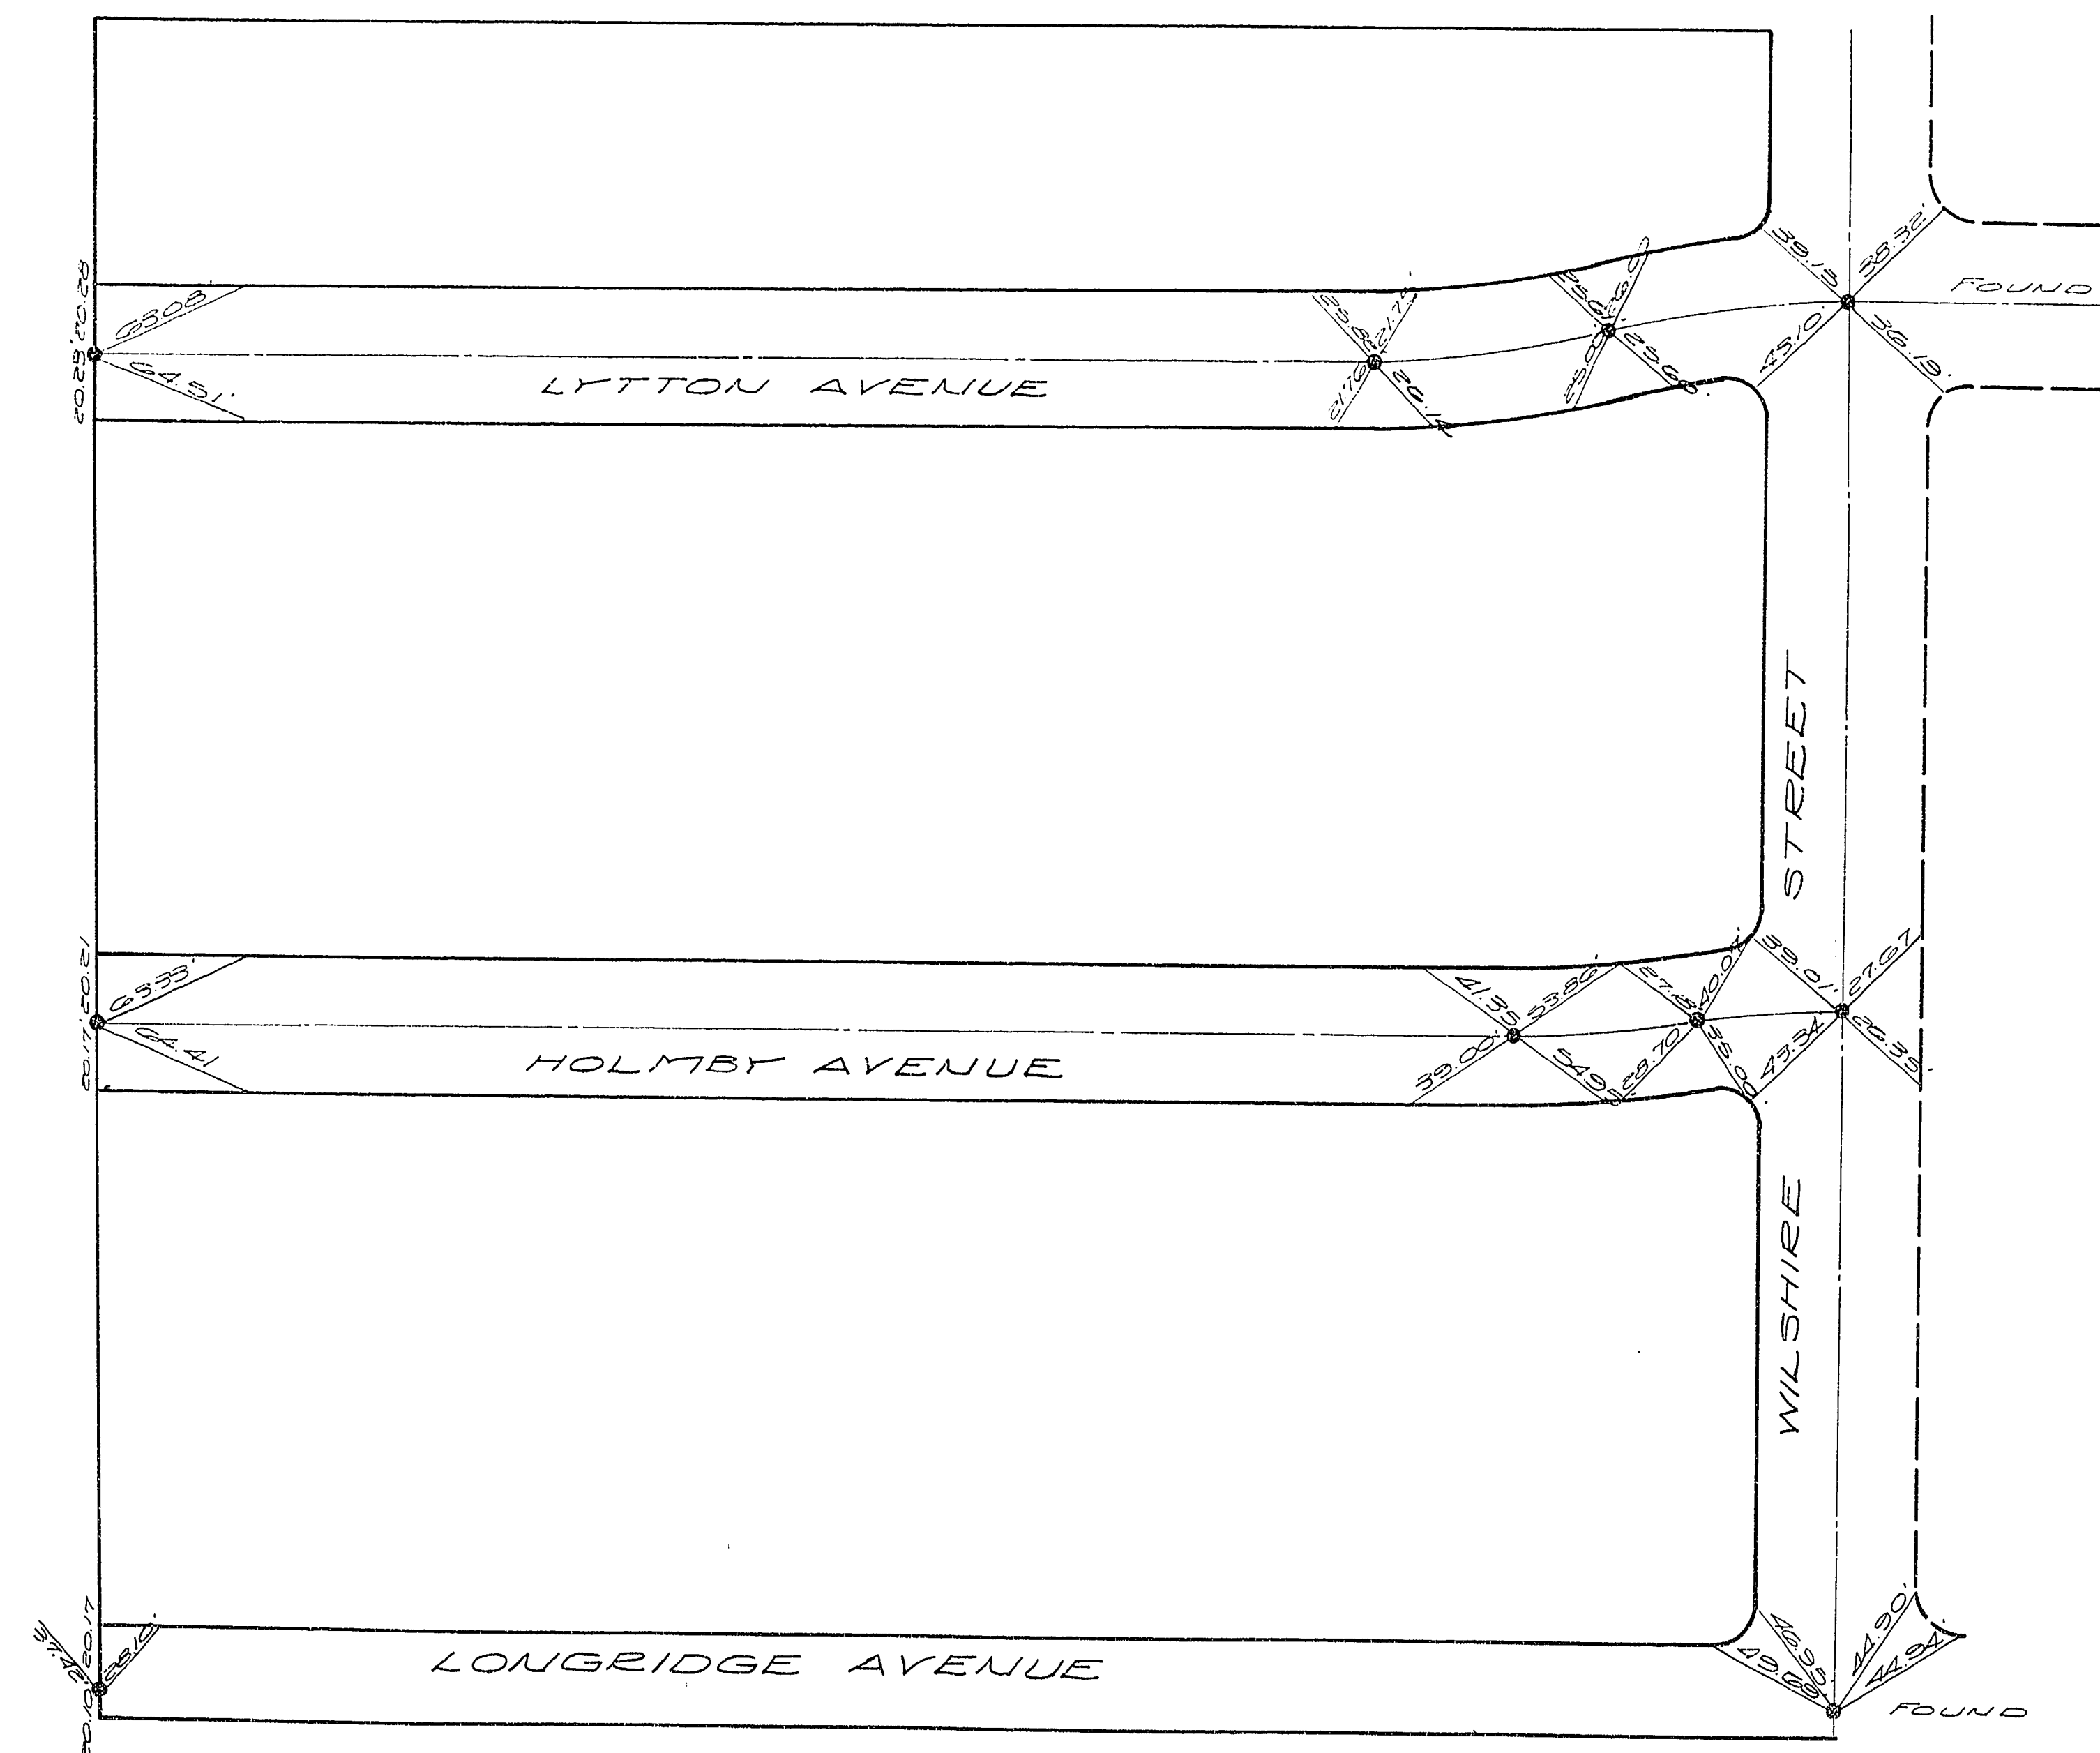


NOTE - UNLESS OTHERWISE SPECIFIED,
ALL MONUMENTS SET BY R.L.S. 12/12.

SCALE 1" = 50'

MONUMENT MAP FOR CHAS. HILLS # 1		
DESIGNED	WESTERN ENGINEERS, INC.	SHEET 1
DRAWN LS	LAS VEGAS, NEVADA	OF 1
CHECKED	APPROVED <i>[Signature]</i> DATE 5/22/69	

058-1045-1

3-6-114

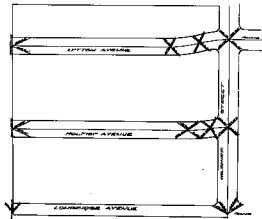

STREET LIGHTS TO BE PLACED AT INTERSECTION

PROJECT TITLE			
ROAD			
CITY, STATE & ZIP			
DATE	DESIGN	CONSTRUCTION	NO. 1
3-1-14	1-1-14	1-1-14	1-1-14

3-1-14