


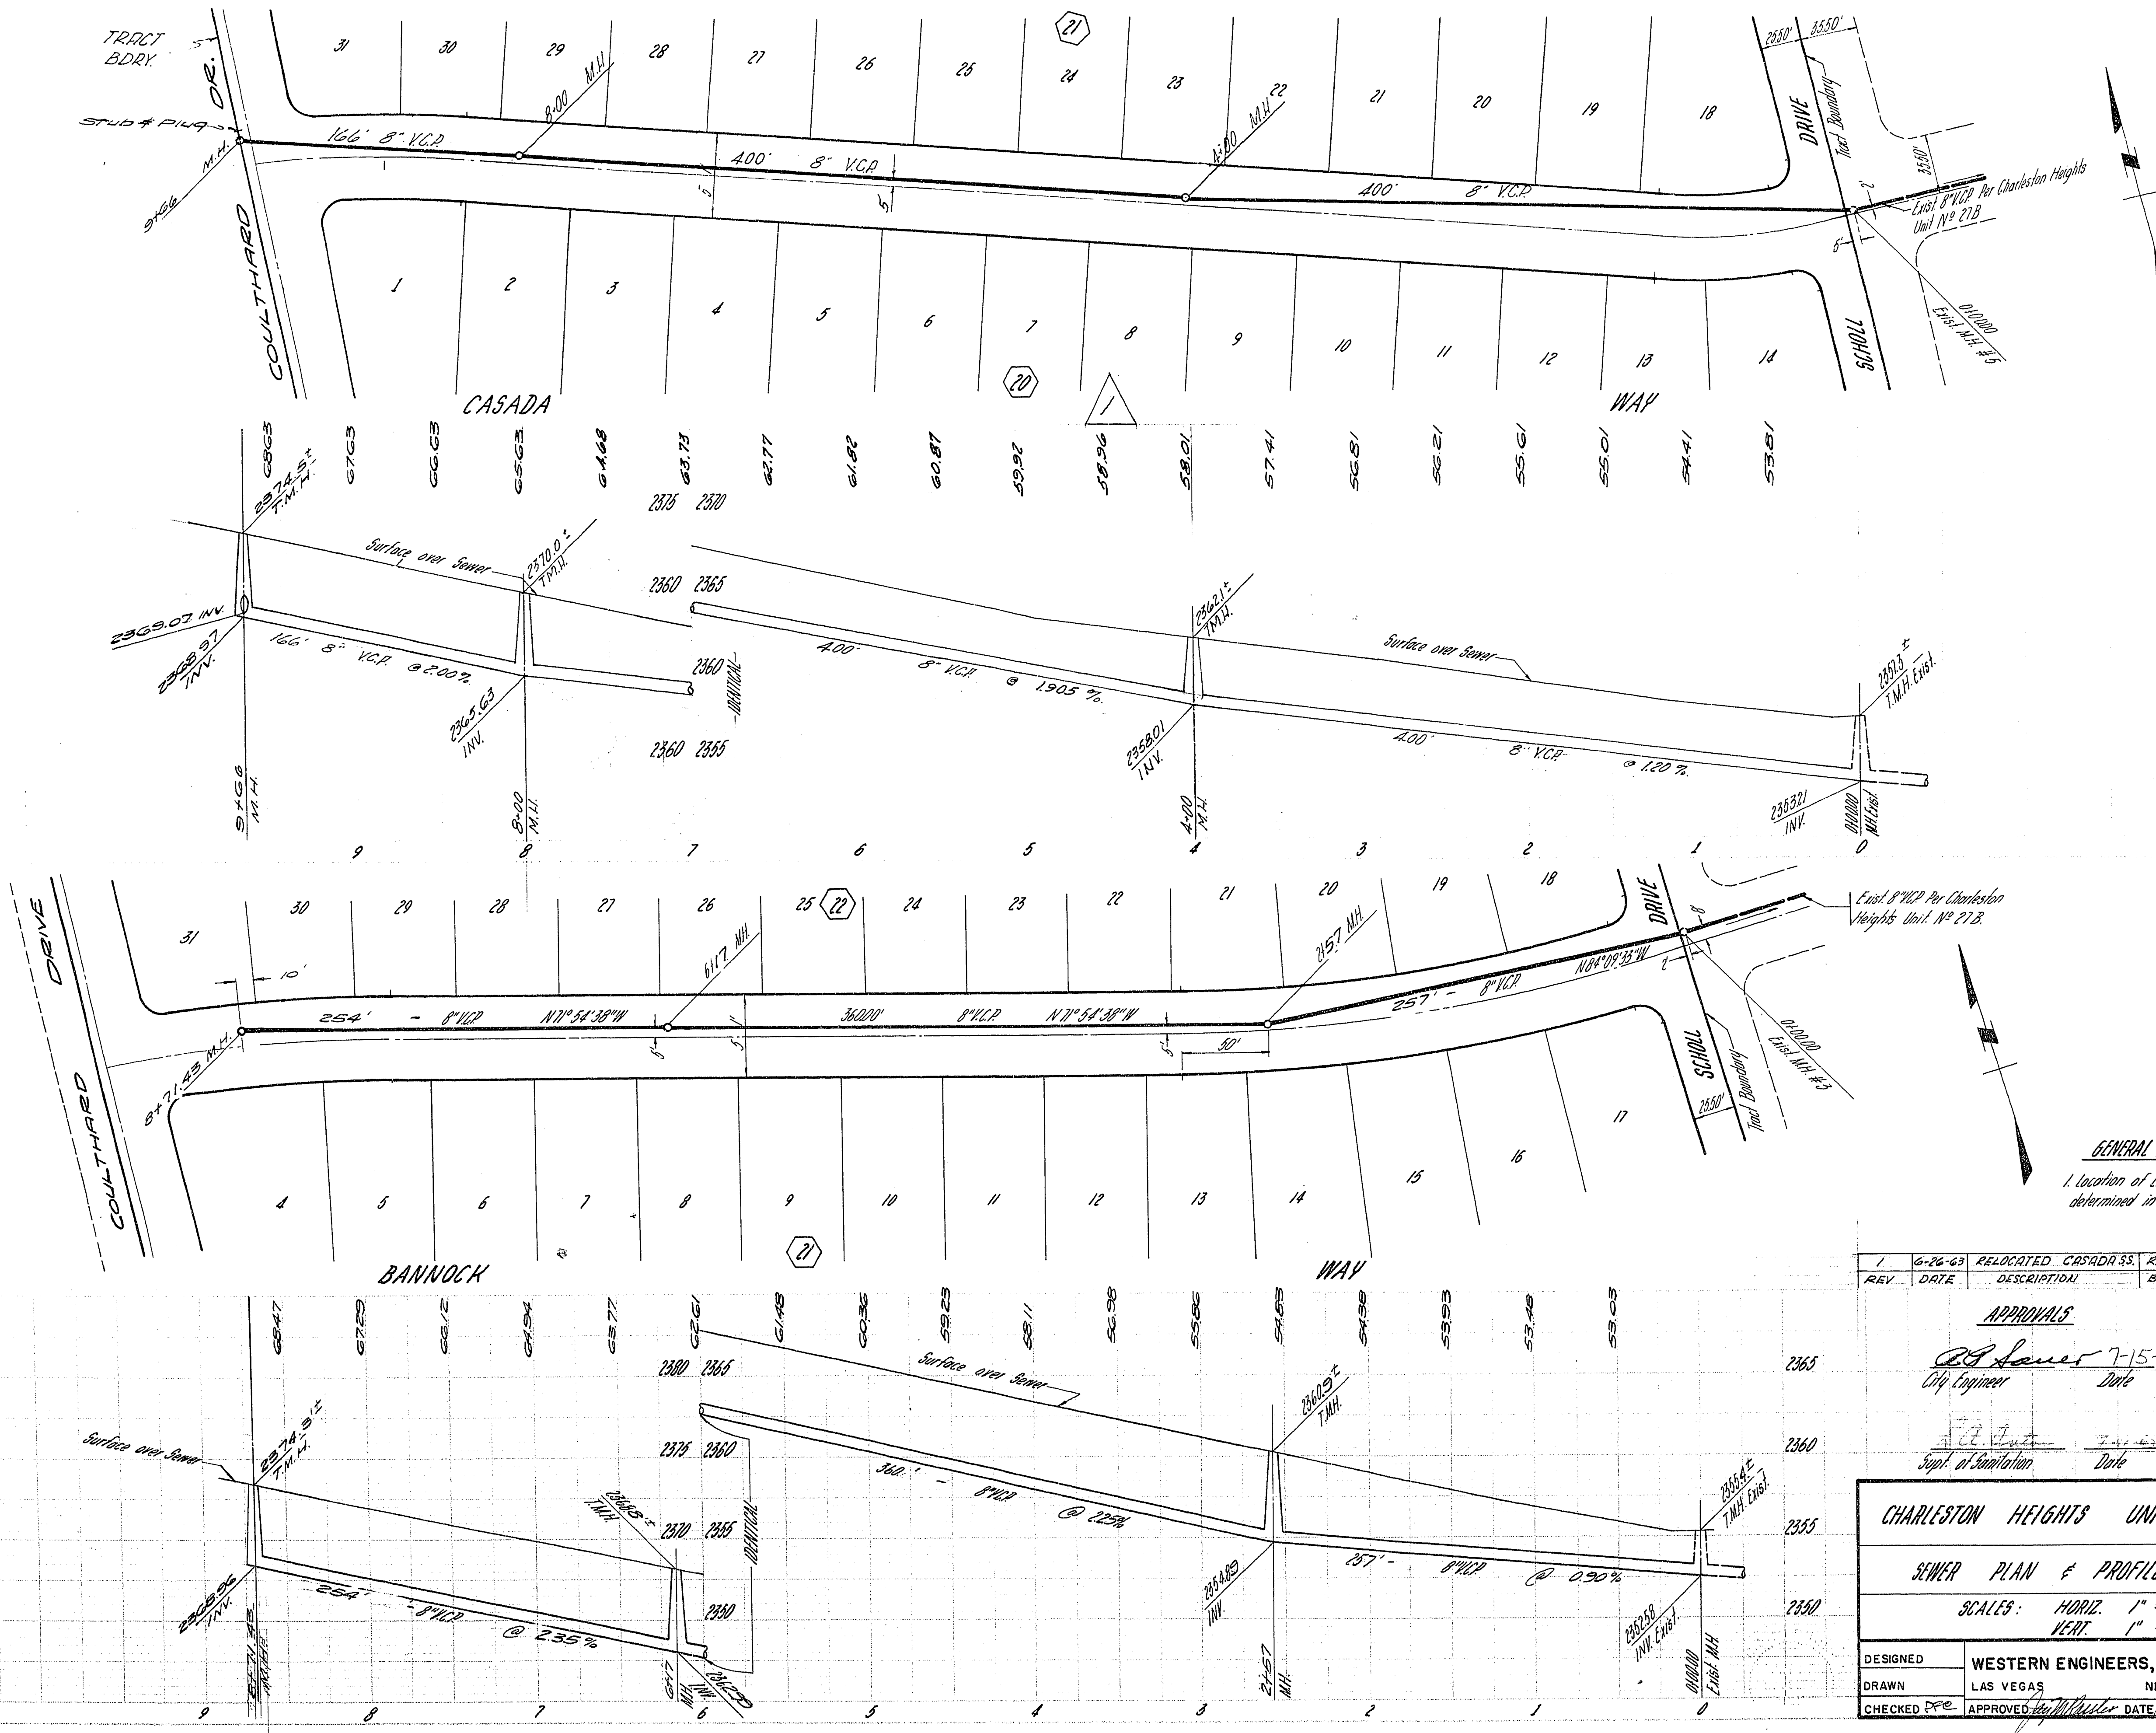


GENERAL NOTES
1. Location of laterals to be determined in the field.

REV.	DATE	DESCRIPTION	BY	APPD.
------	------	-------------	----	-------

APPROVALS
[Signature] 7-15-63
City Engineer Date
[Signature] 7-15-63
Supt. of Sanitation Date

DESIGNED		WESTERN ENGINEERS, INC.		SHEET 2 OF 4
DRAWN		LAS VEGAS, NEVADA		
CHECKED		APPROVED		

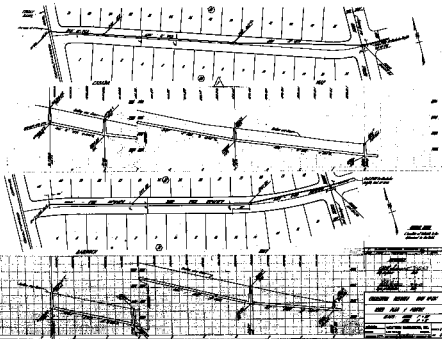

DATE	10/1/1964
BY	J. E. P.
CHECKED	J. E. P.
APPROVED	J. E. P.
SCALE	1" = 100'
PROJECT	1000M
LOCATION	1000M
DATE	10/1/1964
BY	J. E. P.
CHECKED	J. E. P.
APPROVED	J. E. P.
SCALE	1" = 100'
PROJECT	1000M
LOCATION	1000M

97-5-166