



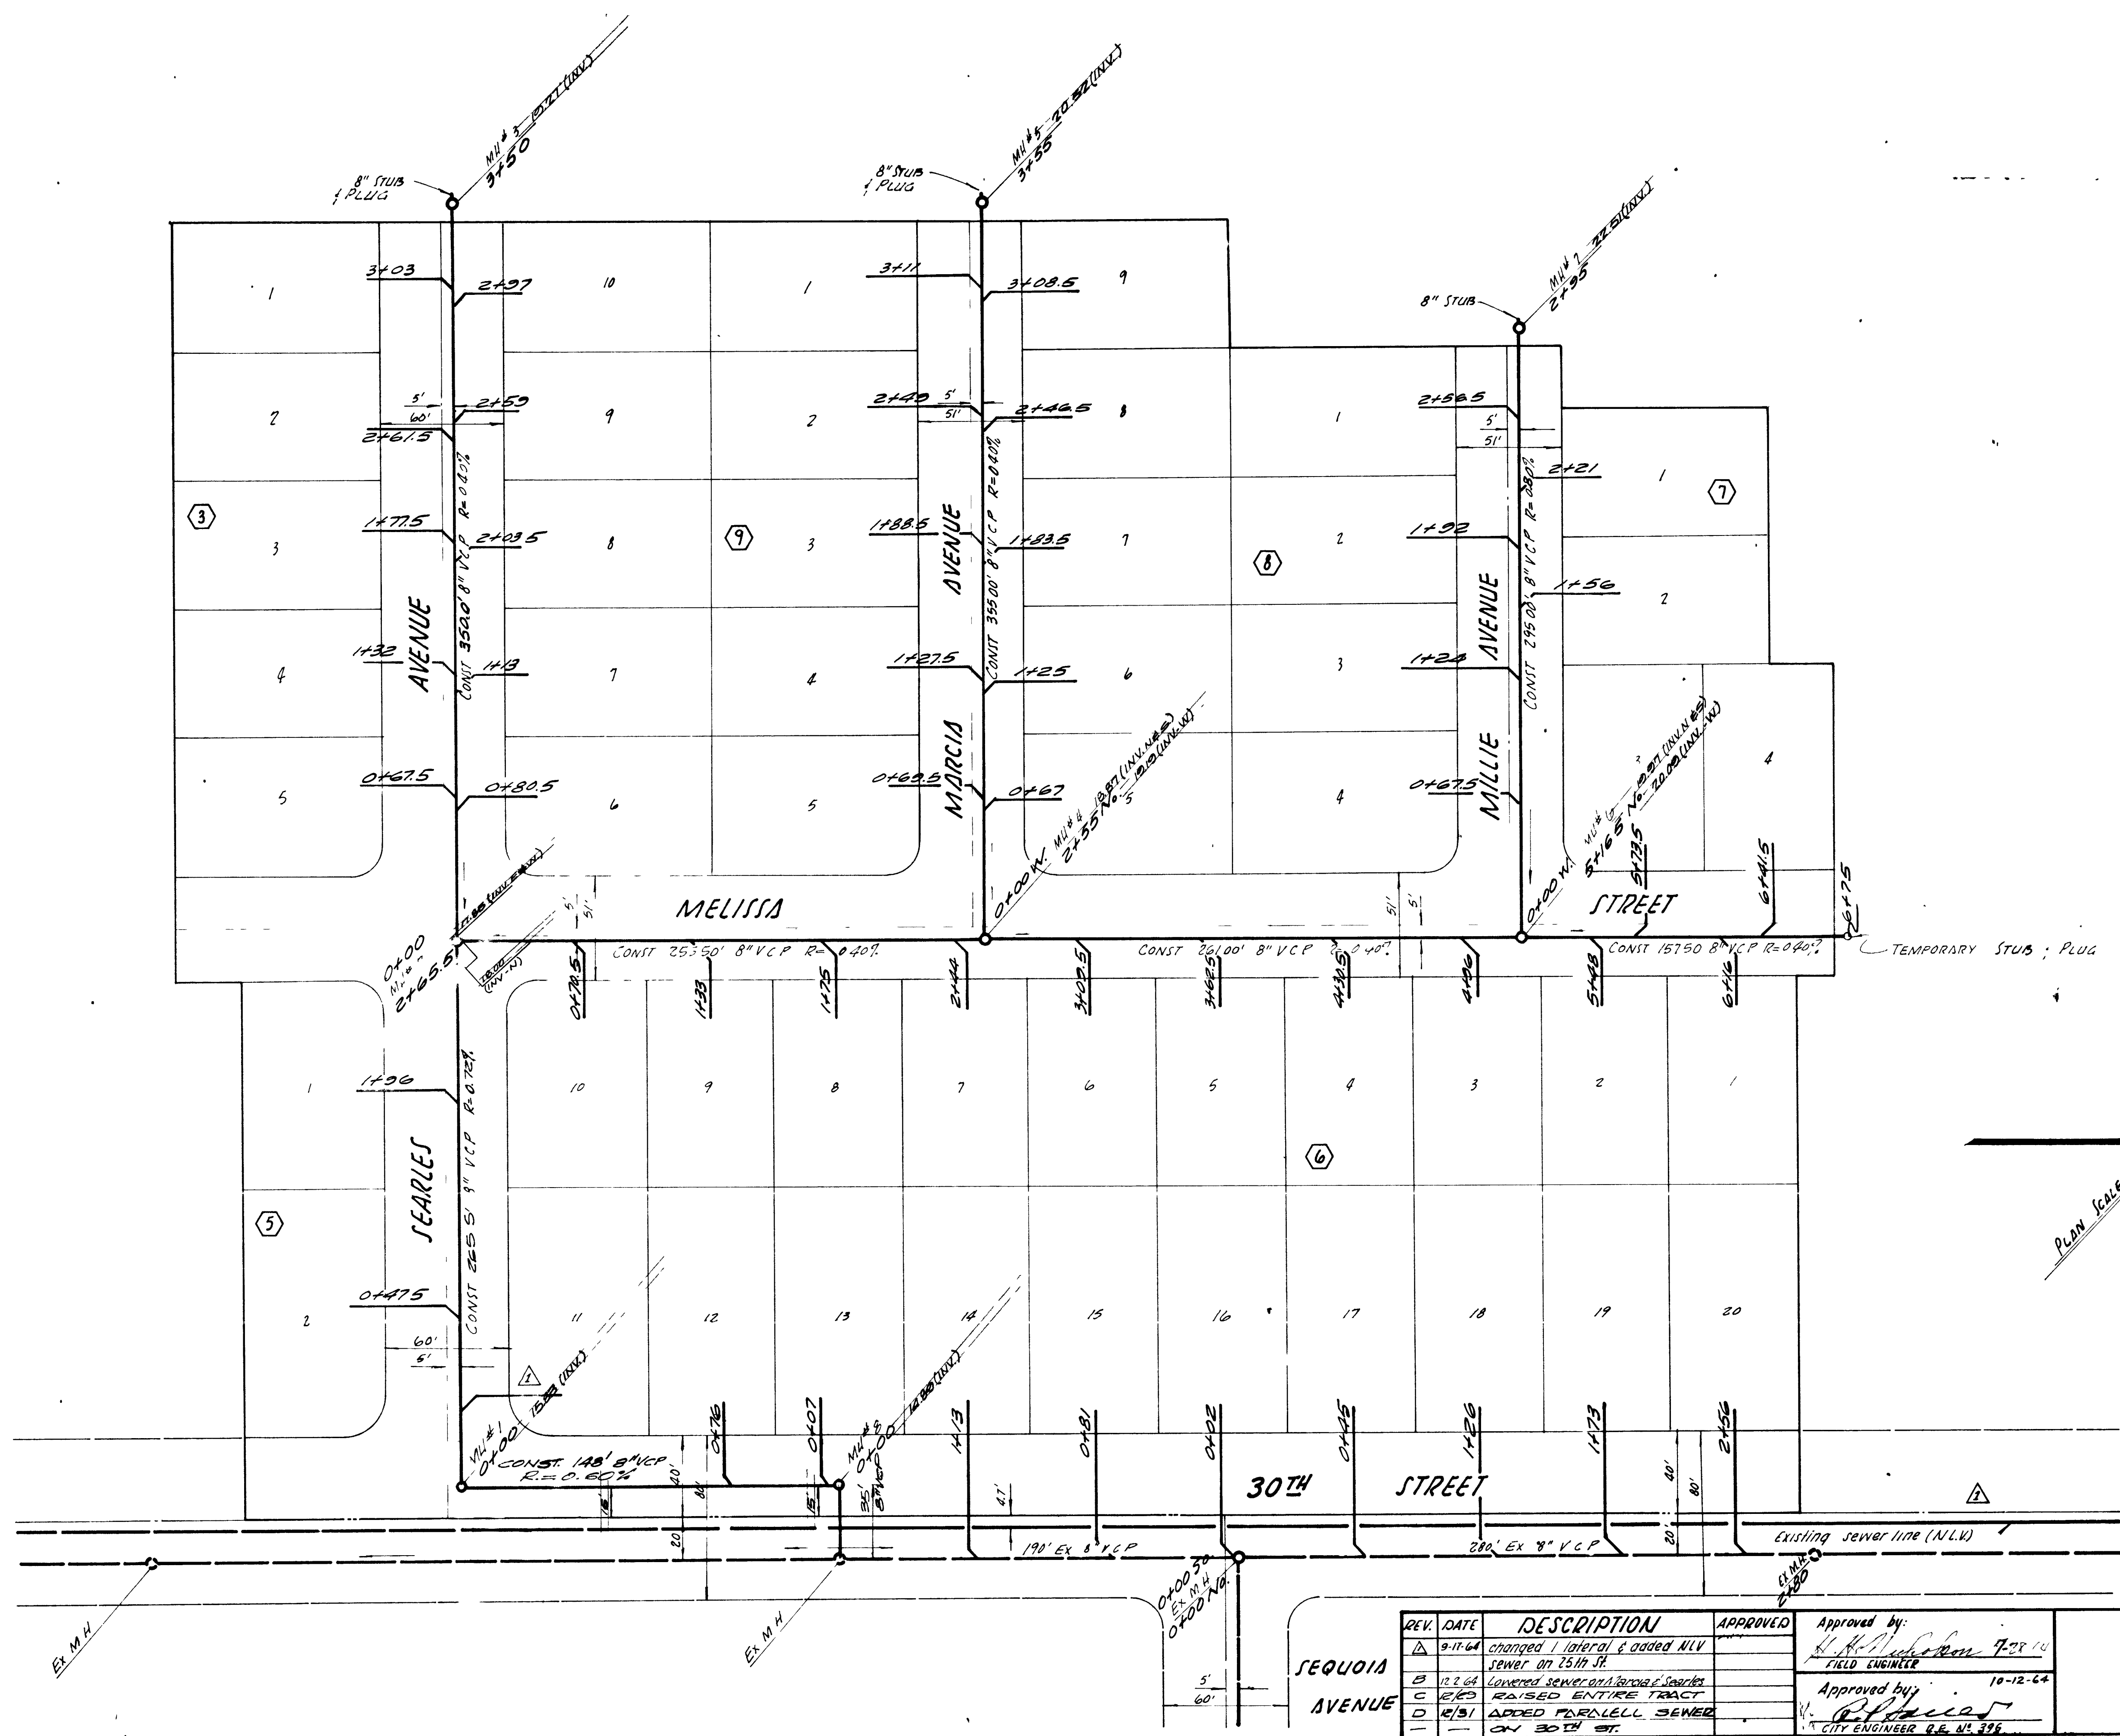

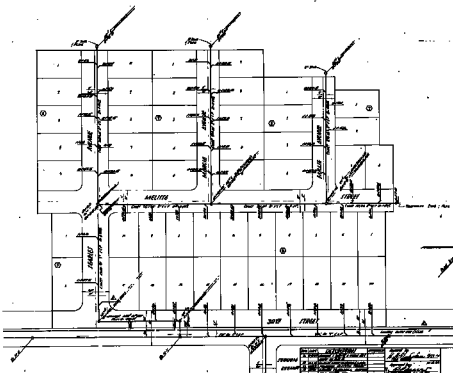

See Schedule 2 for details of building area plan
Building area

REVISION	DATE	BY	APP'D
1	10/1/71	10/1/71	10/1/71
2	10/1/71	10/1/71	10/1/71
3	10/1/71	10/1/71	10/1/71
4	10/1/71	10/1/71	10/1/71
5	10/1/71	10/1/71	10/1/71
6	10/1/71	10/1/71	10/1/71
7	10/1/71	10/1/71	10/1/71
8	10/1/71	10/1/71	10/1/71
9	10/1/71	10/1/71	10/1/71
10	10/1/71	10/1/71	10/1/71

AS-BUILT

Approved by: 10/1/71 10/1/71

Approved by: 10/1/71 10/1/71

Issued by: 10/1/71 10/1/71

**COLLINS PARK 29
AS-BUILT
TUNNEL PLAN**

Part 1
1

10/1/71-21