


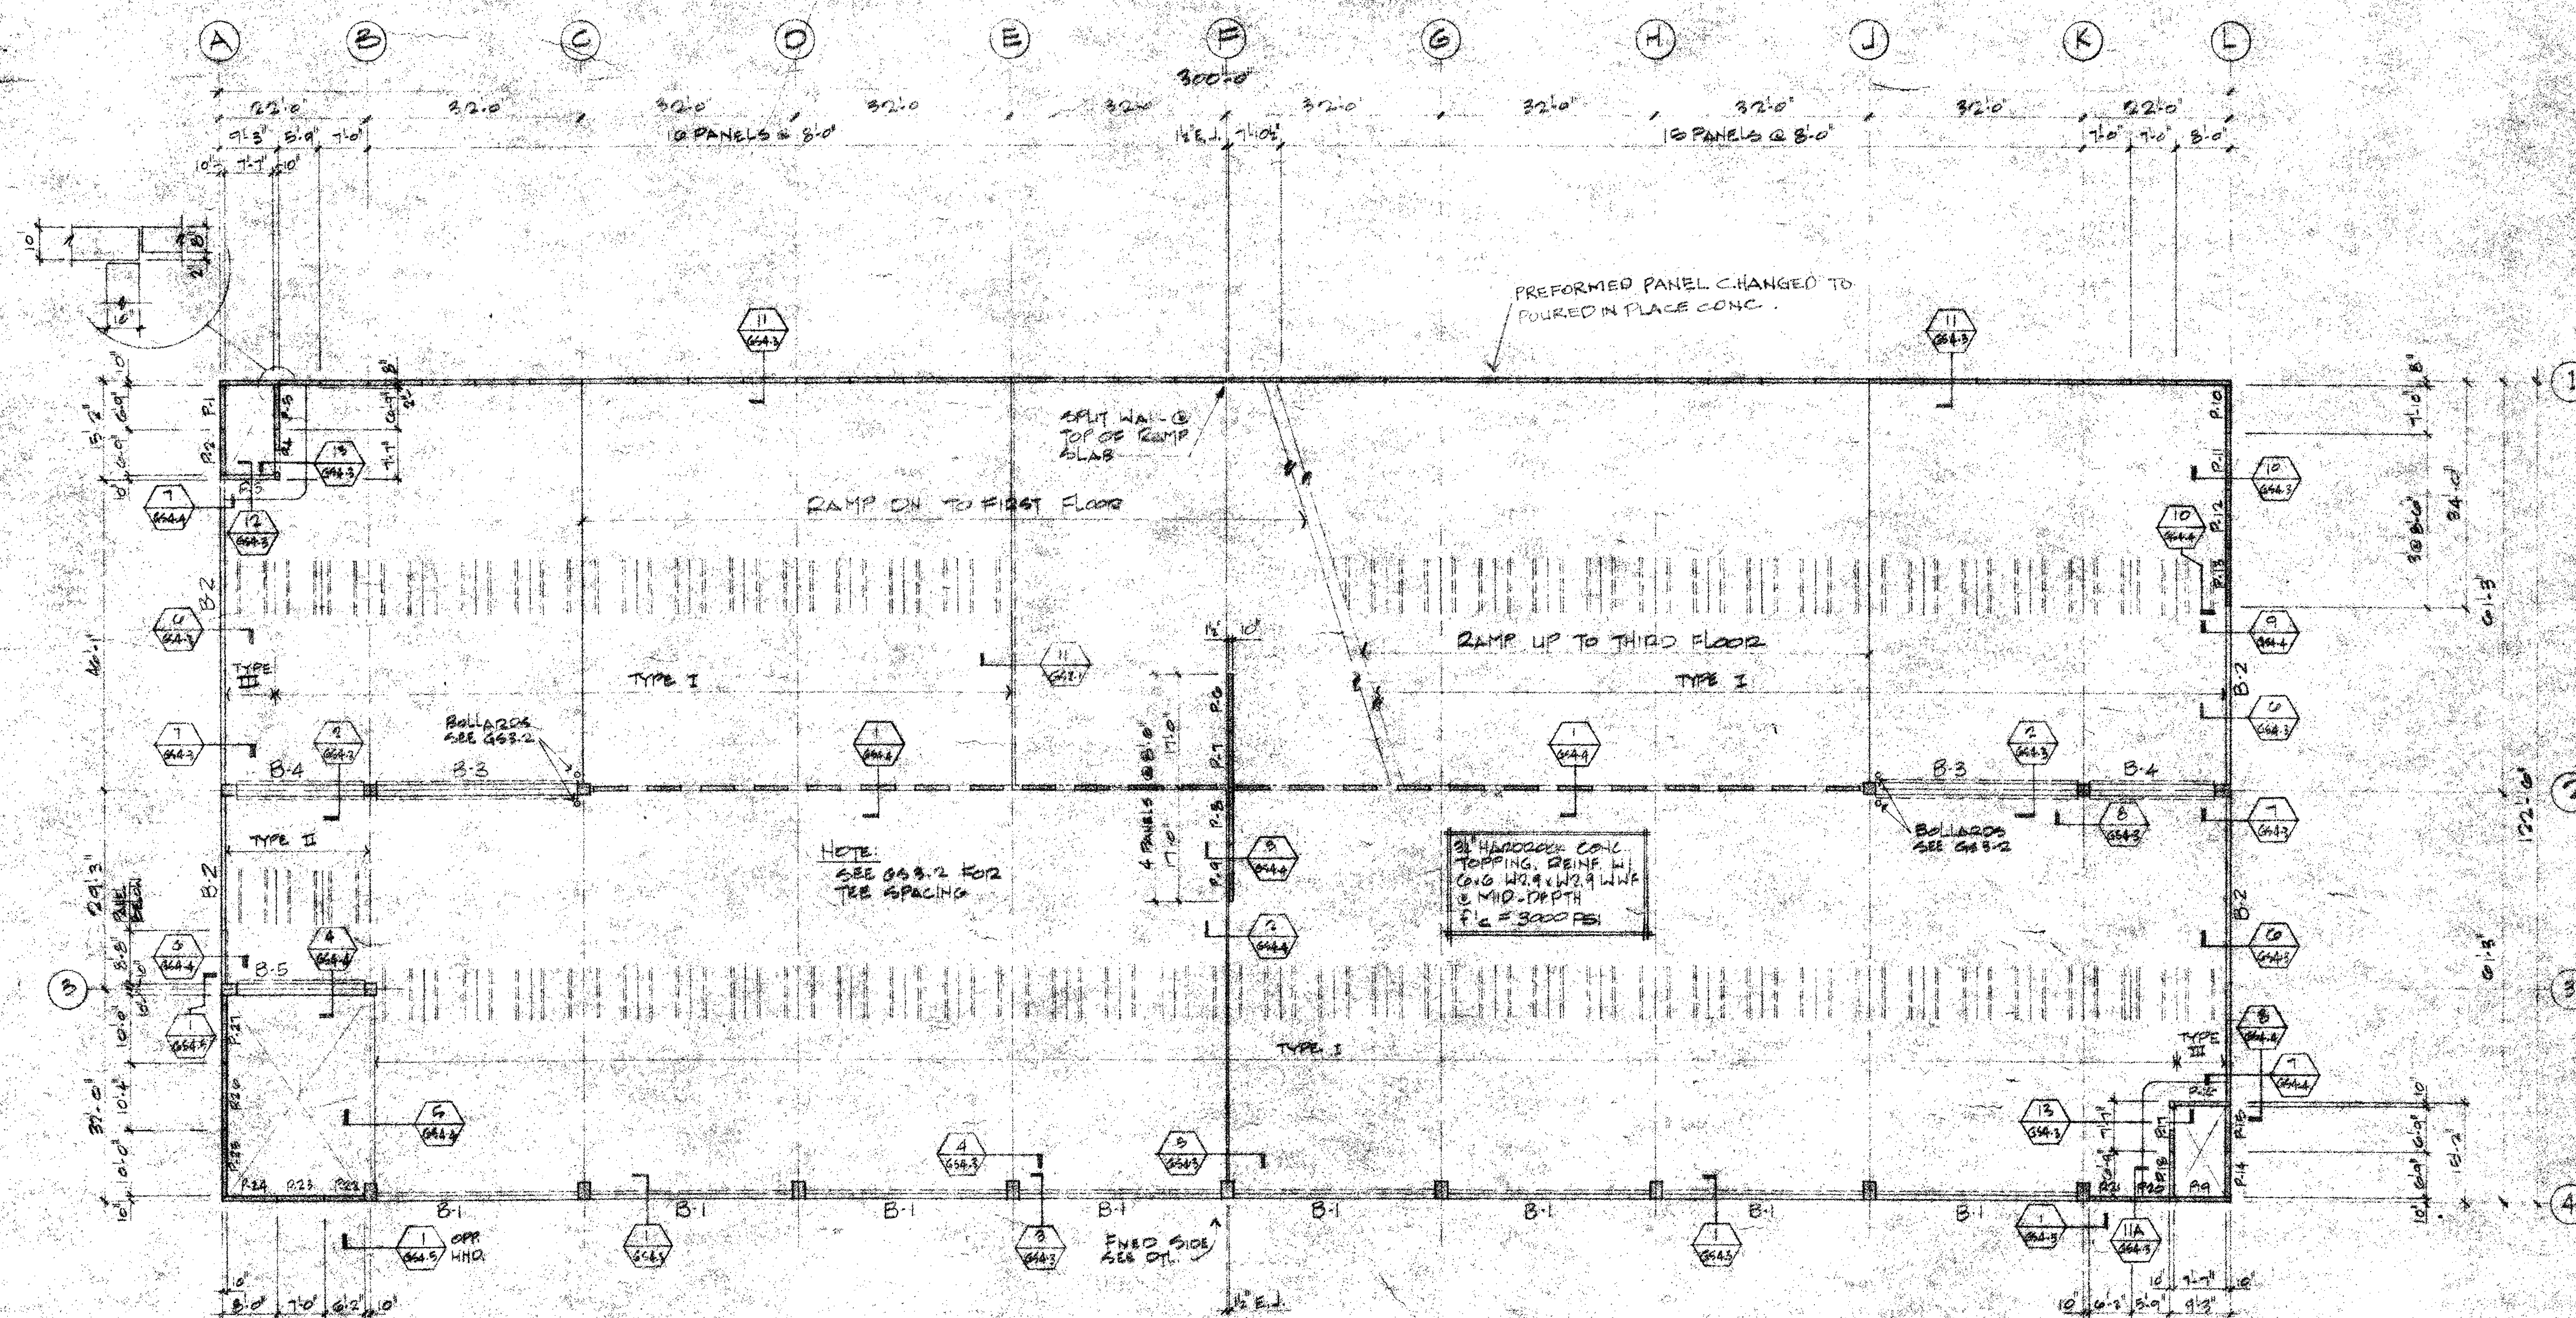


SECOND FLOOR FRAMING PLAN
 1/8" = 1'-0" PH. FLR. 9450

333 RANCHO ROAD
 LAS VEGAS, NEVADA
 MEL POWERS INVESTMENT BUILDER

PROJECT NUMBER

79-24

DATE

5-1-80

SHEET

653-1

OF 13

AS BUILT