
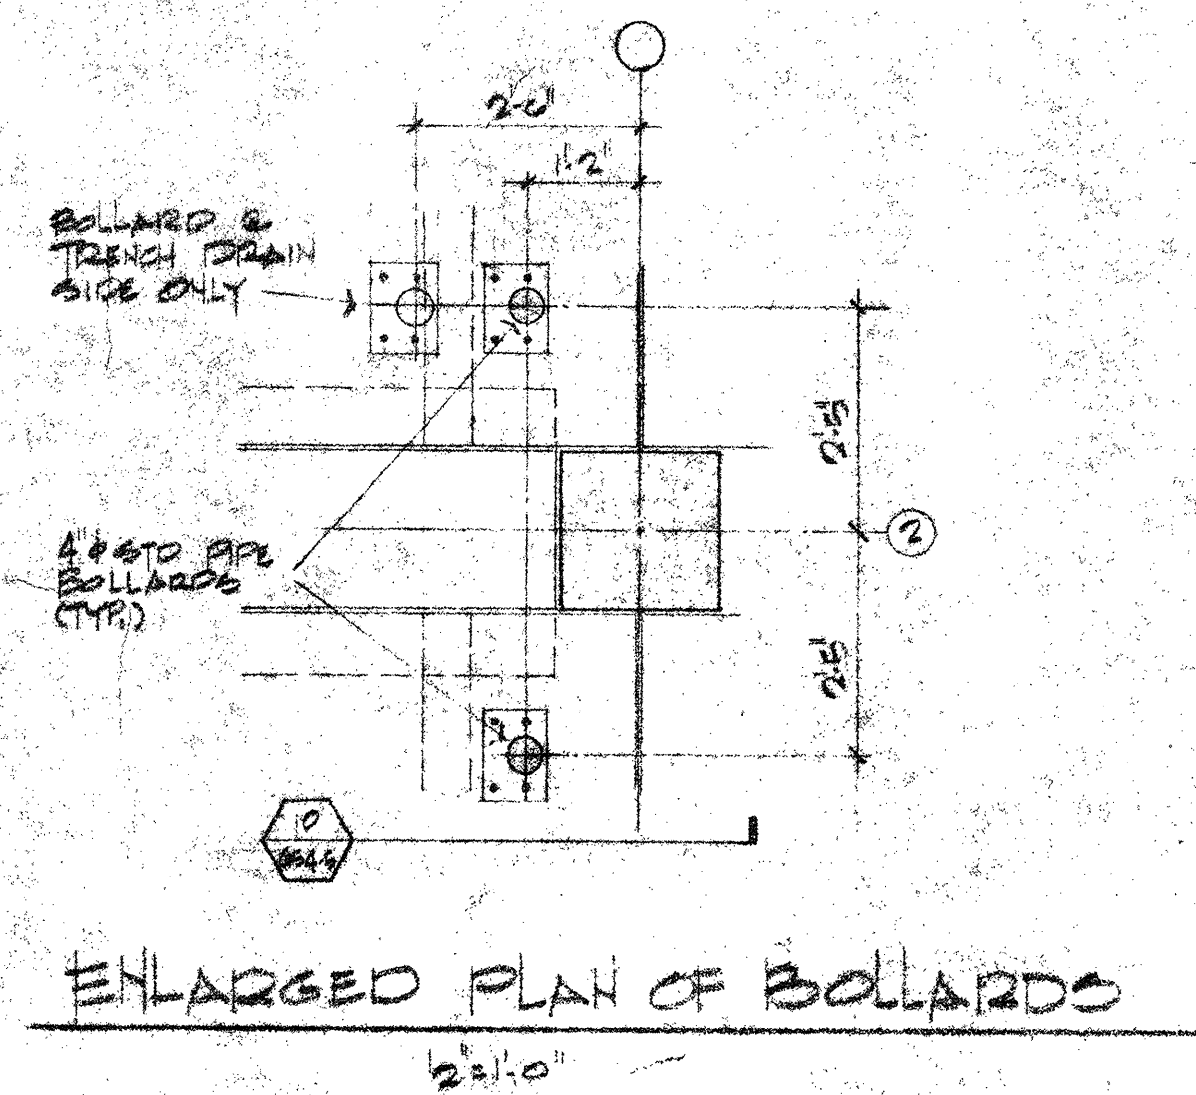


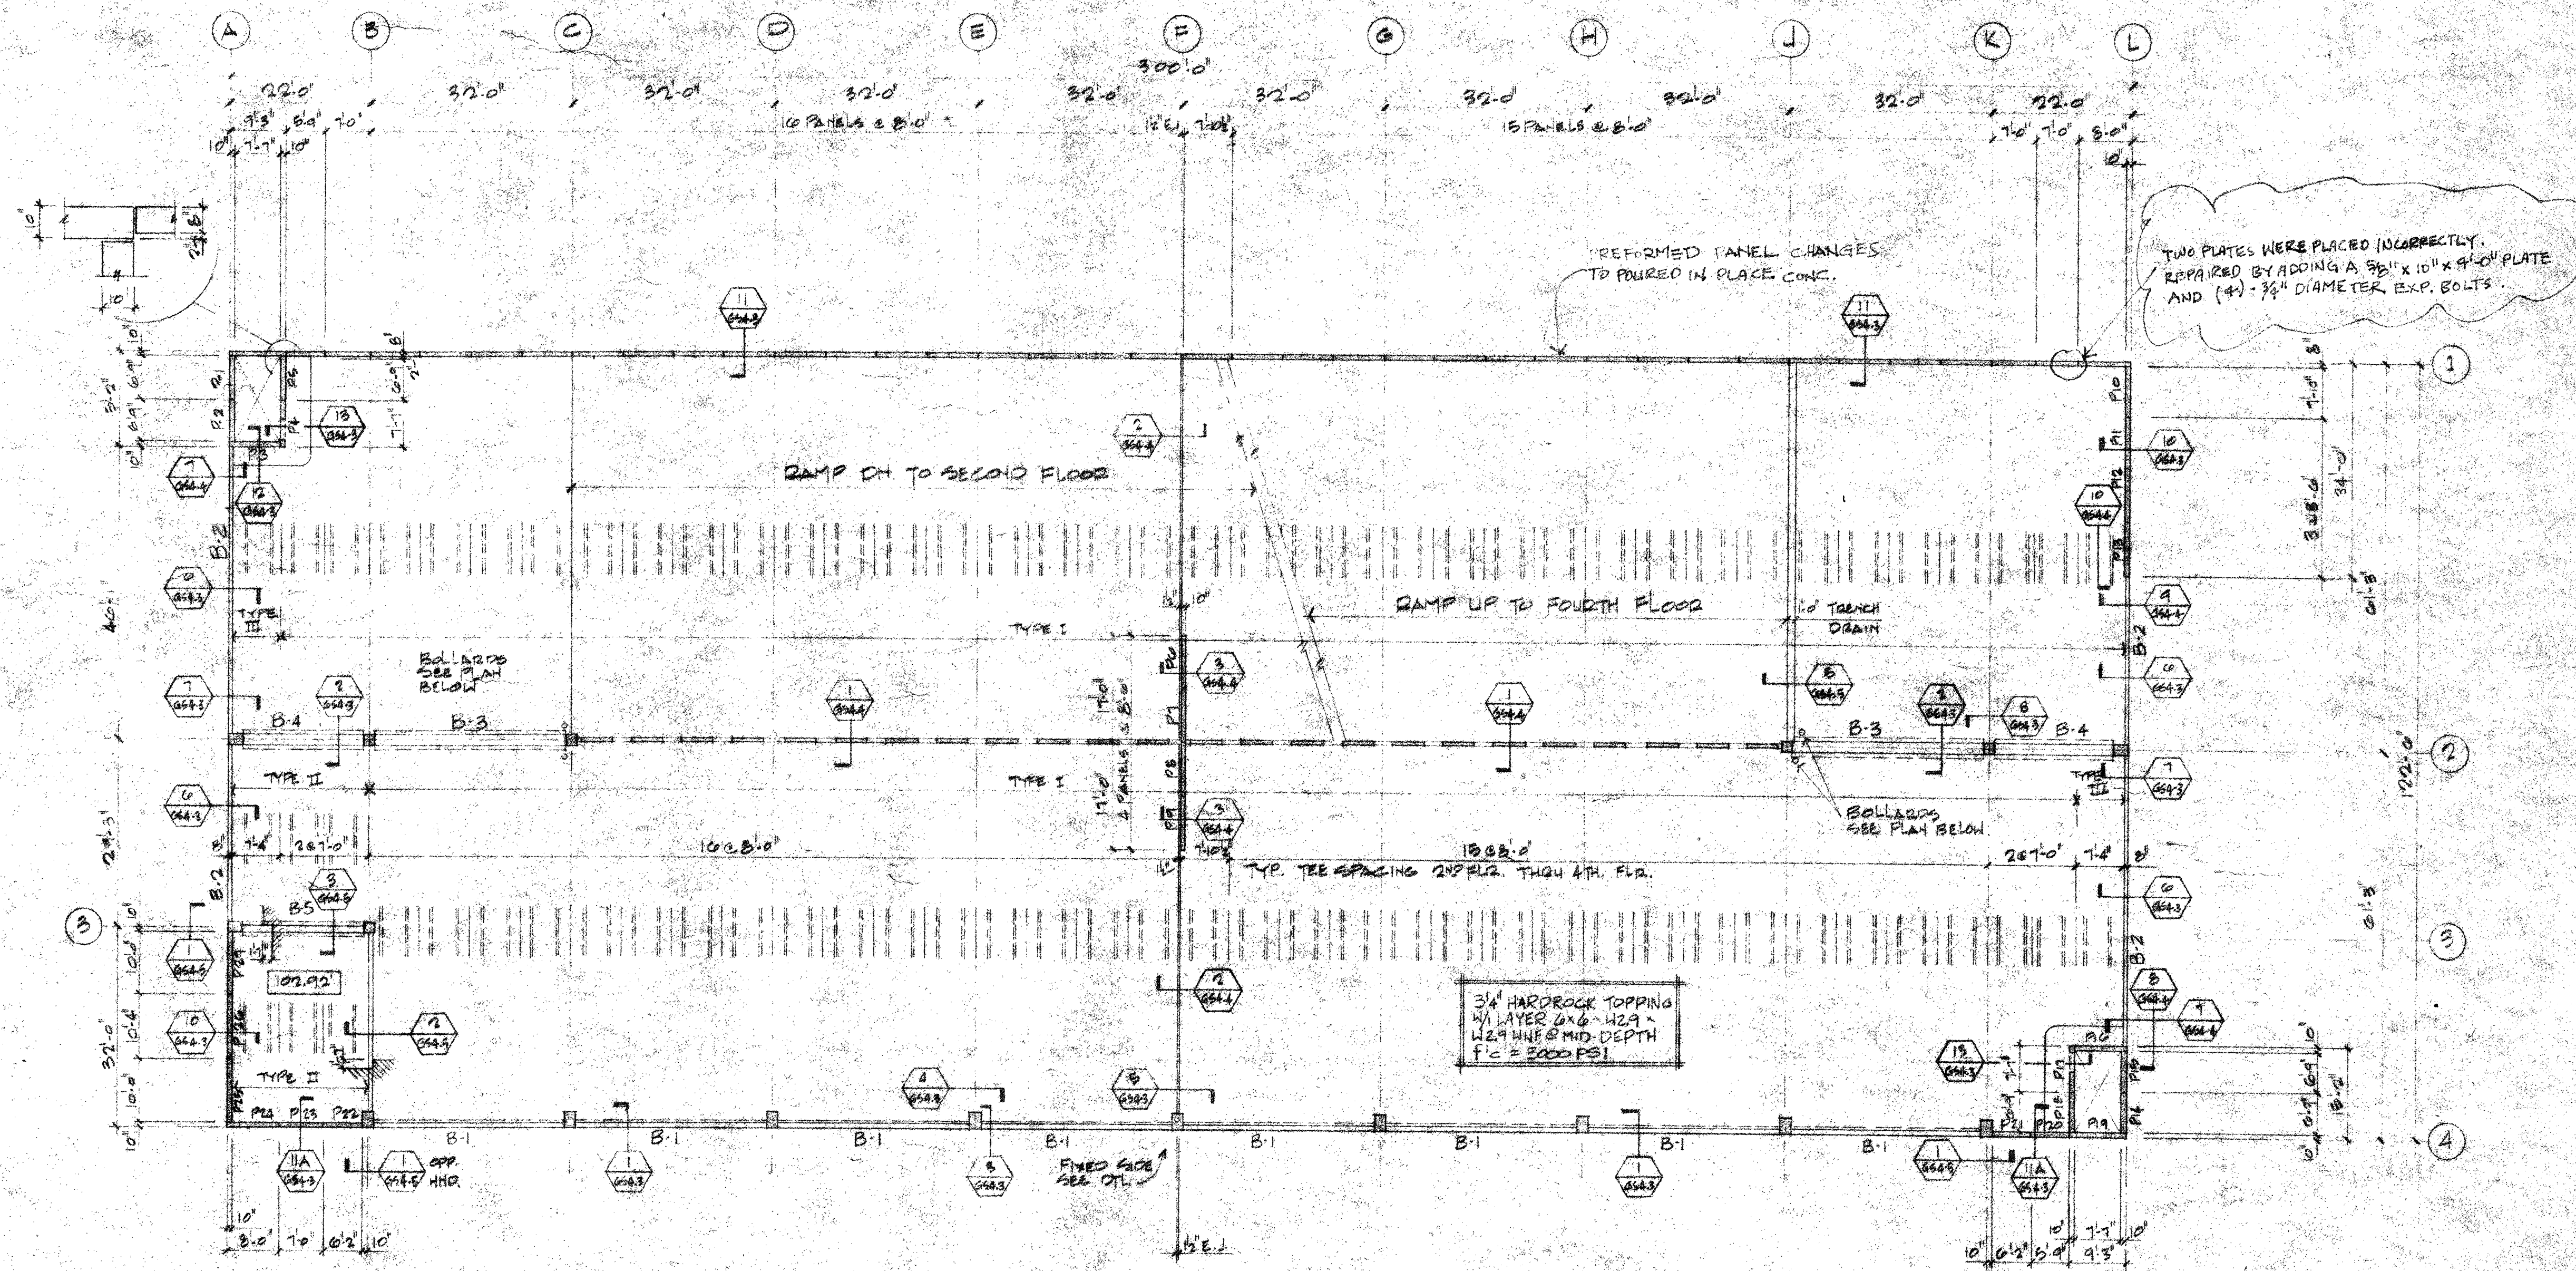

333 RANCHO ROAD
 LAS VEGAS, NEVADA
 MRL POWERS INVESTMENT BUILDER

PROJECT NUMBER
 79-24
 DATE
 5-1-80

SHEET
 653-2
 OF 13

AS BUILT