


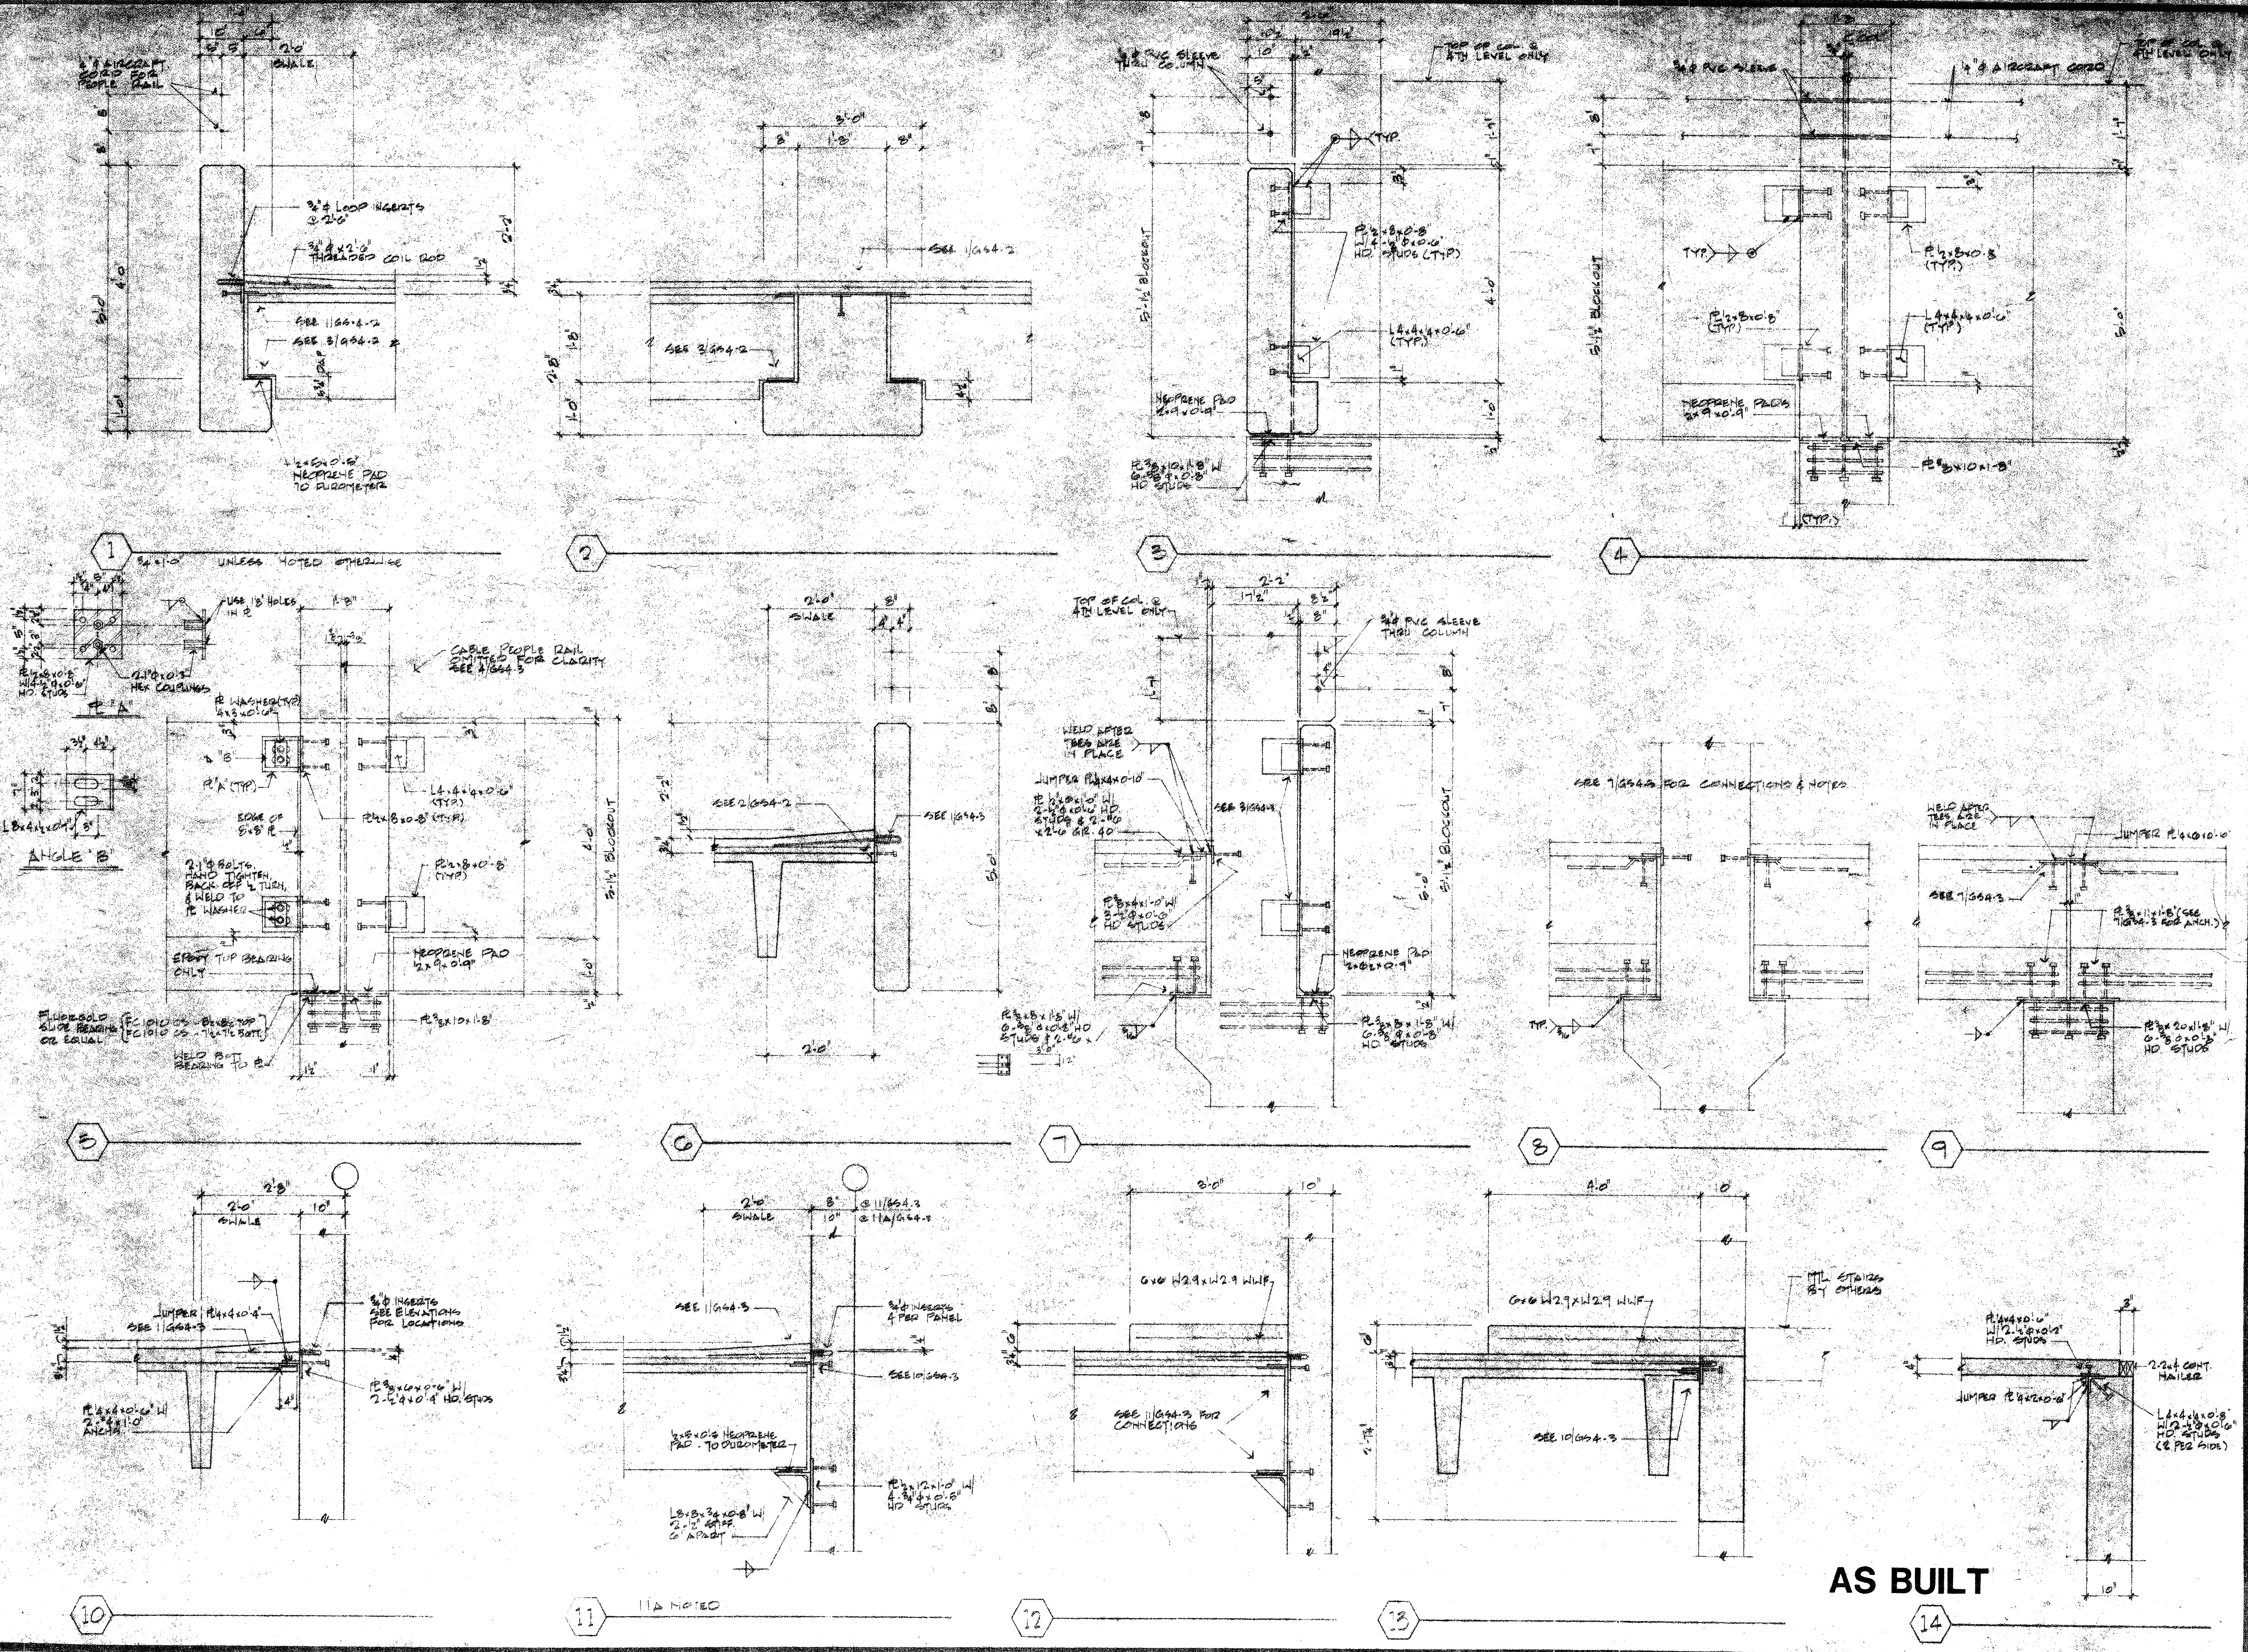

333 RANCHO ROAD
 LAS VEGAS, NEVADA
 MEL POWERS INVESTMENT BUILDER

PROJECT NUMBER
 79.24
 DATE
 5-1-80

SHEET
 G54.3
 OF 13

AS BUILT