


| SEWER LATERAL LOCATION | | | | |
|------------------------|---------------|-------------|---------------|-------------|
| LOT # | END | | "Y" | |
| 1 | N 26763164.52 | E 720925.14 | N 26763160.64 | E 720944.43 |
| 2 | N 26763224.71 | E 720936.00 | N 26763219.15 | E 720958.21 |
| 3 | N 26763323.09 | E 720969.48 | N 26763320.22 | E 720982.14 |
| 4 | N 26763384.60 | E 720976.79 | N 26763379.76 | E 720996.01 |
| 5 | N 26763422.67 | E 720999.79 | N 26763402.65 | E 721008.88 |
| 6 | N 26763425.60 | E 721052.03 | N 26763399.56 | E 721048.30 |
| 7 | N 26763421.96 | E 721071.78 | N 26763397.77 | E 721068.59 |
| 8 | N 26763405.60 | E 720925.14 | N 26763160.64 | E 720944.43 |
| 9 | N 26763398.80 | E 721253.96 | N 26763382.10 | E 721252.29 |
| 10 | N 26763395.57 | E 721329.21 | N 26763375.67 | E 721327.95 |
| 11 | N 26763394.28 | E 721399.24 | N 26763378.12 | E 721399.32 |
| 12 | N 26763396.88 | E 721469.26 | N 26763382.70 | E 721468.81 |
| 13 | N 26763401.09 | E 721539.75 | N 26763387.04 | E 721540.10 |
| 14 | N 26763408.47 | E 721609.76 | N 26763391.45 | E 721610.91 |
| 15 | N 26763419.03 | E 721667.27 | N 26763387.59 | E 721664.76 |
| 16 | N 26763417.22 | E 721703.52 | N 26763376.93 | E 721684.97 |
| 17 | N 26763410.26 | E 721720.98 | N 26763367.36 | E 721703.71 |
| 18 | N 26763378.09 | E 721743.96 | N 26763359.58 | E 721719.23 |
| 19 | N 26763284.34 | E 721736.67 | N 26763285.49 | E 721718.64 |
| 20 | N 26763221.19 | E 721735.00 | N 26763224.64 | E 721712.19 |
| 21 | N 26763156.08 | E 721726.37 | N 26763158.96 | E 721705.08 |
| 22 | N 26763100.90 | E 721719.26 | N 26763104.42 | E 721699.79 |
| 23 | N 26763004.87 | E 721702.96 | N 26763006.37 | E 721688.91 |
| 24 | N 26762938.42 | E 721692.24 | N 26762939.59 | E 721681.19 |
| 25 | N 26762870.81 | E 721689.63 | N 26762873.74 | E 721673.46 |
| 26 | N 26762832.11 | E 721660.31 | N 26762856.67 | E 721649.62 |
| 27 | N 26762822.23 | E 721608.16 | N 26762838.67 | E 721604.40 |
| 28 | N 26762800.40 | E 721527.95 | N 26762819.30 | E 721523.70 |
| 29 | N 26762788.64 | E 721466.48 | N 26762809.71 | E 721462.94 |
| 30 | N 26762778.29 | E 721399.24 | N 26762799.84 | E 721395.22 |
| 31 | N 26762770.17 | E 721331.65 | N 26762789.46 | E 721328.00 |
| 32 | N 26762761.61 | E 721265.46 | N 26762779.67 | E 721262.92 |
| 33 | N 26762754.44 | E 721197.70 | N 26762769.83 | E 721195.71 |
| 34 | N 26762744.95 | E 721123.39 | N 26762758.82 | E 721121.56 |
| 35 | N 26762735.91 | E 721062.01 | N 26762751.90 | E 721059.96 |
| 36 | N 26762728.36 | E 720990.75 | N 26762743.92 | E 720988.70 |
| 37 | N 26762721.05 | E 720925.31 | N 26762735.95 | E 720922.98 |
| 38 | N 26762724.69 | E 720847.15 | N 26762745.59 | E 720870.71 |
| 39 | N 26762737.32 | E 720834.28 | N 26762757.94 | E 720862.89 |
| 40 | N 26762780.74 | E 720828.76 | N 26762775.25 | E 720852.31 |
| 41 | N 26762850.62 | E 720853.48 | N 26762847.08 | E 720866.04 |
| 42 | N 26762915.87 | E 720867.32 | N 26762911.72 | E 720883.90 |
| 43 | N 26762986.60 | E 720886.13 | N 26762981.99 | E 720902.40 |
| 44 | N 26763130.11 | E 720971.93 | N 26763135.93 | E 720939.76 |
| 45 | N 26763236.47 | E 720992.52 | N 26763242.95 | E 720965.06 |
| 46 | N 26763256.79 | E 720996.51 | N 26763263.17 | E 720969.96 |
| 47 | N 26763353.80 | E 721029.92 | N 26763362.56 | E 720993.42 |
| 48 | N 26763358.03 | E 721193.59 | N 26763385.38 | E 721194.68 |
| 49 | N 26763348.79 | E 721262.63 | N 26763379.42 | E 721264.07 |
| 50 | N 26763346.93 | E 721332.50 | N 26763373.50 | E 721334.28 |
| 51 | N 26763344.28 | E 721400.46 | N 26763375.89 | E 721396.47 |
| 52 | N 26763346.56 | E 721469.04 | N 26763380.47 | E 721464.84 |
| 53 | N 26763349.68 | E 721536.56 | N 26763384.78 | E 721533.68 |
| 54 | N 26763355.20 | E 721602.43 | N 26763389.29 | E 721600.45 |
| 55 | N 26763357.64 | E 721675.03 | N 26763377.88 | E 721680.14 |

| SEWER LATERAL LOCATION | | | | |
|------------------------|---------------|-------------|---------------|-------------|
| LOT # | END | | "Y" | |
| 56 | N 26763107.47 | E 721645.65 | N 26763094.62 | E 721645.22 |
| 57 | N 26763114.03 | E 721595.54 | N 26763100.46 | E 721595.27 |
| 58 | N 26763115.96 | E 721525.62 | N 26763103.29 | E 721524.93 |
| 59 | N 26763116.38 | E 721456.67 | N 26763103.92 | E 721456.56 |
| 60 | N 26763116.38 | E 721386.88 | N 26763104.45 | E 721386.63 |
| 61 | N 26763117.48 | E 721315.52 | N 26763105.31 | E 721315.00 |
| 62 | N 26763122.18 | E 721240.20 | N 26763105.98 | E 721239.35 |
| 63 | N 26763126.89 | E 721172.21 | N 26763106.84 | E 721171.07 |
| 64 | N 26763036.53 | E 721153.58 | N 26763105.31 | E 721159.52 |
| 65 | N 26763073.07 | E 721224.63 | N 26763104.56 | E 721224.82 |
| 66 | N 26763068.53 | E 721294.66 | N 26763103.86 | E 721295.20 |
| 67 | N 26763066.68 | E 721366.11 | N 26763103.16 | E 721364.66 |
| 68 | N 26763065.96 | E 721437.33 | N 26763102.55 | E 721437.29 |
| 69 | N 26763065.42 | E 721508.55 | N 26763101.72 | E 721508.16 |
| 70 | N 26763033.76 | E 721656.91 | N 26763030.33 | E 721689.94 |
| 71 | N 26762934.33 | E 721641.27 | N 26762928.90 | E 721678.13 |
| 72 | N 26762862.87 | E 721593.97 | N 26762839.85 | E 721602.50 |
| 73 | N 26762836.31 | E 721448.42 | N 26762810.12 | E 721451.36 |
| 74 | N 26762827.43 | E 721374.61 | N 26762799.33 | E 721377.45 |
| 75 | N 26762818.42 | E 721302.15 | N 26762788.01 | E 721305.39 |
| 76 | N 26762809.57 | E 721229.62 | N 26762777.53 | E 721232.49 |
| 77 | N 26762800.98 | E 721157.60 | N 26762766.42 | E 721160.20 |
| 78 | N 26762792.43 | E 721084.74 | N 26762756.86 | E 721087.14 |
| 79 | N 26762810.23 | E 720895.39 | N 26762817.80 | E 720859.66 |
| 80 | N 26762877.17 | E 720909.95 | N 26762884.88 | E 720877.98 |
| 81 | N 26762947.21 | E 720925.65 | N 26762954.24 | E 720897.14 |

NOTE:
SEWER LATERAL LOCATIONS SHOWN HEREIN ARE DESIGN COORDINATES
AND WERE DERIVED FROM DRAWING C4B, SHEET 4B OF 31 SHEETS OF
PLAN SET SUMMERLIN VILLAGE 23A PARCEL L AND ALLUSIA, BY G.C.
WALLACE COMPANIES, PROJECT NO. 62023-980, DATED 11-21-11. SAID
COORDINATES WERE NOT ESTABLISHED BY J.S. & S. INC. AND THEREFOR
CAN NOT BE CERTIFIED FOR ACCURACY.

| | |
|------------|--------------------|
| DATE | |
| SCALE (H) | 1" = 40' |
| SCALE (V) | |
| DRAWN BY | RPS |
| CHECKED BY | |
| SEC. 34 | T. 20 S., R. 69 E. |

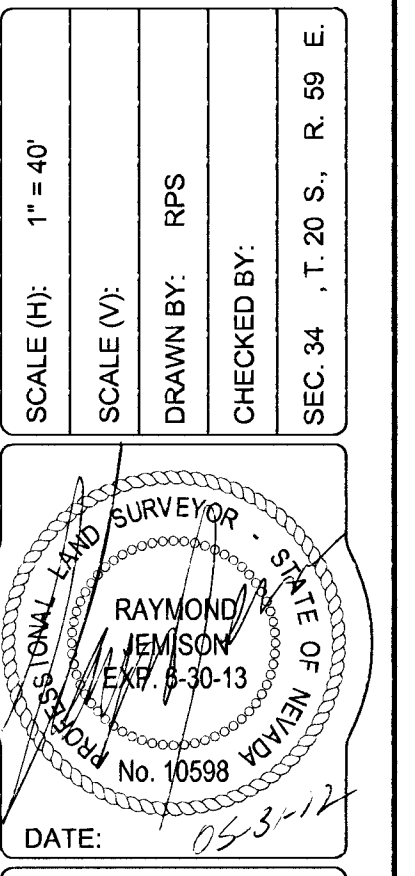

JEMISON SURVEYING & SERVICES
2680 CRIMSON CANYON DRIVE
LAS VEGAS, NEVADA, 89128
702-360-4838 F. 702-360-4839

JEMISON SURVEYING & SERVICES

JOB TITLE: VILLAGE 23A - PARCEL "L" UTILITY EXHIBIT
CLARK COUNTY, NEVADA

DATE: 05-31-2012

JOB NO.:

SHEET 2 OF 2

AS-BUILTS