

# CITY OF LAS VEGAS

MAYOR

RON LURIE



CITY COUNCIL

BOB NOLEN

STEVE MILLER

W. WAYNE BUNKER

ARNIE ADAMSEN

BUILDING "B"

CITY YARDS FACILITIES

BONANZA ROAD AND MOJAVE ROAD


LAS VEGAS NEVADA

PROJECT NUMBER : 880307.3

DEPARTMENT OF GENERAL SERVICES

## Index to Drawings

|     |                           |
|-----|---------------------------|
| T-1 | TITLE SHEET               |
| A-1 | NEW & EXISTING ROOF PLANS |
| A-2 | MISCELLANEOUS DETAILS     |

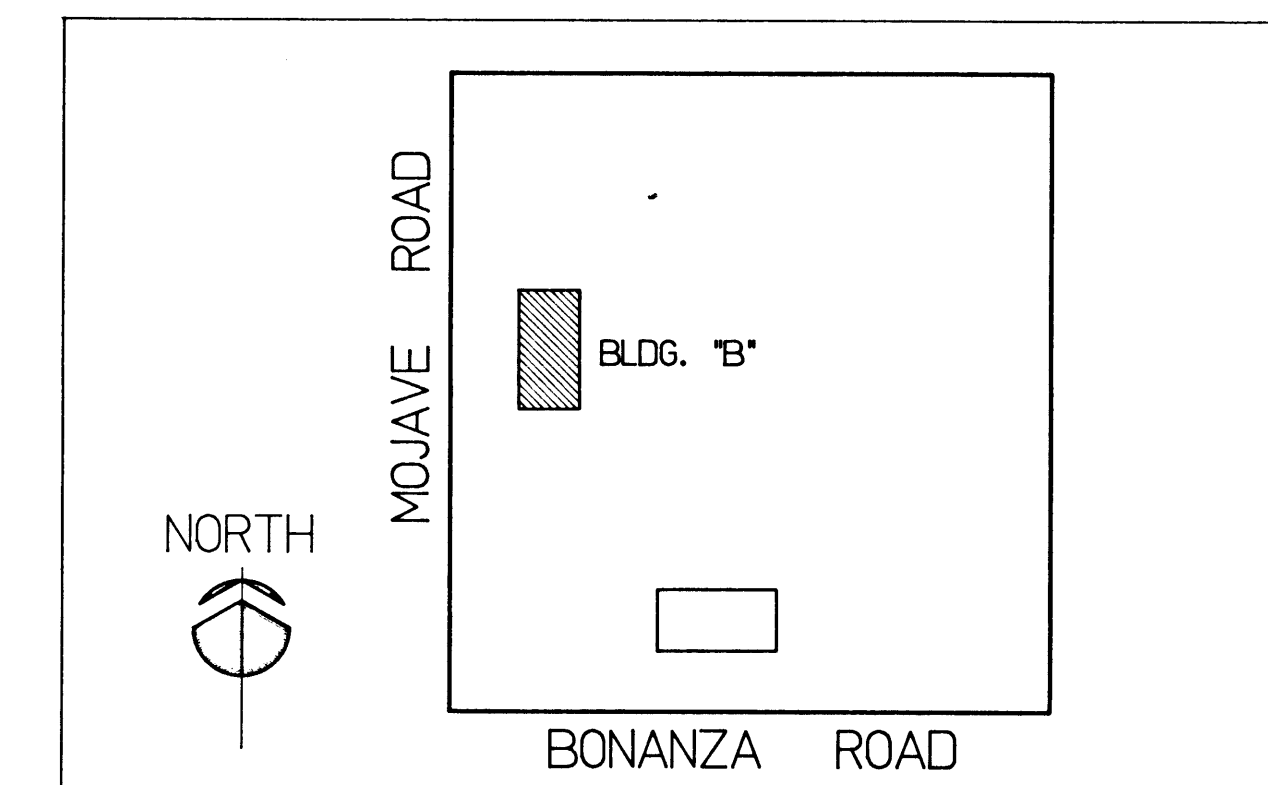

KEY PLAN


## Basis of Design

Code Use: 1985 UBC

Occupancy: N/A

Occupancy Load: N/A

Construction: N/A

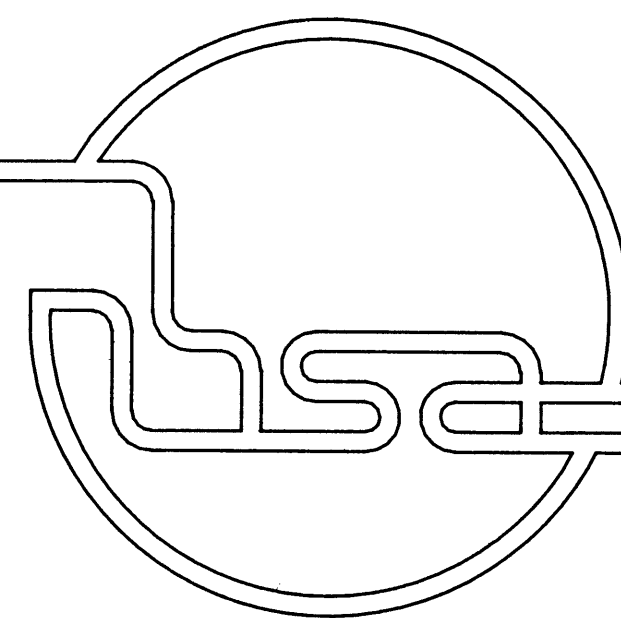


Harris Sharp Associates Incorporated

Architecture, Planning, Interiors

4800 West Charleston Boulevard Las Vegas, Nevada 89102 (702) 877-0125

## Vicinity Map

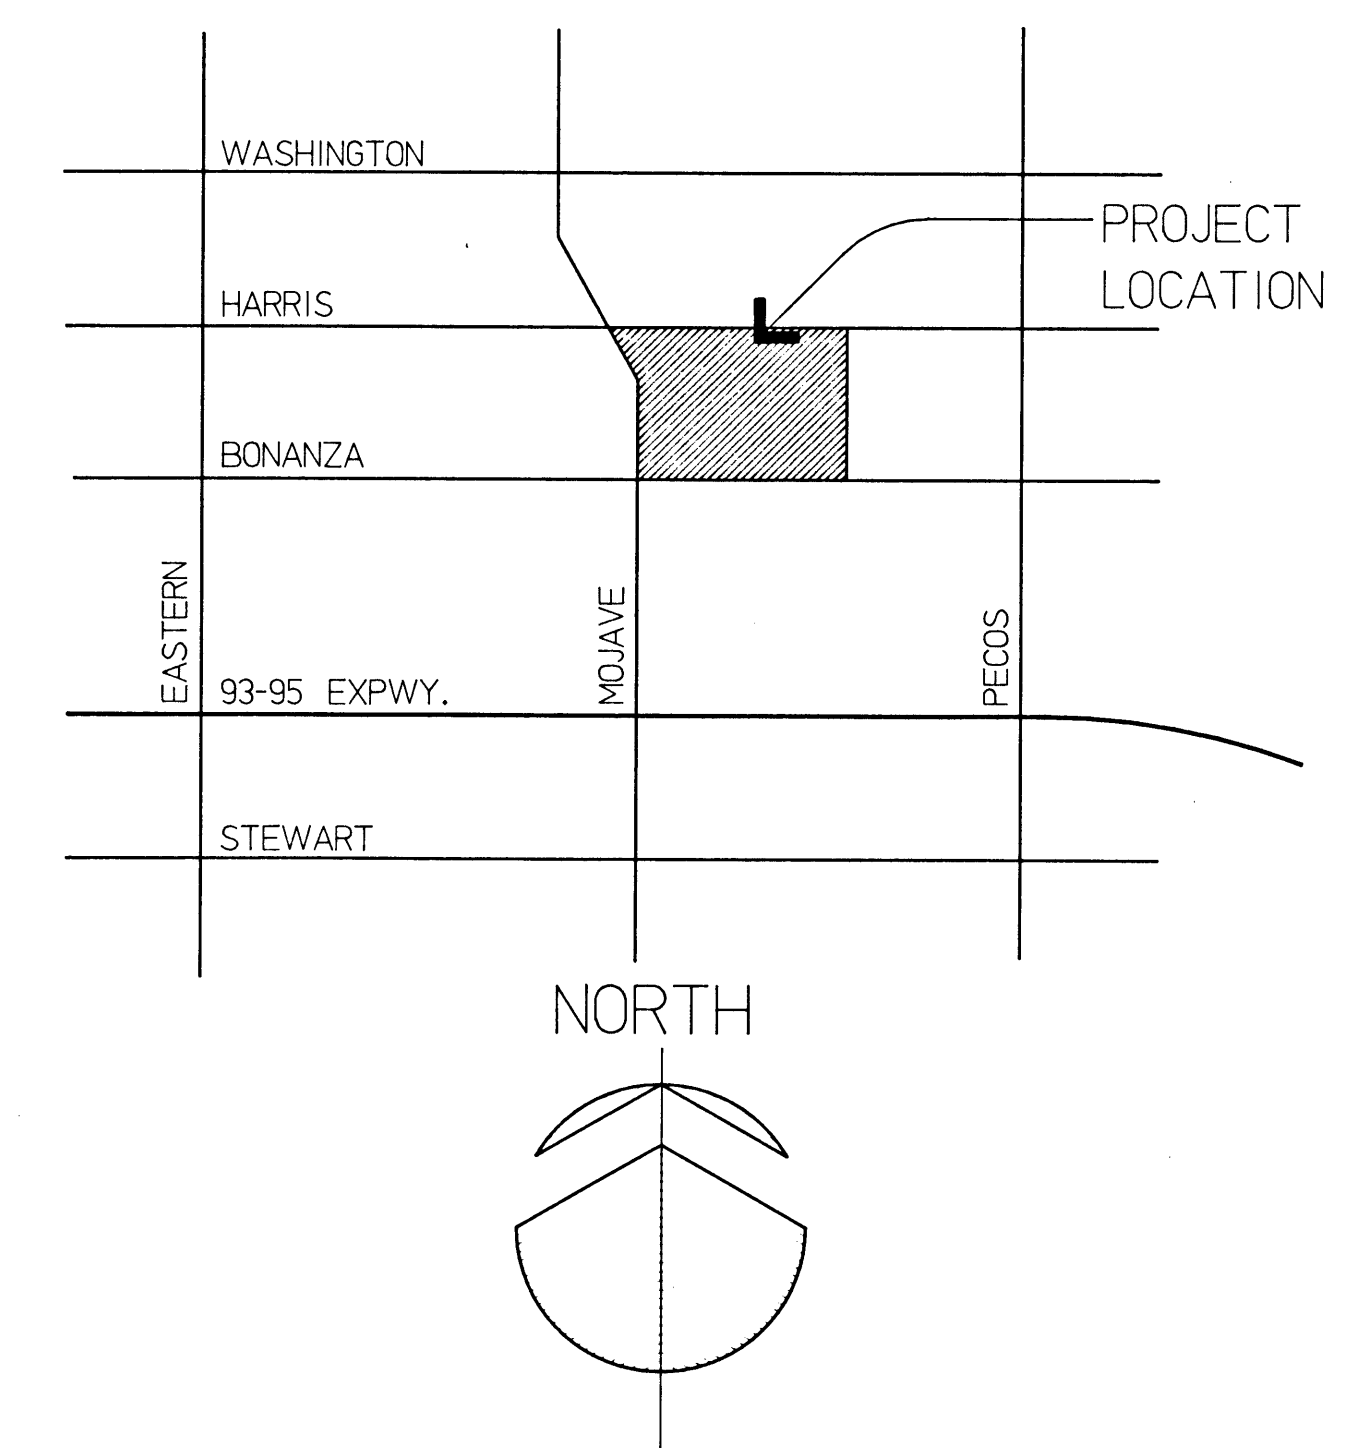

Architect

Set

RECORD DRAWING