


REVISIONS		
NO.	DESCRIPTION	DATE
1	REV. PER. H.H.P. COMMENTS	3-14-91
2	REV. PER. H.H.P. & S.L.V. COMMENTS	4-16-91 RP

CROSS SECTIONS
 BUREAU DRIVE
 SCALE HOR. 1"=20' VERT. 1"=4'
 SHEET N.
 80

1963

95-2-85 107-11877

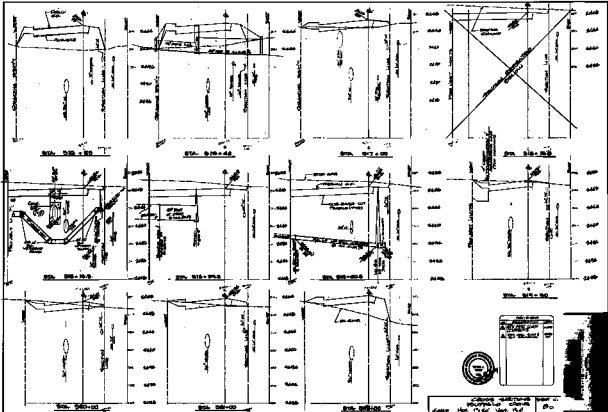

DATE	BY

Check against
 original plans
 Date 1/1/57

