

QUANTITIES

ITEM	S.A.D.	R.S.H.	C.L.V.	UNIT
1. EXCAVATION (UNCLASSIFIED)	143	3230		CY
2. TYPE I BASE AGGREGATE	88	1772		CY
3. TYPE II BASE AGGREGATE	58	560		CY
4. 1" A.C. PAVING (TRAFFIC ISLAND)		NONE		SF
5. 1" OVERLAY		NONE		SF
6. 1" A.C. PAVING (MEDIAN/ISLAND)		130		SF
7. 3" ASPHALTIC CONCRETE		4307		SF
8. FOG SEAL		4307		SF
9. BLOW SAND		43		CY
10. CONC. VALLEY GUTTER	560	580		SF
11. CONC. CURB & GUTTER "TYPE-18"		913		LF
12. CONC. CURB & GUTTER "TYPE-24"	523	361		LF
13. CONC. SIDEWALK	3320	2131		SF
14. CONCRETE MEDIAN ISLAND		1364		SF
17. REMOVE & RESET FIRE HYDRANTS				EA
20. REMOVE TREES		NONE		EA
21. REMOVE & RESET STREET SIGNS				EA
22. ADJUST SANITARY MANHOLES	294	294		EA
15. CONC. DRIVEWAYS				SF
16. CONC. ALLEY GUTTER		3		EA
19. CONC. DRIVEWAY				EA

AS CONSTRUCTED
Note: See C.L.V. Dwg. No. F.S.-168
For Island Changes



CITY OF LAS VEGAS, NEVADA
ENGINEERING DEPARTMENT

PLAN AND PROFILE
25 TH STREET WIDENING PROJECT

DESIGNED BY P.A.F.	DATE 5-3-66	PROJECT NUMBER 65-58
DRAWN BY Q.G.S.	DATE 6-3-66	CONTRACT NUMBER CLV-255
CHECKED BY K.T.S.	DATE 8-1-66	DRAWING NUMBER GLW 19

APPROVED: [Signature]

SHEET No. 4 A

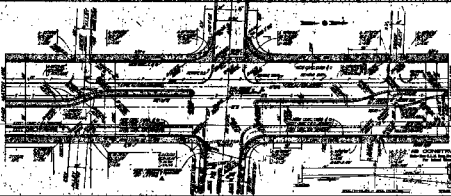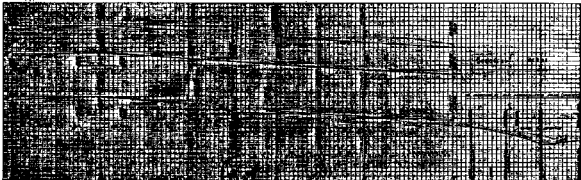

NO.	DESCRIPTION	DATE
1	DESIGNED BY	
2	DRAWN BY	
3	CHECKED BY	
4	APPROVED BY	
5	DATE	

NOT CONSTRUCTED
 DATE

FILED AND PROFILE	
DATE	FILED
BY	BY
AT	AT