

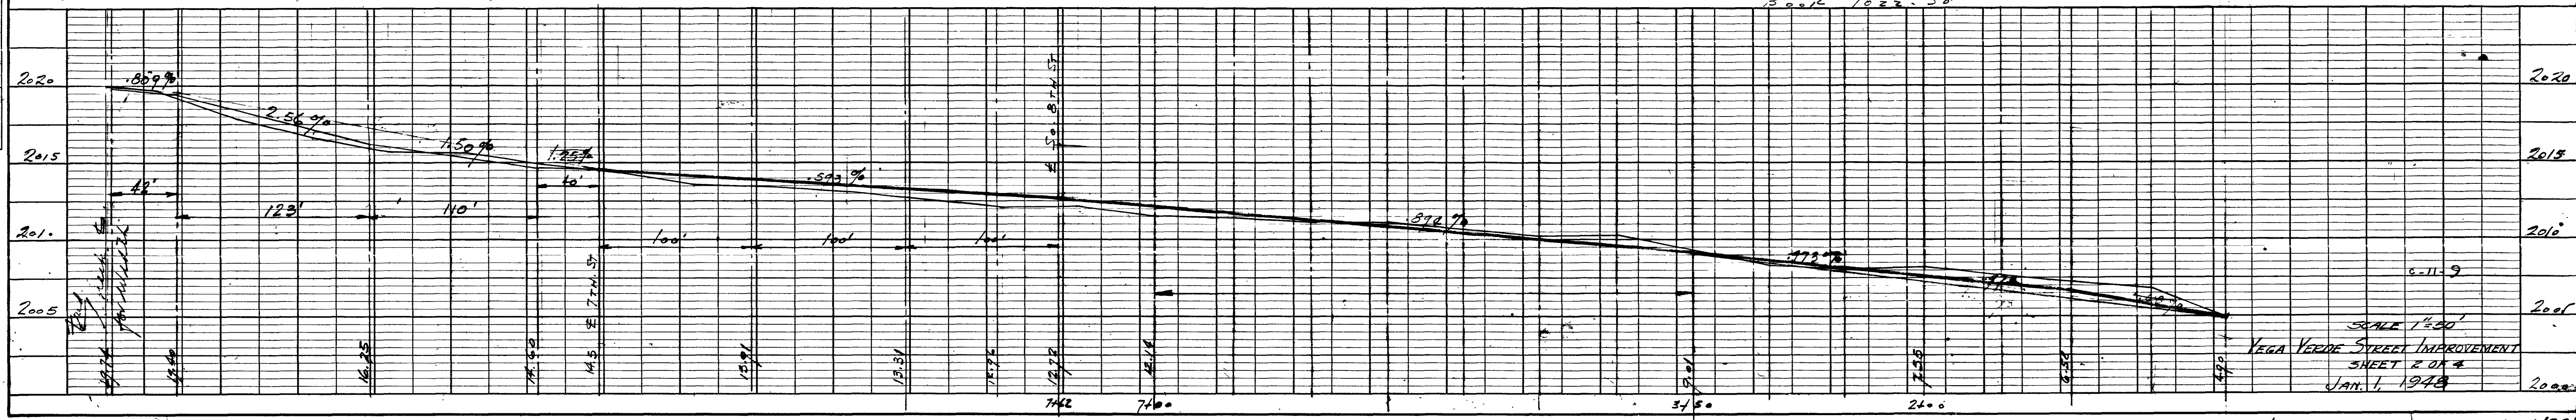
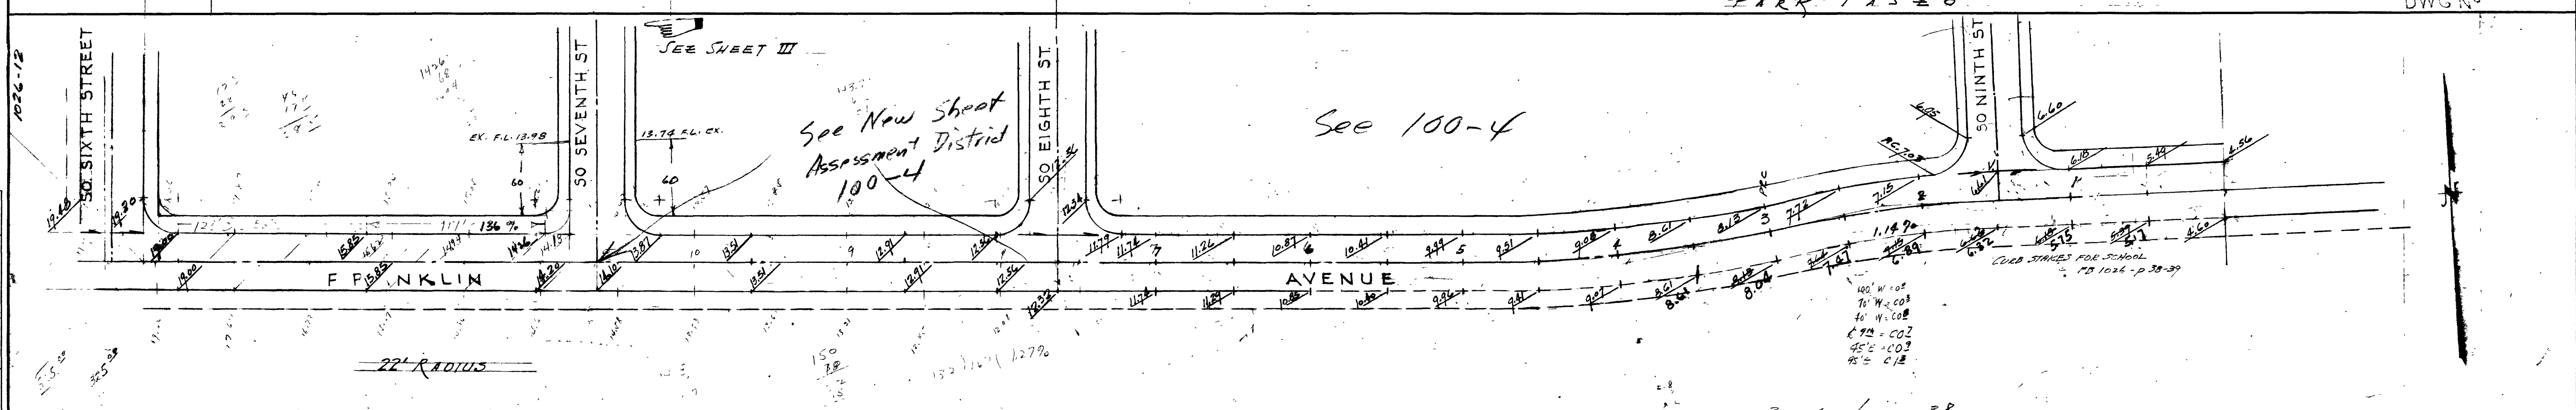
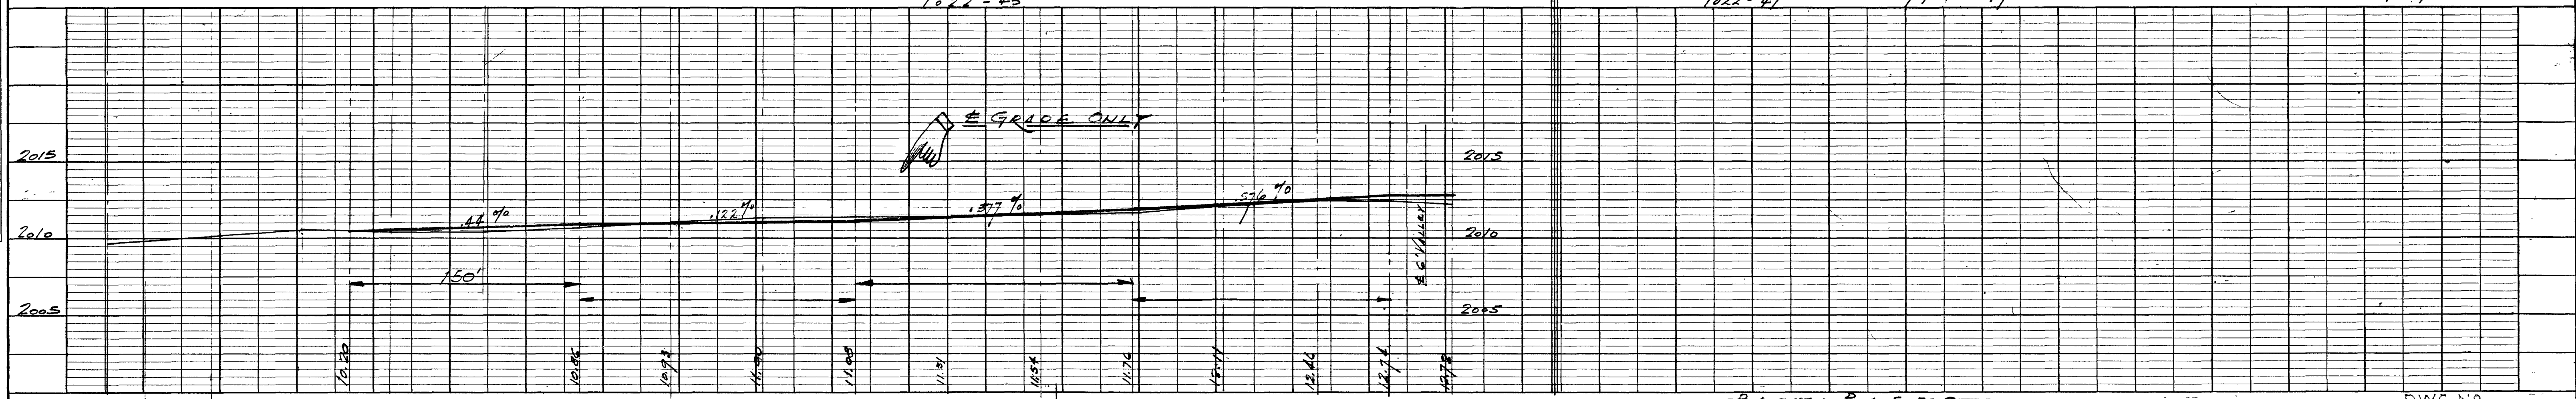


DATE: _____ BY: _____
 SURVEYED: _____
 NOTE BOOK: _____
 ALIGNMENT CHECKED: _____
 RT. OF WAY CHECKED: _____
 NO. _____

DATE: _____ BY: _____
 SURVEYED: _____
 NOTE BOOK: _____
 GRADE CHECKED: _____
 PLAN & PROFILE NOTATIONS CHECKED: _____
 NO. _____

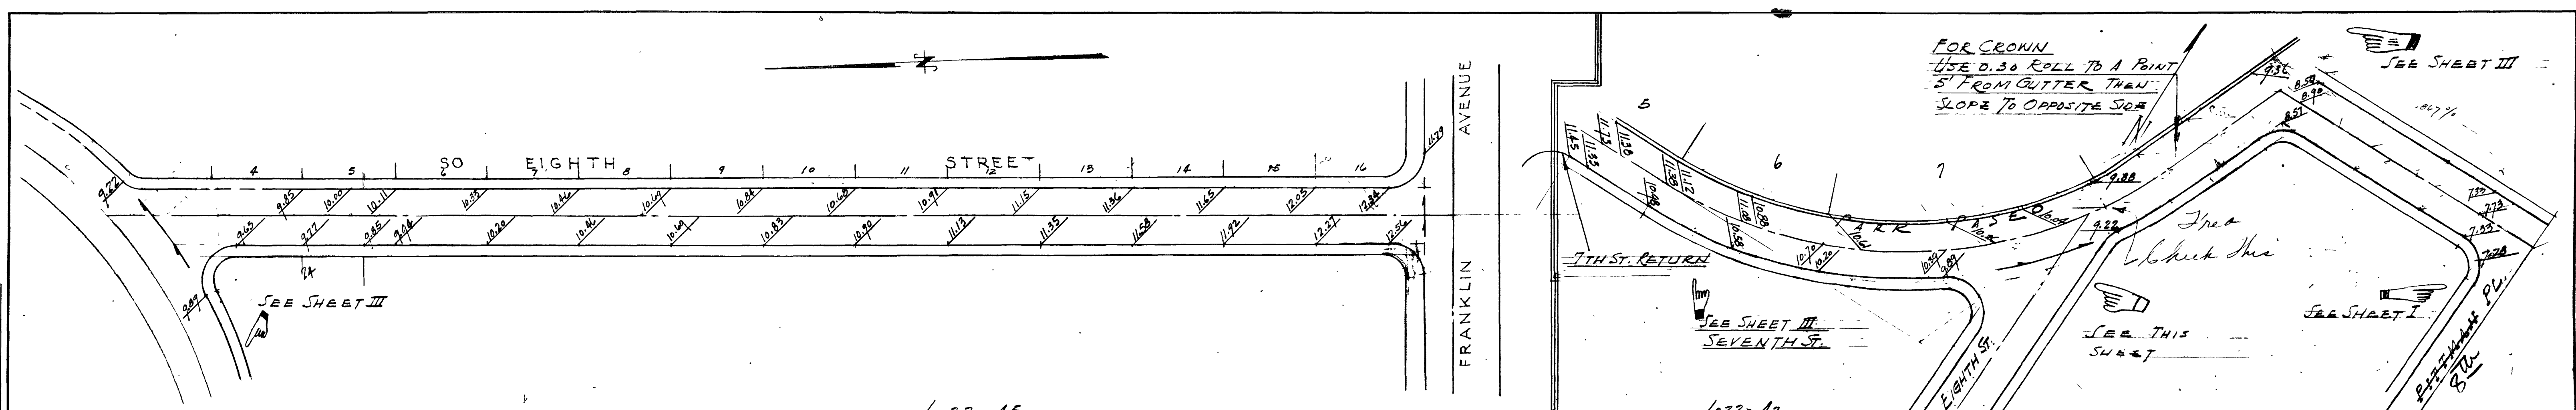

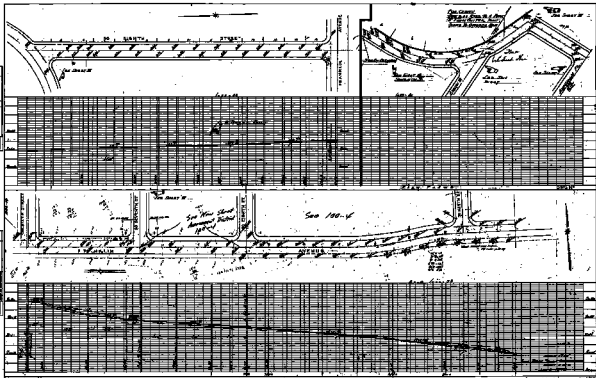

FRANKLIN RD. EAST LIME OF VILLA VERDE TRACTS TO SIXTH ST. N.Y. (L.S. 100-V) 1910