

© DOMINGO CAMBEIRO CORPORATION 1980

© DOMINGO CAMBEIRO CORPORATION 1980

All designs, arrangements and plans indicated or presented by this drawing, as instruments of service, are owned by and the property of DOMINGO CAMBEIRO CORPORATION. The use of these plans and/or specifications for any other construction or design, in whole or in part, without the written permission of DOMINGO CAMBEIRO CORPORATION, and the reproduction and publication thereof is expressly limited to such use. Reproduction, publication or re-use by any method, in whole or in part is prohibited. None of such designs, arrangements or plans shall be used by or disclosed to any person, firm, agency or corporation without the written permission of DOMINGO CAMBEIRO CORPORATION. Visual contact with these plans and specifications shall constitute prima facie evidence of acceptance of these restrictions.


DO NOT SCALE DRAWINGS

SHEET NO.

513-55X



KEY PLAN

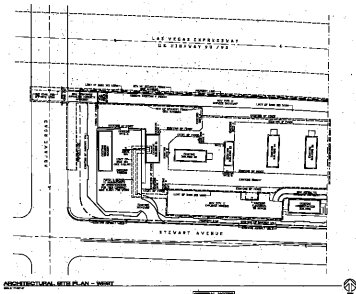

ARCHITECTURAL SITE PLAN - WEST



NO.	REVISION	DATE
1	ISSUED FOR PERMIT	11-1-61
2	REVISION	
3	REVISION	
4	REVISION	
5	REVISION	
6	REVISION	
7	REVISION	
8	REVISION	
9	REVISION	
10	REVISION	

AS-BUILT RECORD DRAWING
 INDICATING CHANGES MADE
 TO THE ORIGINAL
 DRAWING OF THE PROJECT

NO.	REVISION	DATE
1	ISSUED FOR PERMIT	11-1-61
2	REVISION	
3	REVISION	
4	REVISION	
5	REVISION	
6	REVISION	
7	REVISION	
8	REVISION	
9	REVISION	
10	REVISION	

NO.	REVISION	DATE
1	ISSUED FOR PERMIT	11-1-61
2	REVISION	
3	REVISION	
4	REVISION	
5	REVISION	
6	REVISION	
7	REVISION	
8	REVISION	
9	REVISION	
10	REVISION	

Domino Concrete Corporation
 1100 S. 10th Street, Las Vegas, Nevada 89102
 Phone: 762-1111



AS-BUILT
 11 OF 103