


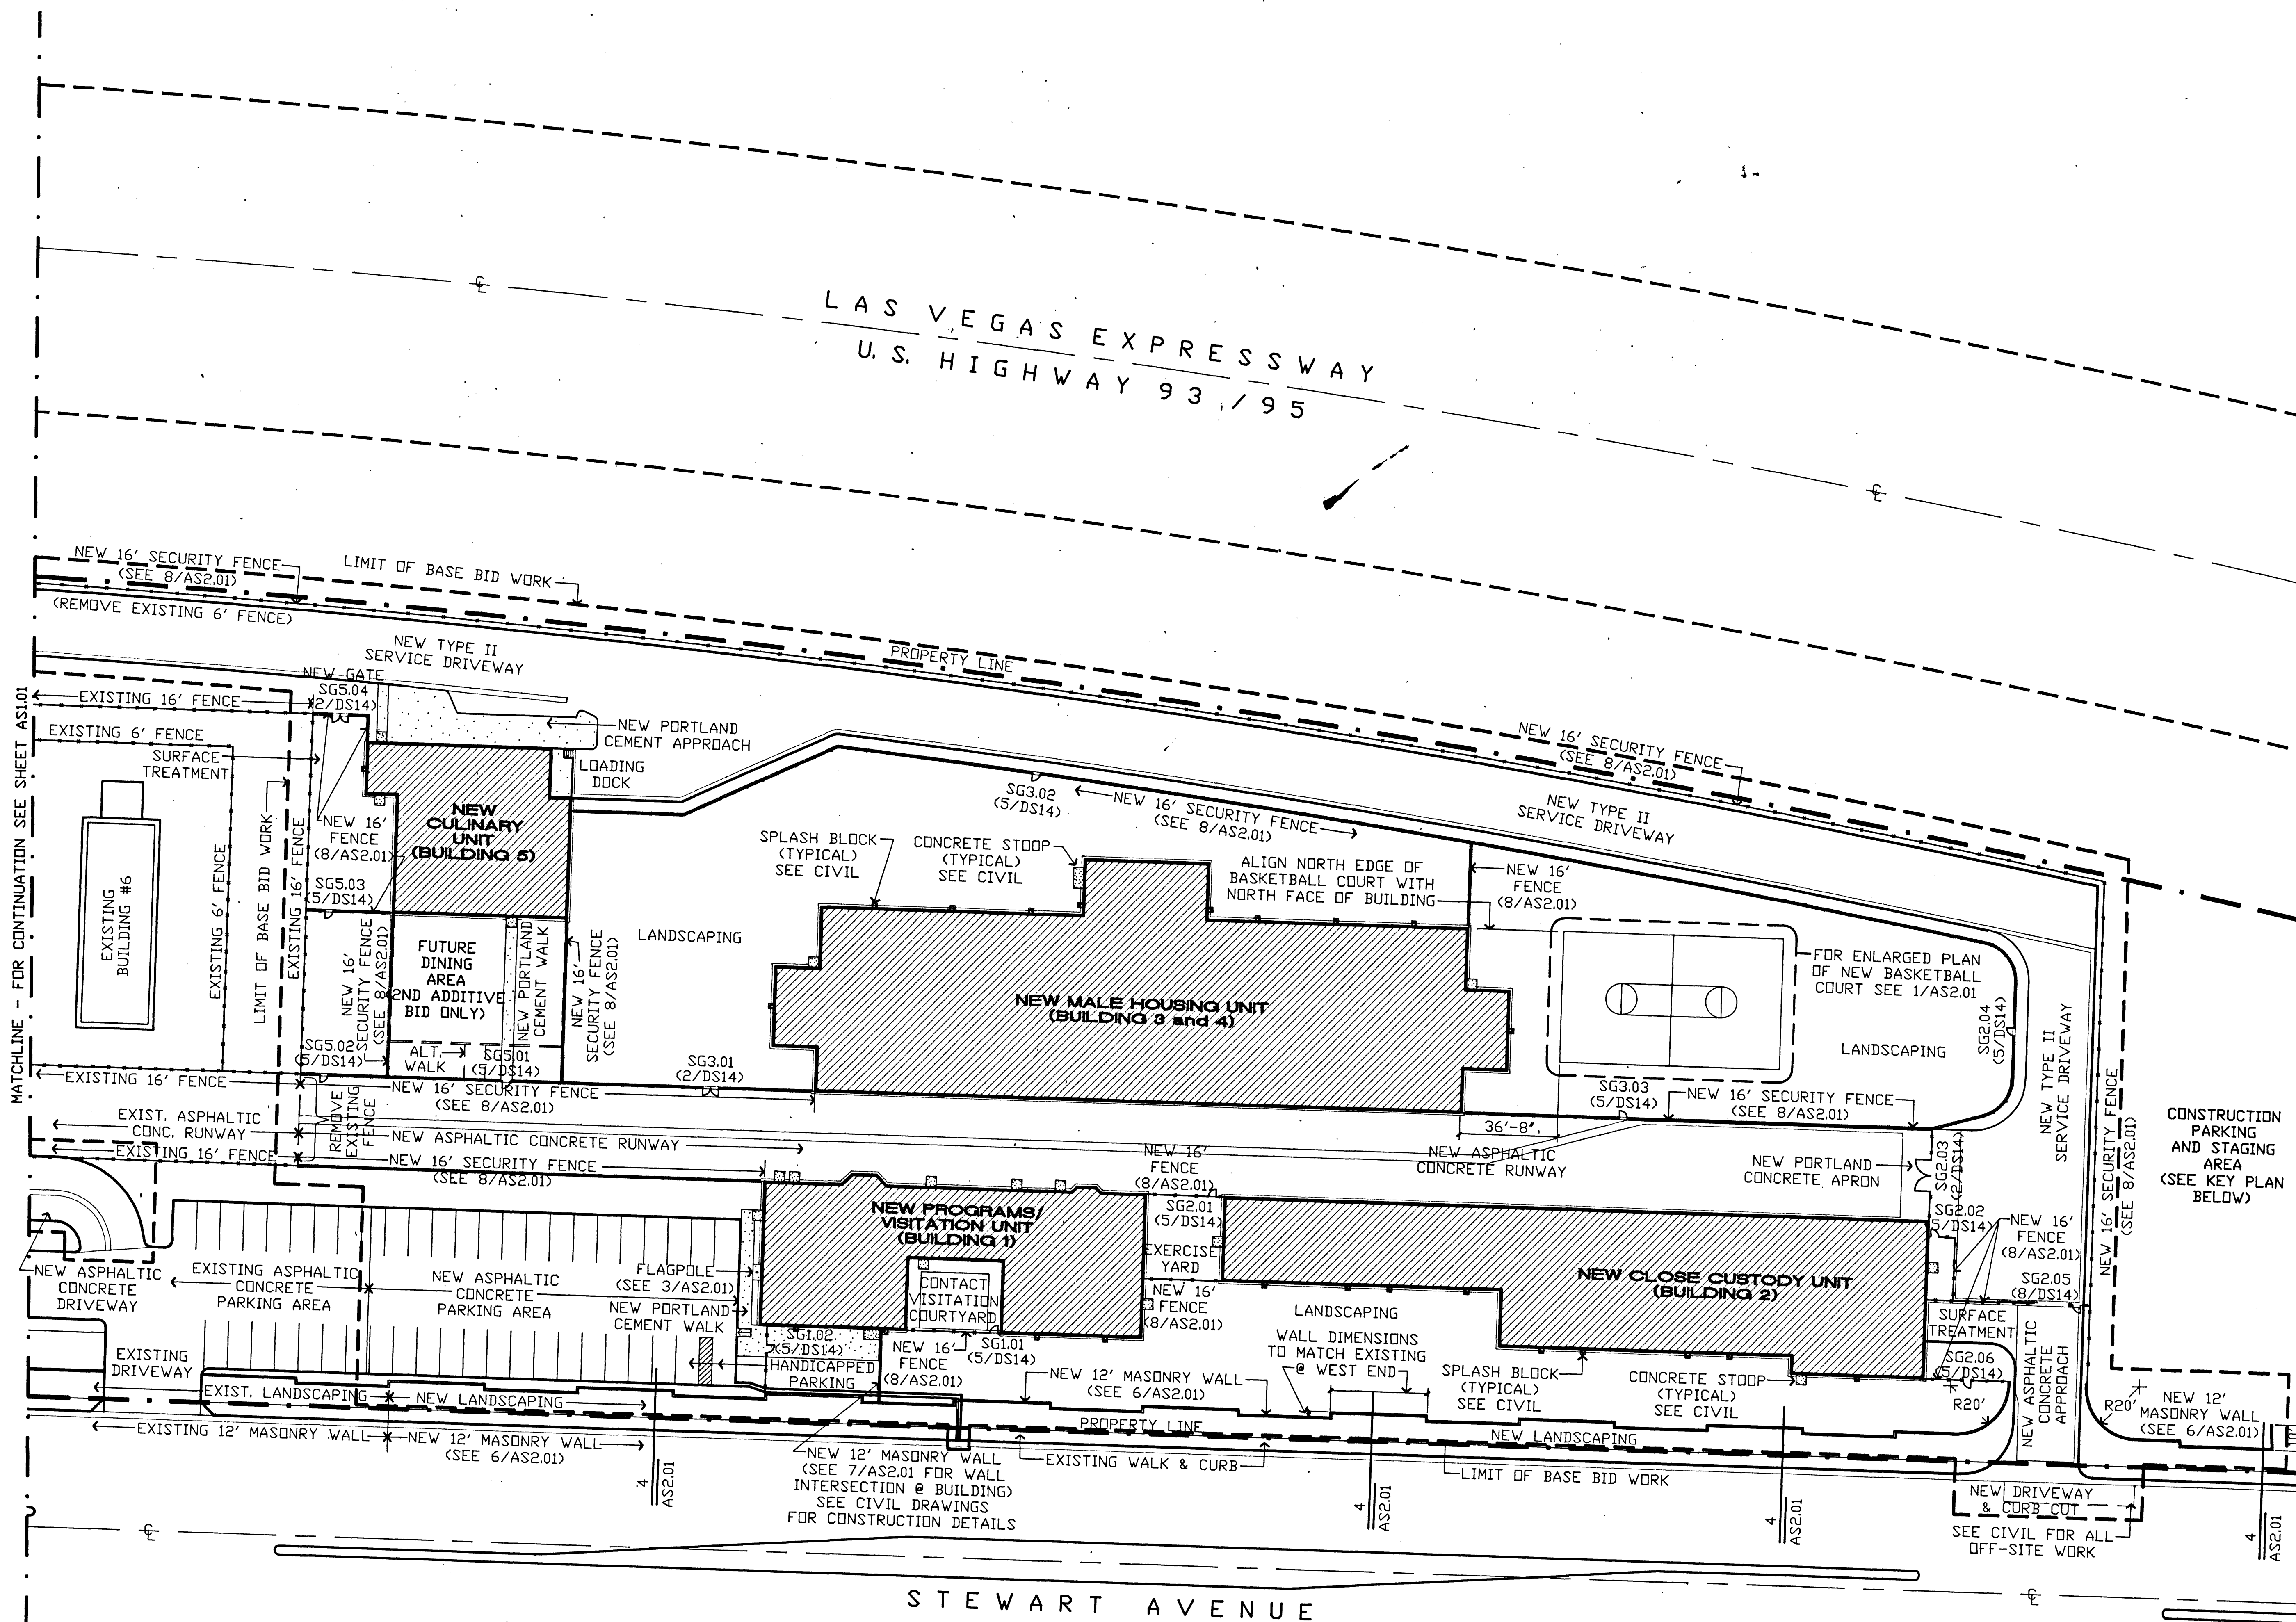


# ARCHITECTURAL SITE PLAN - EAST

SCALE: 1"=30'-0"

## GENERAL NOTES

1. CONTRACTOR IS RESPONSIBLE FOR COMPLETE COORDINATION OF SCHEDULING WITH OWNER. THE FACILITY WILL REMAIN IN FULL OPERATION WHILE EXPANSION IS CONSTRUCTED.
2. PROVIDE SECURITY MARKERS AND FENCING AS NECESSARY TO CONTROL PROJECT METHOD & CONTRACTOR DISCRETION EXCEPT WHERE SPECIFICALLY NOTED.
3. SEE SHEET DS14 FOR ALL PLANS, ELEVATIONS, AND DETAILS OF ALL NEW GATES.

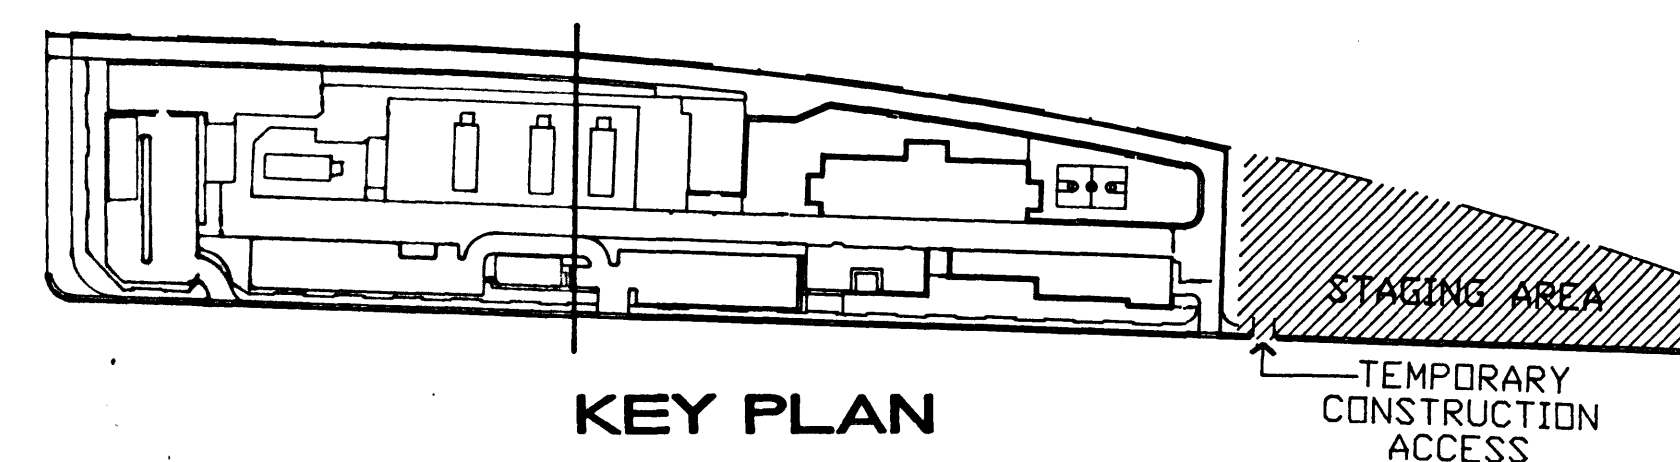

KEY PLAN

| REVISIONS |             |      |    |
|-----------|-------------|------|----|
| REV       | DESCRIPTION | DATE | BY |
|           |             |      |    |
|           |             |      |    |
© DOMINGO CAMBEIRO CORPORATION 1990

**AS-BUILT RECORD DRAWING**  
CONSTRUCTION CHANGES SHOWN HEREON  
ARE BASED ON DATA  
FURNISHED BY THE CONTRACTOR

All designs, arrangements and plans indicated or presented by this drawing, as instruments of service, are owned by and the property of DOMINGO CAMBEIRO CORPORATION. The use of these plans and/or specifications shall be restricted to the original site for which they were prepared and publication thereof is expressly limited to such use. Reproduction, publication or reuse by any method in whole or in part is prohibited. None of such designs, arrangements or plans shall be used by or disclosed to any person, firm, agency or corporation without the written permission of DOMINGO CAMBEIRO CORPORATION. Visual contact with these plans and specifications shall constitute prima facie evidence of acceptance of these restrictions.

|      |          |            |             |
|------|----------|------------|-------------|
| SEAL | DRAWN BY | CHECKED BY | ISSUED DATE |
|      |          |            | 11-15-90    |

|                         |                       |
|-------------------------|-----------------------|
| ARCHITECTURAL SITE PLAN | DO NOT SCALE DRAWINGS |
|-------------------------|-----------------------|

CITY OF LAS VEGAS  
DETENTION FACILITY EXPANSION  
3100 EAST STEWART AVENUE  
LAS VEGAS, NEVADA

**Domingo Cambeiro Corporation**  
ARCHITECTURE • ENGINEERING • PLANNING • INTERIORS  
3555 PECOS-McLEOD IC. LAS VEGAS, NEVADA 89121  
(702) 792-0064

SHEET NO.  
**AS1.02**  
12 of 163