




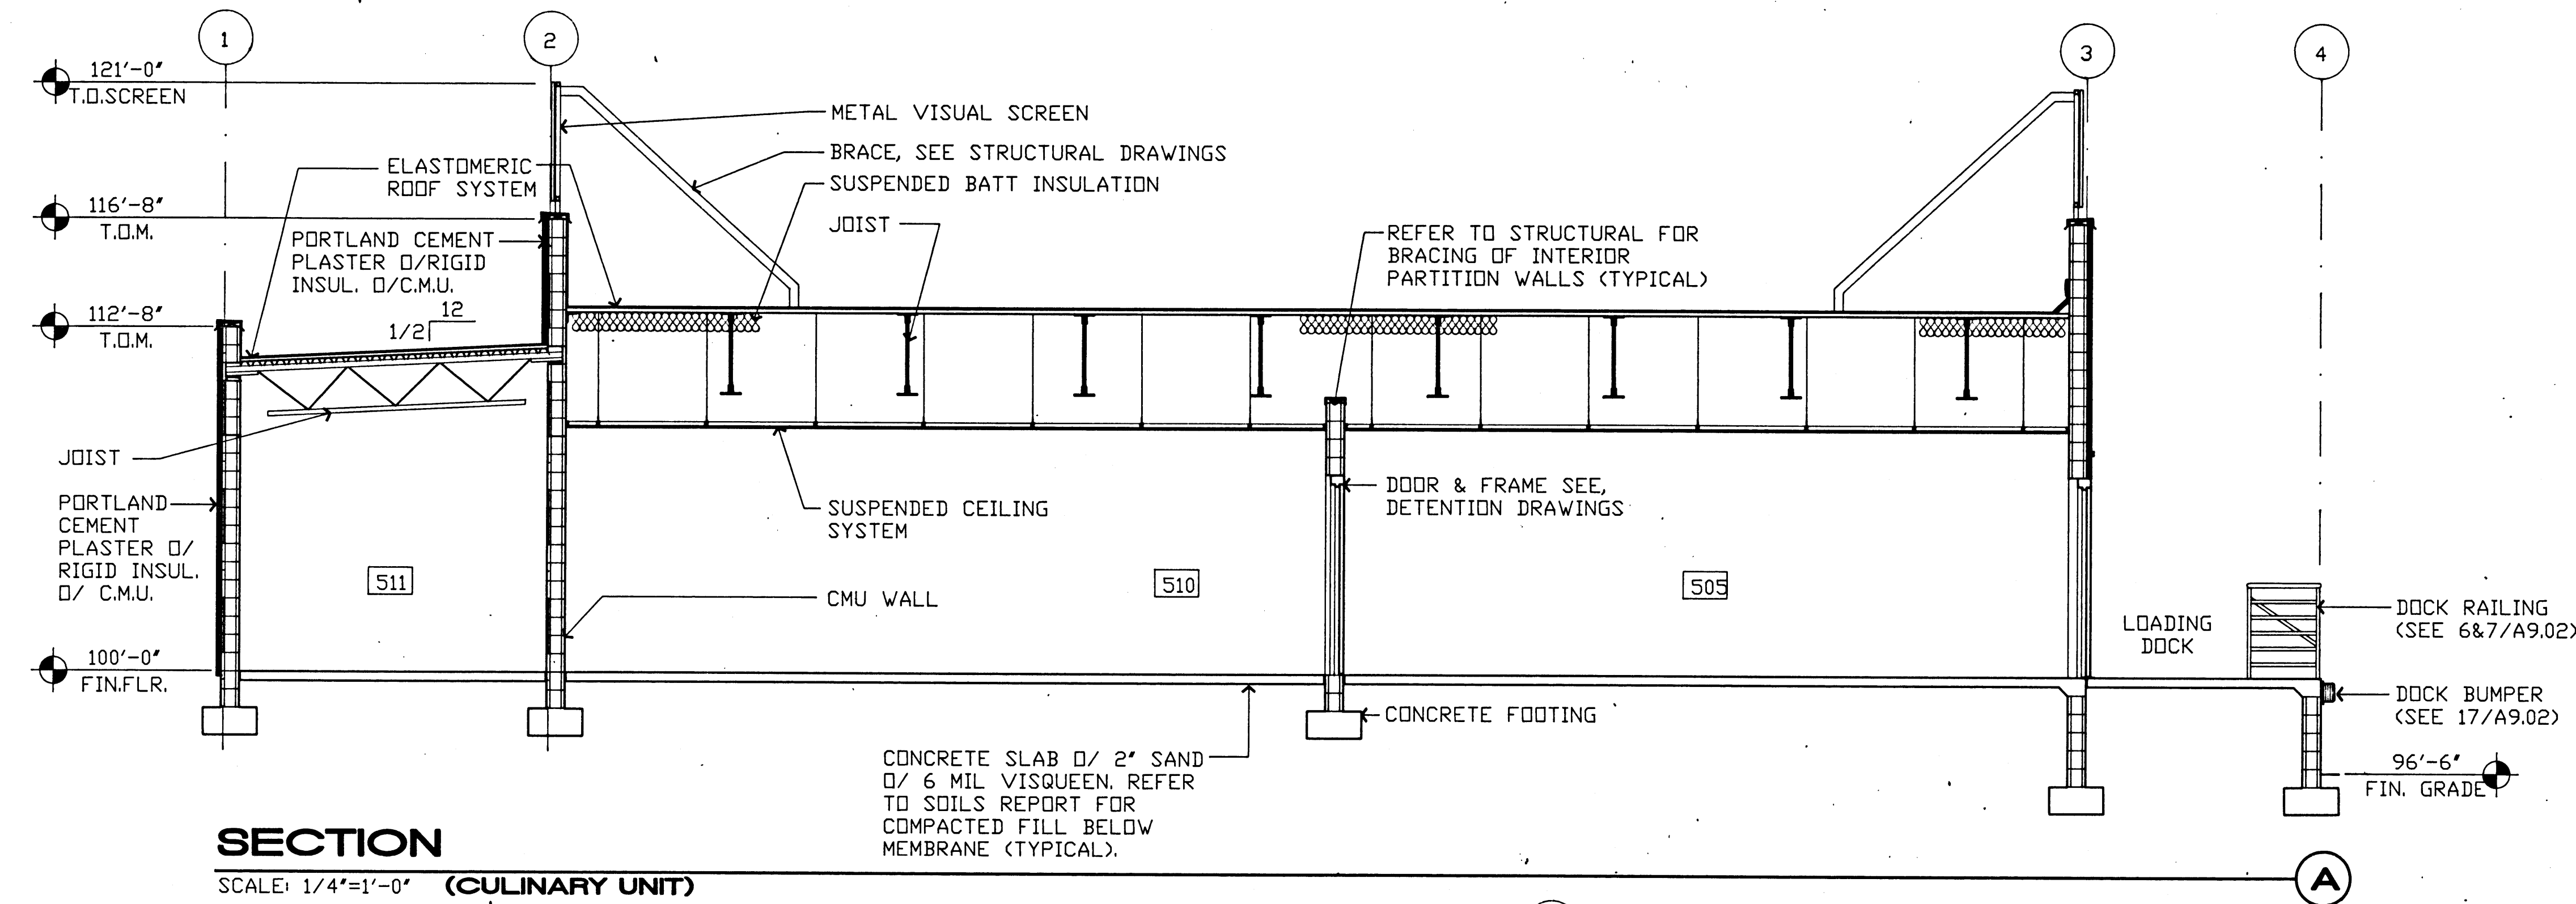

SECTION
SCALE: 1/4"=1'-0" (CULINARY UNIT)

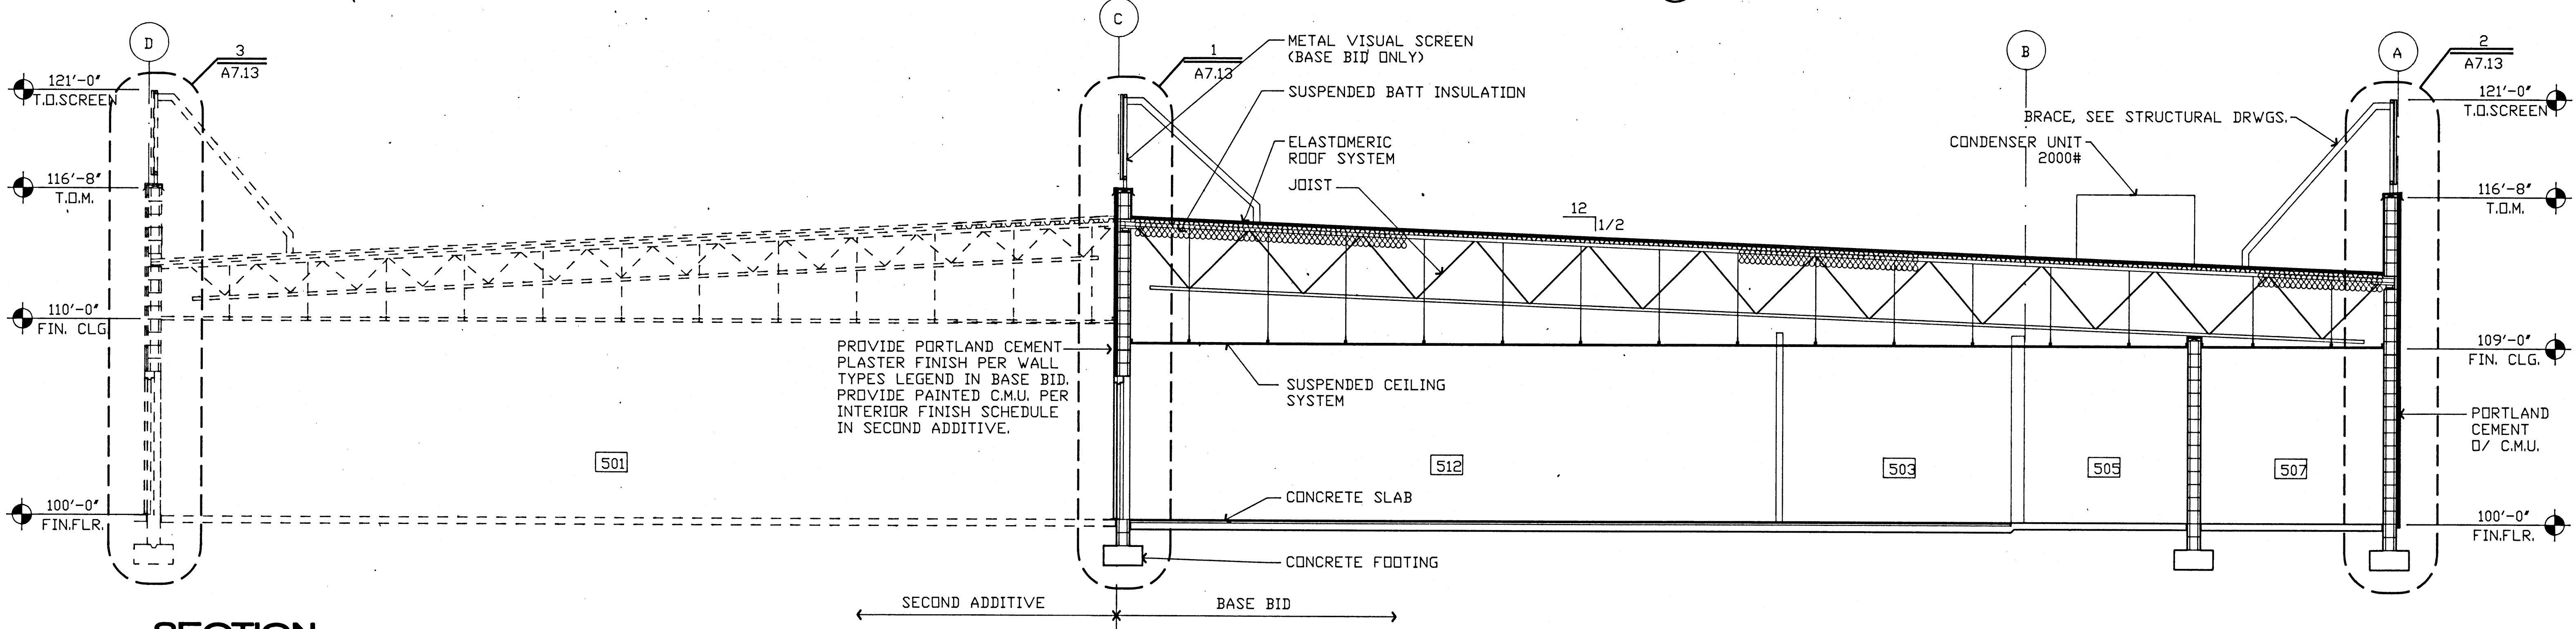

SECTION
SCALE: 1/4"=1'-0" (CULINARY UNIT)

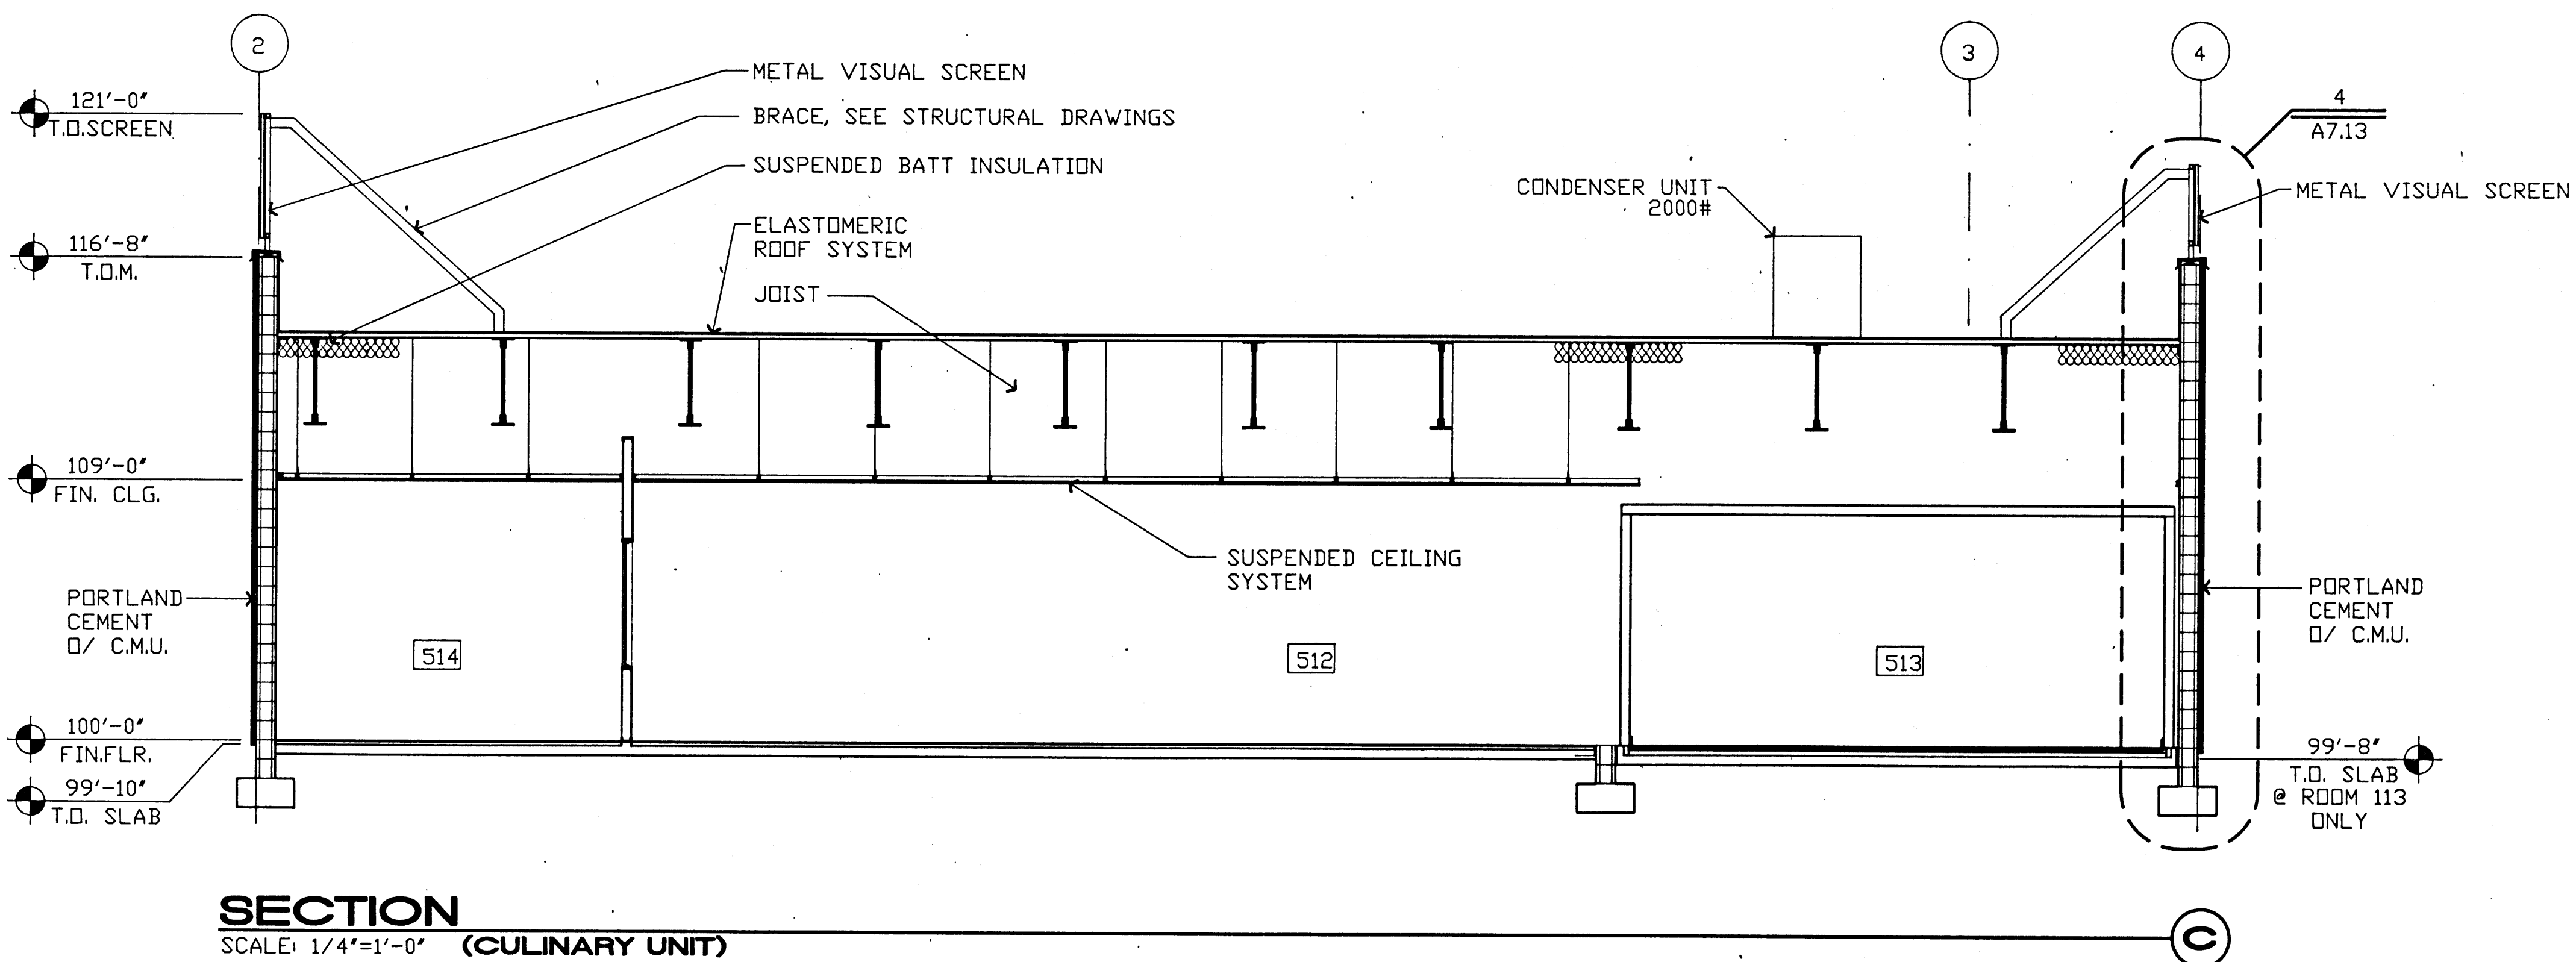

SECTION
SCALE: 1/4"=1'-0" (CULINARY UNIT)

CONTRACTOR NOTE:
ALL ROOF JOISTS
SPRAYED TO PROVIDE
1-HOUR PROTECTION
(ENTIRE PROJECT)

REVISIONS			
REV	DESCRIPTION	DATE	BY

© DOMINGO CAMBEIRO CORPORATION 1990

AS-BUILT RECORD DRAWING
CONSTRUCTION CHANGES SHOWN HEREON
ARE BASED ON DATA
FURNISHED BY THE CONTRACTOR

All designs, arrangements and plans indicated on or presented by this drawing, as instruments of service, are owned by and the property of DOMINGO CAMBEIRO CORPORATION. The use of these plans and/or specifications shall be restricted to the original site for which they were prepared and publication thereof is expressly limited to such use. Reproduction, publication or reuse by any method in whole or in part is prohibited. None of such designs, arrangements or plans shall be used by or disclosed to any person, firm, agency or corporation without the written permission of DOMINGO CAMBEIRO CORPORATION. Visual contact with these plans and specifications shall constitute prima facie evidence of acceptance of these restrictions.

DRAWN BY	CHECKED BY		ISSUED DATE 11-15-90

SEAL

ING	INTERIORS	732-0094
99121		
Hyperation		

BUILDING SECTIONS CULINARY UNIT	DO NOT SCALE DRAWINGS	

**CITY OF LAS VEGAS
DETENTION FACILITY EXPANSION
3100 EAST STEWART AVENUE
LAS VEGAS, NEVADA**

Domingo Cambeiro Corporation
ARCHITECTURE • ENGINEERING • PLANNING • INTERIORS
3555 PECOS-McLEOD IC. LAS VEGAS, NEVADA 89121
(702) 792-0084

A7.04

50 of 163

