

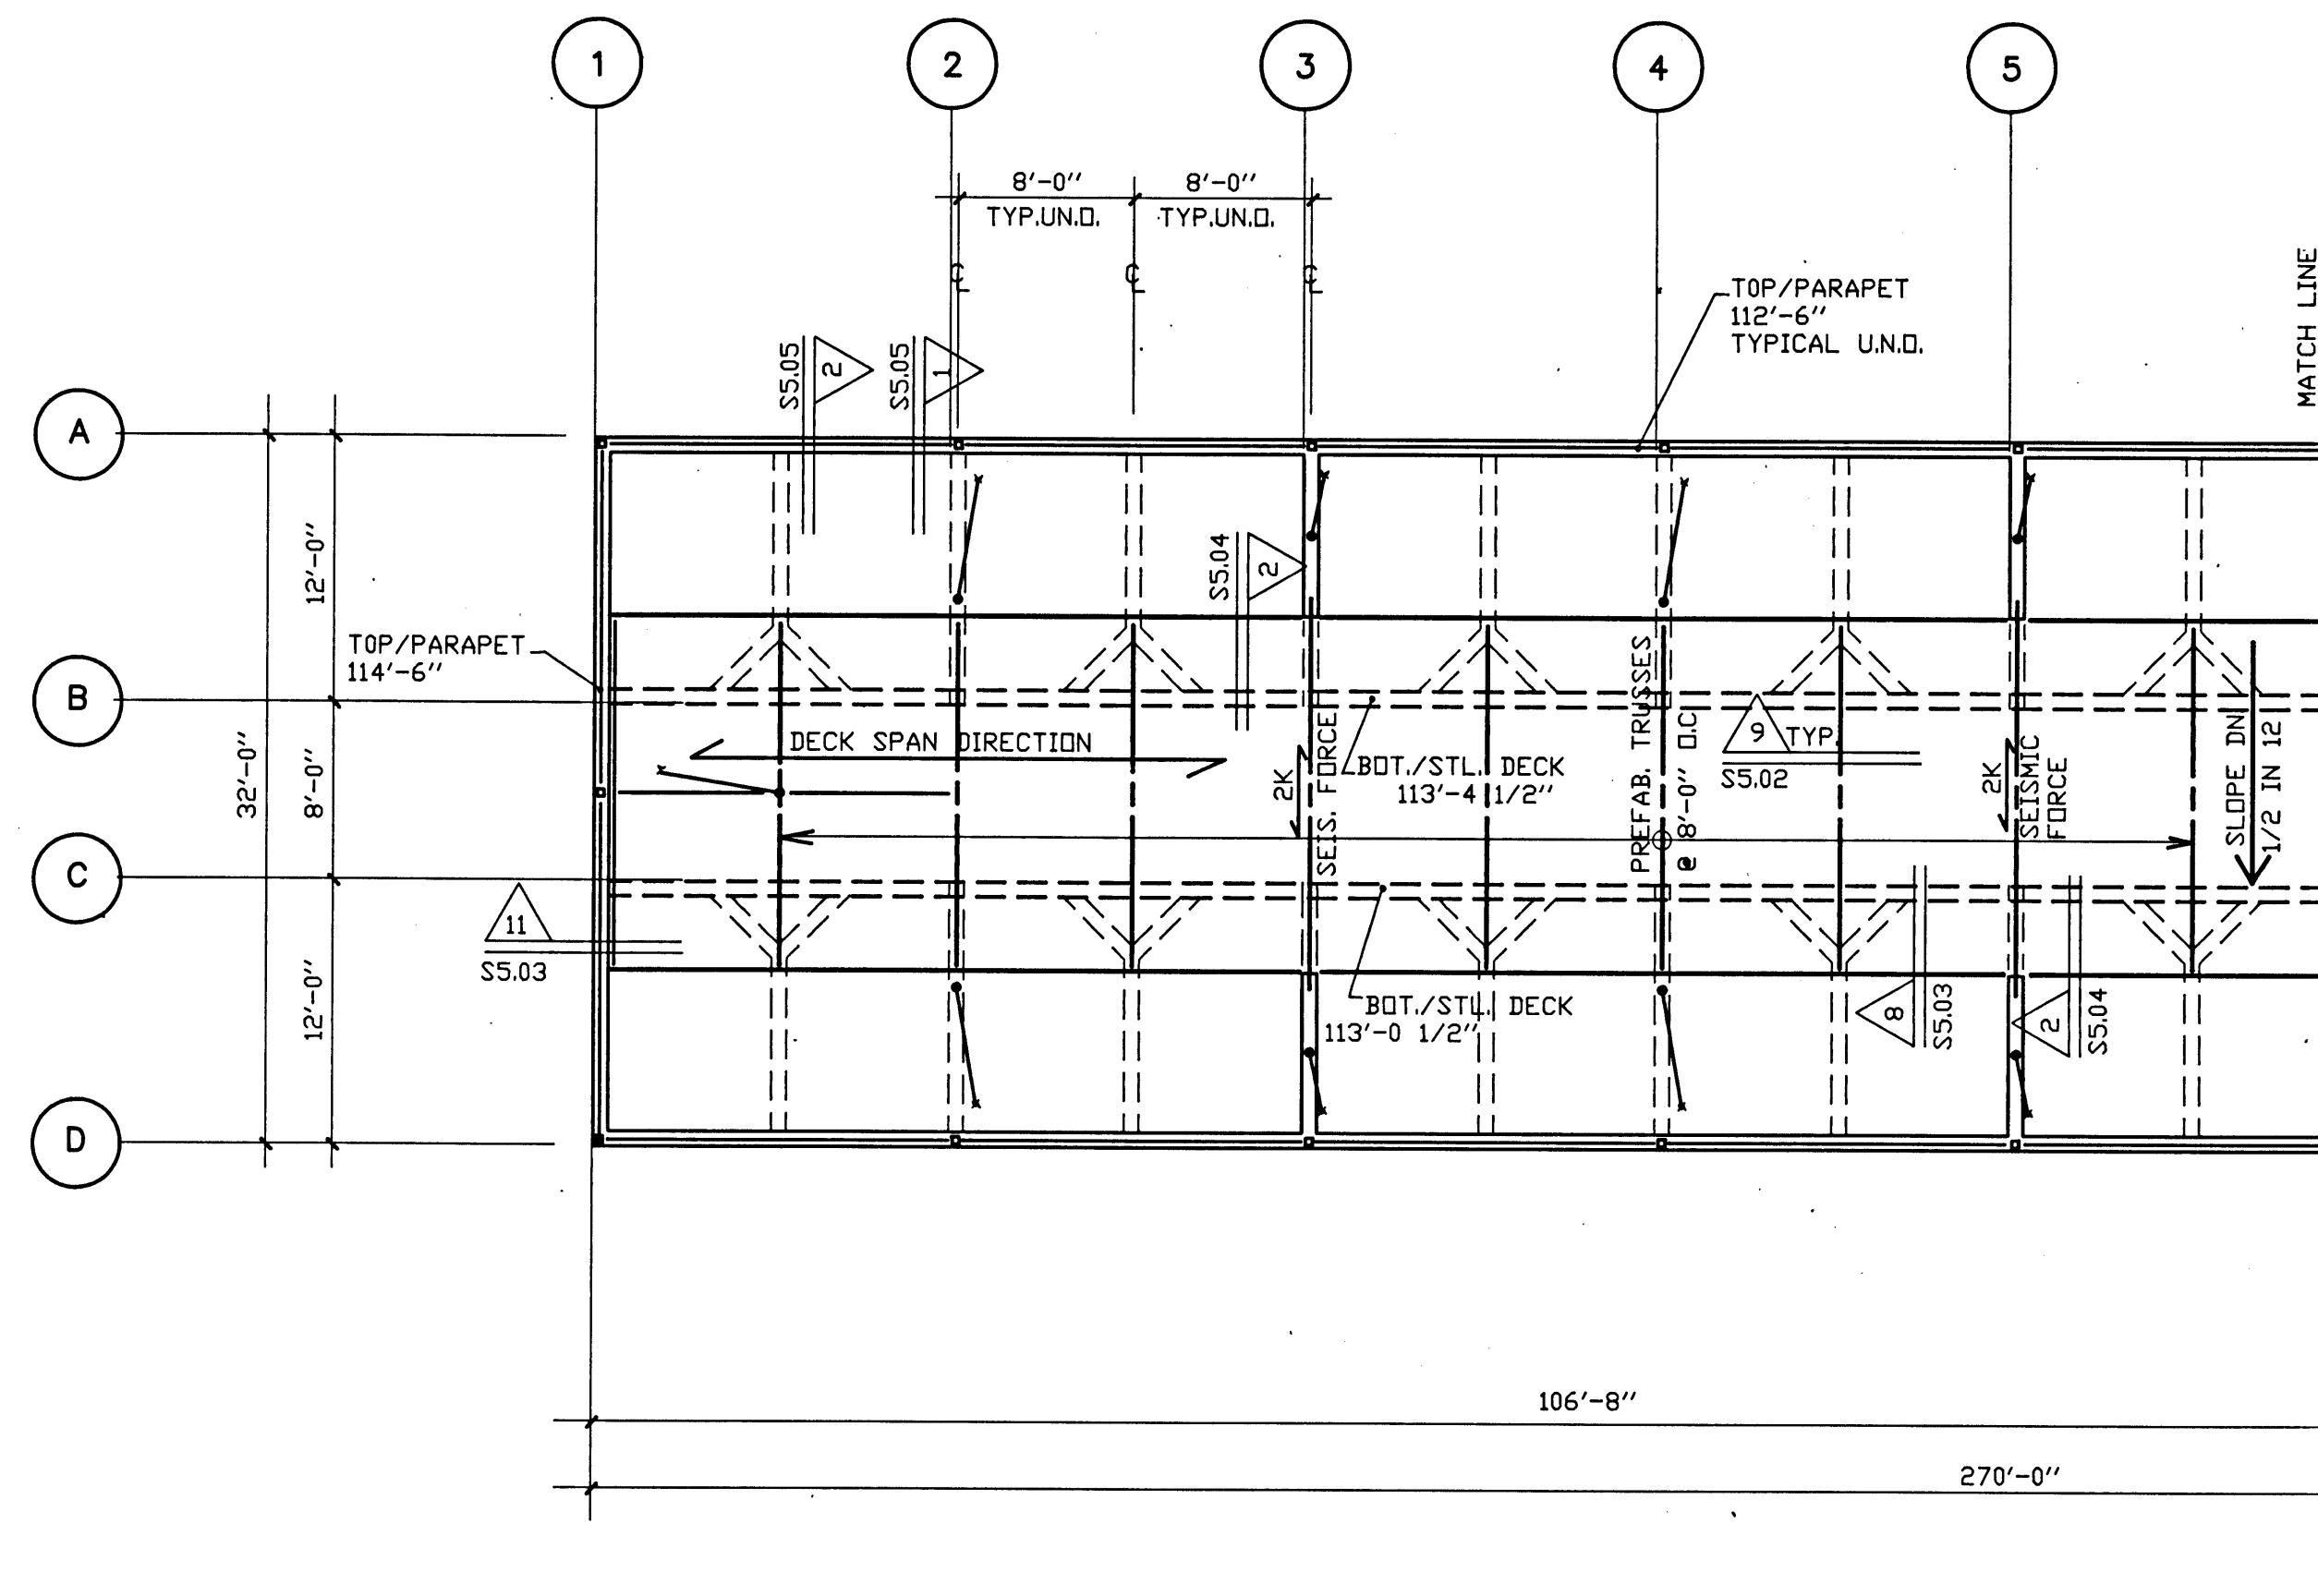
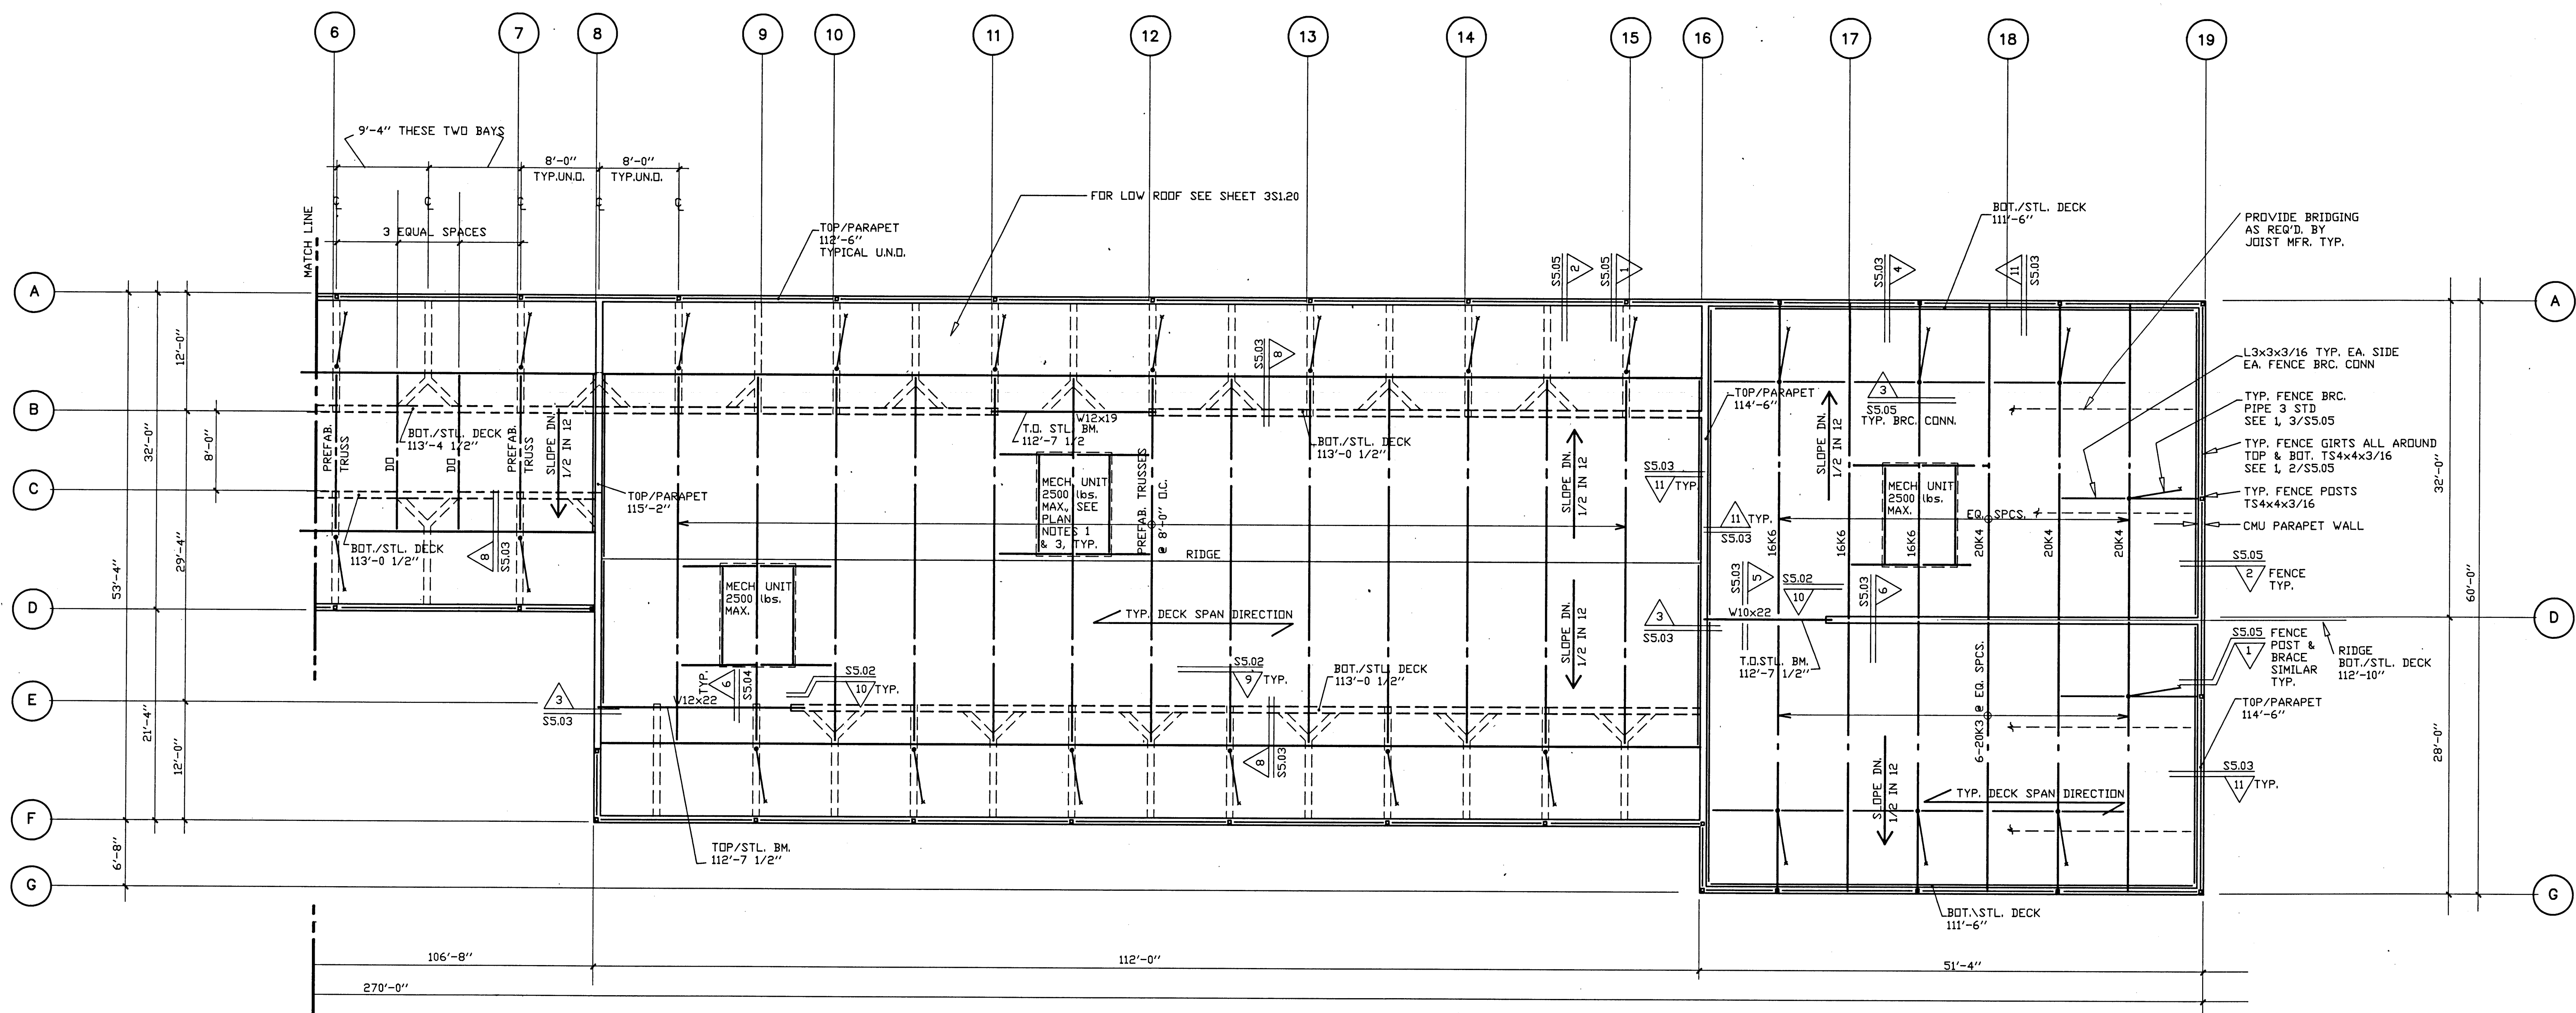


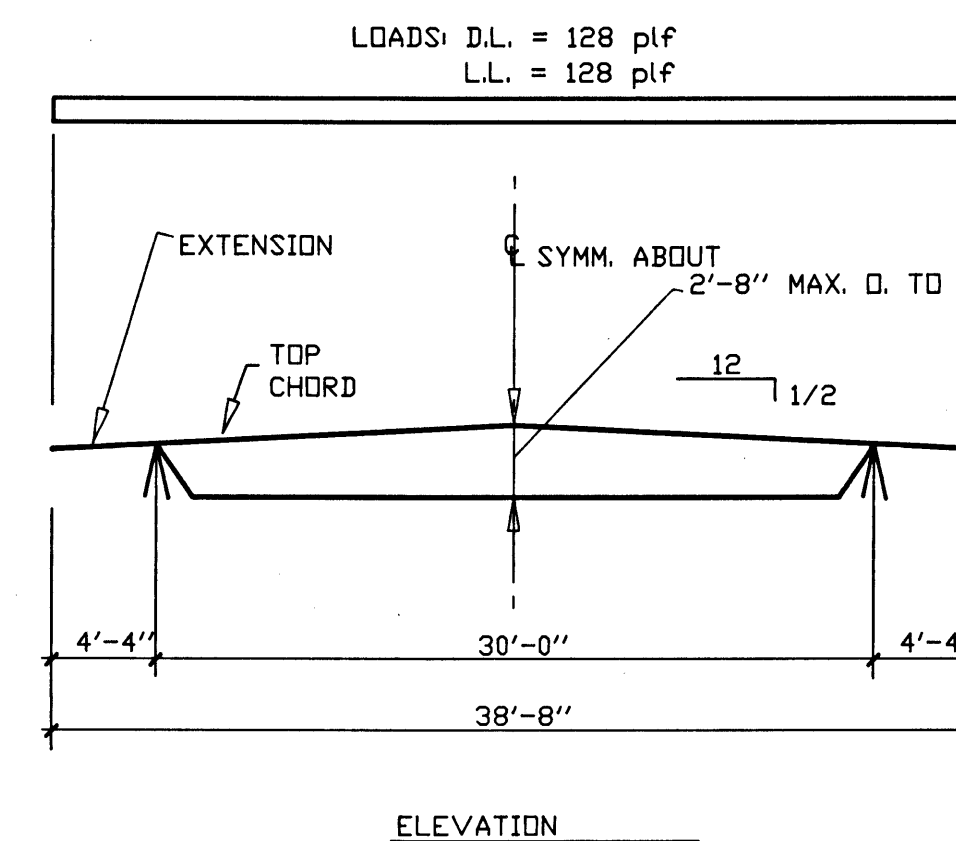

HIGH ROOF FRAMING PLAN - CLOSE CUSTODY UNIT

FOR PLAN NOTES
SEE SHEET 2S1.20

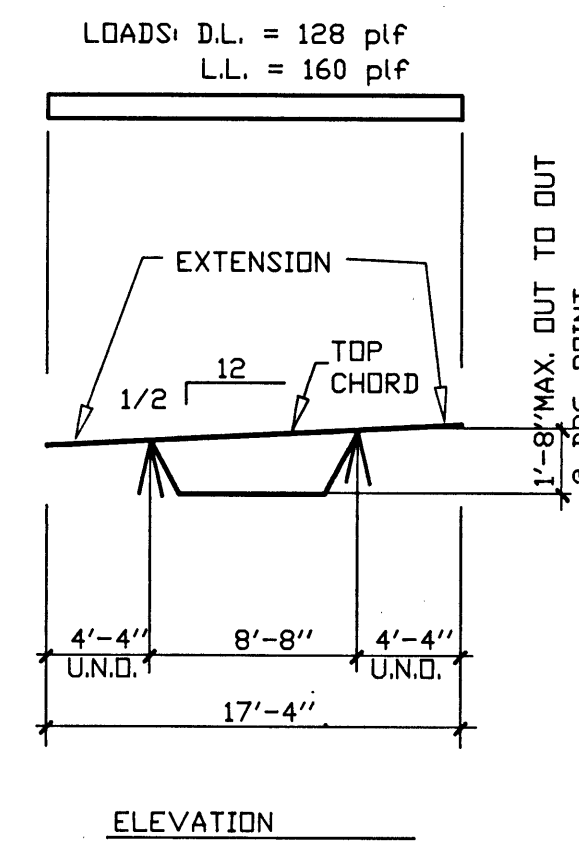

PREFABRICATED TRUSS LOADING DIAGRAMS

PLAN NOTE 1 APPLIES TO PREFABRICATED TRUSSES

REVISIONS			
REV	DESCRIPTION	DATE	BY

© DOMINGO CAMBEIRO CORPORATION 1990

AS-BUILT RECORD DRAWING
CONSTRUCTION CHANGES SHOWN HEREON
ARE BASED ON DATA
FURNISHED BY THE CONTRACTOR

MARTIN, PELTYN & ASSOCIATES
STRUCTURAL ENGINEERS
1001 RANCHO DRIVE SOUTH
LAS VEGAS, NEVADA 89106
JOB NO. 2523

All ideas, designs, arrangements and plans indicated or presented by this drawing, as instruments of service, are owned by and the property of DOMINGO CAMBEIRO CORPORATION. The use of these plans and/or specifications shall be restricted to the original site for which they were prepared and publication thereof is expressly limited to such use. Reproduction, publication or reuse by any method, in whole or in part, is prohibited. None of such ideas, designs, arrangements or plans shall be used by or disclosed to any person, firm, agency, or corporation without the written permission of DOMINGO CAMBEIRO CORPORATION. Visual contact with these plans and specifications shall constitute prima facie evidence of acceptance of these restrictions.


SEAL	DRAWN BY EH	CHECKED BY MA	ISSUED DATE 11-15-90
------	----------------	------------------	-------------------------

HIGH ROOF FRAMING PLAN
CLOSE CUSTODY UNIT

DO NOT SCALE DRAWINGS

CITY OF LAS VEGAS
DETENTION FACILITY EXPANSION
3100 EAST STEWART AVENUE
LAS VEGAS, NEVADA

Domingo Cambeiro Corporation
ARCHITECTURE ENGINEERING PLANNING INTERIORS
3555 PECOS-McLEOD IC. LAS VEGAS, NEVADA 89121 (702) 792-0084

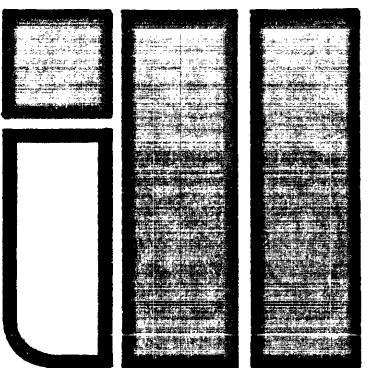

SHEET NO.

3S1.21

71 of 163
JOB NO. 2523
JOB NO. 2523