



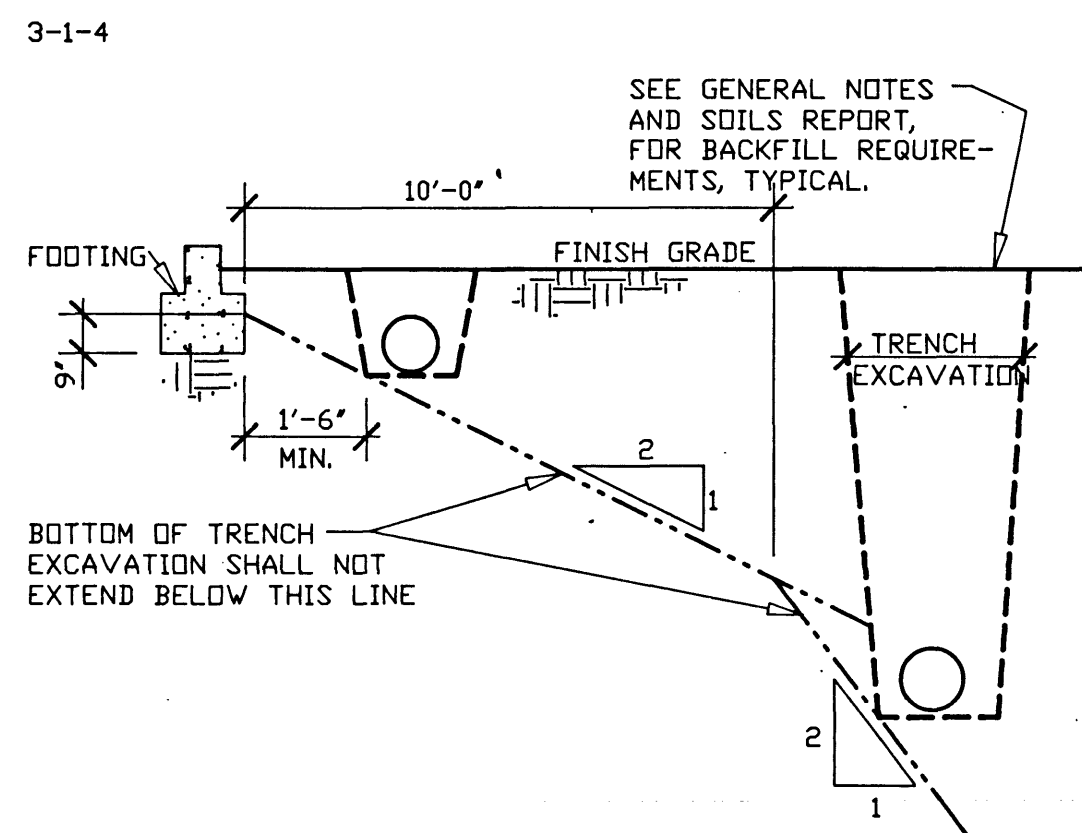


NOTES:
1. THE CONTRACTOR SHALL COORDINATE ALL EXCAVATION OPERATIONS WITH BUILDING FOUNDATION REQUIREMENTS.

EXCAVATION PARALLEL TO FOOTING

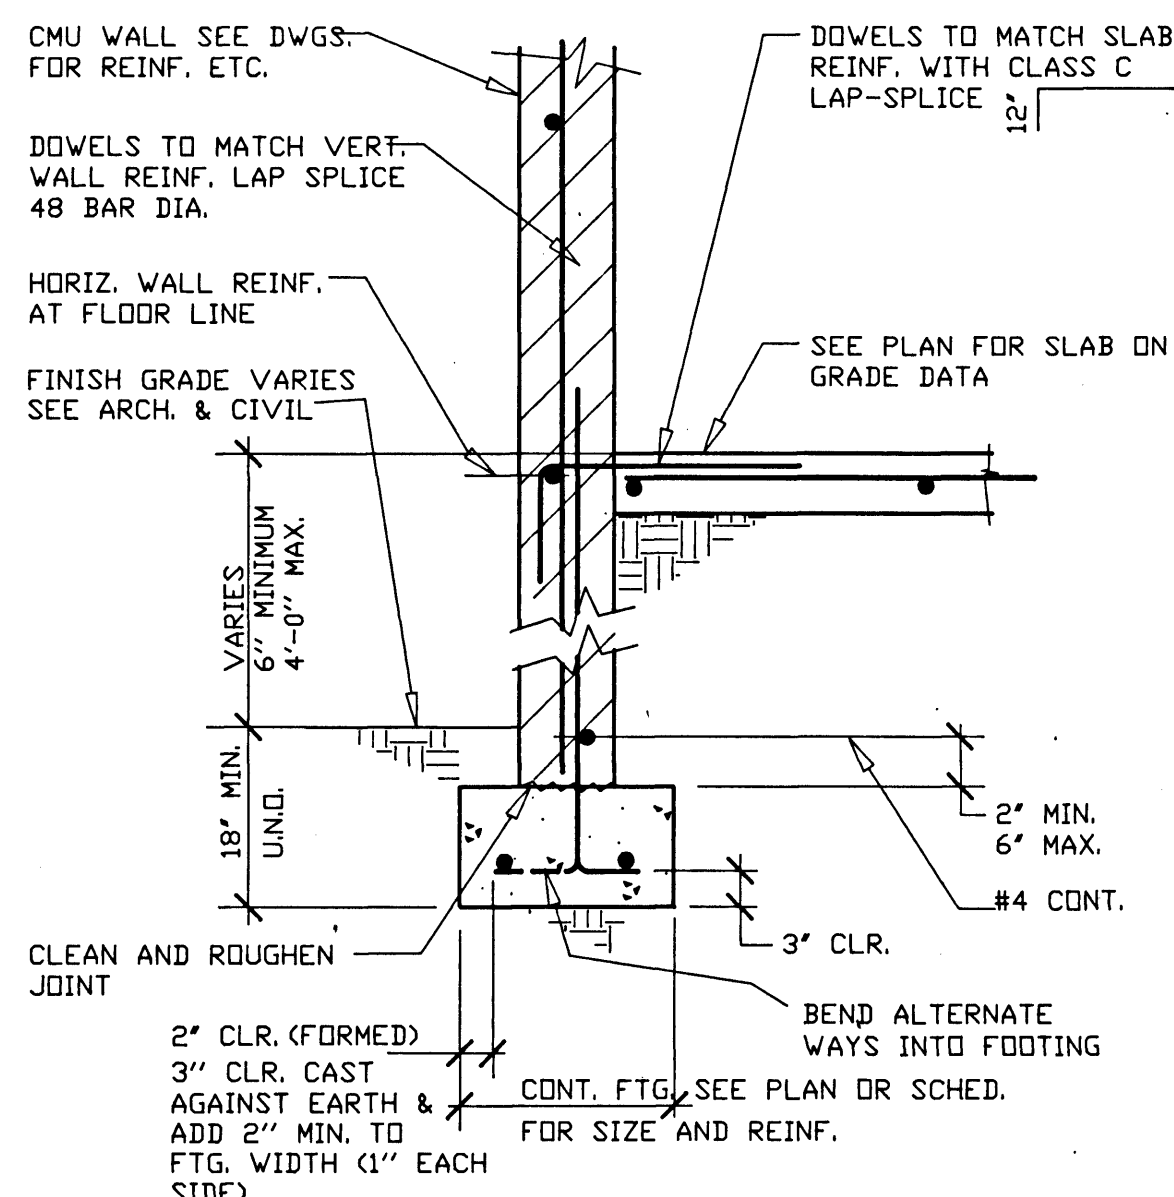


EXTERIOR WALL FOOTING

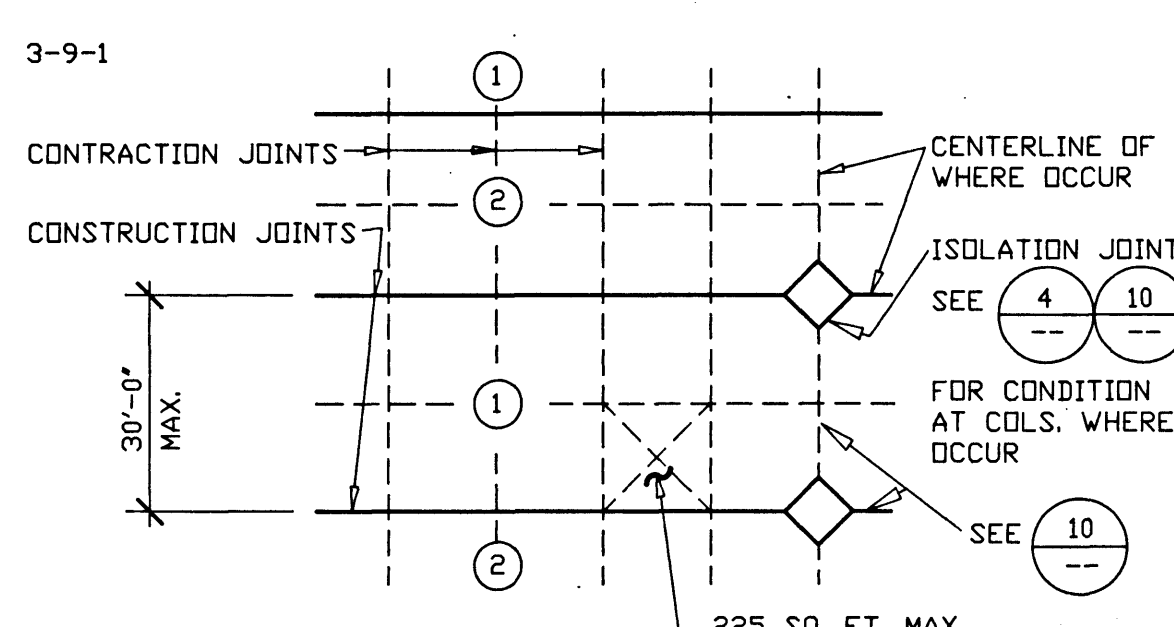


NOTES:
1. SLAB SHALL BE POURED IN STRIP PATTERN.
2. STRIPS TO BE DIVIDED BY CONSTRUCTION JOINTS AT THE CENTERLINE OF COLUMNS AND SUBDIVIDED AS REQ'D. INTO AREAS NOT EXCEEDING 225 SQ. FT. BY CONSTRUCTION JOINTS.
3. IN AREAS WHERE COLUMNS DO NOT OCCUR PROVIDE CONSTRUCTION AND/OR CONTRACTION JOINTS AS ABOVE.
4. CONTRACTORS SHALL OBTAIN ARCHITECT'S APPROVAL FOR ALL JOINT LOCATIONS.

METHOD OF POURING SLAB ON GRADE

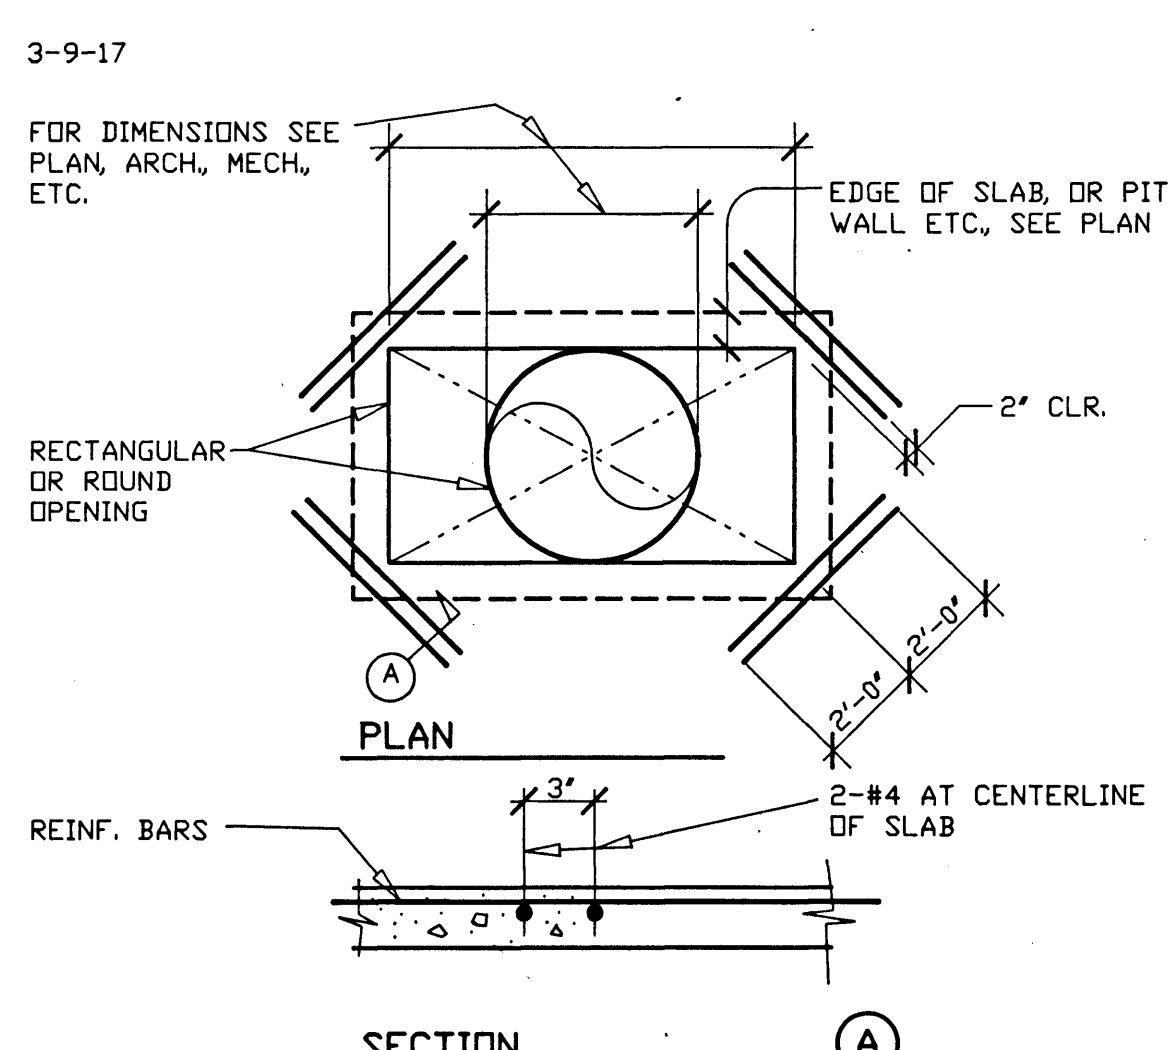


OPENING IN SLAB ON GRADE

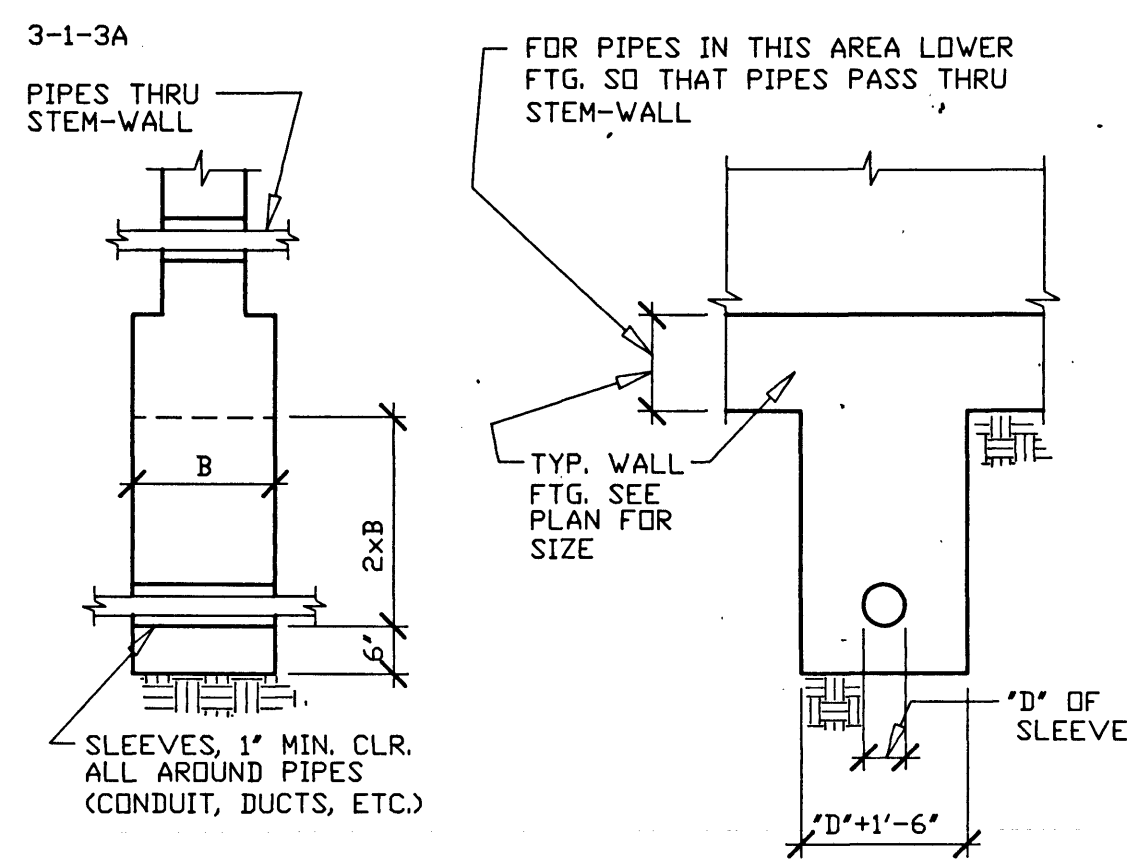


NOTES:
1. FOR PIPES 2x8 OR LESS BELOW BOTTOM OF FOOTINGS, PROVIDE SLEEVE & CONC. AS SHOWN.
2. B = WIDTH OF CONTINUOUS FOOTING OR LENGTH OF SPREAD FOOTING.

FOOTING PERPENDICULAR TO UTILITY

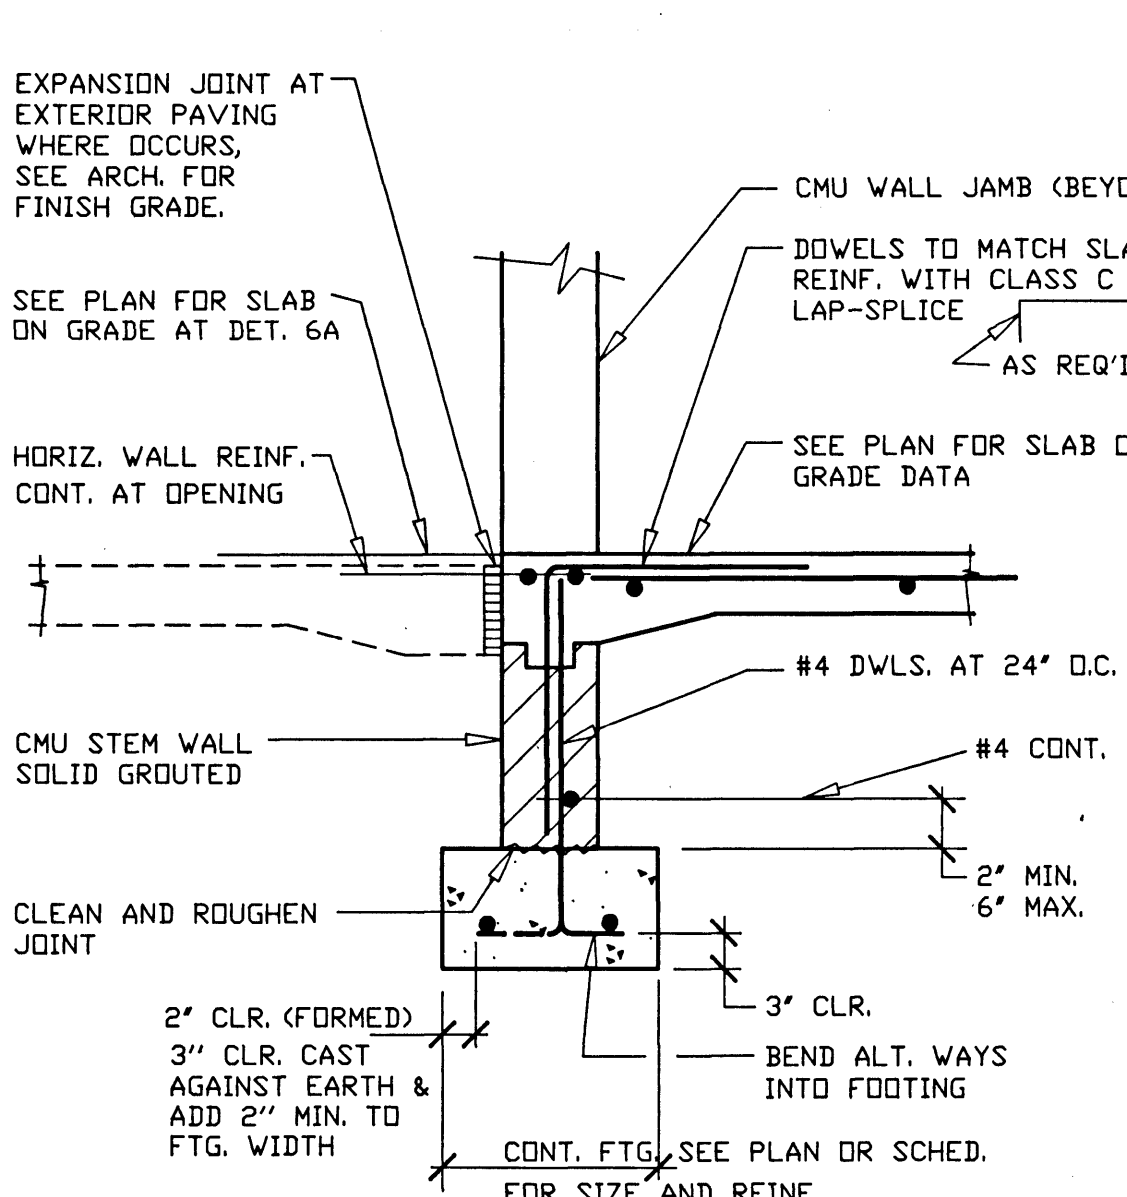


FOOTING AT OPENING

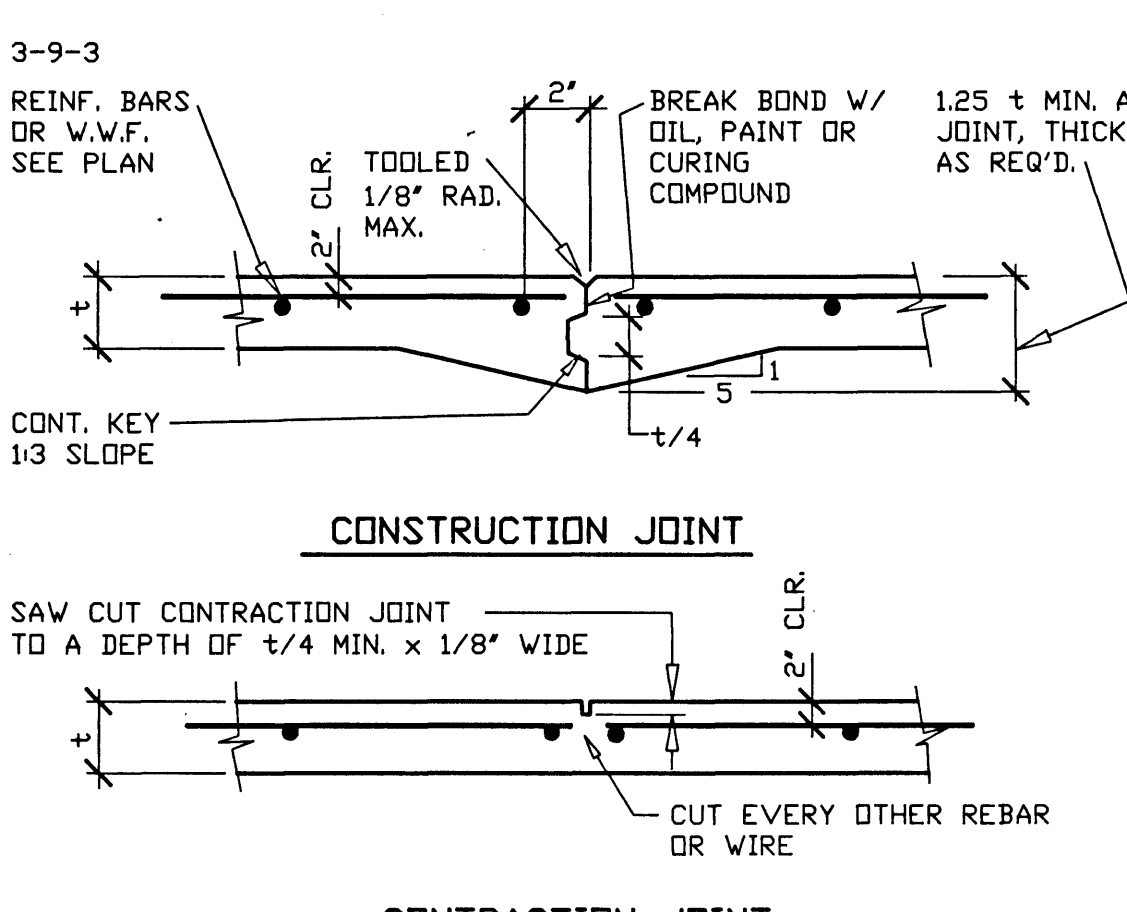


* IF CALLED FOR ON ARCH'L. OR STRUCT'L. DWGS., OR W/ ARCHITECT'S APPROVAL, USE GREENSTREAK ZIPCAP CONTROL JOINT FORMERS NO. 832 x 1 1/2" DEEP INSTALLED AS PER MANUF. INSTRUCTIONS.


JOINTS IN SLAB ON GRADE

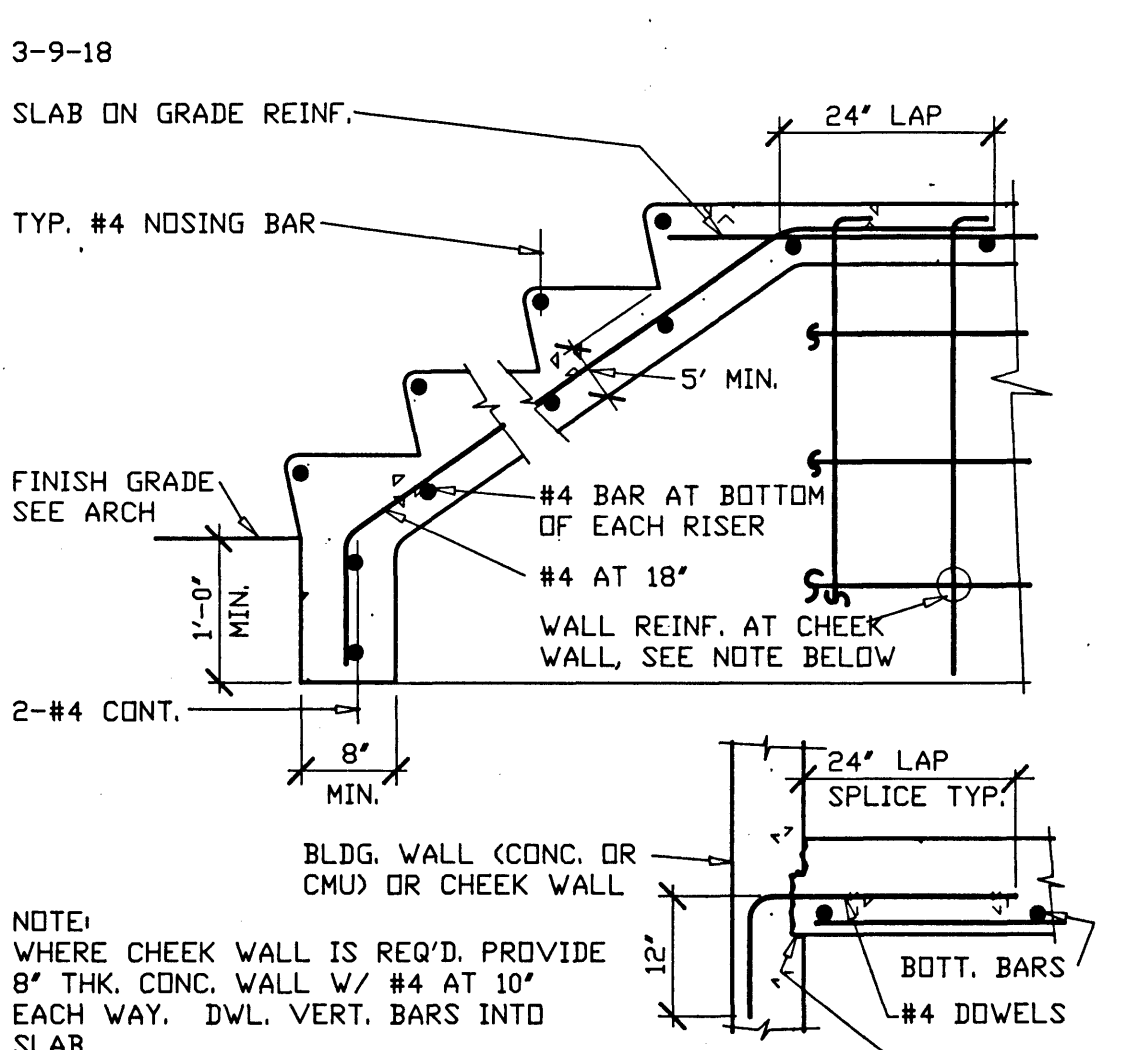


CONCRETE STAIR ON GRADE

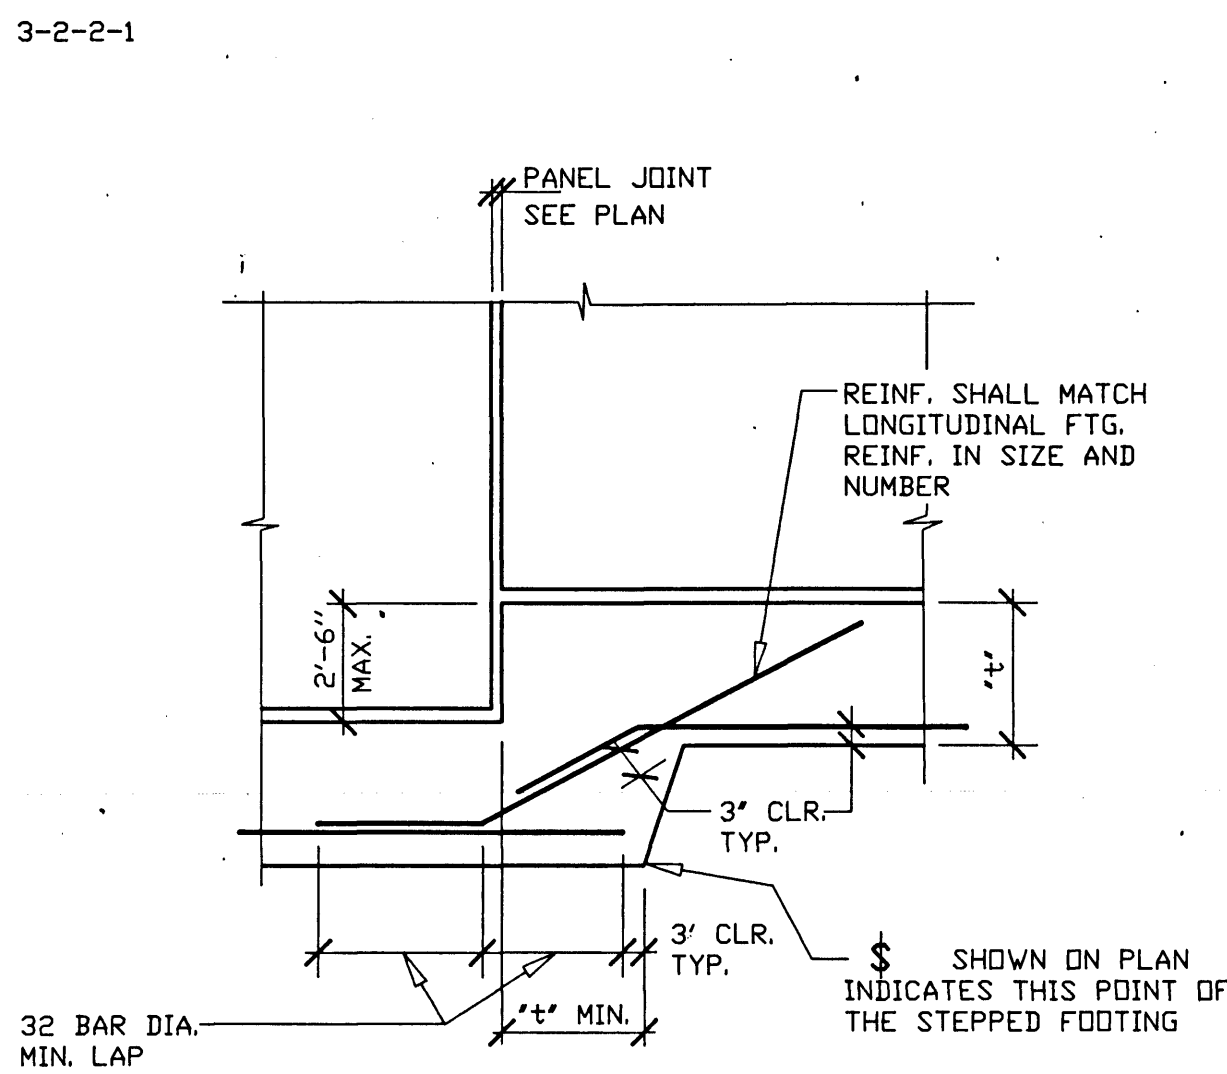


STEPPED FOOTING

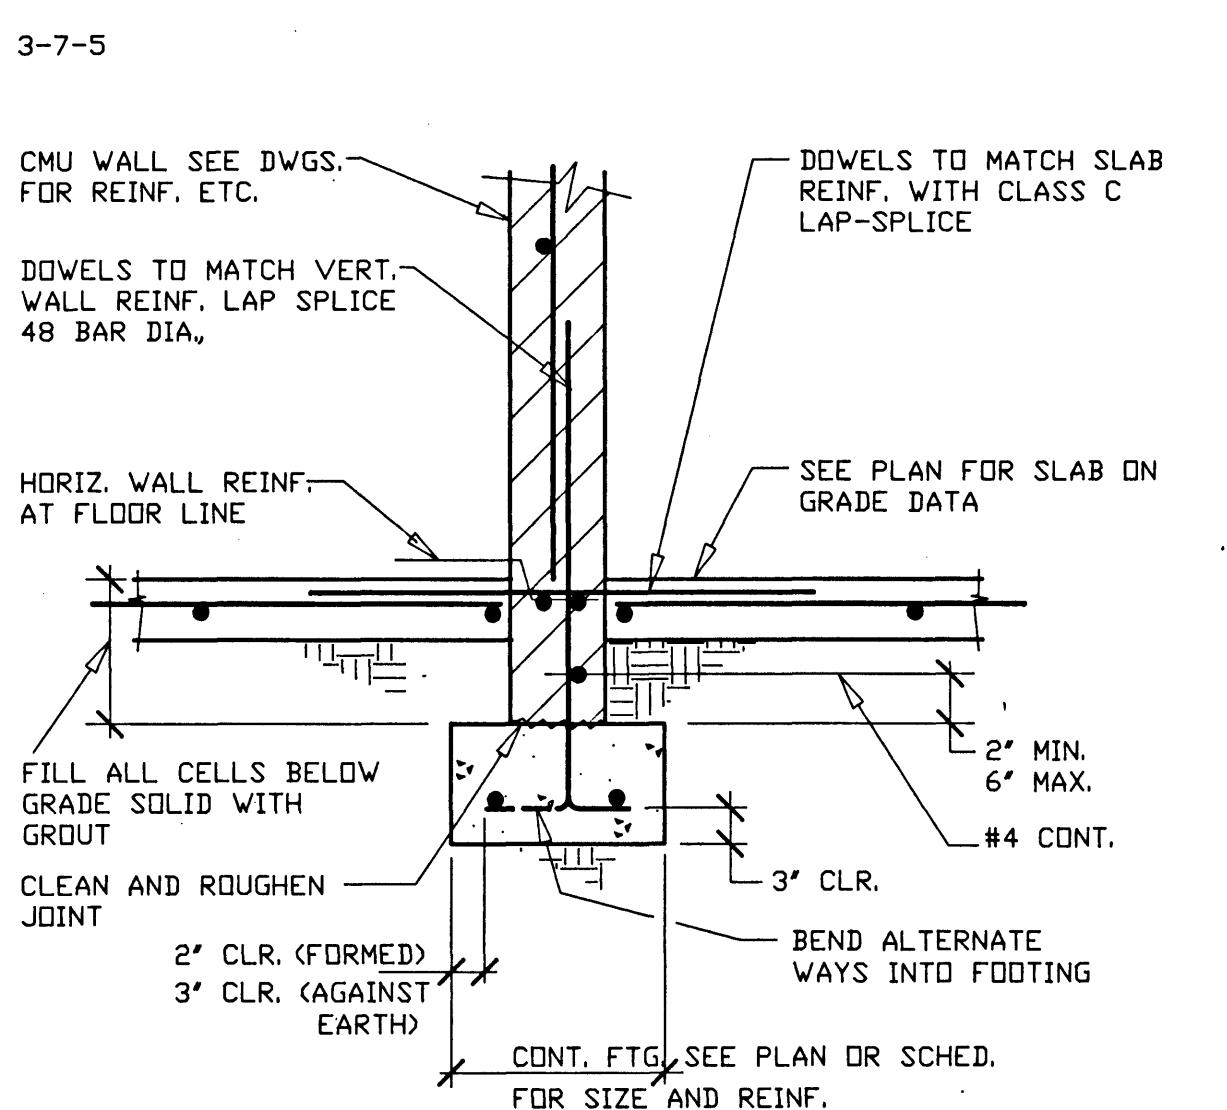


INTERIOR CMU WALL FOOTING

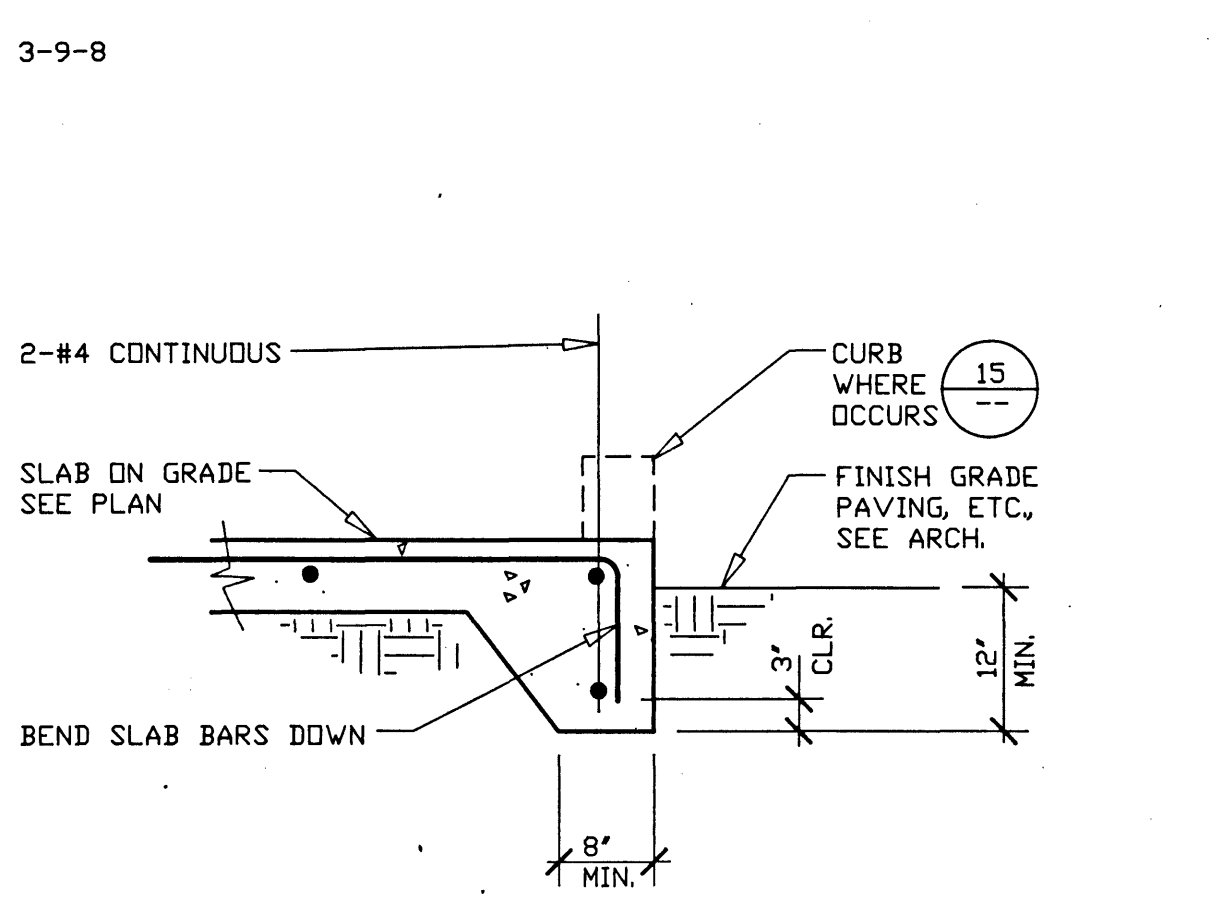


EDGE OF SLAB

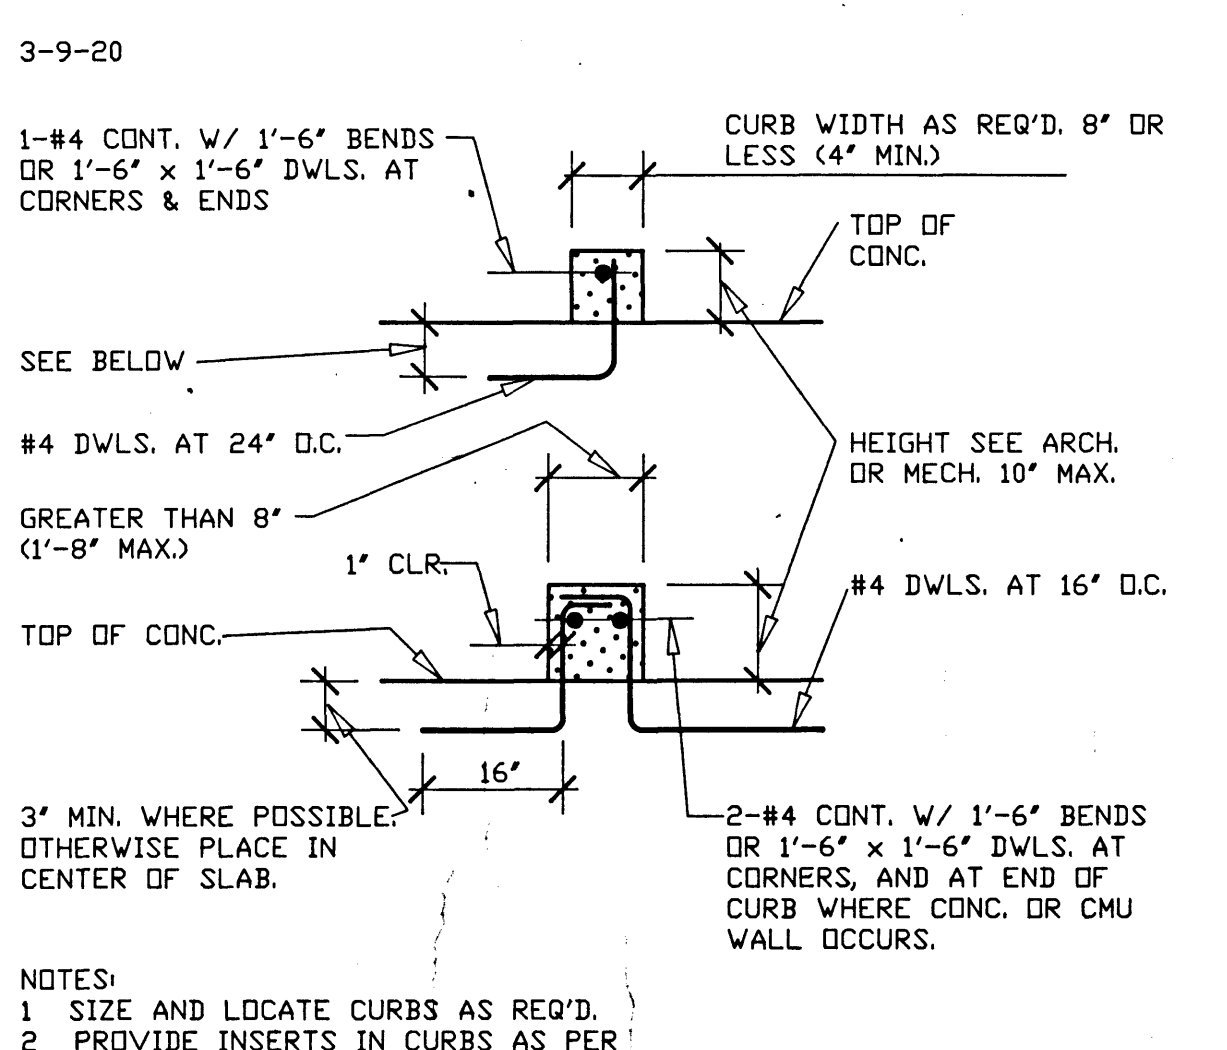


CONCRETE CURB

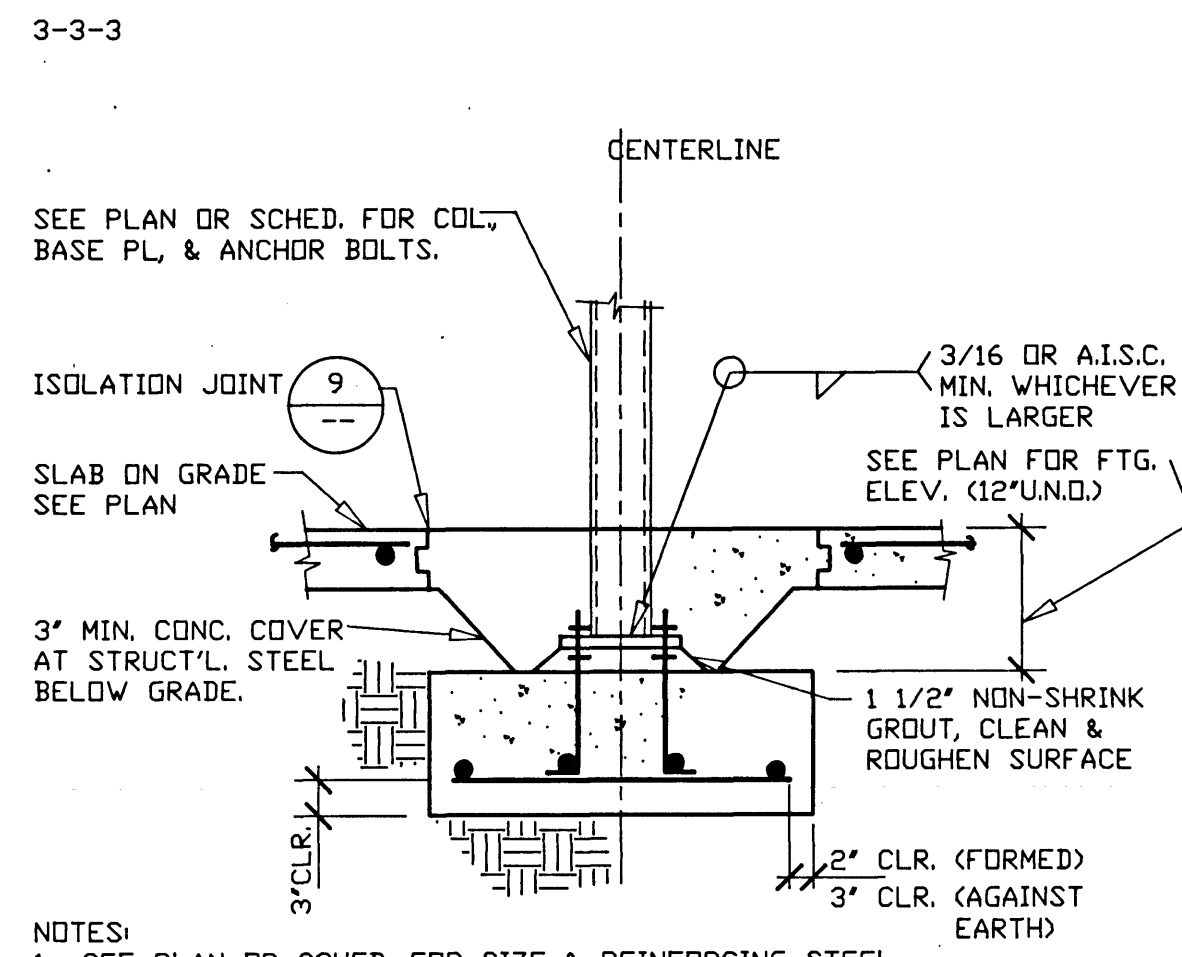


SPREAD FOOTING

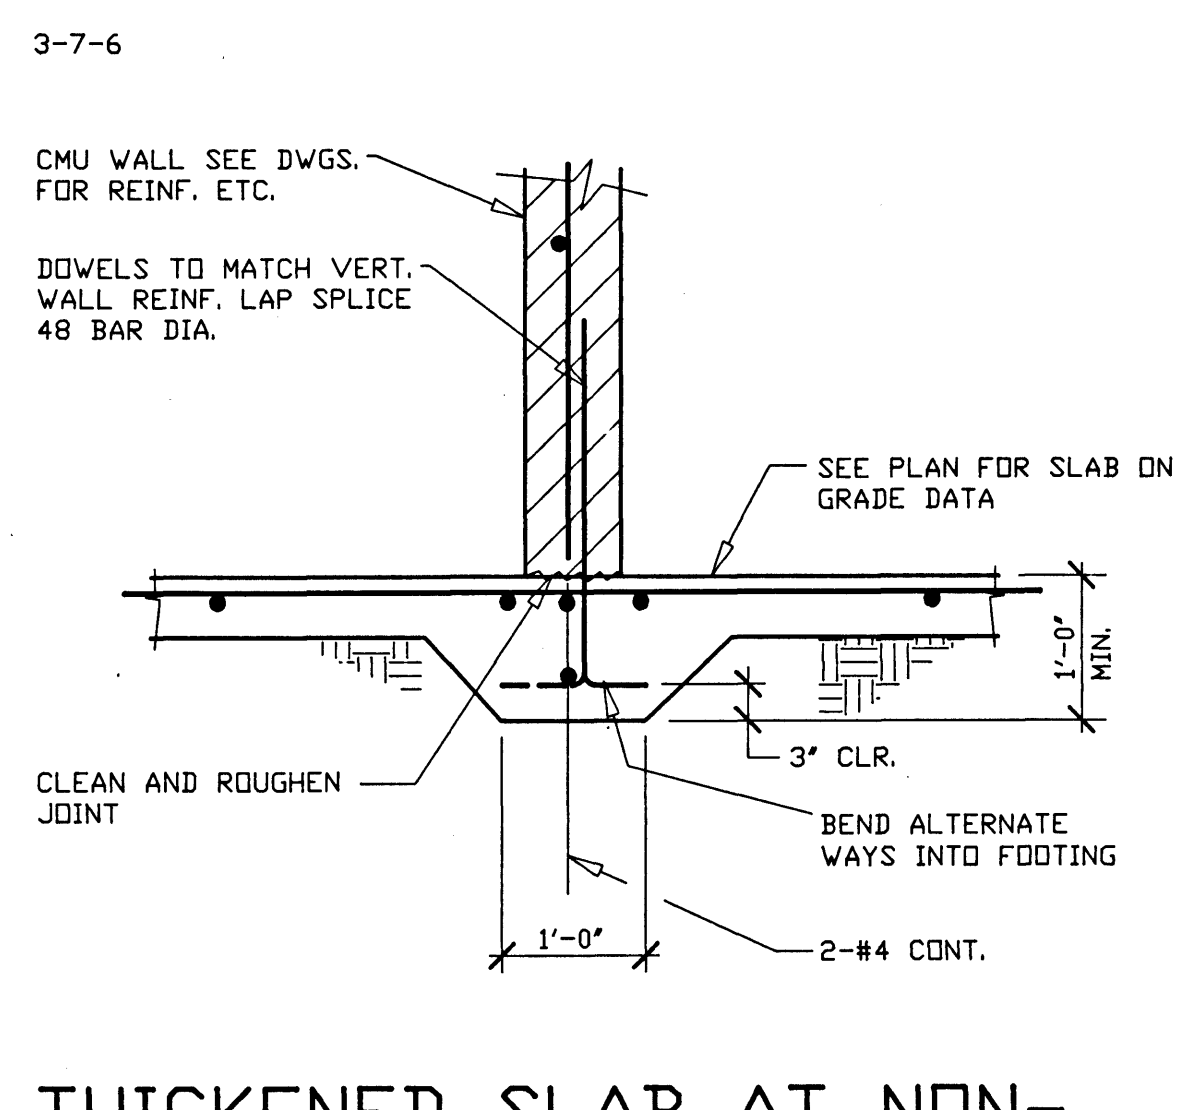

THICKENED SLAB AT NON-BEARING MASONRY WALL

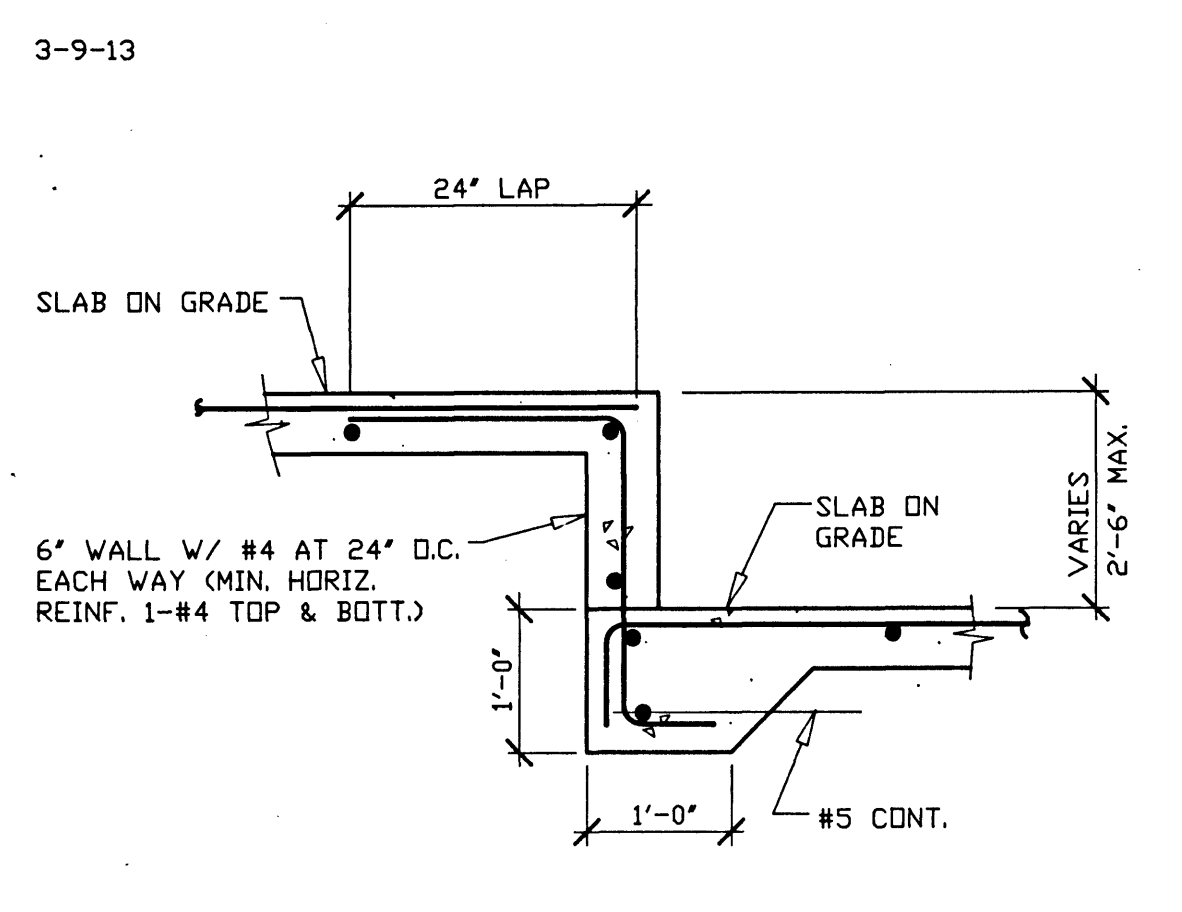

STEP IN SLAB ON GRADE

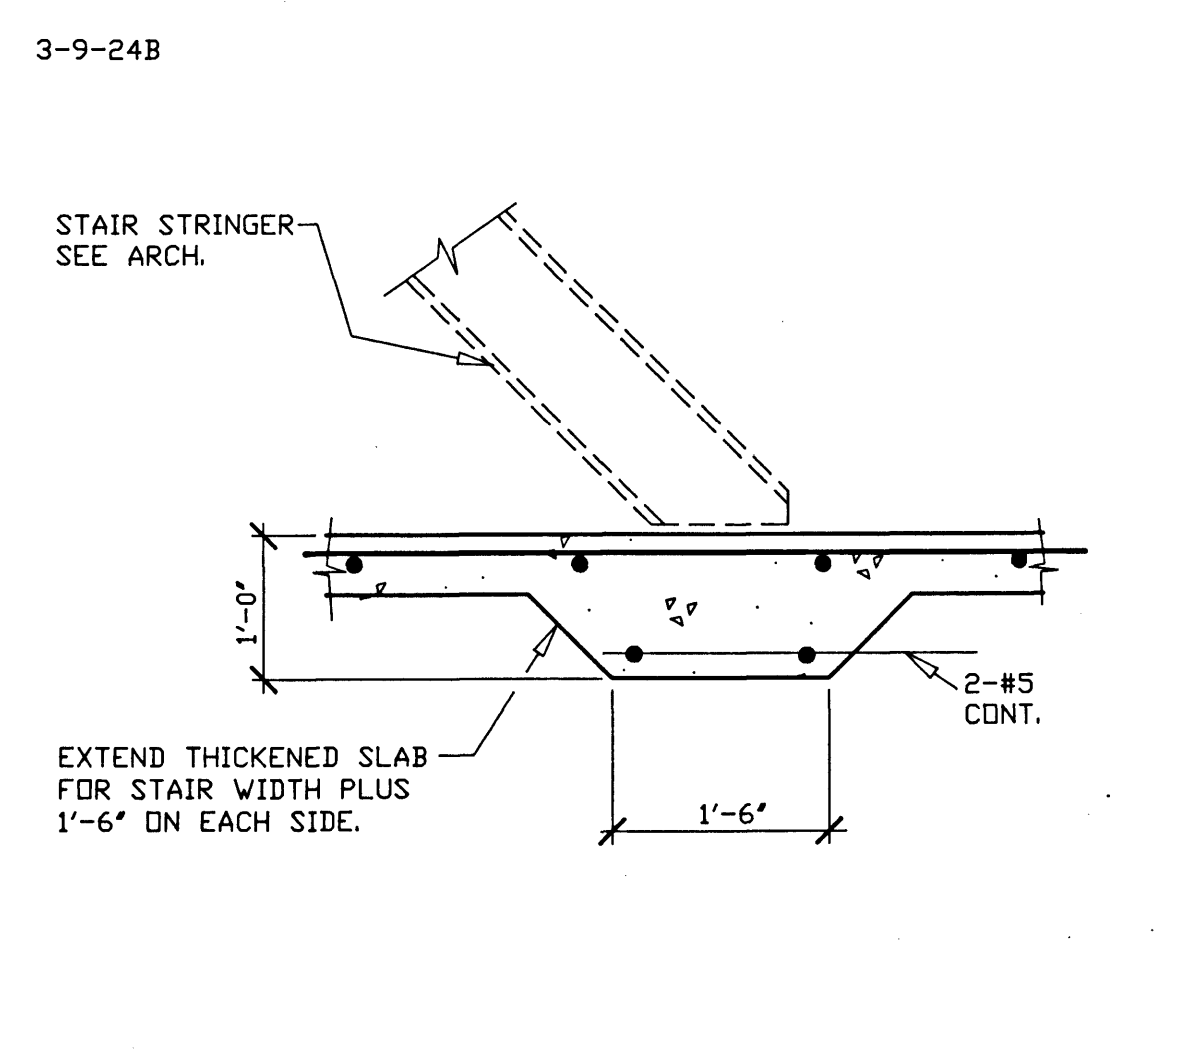

STAIR STRINGER TO SLAB ON GRADE

REVISIONS			
REV	DESCRIPTION	DATE	BY

© DOMINGO CAMBEIRO CORPORATION 1990

AS BUILT RECORD DRAWING
CONSTRUCTION CHANGES SHOWN HEREON
ARE BASED ON DATA
FURNISHED BY THE CONTRACTOR

MARTIN, PELTYN & ASSOCIATES
STRUCTURAL ENGINEERS
1001 RANCHO DRIVE SOUTH
LAS VEGAS, NEVADA 89106
JOB NO. 2523

All designs, arrangements and plans indicated on or presented by this drawing, as instruments of service, are owned by and the property of DOMINGO CAMBEIRO CORPORATION. The use of these plans and/or specifications shall be restricted to the original site for which they were prepared and publication thereof is expressly limited to such use. Reproduction, publication or reuse by any method, in whole or in part, is prohibited. None of such designs, arrangements or plans shall be used by or disclosed to any person, firm, agency, or corporation without the written permission of DOMINGO CAMBEIRO CORPORATION. Visual contact with these plans and specifications shall constitute prima facie evidence of acceptance of these restrictions.

SEAL	DRAWN BY EH	CHECKED BY MA	ISSUED DATE 11-15-90
------	----------------	------------------	-------------------------

TYPICAL DETAILS	DO NOT SCALE DRAWINGS
-----------------	-----------------------

CITY OF LAS VEGAS
DETENTION FACILITY EXPANSION
3100 EAST STEWART AVENUE
LAS VEGAS, NEVADA

Domingo Cambeiro Corporation
ARCHITECTURE • ENGINEERING • PLANNING • INTERIORS
3555 PECOS-McLEOD IC. LAS VEGAS, NEVADA 89121
(702) 732-0084

SHEET NO.
S5.01
80 OF 163
JOB NO. 2523