



PARTIAL FIRST FLOOR PLAN - MALE HOUSING UNIT

SCALE: 1/8"=1'-0"

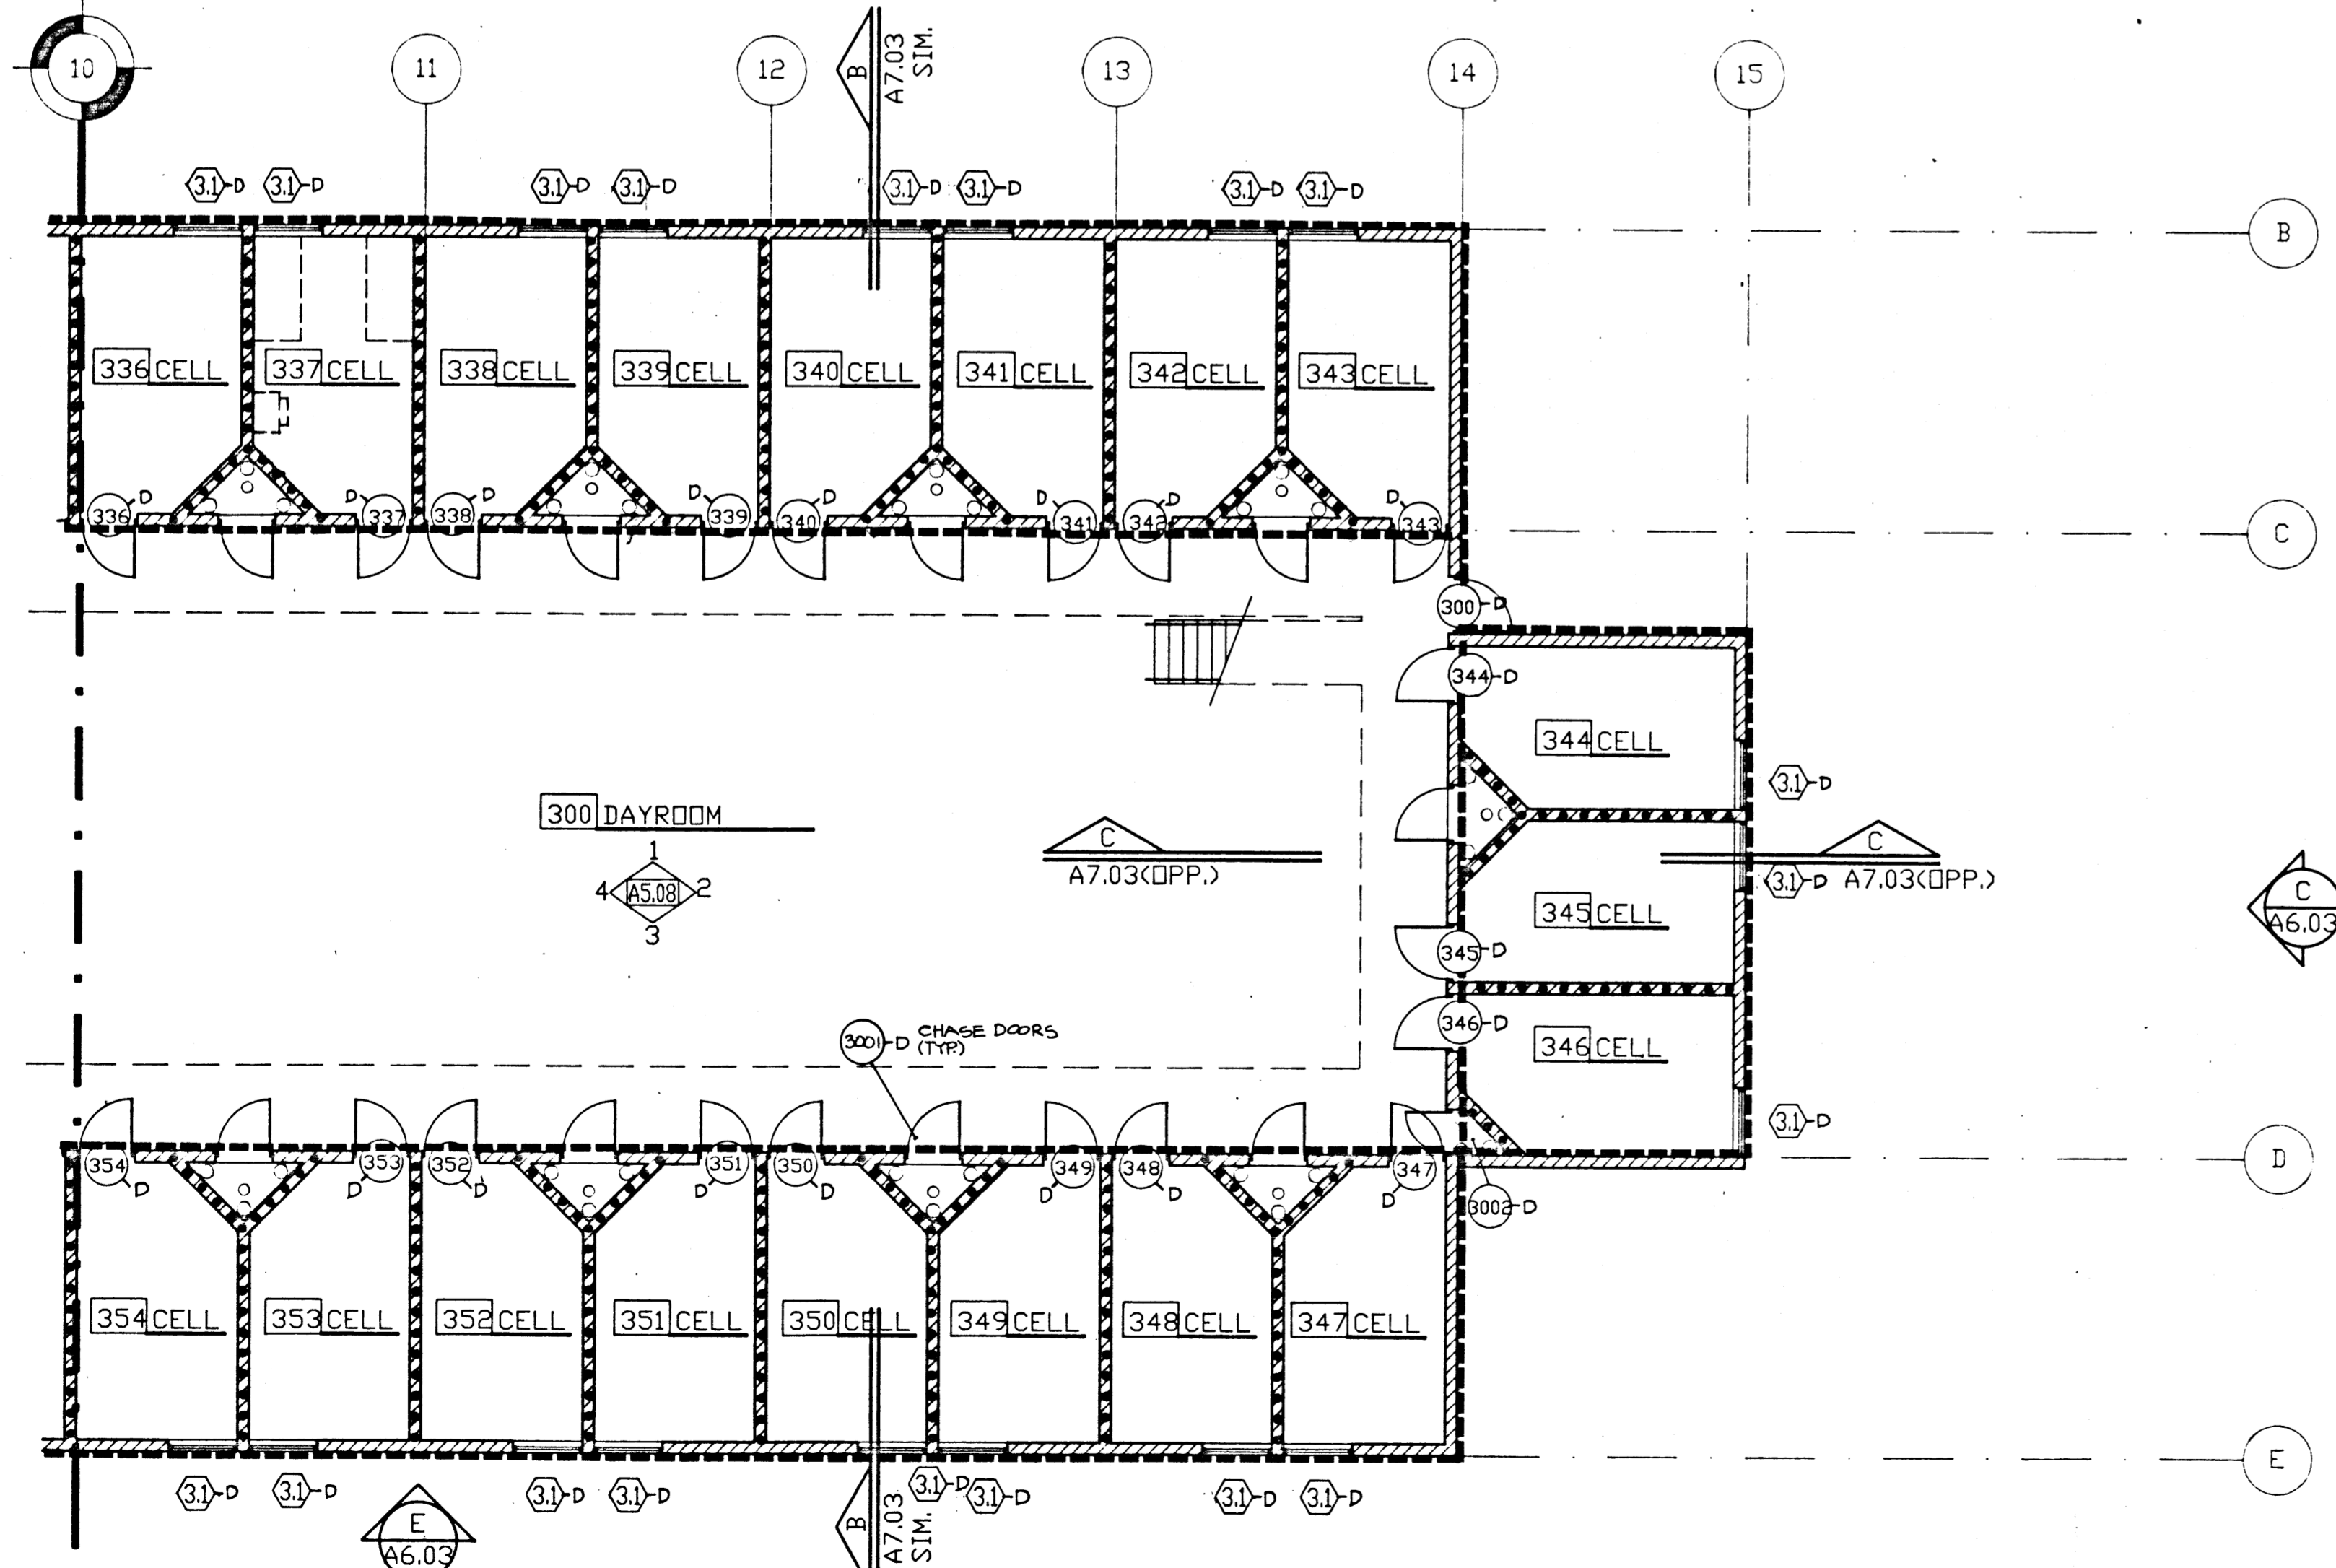

PARTIAL FIRST FLOOR PLAN - MALE HOUSING UNIT

SCALE: 1/8"=1'-0"

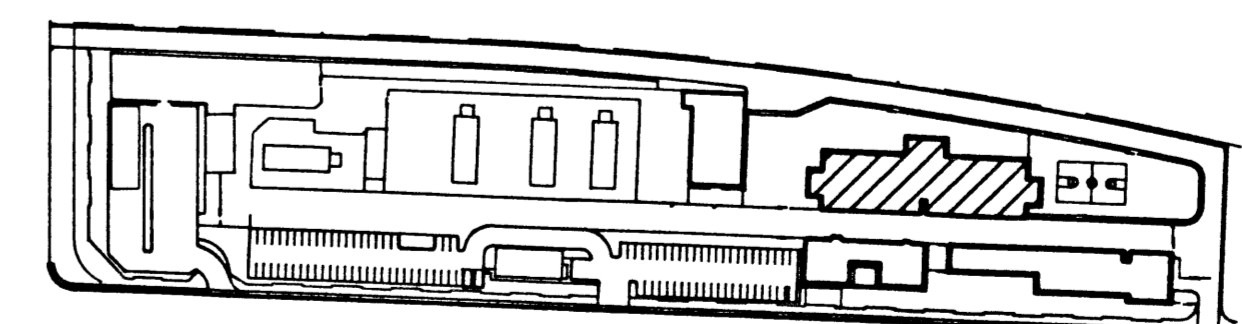

KEY PLAN

| REVISIONS | | | |
|-----------|-------------|------|----|
| REV | DESCRIPTION | DATE | BY |
| | | | |
| | | | |
© DOMINGO CAMBEIRO CORPORATION 1990

AS-BUILT RECORD DRAWING
CONSTRUCTION CHANGES SHOWN HEREON ARE BASED ON DATA FURNISHED BY THE CONTRACTOR

© Haldane Harrison Associates, Inc., 1990

Haldane Harrison Associates, Inc.
Detention Consultants and Planners 303 484-1488
348 MARTIN DRIVE, BOULDER, COLORADO 80303 fax: (303) 448-0008

All designs, arrangements and plans indicated on presented by this drawing as instruments of service, are owned by and the property of DOMINGO CAMBEIRO CORPORATION. The use of these plans and/or specifications shall be restricted to the original site for which they were prepared and publication thereof is expressly limited to such use. Reproduction, publication or reuse by any method, in whole or in part, is prohibited. None of such designs, arrangements or plans shall be used by or disclosed to any person, firm, agency, or corporation without the written permission of DOMINGO CAMBEIRO CORPORATION. Visual contact with these plans and specifications shall constitute prima facie evidence of acceptance of these restrictions.

SEAL


DRAWN BY
CHECKED BY
ISSUED DATE
11-15-90

**FIRST FLOOR PLAN
MALE HOUSING UNIT**
DO NOT SCALE DRAWINGS


**CITY OF LAS VEGAS
DETENTION FACILITY EXPANSION
3100 EAST STEWART AVENUE
LAS VEGAS, NEVADA**

SHEET NO.
DS3
135 of 163


Domingo Cambeiro Corporation
ARCHITECTURE ENGINEERING PLANNING INTERIORS
3555 PECOS-MCLEDD IC. LAS VEGAS, NEVADA 89121
(702) 792-0084

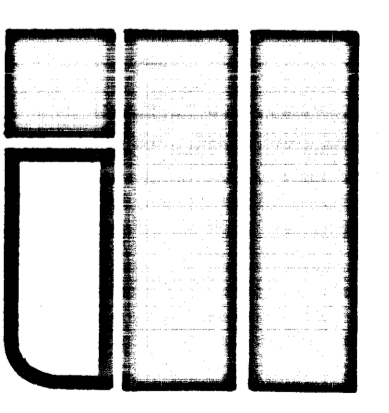

162-51

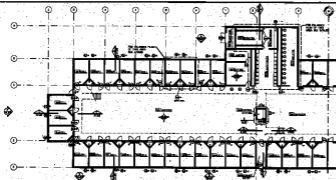

CENTRAL FIRST FLOOR PLAN - MALE HOUSING UNIT

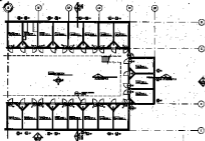

CENTRAL FIRST FLOOR PLAN - MALE HOUSING UNIT



KEY PLAN

| | |
|-----|----------|
| NO. | REVISION |
| | |
| | |
DATE: 10/10/68

DESIGNED BY: [Name]
 DRAWN BY: [Name]
 CHECKED BY: [Name]

SCALE: 1/8" = 1'-0"

PROJECT: [Name]
 SHEET: [Number]

| | | |
|--|--|--|
| <p>DATE: 10/10/68</p> <p>DESIGNED BY: [Name]</p> <p>DRAWN BY: [Name]</p> <p>CHECKED BY: [Name]</p> | <p>SCALE: 1/8" = 1'-0"</p> <p>PROJECT: [Name]</p> <p>SHEET: [Number]</p> | <p>DESIGN CONSULTING CORPORATION</p> <p>1000 [Address]</p> <p>[City, State, Zip]</p> |
|--|--|--|

DESIGN CONSULTING CORPORATION

| | |
|-----|----------|
| NO. | REVISION |
| | |
| | |
DATE: 10/10/68