



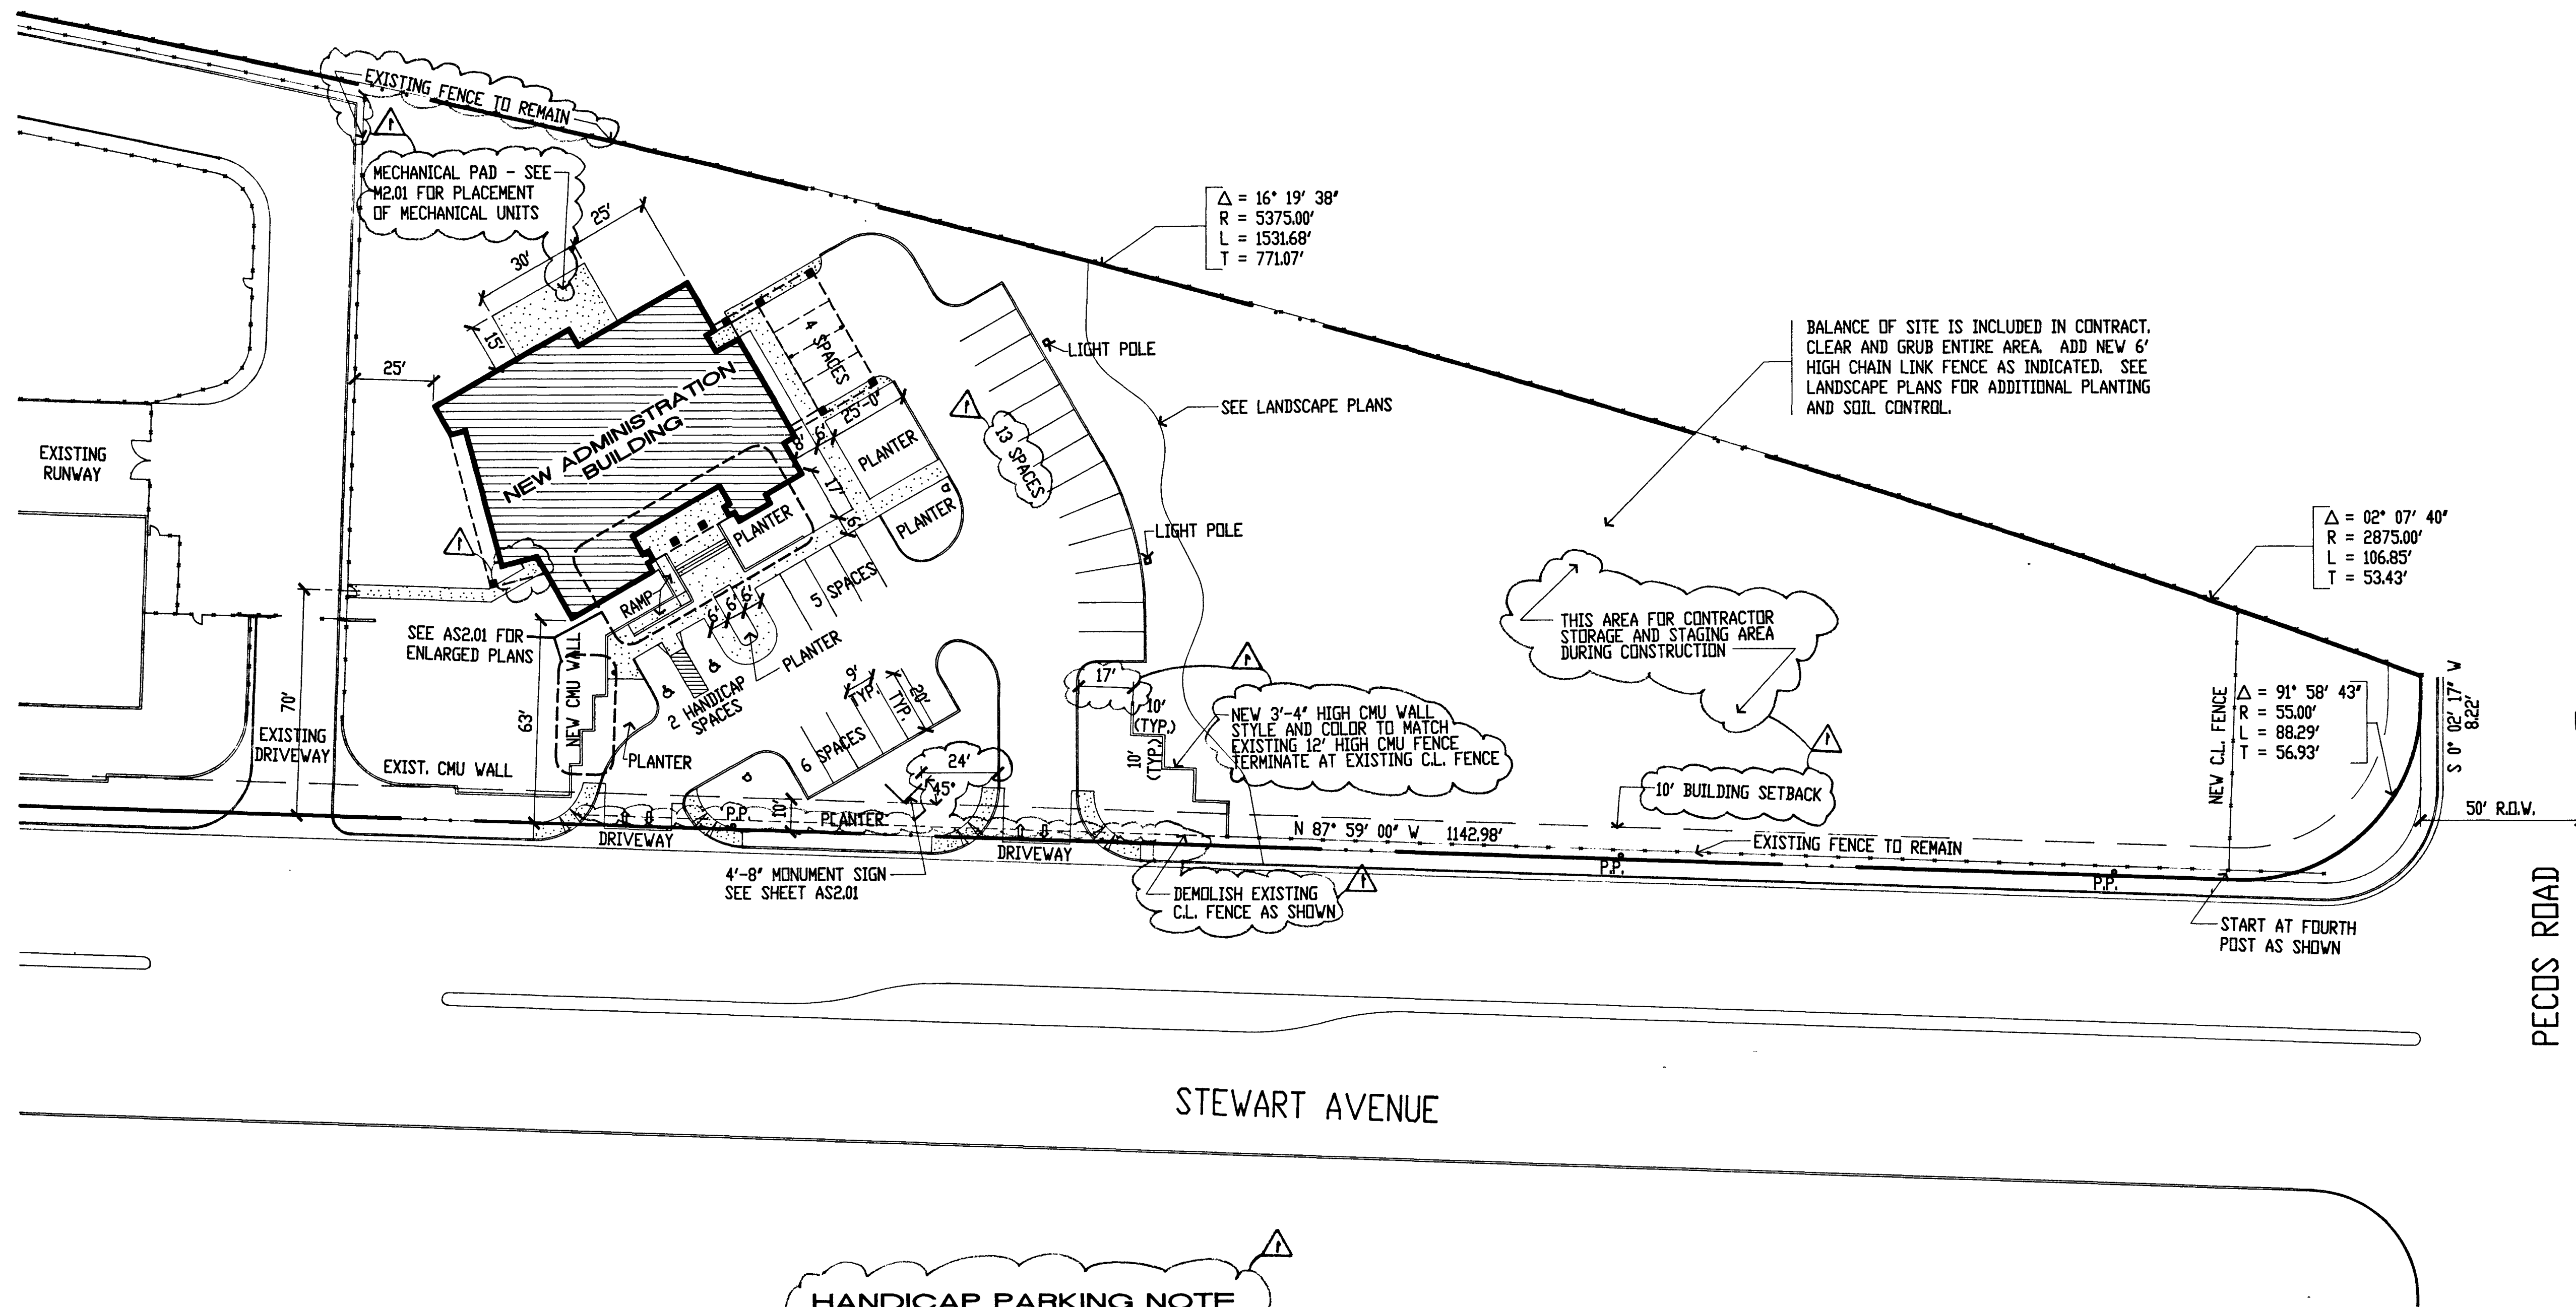

ARCHITECTURAL SITE PLAN
SCALE: 1"=30'

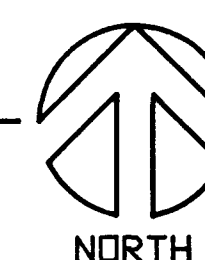

HANDICAP PARKING NOTE
HANDICAP SYMBOLS SHALL BE PAINTED ON GROUND ONLY, NOT POLE-MOUNTED SIGN. FOLLOW CITY STANDARDS FOR SYMBOLS AND STRIPING.

REVISIONS			
REV	DESCRIPTION	DATE	BY
1	GENERAL REVISIONS	1-28-92	

DOMINGO CAMBEIRO CORPORATION 1990

AS BUILT RECORD DRAWING
ALL DIMENSIONS SHOWN HEREON ARE BASED ON DATA FURNISHED BY THE CONTRACTOR

All designs, arrangements and plans indicated on or presented by this drawing, its instruments of service, are owned by and the property of DOMINGO CAMBEIRO CORPORATION. The use of these plans and/or specifications shall be restricted to the original site for which they were prepared and publication thereof is expressly limited to such use. Reproduction, publication or re-use by any method, in whole or in part is prohibited. None of such designs, arrangements or plans shall be used by or disclosed to any person, firm, agency or corporation without the written permission of DOMINGO CAMBEIRO CORPORATION. Visual contact with these plans and specifications shall constitute prima facie evidence of acceptance of these restrictions.

SEAL	DRAWN BY	CHECKED BY	ISSUED DATE
			1-27-92

ARCHITECTURAL SITE PLAN	DO NOT SCALE DRAWINGS
-------------------------	-----------------------

**ADMINISTRATION BUILDING
DETENTION FACILITY EXPANSION**
CITY OF LAS VEGAS, NEVADA

Domingo Cambeiro Corporation
ARCHITECTURE • ENGINEERING • PLANNING • INTERIORS
3555 PECOS-McLEOD IC. LAS VEGAS, NEVADA 89121 (702) 792-0084

SHEET NO. 8 of 44

AS1.01